
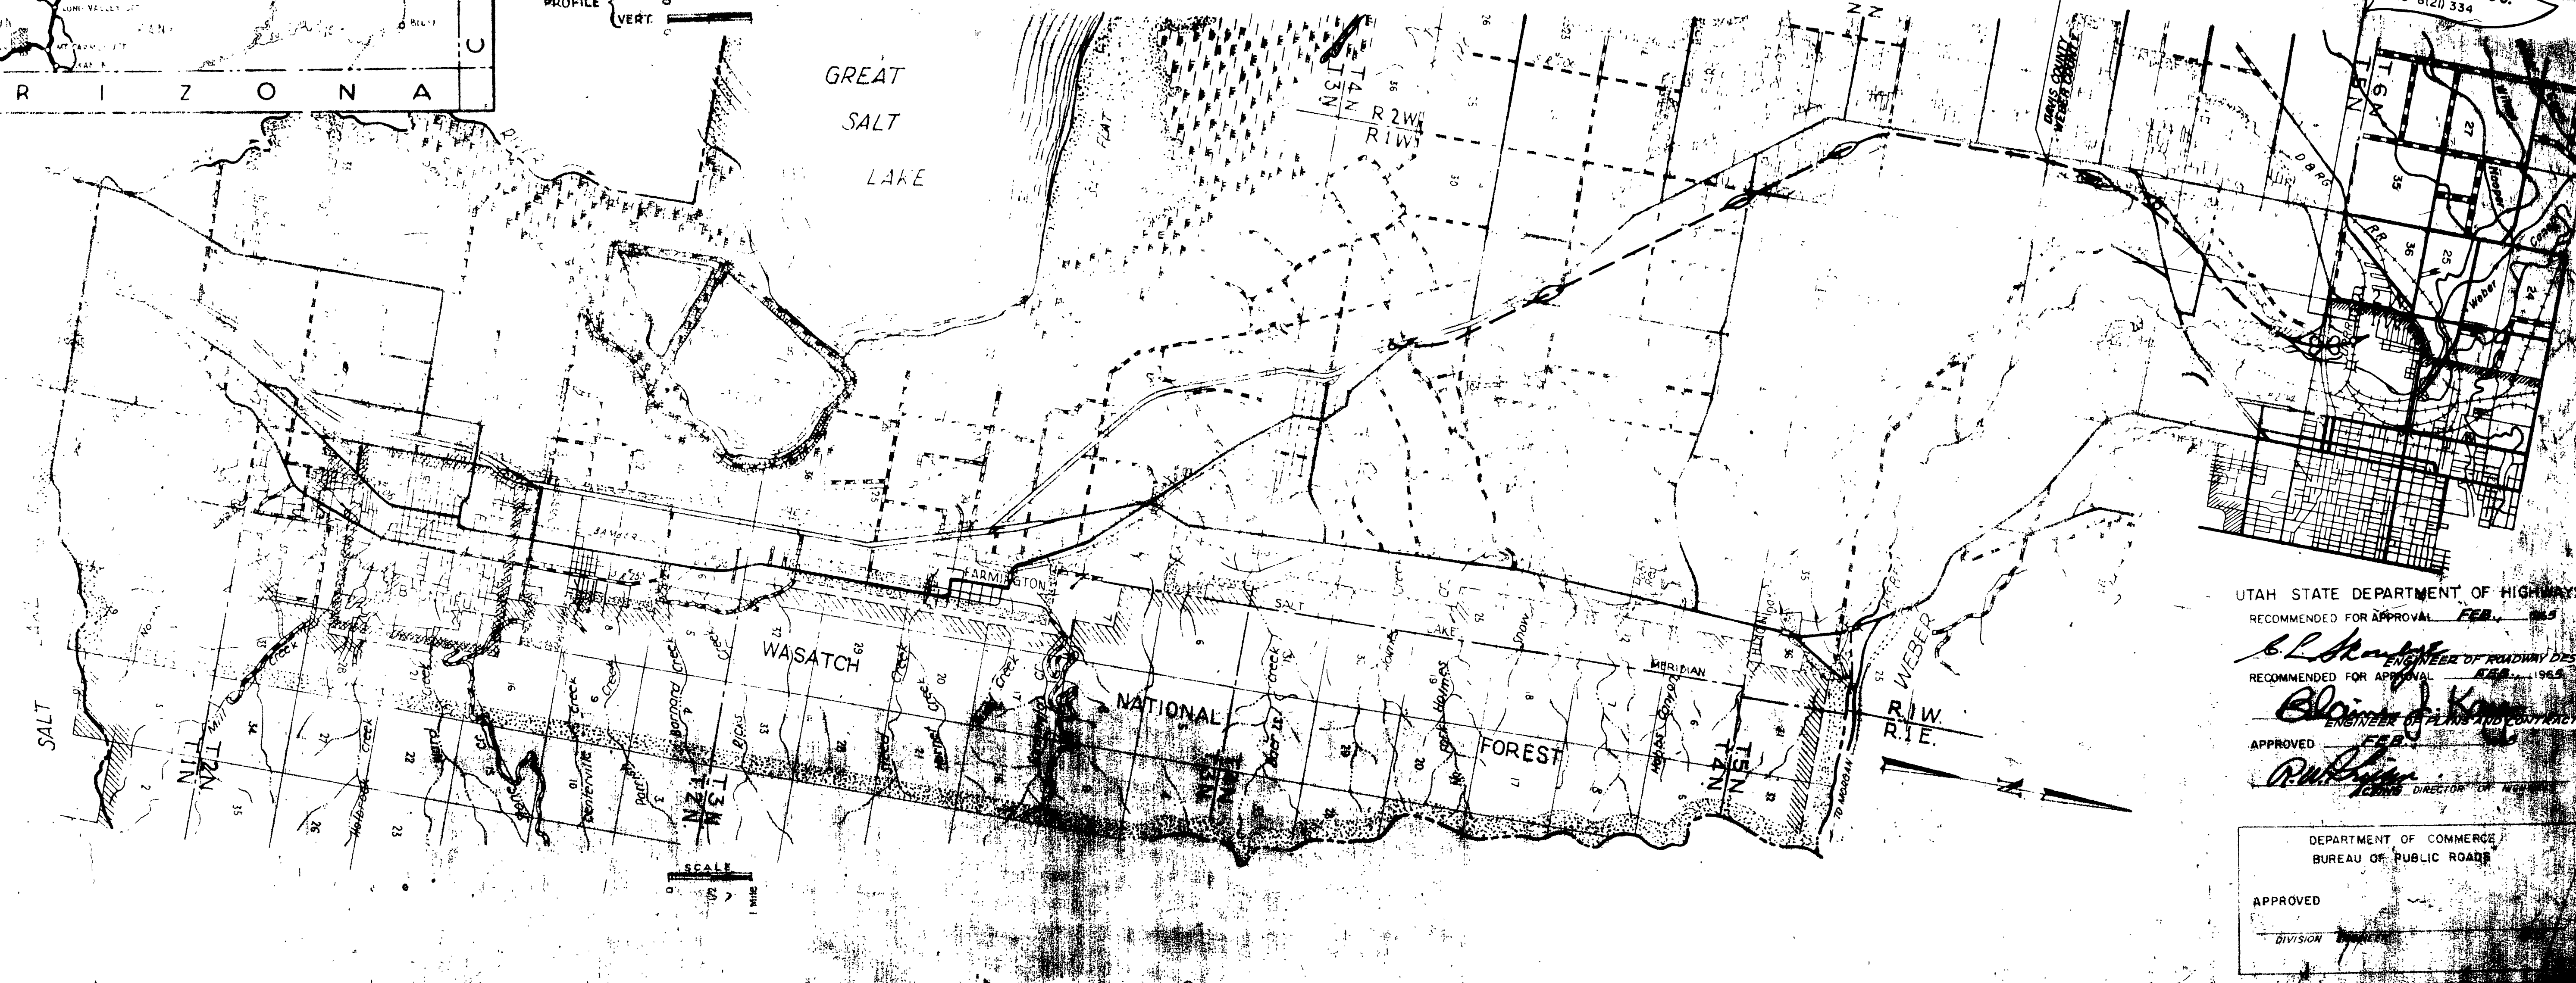
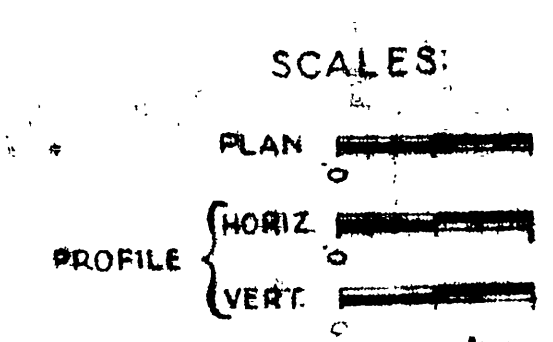


STATE OF UTAH STATE ROAD COMMISSION

PLANS OF PROPOSED STATE ROAD
FEDERAL AID PROJECT
I-15-8(2D) 334 1ST CONTRACT
DAVIS-WEBER COUNTY LINE TO 31ST STREET
WEBER COUNTY
LENGTH 3.862 MILES
AS CONSTRUCTED DRAWINGS

1ST Contract
INDEX TO SHEETS I-15-8(21) 334

DESCRIPTION	
1	TITLE SHEET
2-4	TYPICAL SECTION
5-10	SUM. SHEETS AND MAT'L. SITE SHEETS
11-15	PLAN & PROFILE SHEETS
16-20	DEEP BEAM HIGHWAY GUARDRAIL
21-25	GROUND MOUNTED SIGN INSTALLATION DETAILS
26-30	CHAIN LINK FENCE
31-35	CONSTRUCTION DRIVE
36-40	CONCRETE CURB AND GUTTER
41-45	REINFORCED CONC. END SECTION
46-50	STANDARD CATCH BASIN
51-55	STANDARD CATCH BASIN
56-60	STANDARD CATCH BASIN
61-65	STANDARD CATCH BASIN
66-70	STANDARD CATCH BASIN
71-75	STANDARD CATCH BASIN
76-80	STANDARD CATCH BASIN
81-85	STANDARD CATCH BASIN
86-90	STANDARD CATCH BASIN
91-95	STANDARD CATCH BASIN
96-100	STANDARD CATCH BASIN

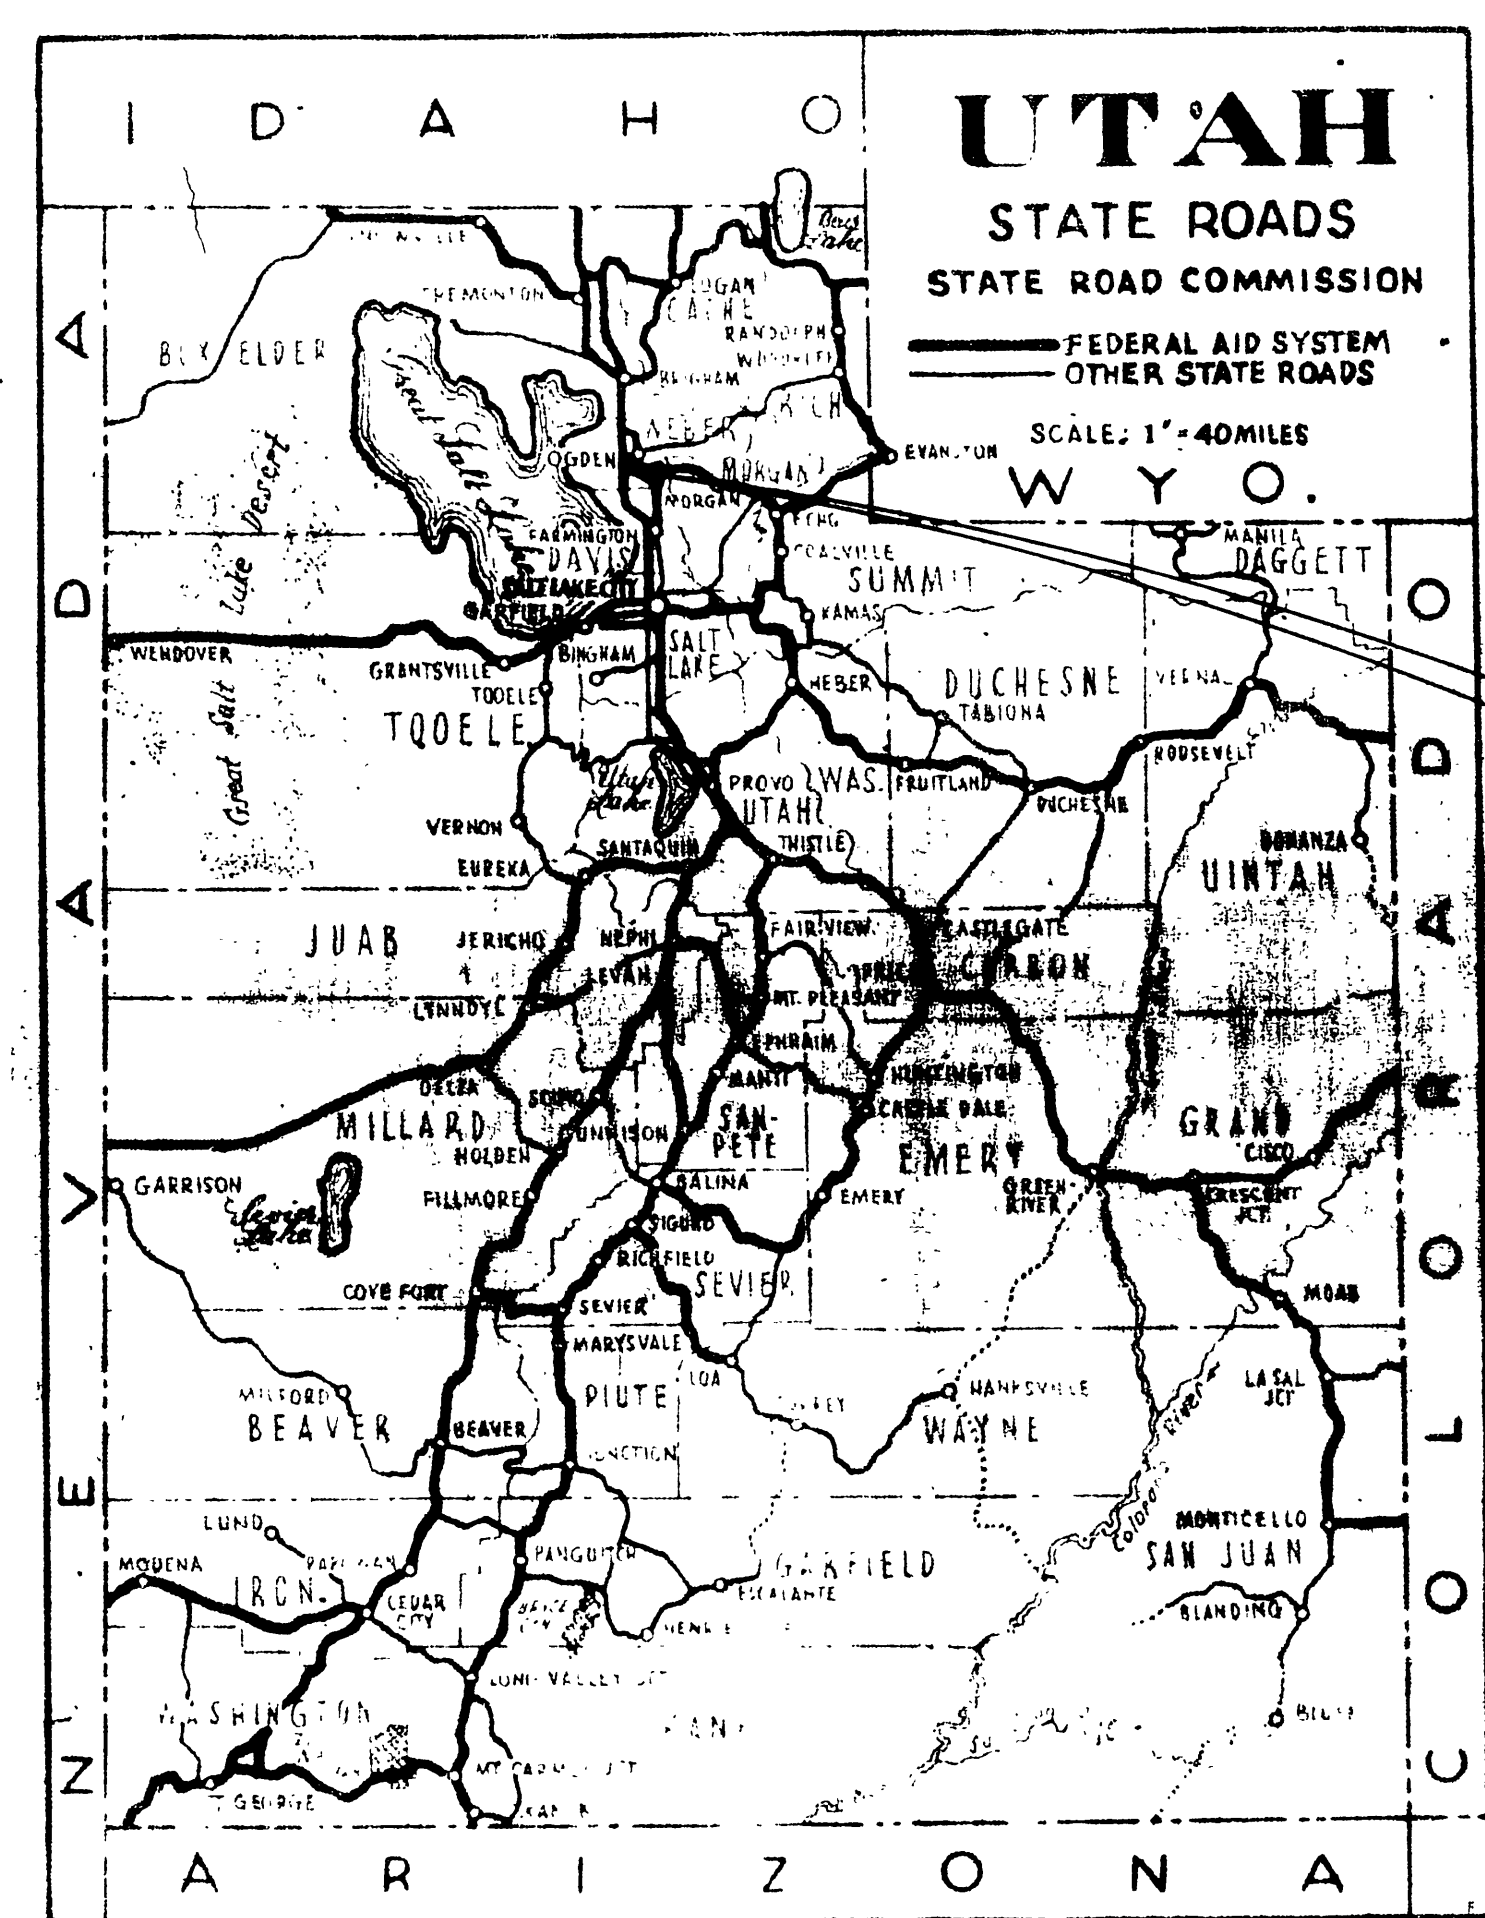


UTAH STATE DEPARTMENT OF HIGHWAYS
RECOMMENDED FOR APPROVAL FEB. 1965
ENGINEER OF ROADWAY DESIGN
RECOMMENDED FOR APPROVAL FEB. 1965
ENGINEER OF PLANS AND CONTRACTS
APPROVED FEB. 1965
DIRECTOR OF HIGHWAYS
DEPARTMENT OF COMMERCE
BUREAU OF PUBLIC ROADS
APPROVED
DIVISION

APPLICATION	TYPE	AMOUNT FOR EST. PURPOSES ONLY
PORTLAND CEMENT CONCRETE PAVEMENT	9" THICK	SQ. YD.
PORTLAND CEMENT TREATED BASE COURSE		140 LBS./CU. FT.
PORTLAND CEMENT	TYPE I	SEE SPECIAL PROVISION
GRAVEL BASE COURSE	1" MAX. AGG.	140 LBS./CU. FT.
GRAVEL SURFACE COURSE	1" MAX. AGG.	140 LBS./CU. FT.
BITUMINOUS SURFACE COURSE	1" MAX. AGG.	148 LBS./CU. FT.
BITUMINOUS SURFACE COURSE	3/4" MAX. AGG.	148 LBS./CU. FT.
BITUMINOUS MATERIAL	85-100 PENETRA.	5% BIT. SUR. CRSE. BY WT.
BITUMINOUS MATERIAL	60-70 PENETRA.	7% BIT. SUR. CRSE. BY WT.
BITUMINOUS MATERIAL SEAL COAT	RC-800	0.2 GAL./SQ. YD.
BITUMINOUS MATERIAL TACK COAT	RC-70 OR RC-250	0.15 GAL./SQ. YD.
BITUMINOUS MATERIAL CURING COAT	MC-70 OR MC-250	0.15 GAL./SQ. YD.
BITUMINOUS MATERIAL PRIME COAT	MC-70 OR MC-250	0.5 GAL./SQ. YD.
BITUMINOUS ADDITIVE	COMMERCIAL GRADE	1% OF RC-800 IN GALS.
HYDRATED LIME	TYPE 'A'	1% OF BIT. SUR. CRSE.
COVER MATERIAL		20 LBS./CU. FT.
PLANT MIX SEAL COAT	RC-70 OR RC-250	148 LBS./CU. FT.
FLUSH COAT		0.1 GAL./SQ. YD.


TYPICAL CROSS SECTION

FED. ROAD DIST. NO.	STATE	PROJ. NO.	SHEET NO.	TOT. SHEETS
UTAH	UTAH	1-15-8(2)334	2	

REVISION DATE 3/10/65

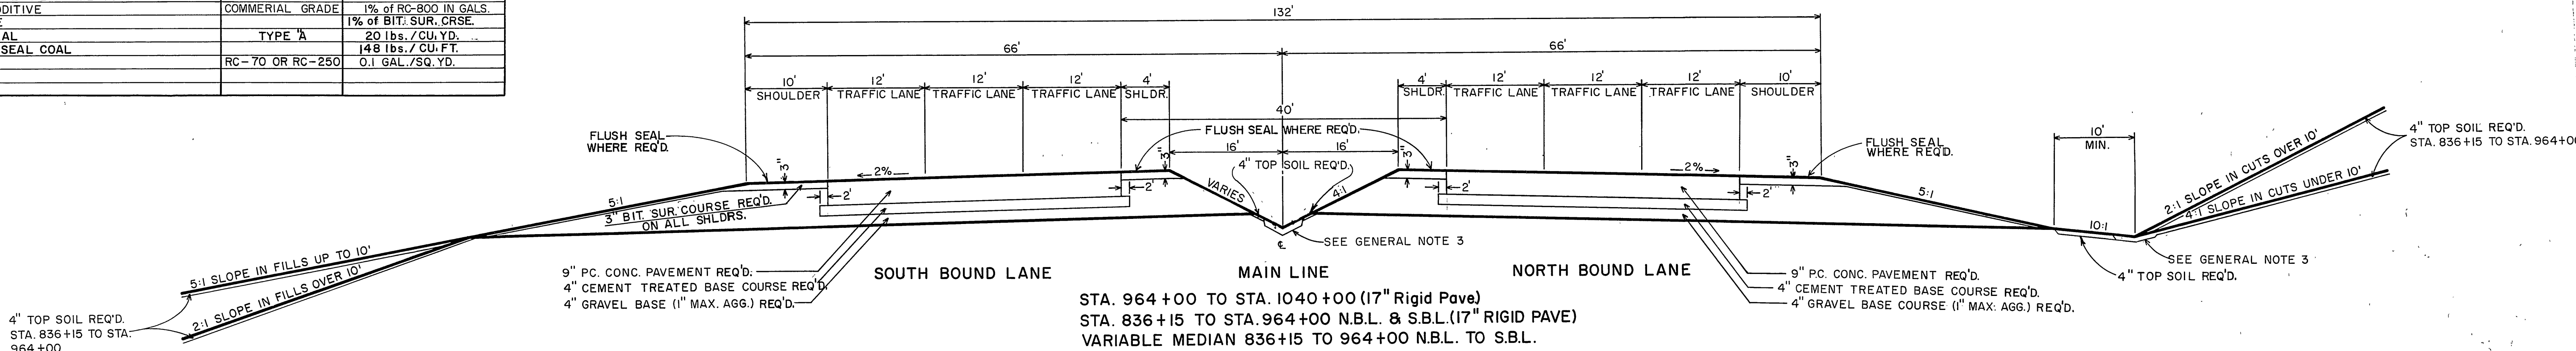



- GENERAL NOTE
1. TOP SOIL TO BE PLACED ON ALL MEDIAN AND OUTSIDE SLOPES OF LINES BEING SURFACED UP TO STA. 964 (AS DIRECTED BY PROJ. ENG.)
 2. DESIGN SPEED 70 MPH SUPERELEVATE IN ACCORDANCE WITH STANDARD DRWG. NO. 203
 3. FOR PLACING OF BITUMINOUS PAVED MEDIAN AND CUT DITCHES SEE TYPICAL SECTIONS SHEET 2C.
 4. FOR TYPICAL SECTION AND PLACING OF ROLLED GUTTER ON SHOULDERS SEE SHEET 2B.
 5. HIGHWAY TRAFFIC STRIPING SHALL BE REQ'D. ON THE MAIN LINE, ALL RAMPS, CROSS ROADS AND FRONTAGE ROADS ON THIS PROJECT UNDER THIS CONTRACT, SEE SHEET NO. 2F & SUMMARY SHEET 3D.

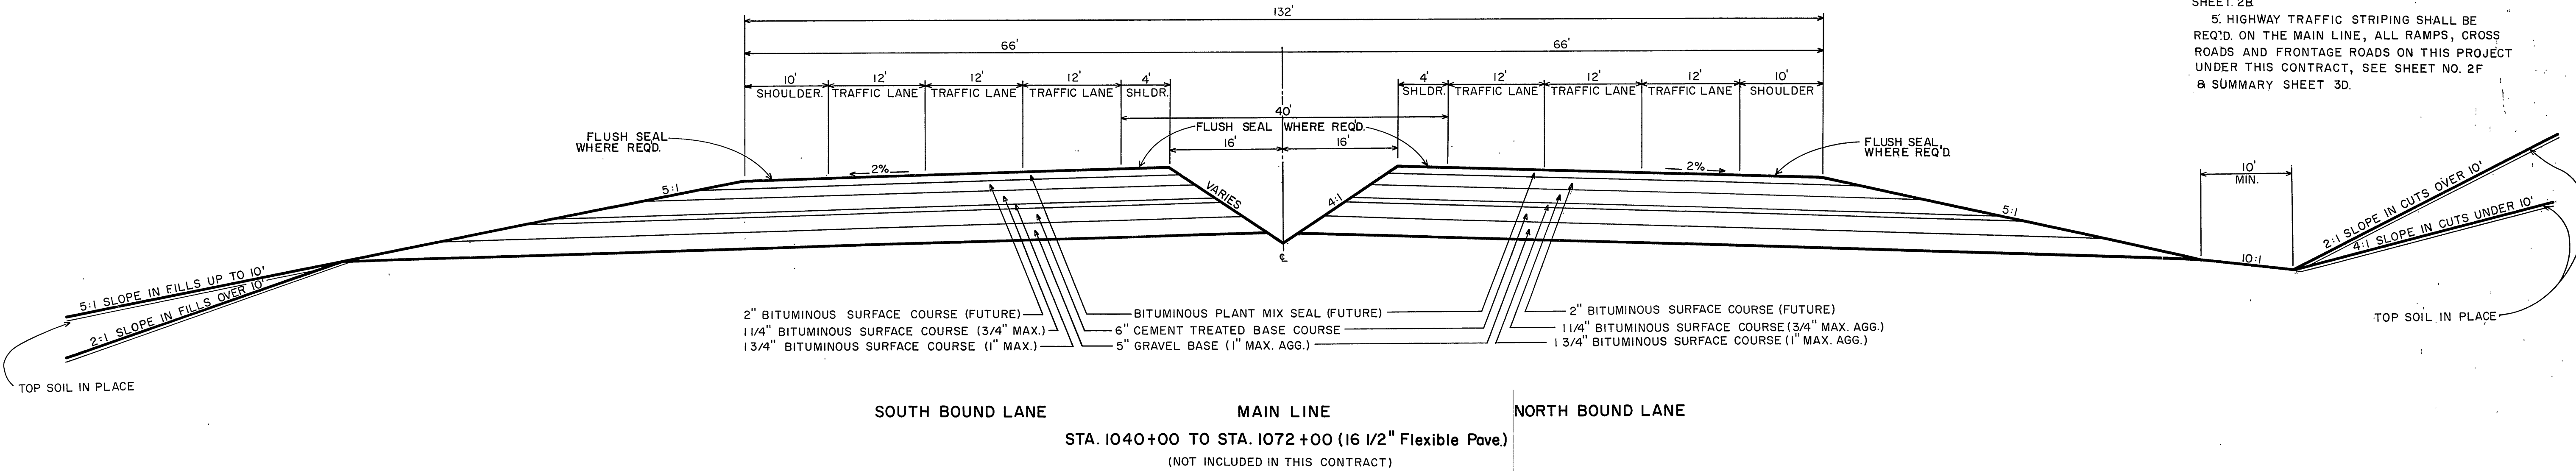

REVISIONS	DATE	BY	DATE	BY





TYPICAL CROSS SECTION

FED. ROAD DIST. NO.	STATE	PROJ. NO.	SHEET NO.	TOTAL SHEETS
UTAH	UTAH	1-15-8(2)334	2A	
REV. DATE 3/10/65				
REV. DATE 3/12/65				

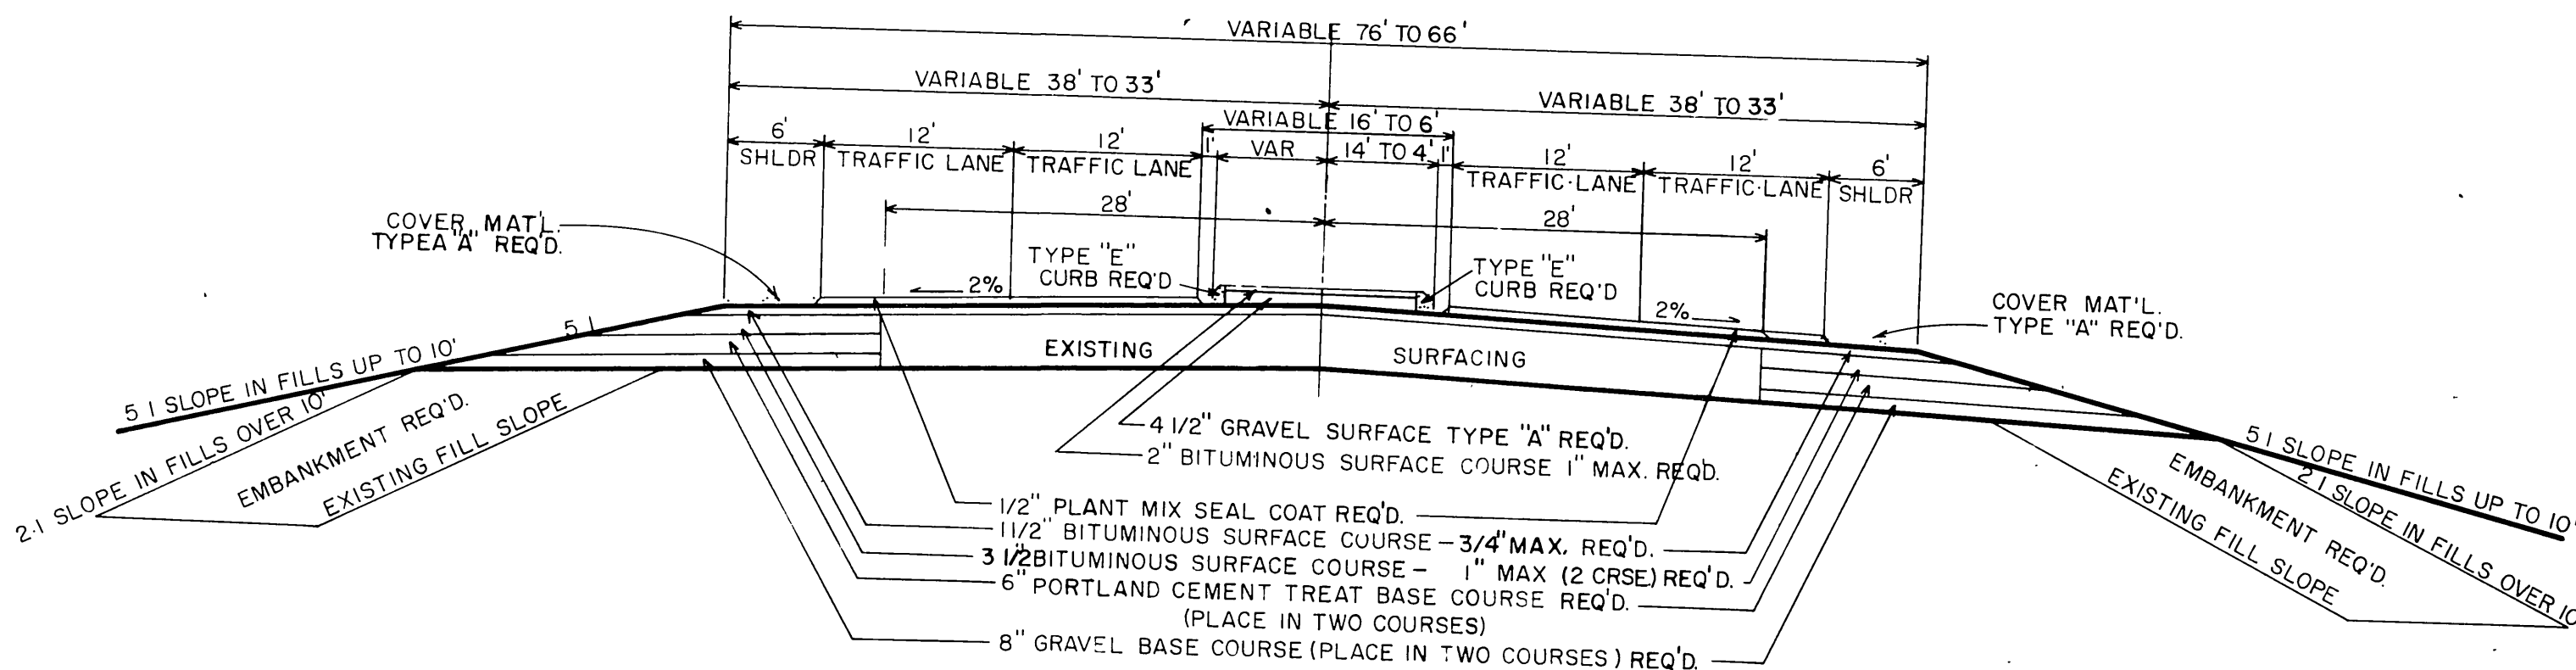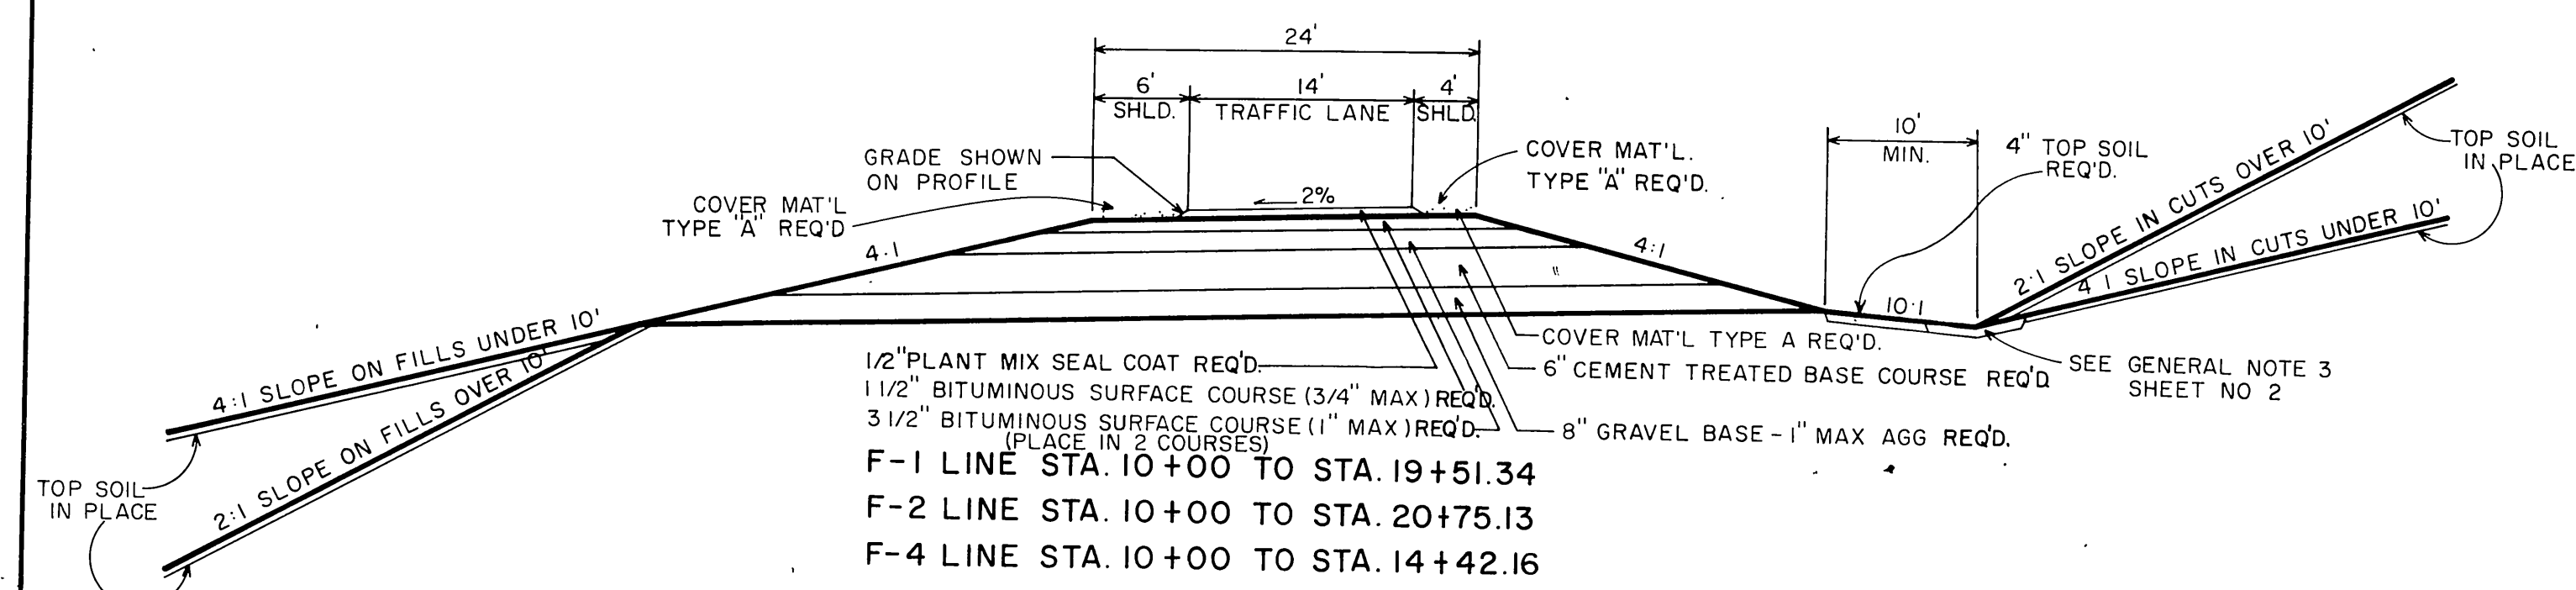



RIVERDALE ROAD
STA. 23+00 TO STA. 54+22

NOTE:
STA. 31+95 TO STA. 40+00 WHERE FINISHED GRADE IS HIGHER THAN THE EXISTING ROADWAY SURFACE EXTEND THE SHOULDER TREATMENT OVER THE EXISTING ROADWAY (AVE. DEPTH OF GRAVEL BASE COURSE IS 11" PLACE IN 3 COURSES)

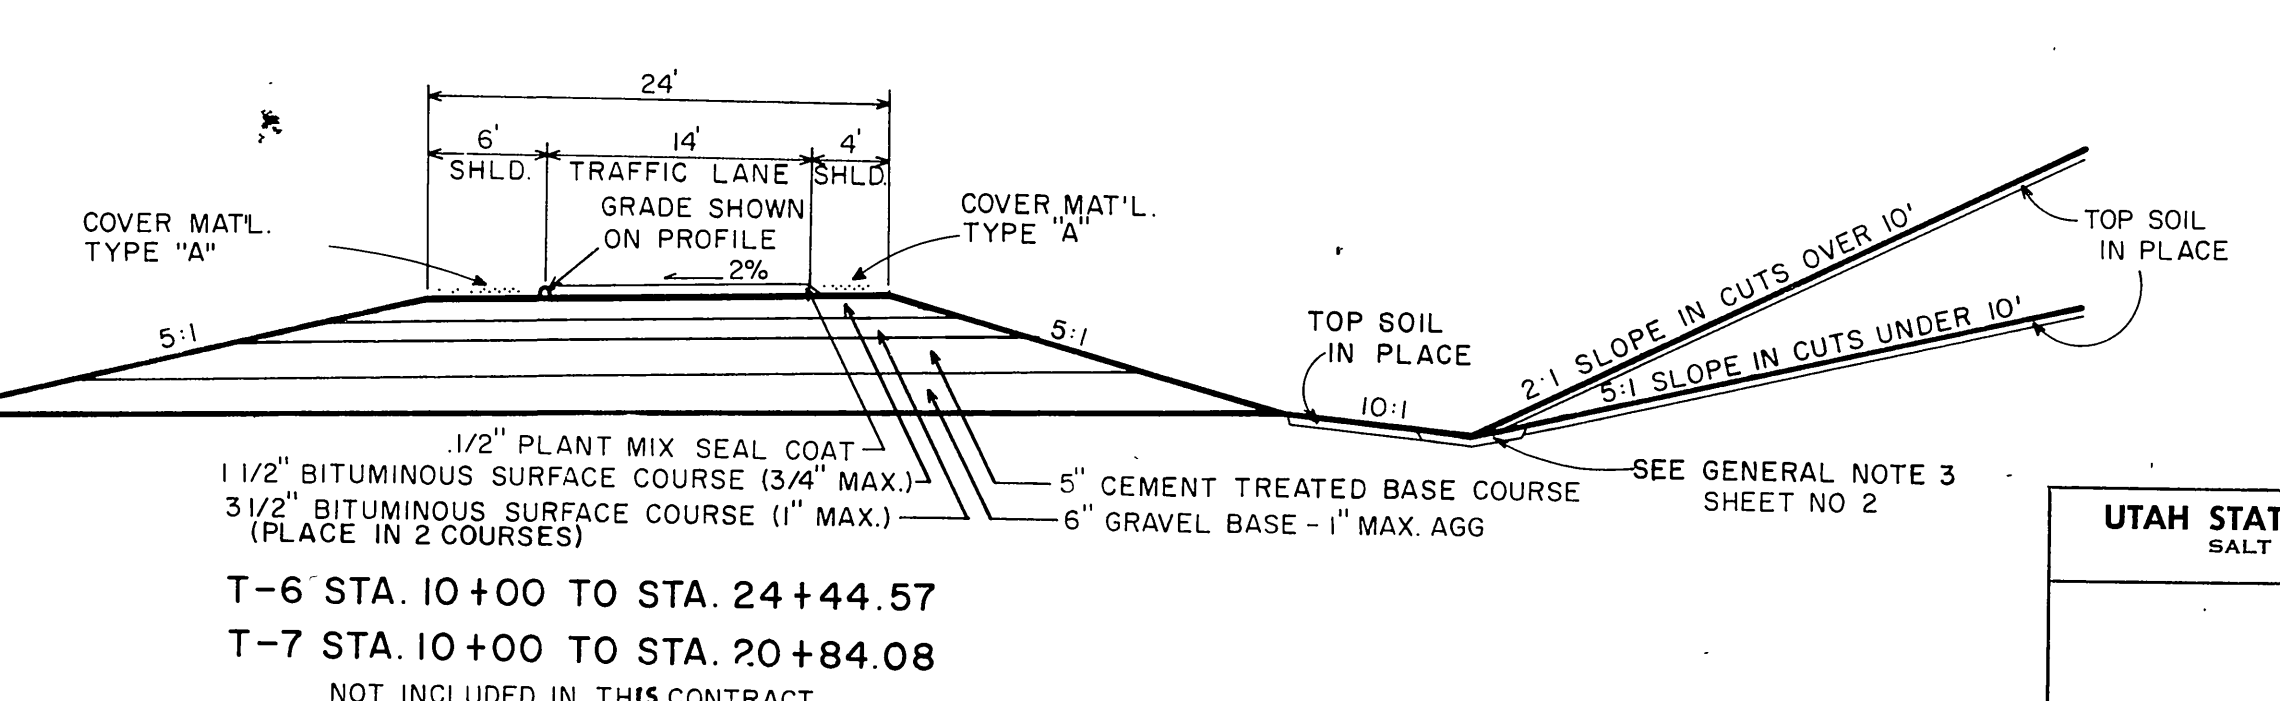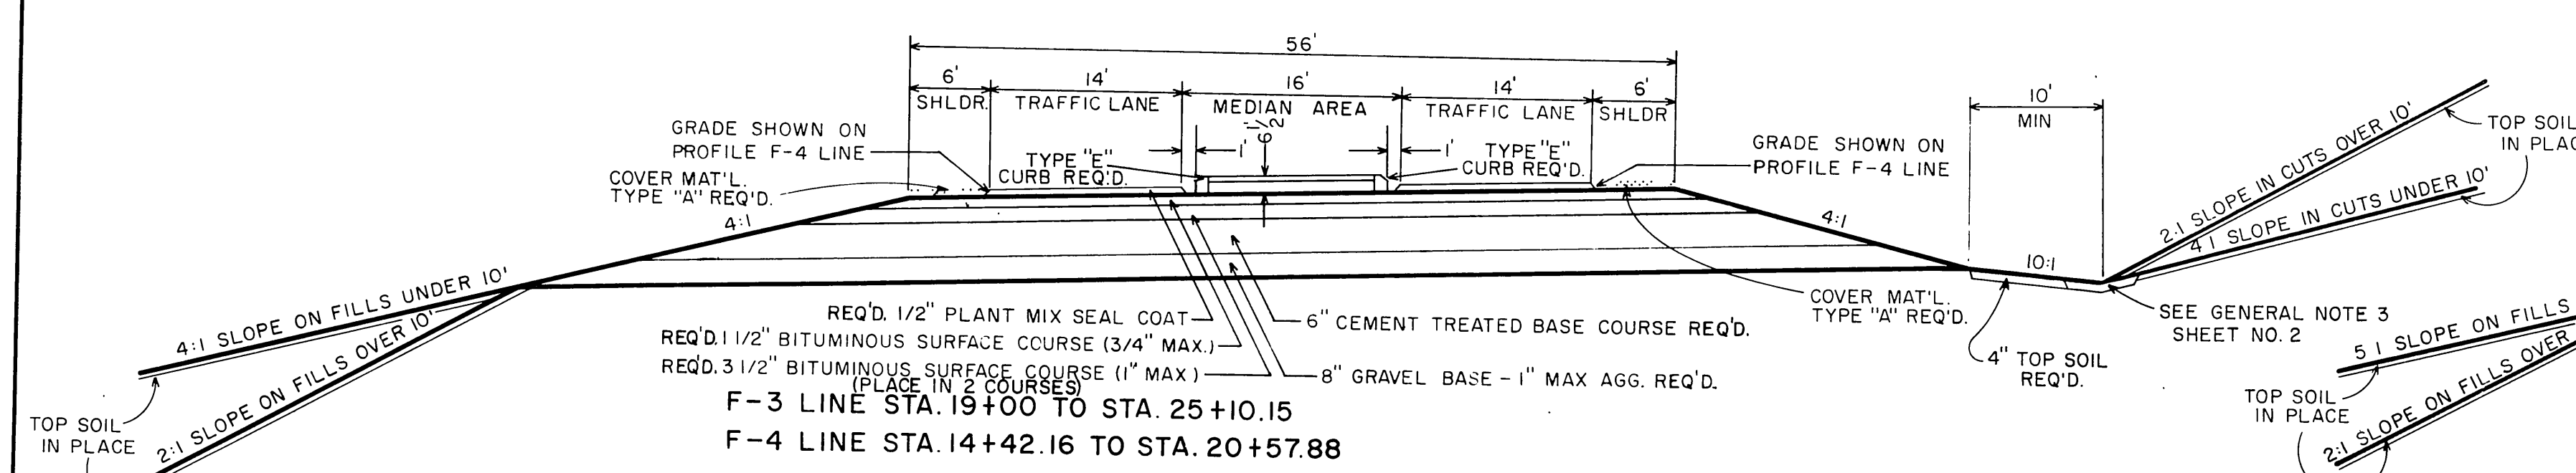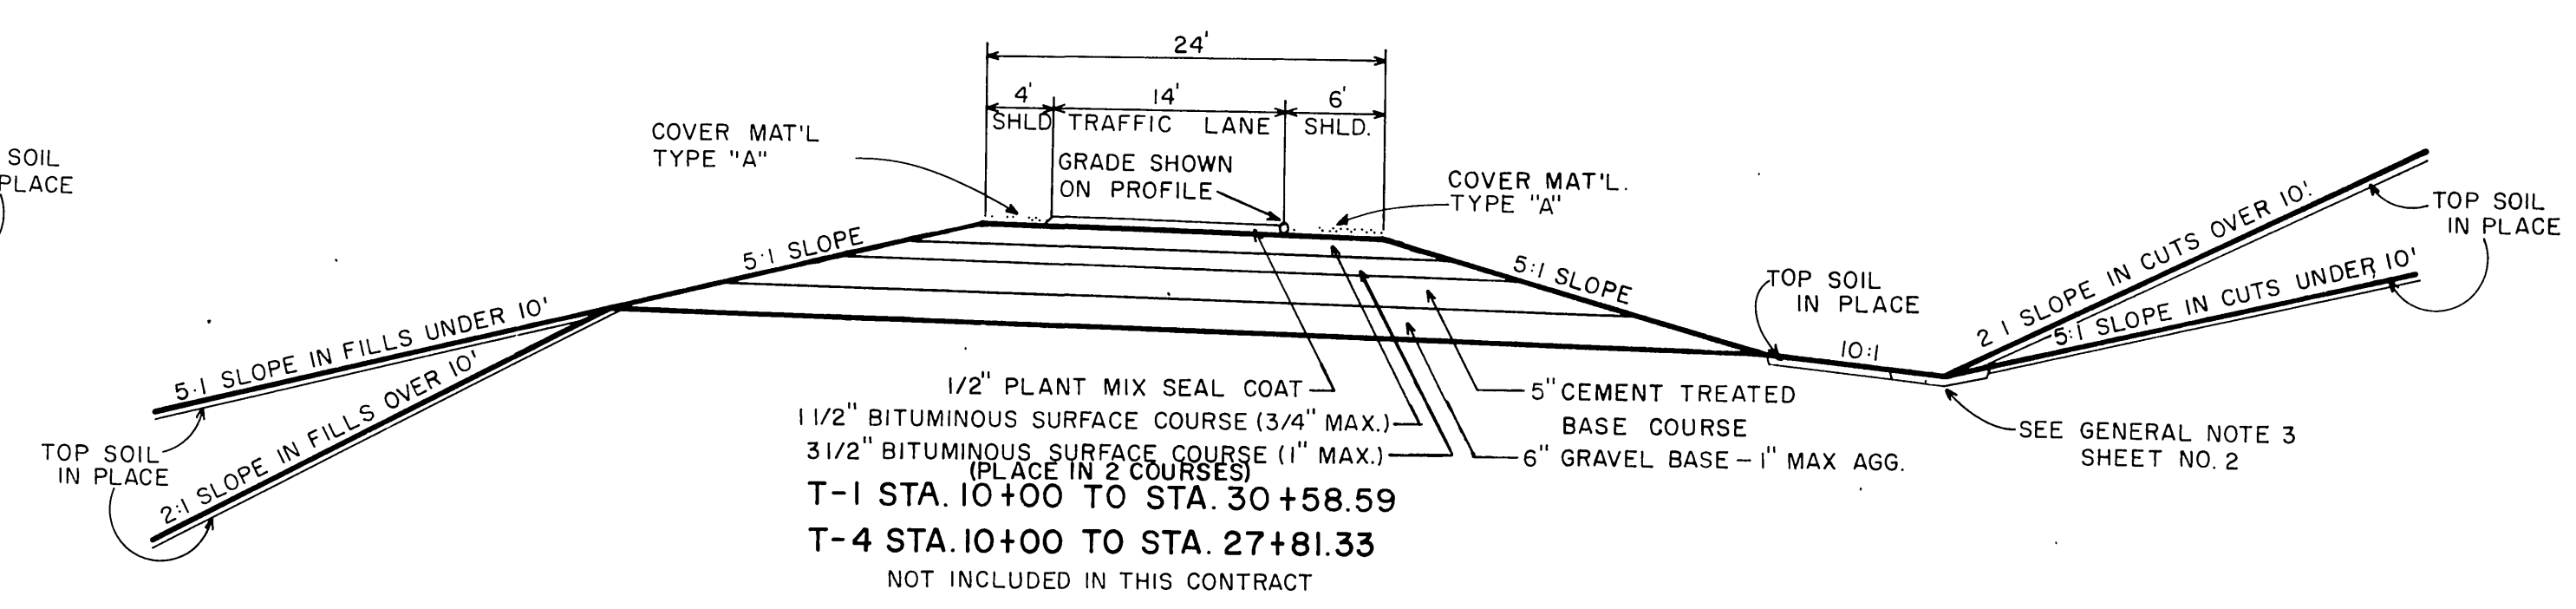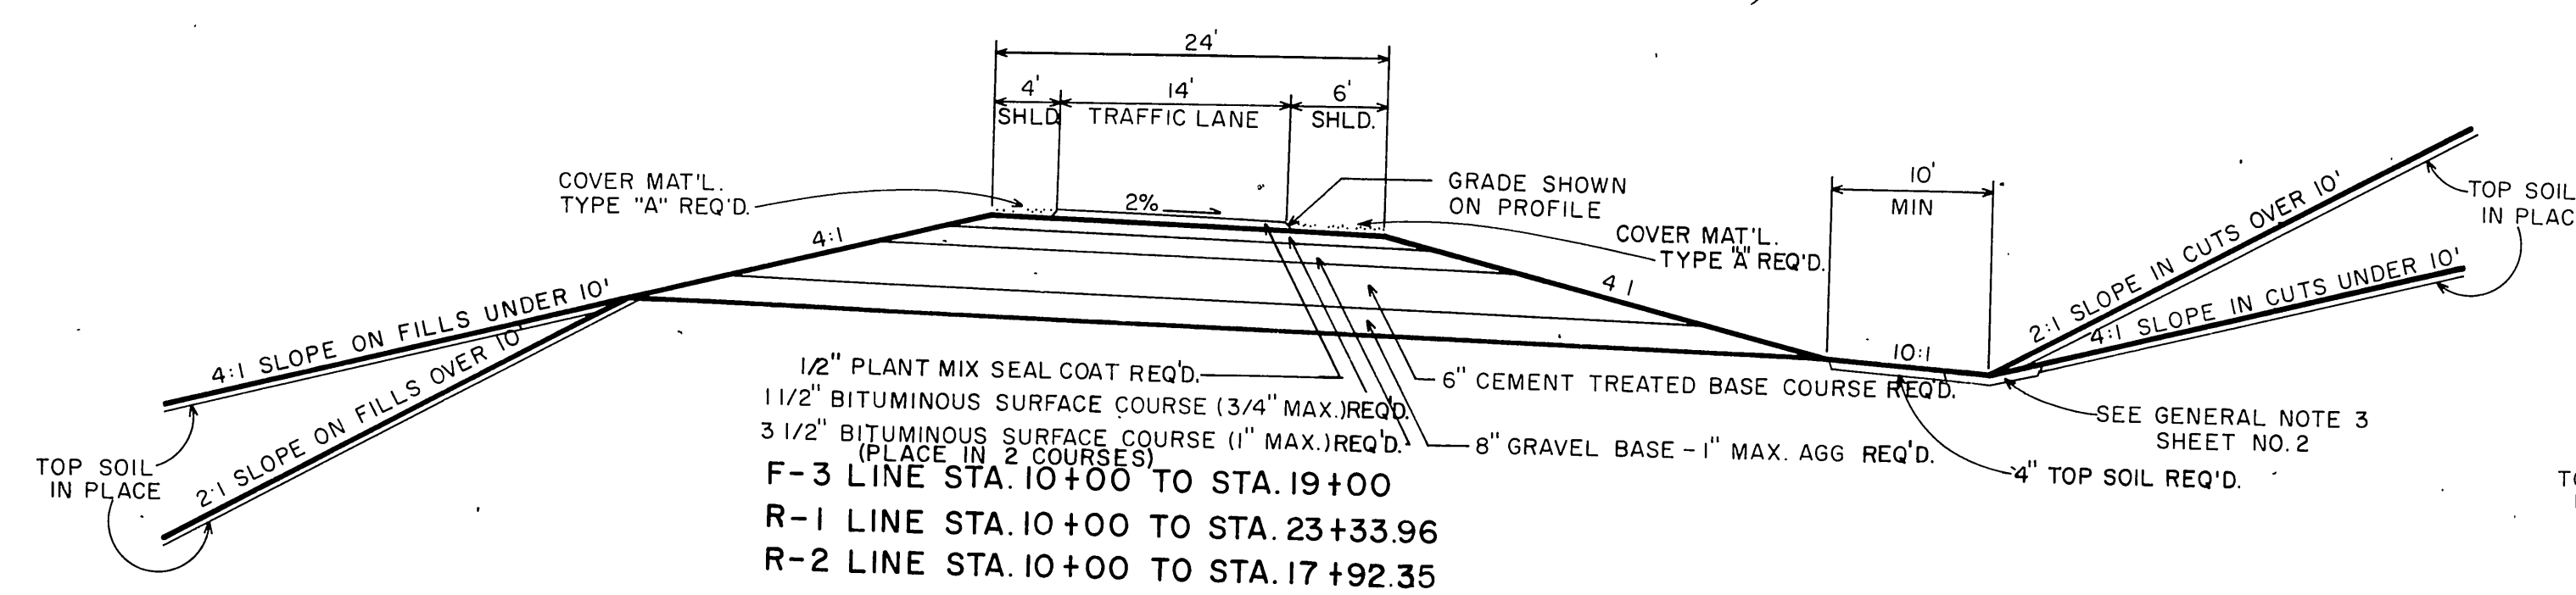

SHOULDER DRAIN

- 1 SHOULDER DRAIN SHALL BE PLACED IN CONJUNCTION WITH BITUMINOUS ROLLED GUTTER TO PREVENT EROSION OF THE FILL SLOPES.
- 2 WHEN DRAINS ARE PLACED AT INTERMEDIATE POINTS ON A GRADE, A 45° ELBOW SHALL BE USED TO PROVIDE A MORE DIRECT ENTRANCE.
- 3 THE BITUMINOUS ROLLED GUTTER AND SURFACING SHALL BE TRANSITIONED TO PROVIDE A GOOD ENTRANCE CONDITION. THE ENTRANCE SHALL BE LOWERED A MINIMUM OF 3" BELOW NORMAL GUTTER FLOWLINE.
- 4 SPACING SHALL BE DETERMINED FROM THE PLAN SHEETS UNLESS OTHERWISE DIRECTED BY THE PROJECT ENGINEER.
- 5 A BITUMINOUS DIKE SHALL BE PLACED ACROSS THE BITUMINOUS ROLLED GUTTER TO DIRECT THE DRAINAGE INTO THE SHOULDER DRAIN.
- 6 SHOULDER DRAIN INLET SHALL BE A STANDARD METAL END SECTION WITH 1/2" STEEL WANS BOLTED OR WELDED ON 5' CENTERS. AS PER STD. DWG NO. 347
- 7 RIPRAP SHALL BE PLACED IN A FANSHAPED HOLE ONE FOOT DEEP, REQUIRING 2.00 CU YD PER END SEC.

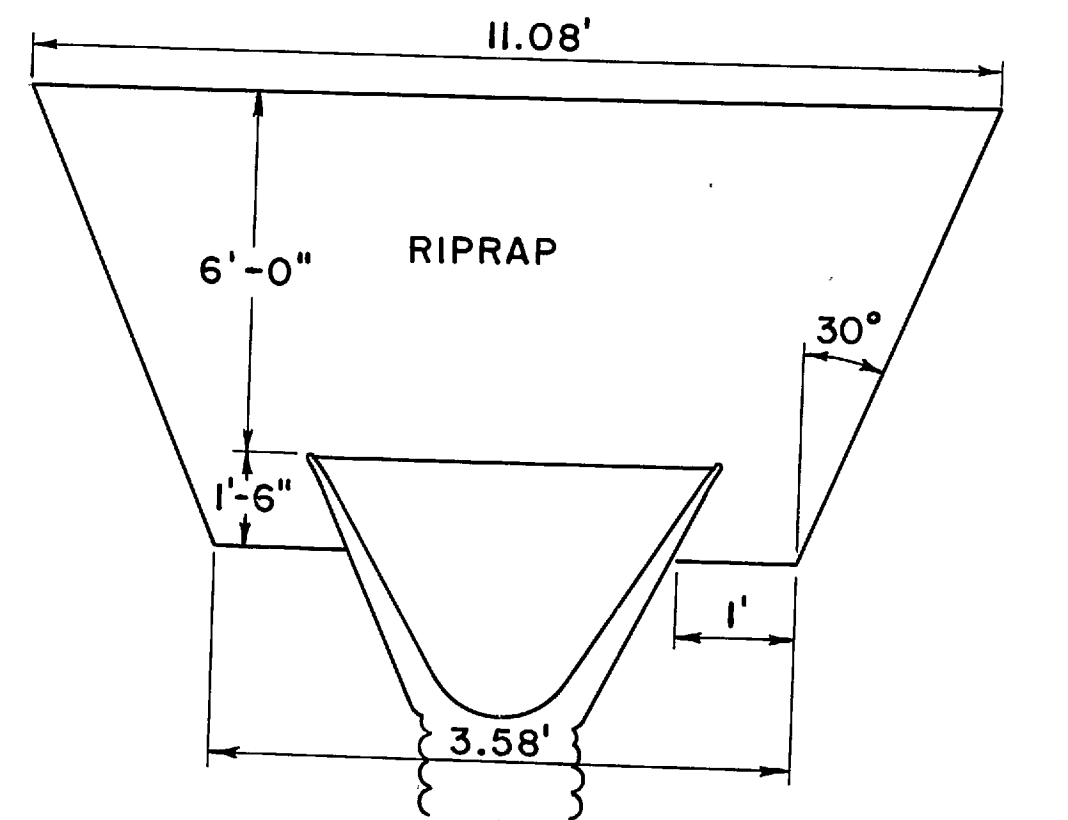
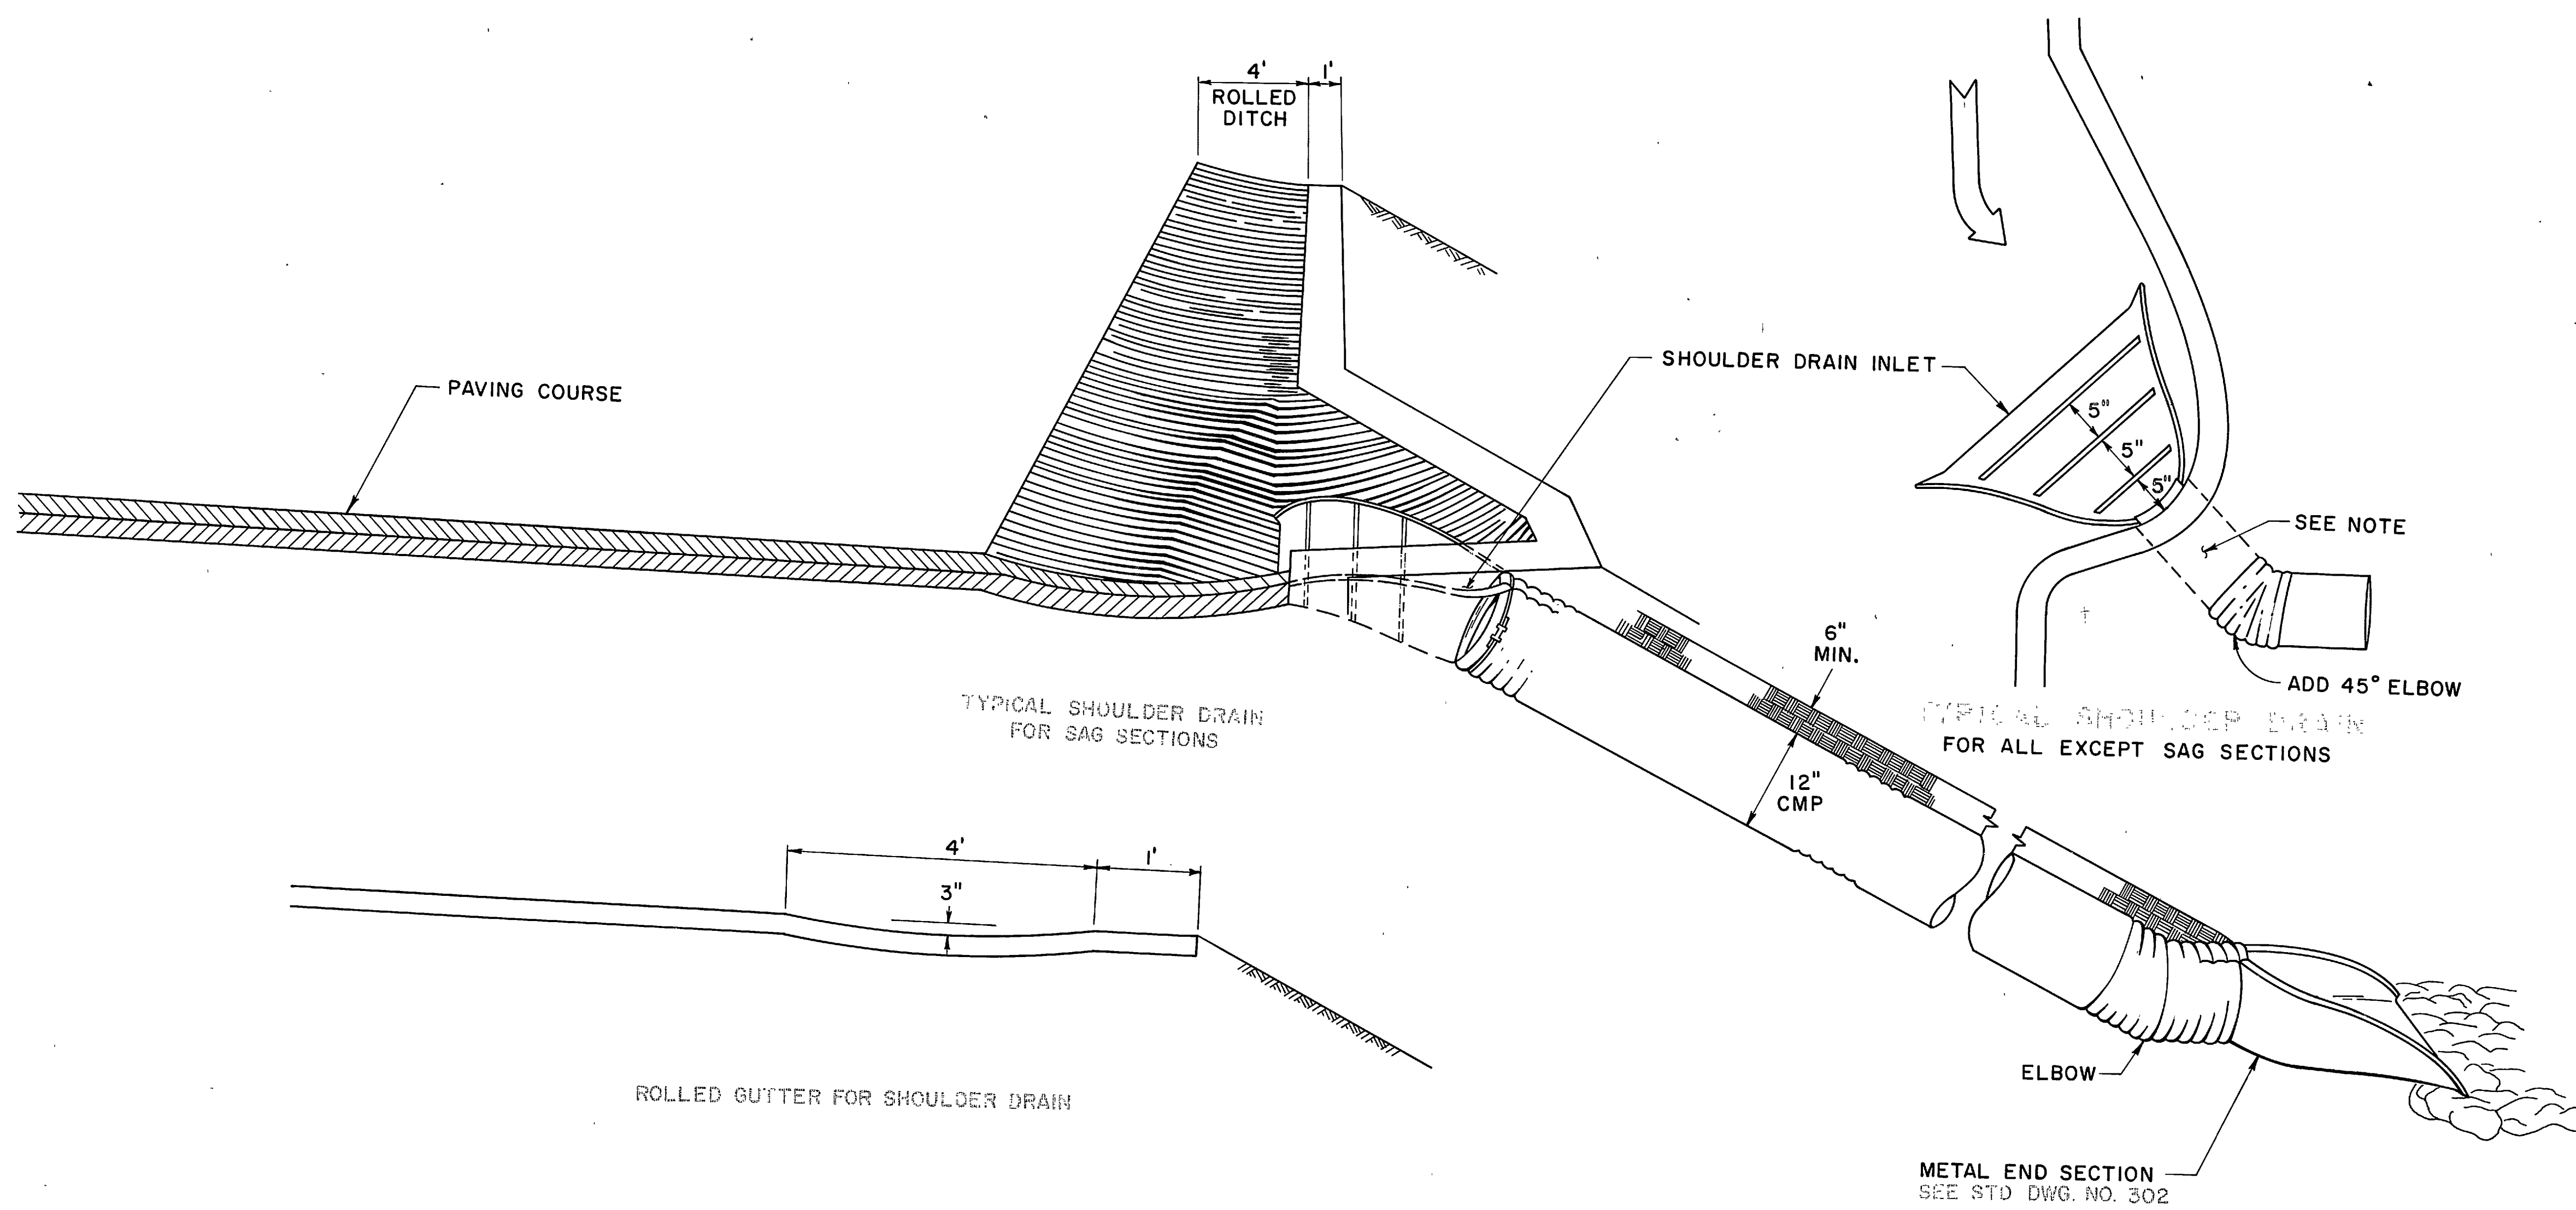


GENERAL NOTE:
FOR LOCATIONS OF BITUMINOUS ROLLED
GUTTER SEE SHEET NO 3 AND
SHOULDER DRAINS, SEE SUMMARY SHEET 3B


SLOPE PROTECTION FOR MAJOR STRUCTURES DETAIL FOR STATIONS SEE SUMMARY SHEET NO. 3C

FED. ROAD DIST. NO.	STATE	PROJ. NO.	SHEET NO.	TOTAL SHEETS
UTAH	UTAH	I-15-8(21)334	2C	


REV. DATE 3/10/65

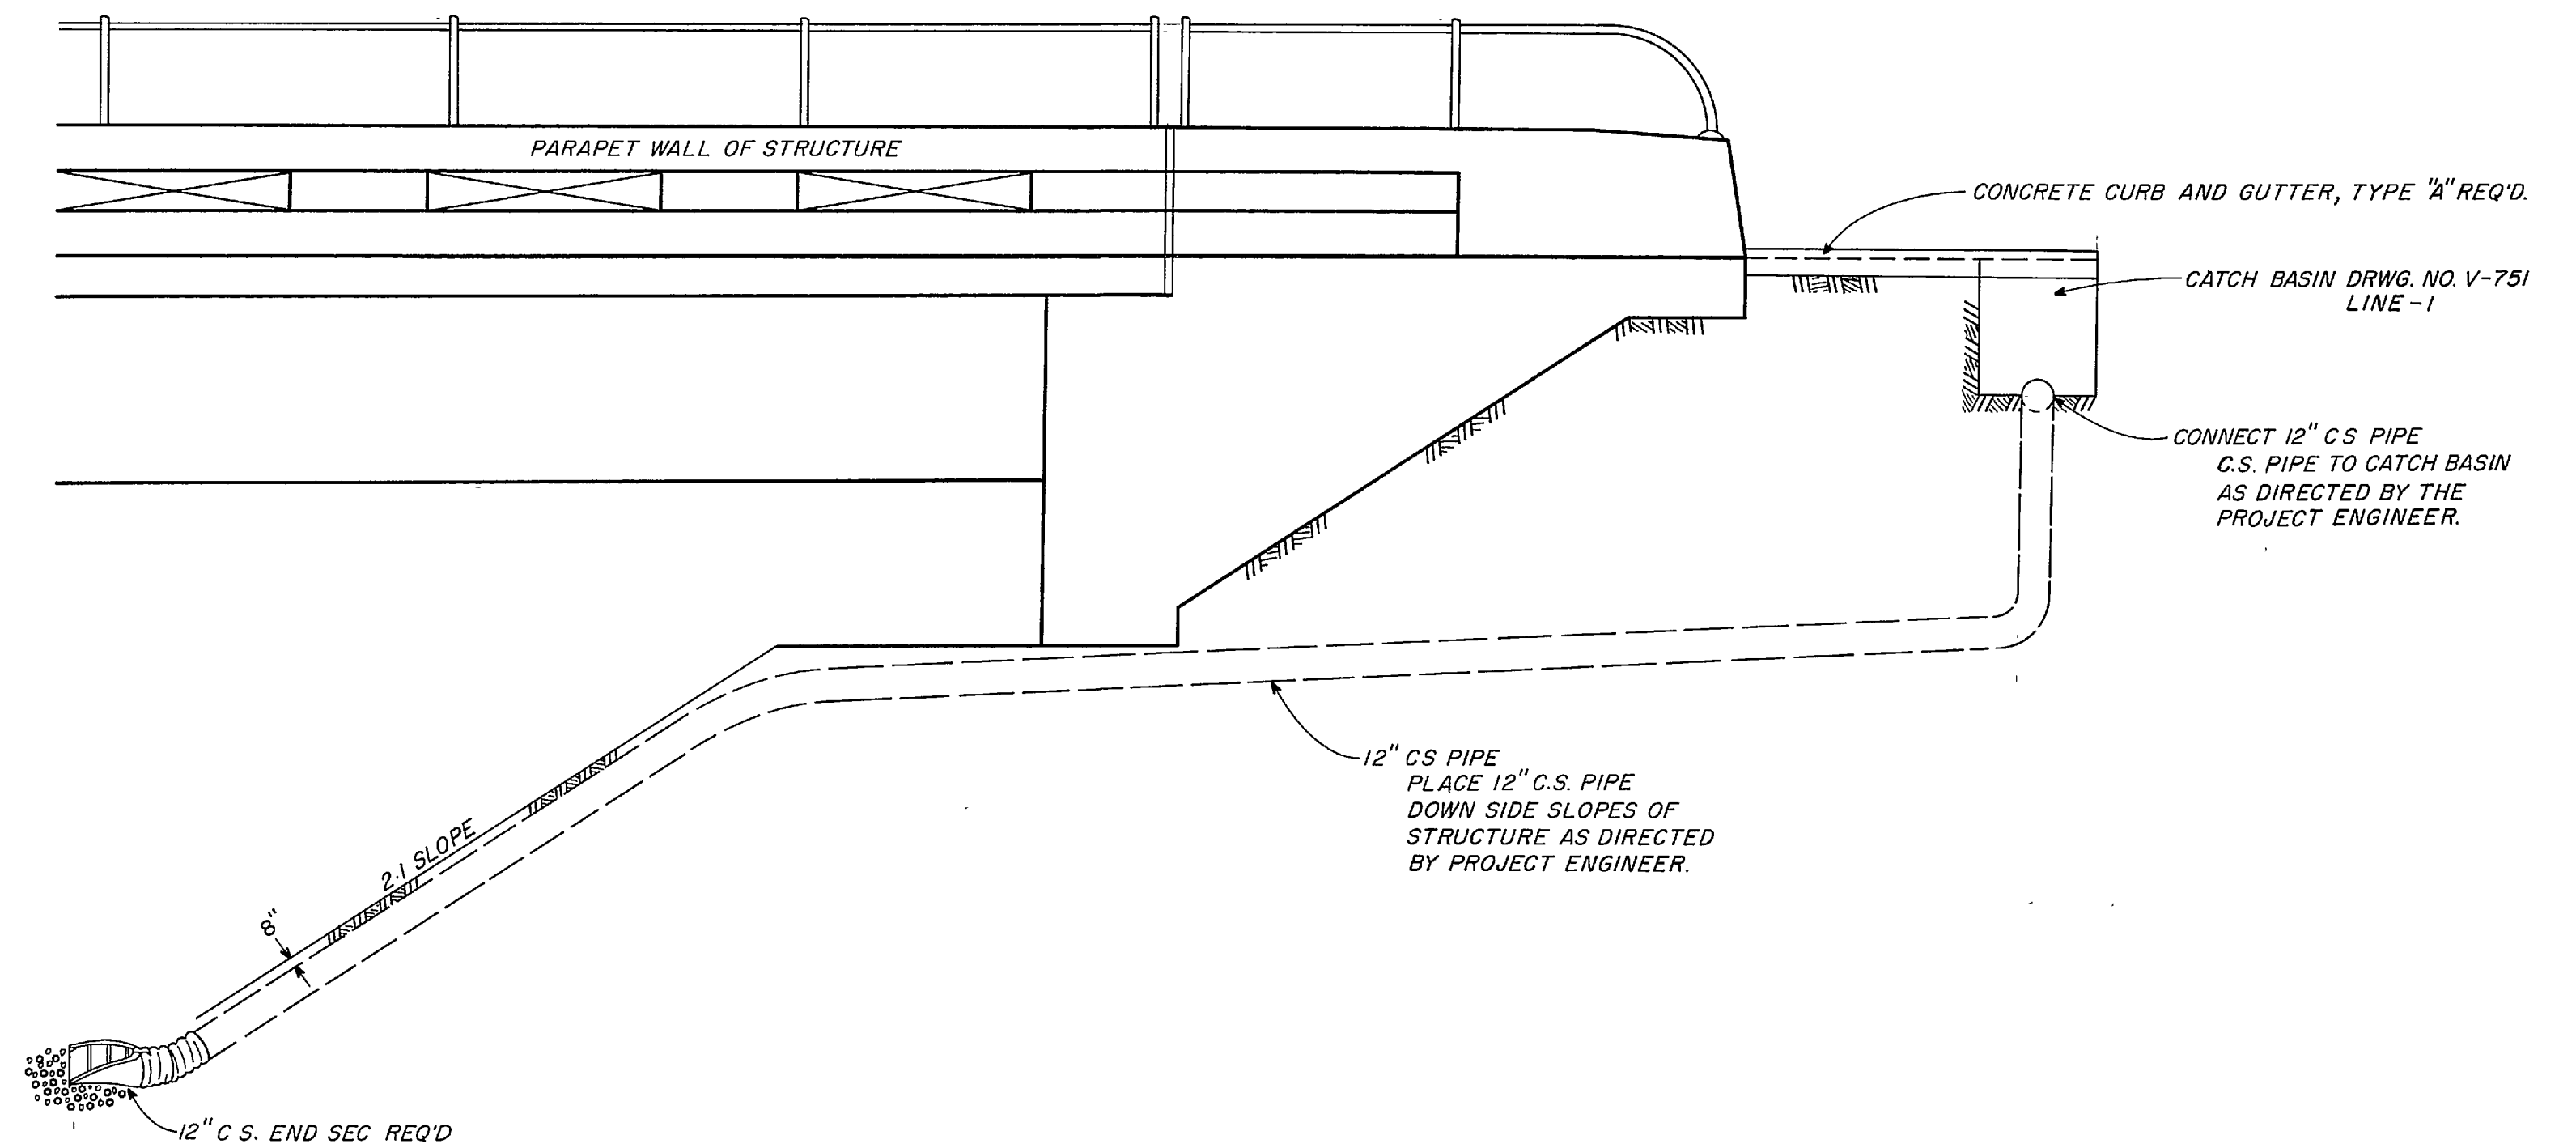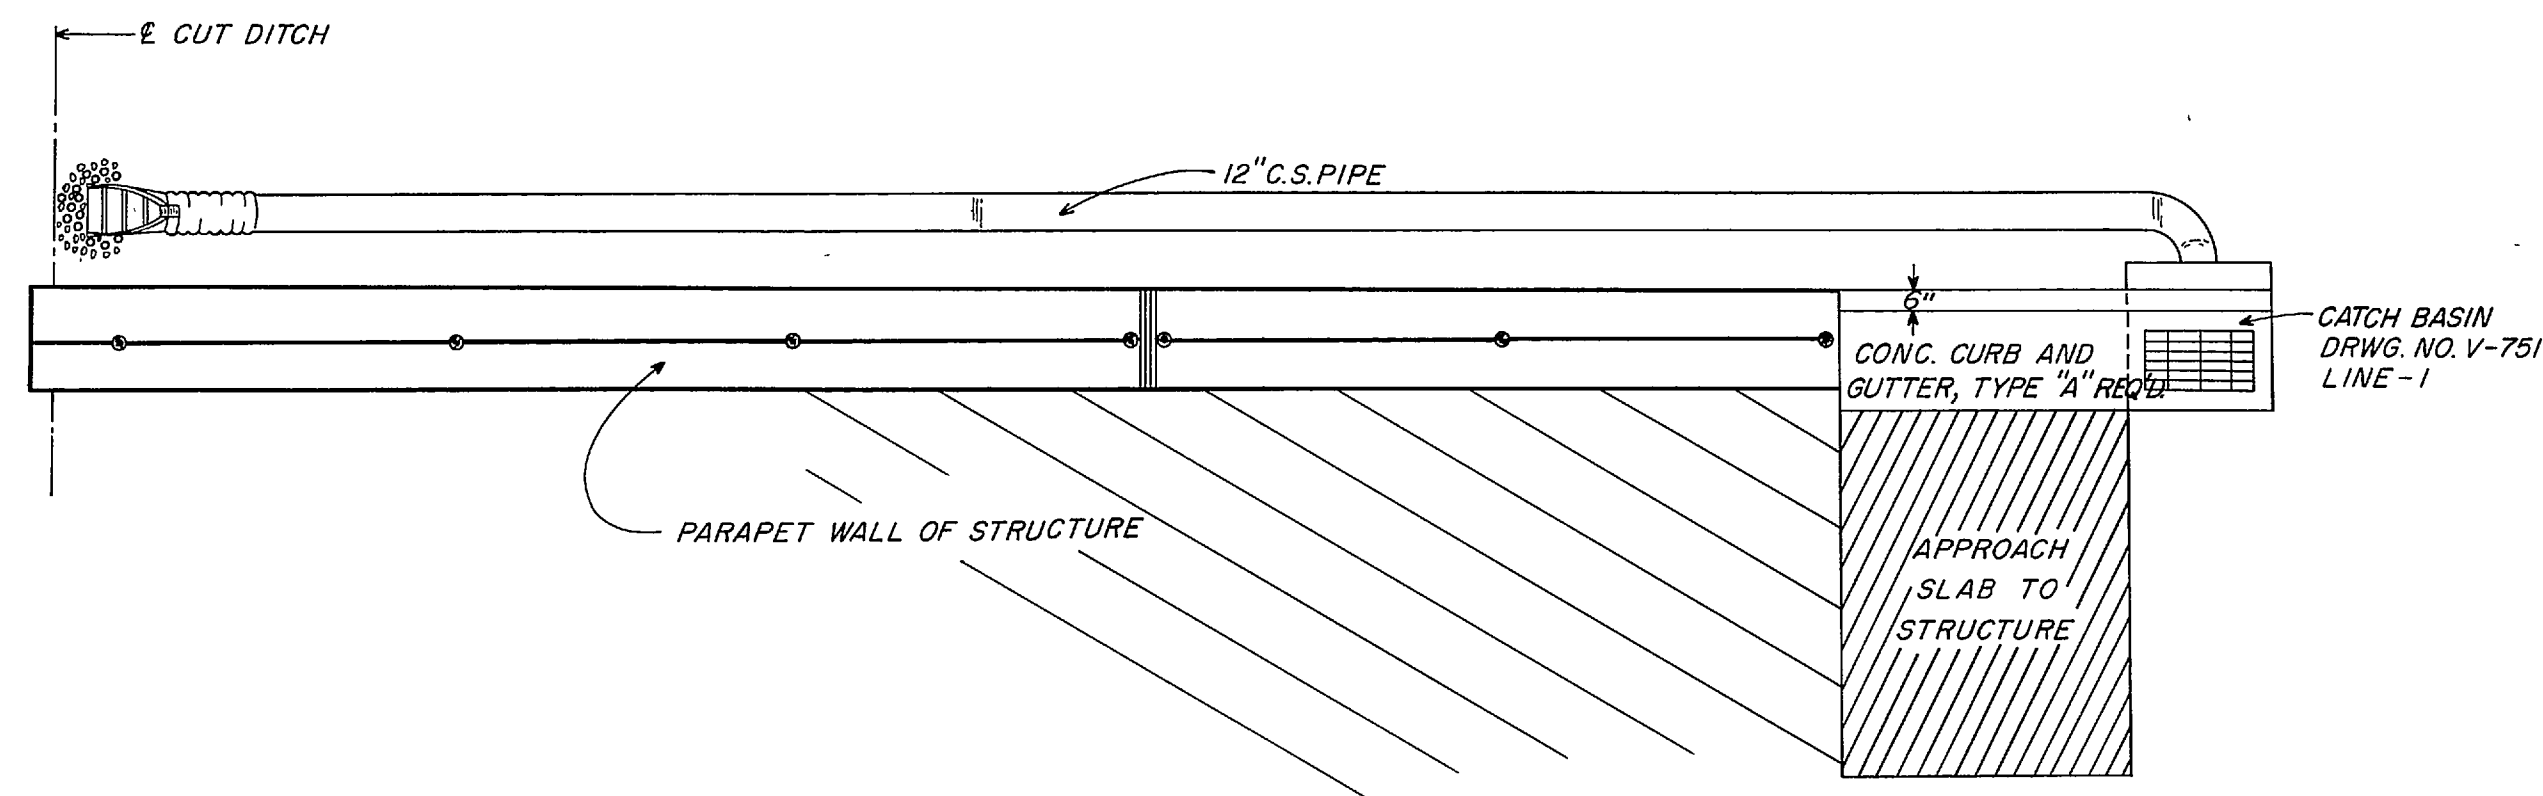



REVISIONS	DATE	BY

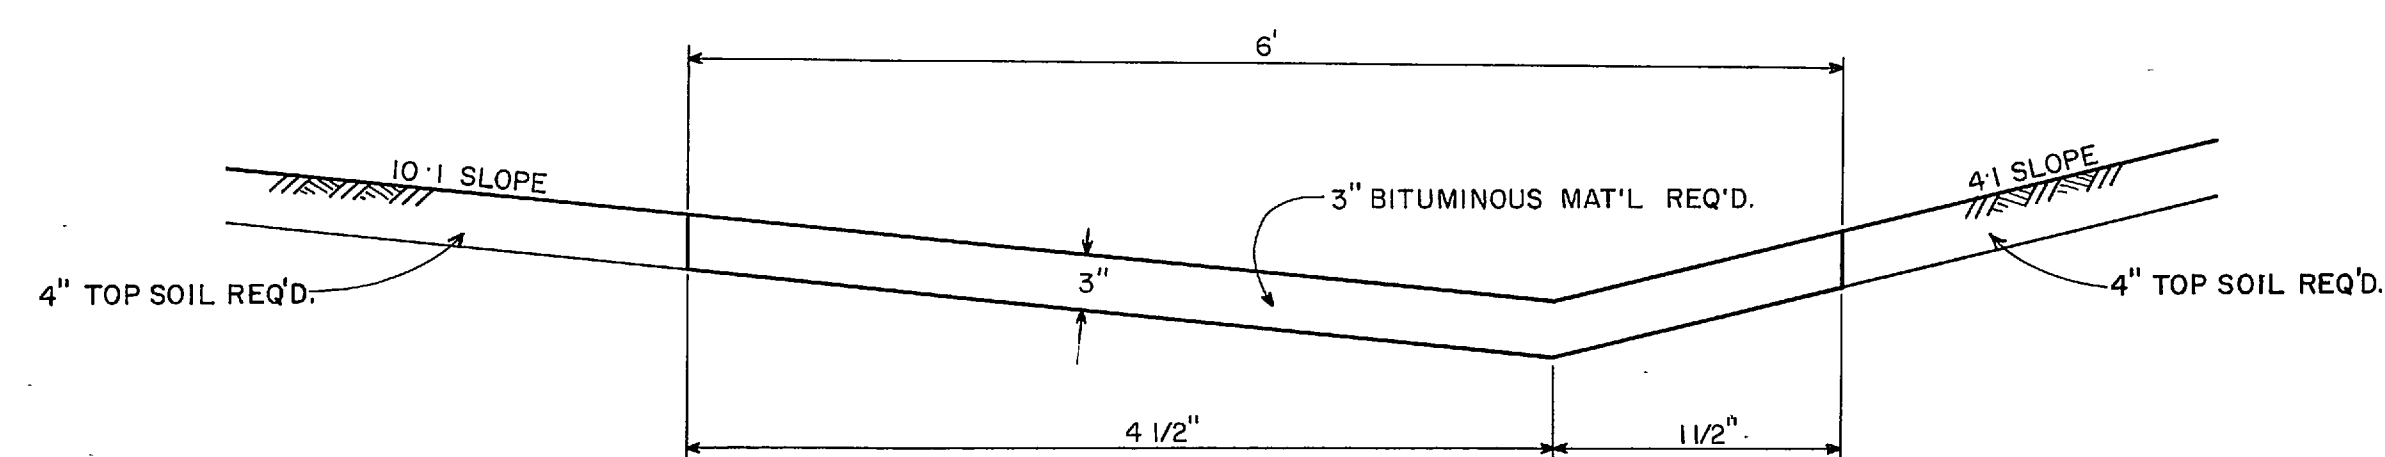

TYPICAL SECTION FOR PAVED CUT DITCH
FOR PLACING OF PAVED CUT DITCH
SEE SUMMARY SHEET NO. 3
FOR BITUMINOUS MATERIAL QUANTITIES
SEE SURF. SUM. SHEET NO. 3A

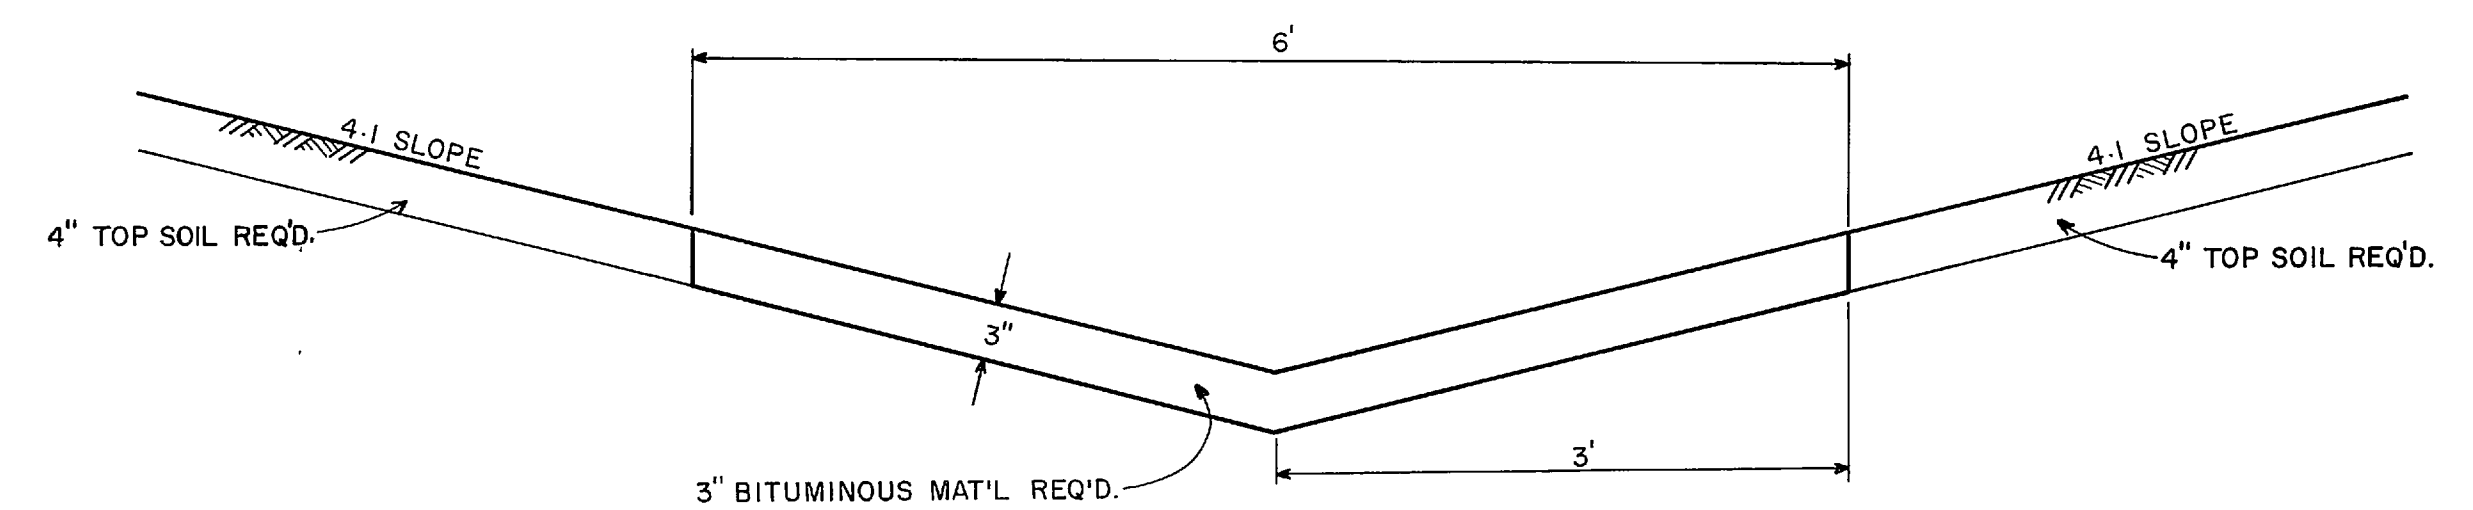


TYPICAL SECTION FOR PAVED MEDIAN DITCH
FOR PLACING OF PAVED MED DITCH
SEE SUMMARY SHEET NO. 3

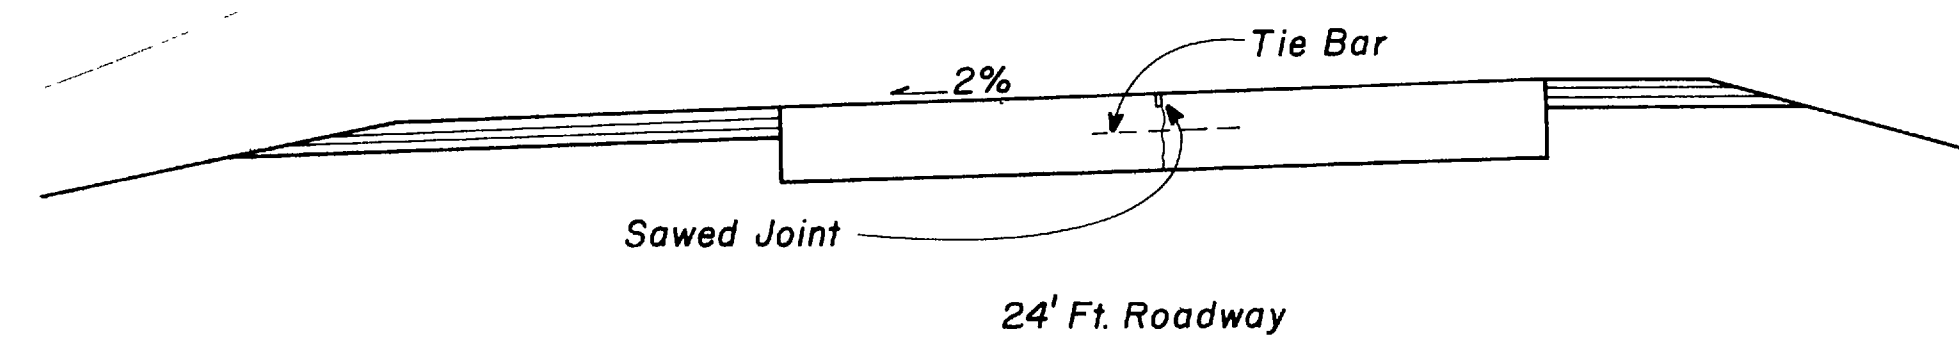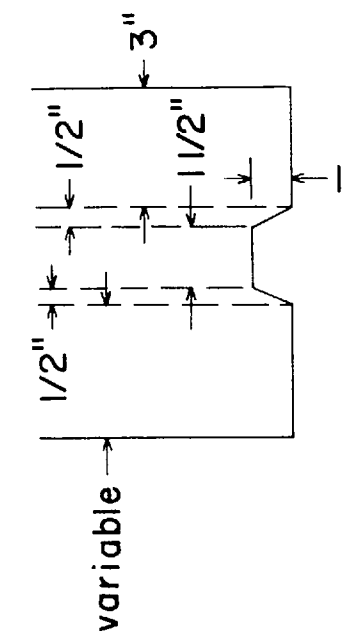
REV DATE 3/10/65

GUARDRAIL INSTALLATION STRUCTURES


PROJ. ROAD DIST. NO.	STATE	PROJ. NO.	SHEET NO.	TOTAL SHEETS
UTAH	UTAH	1-15-8(2)334	2 E	

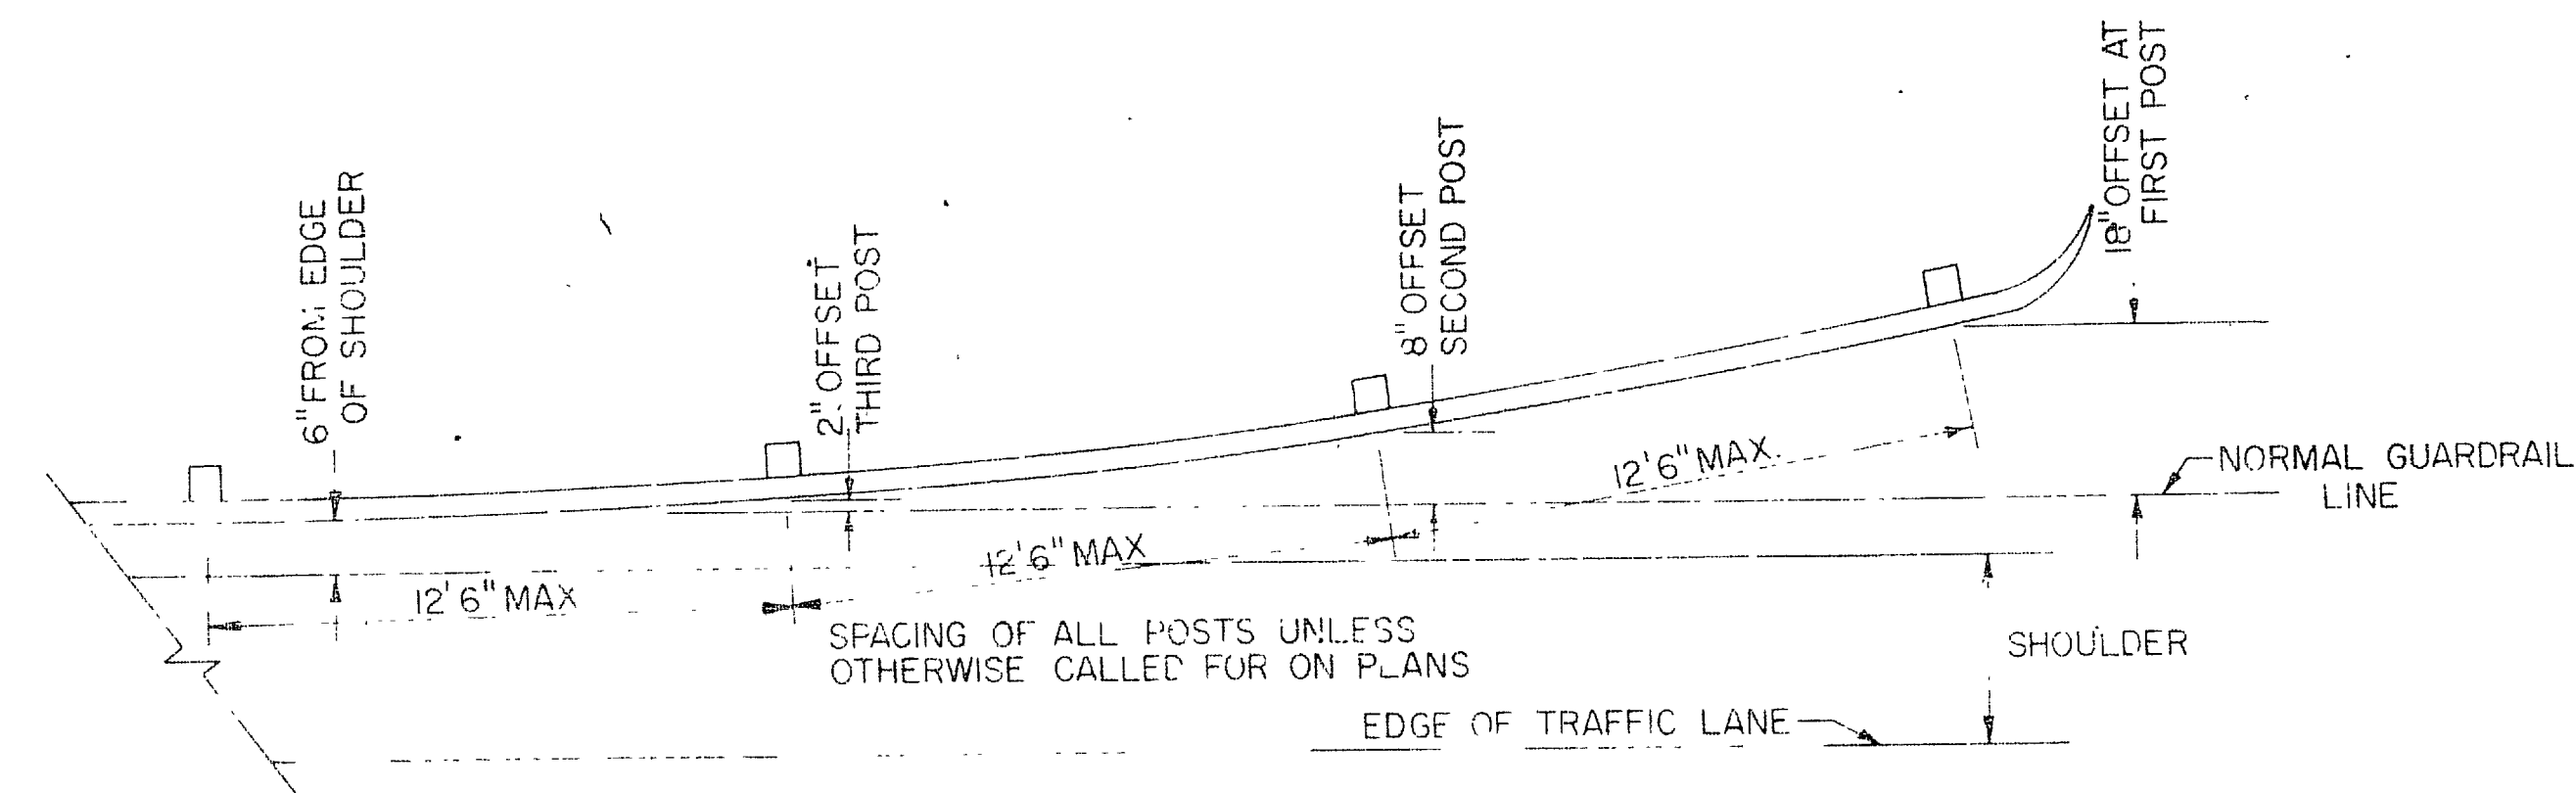


TYPICAL INSTALLATION FOR ROADWAY APPROACH TERMINAL

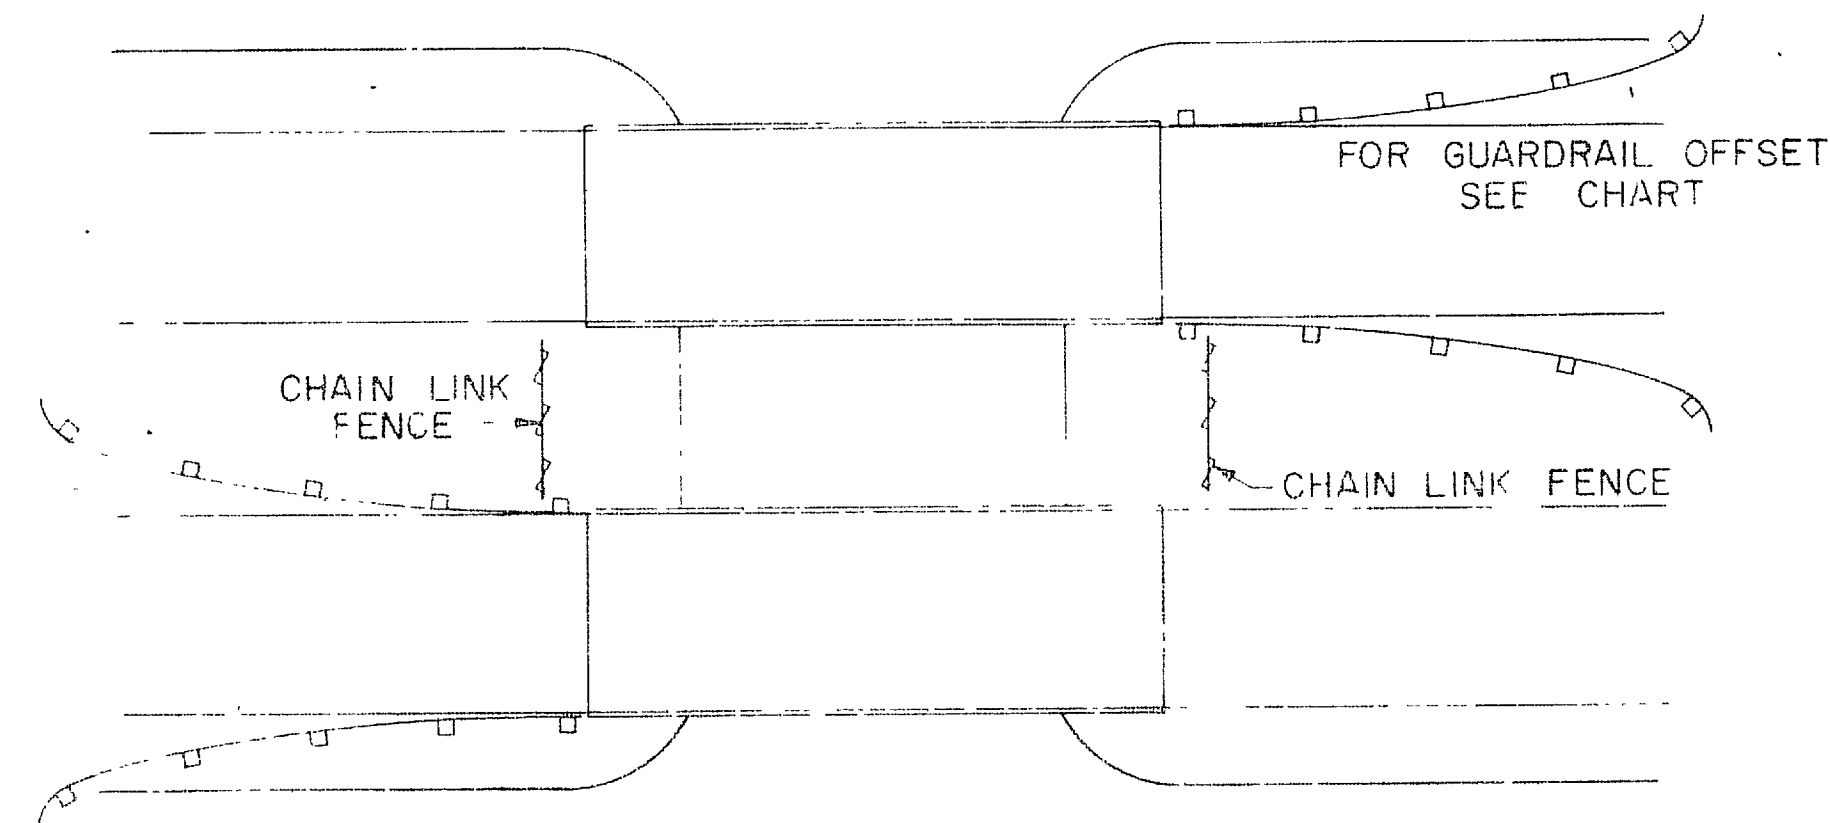


MEDIAN TREATMENT AT OVERPASS

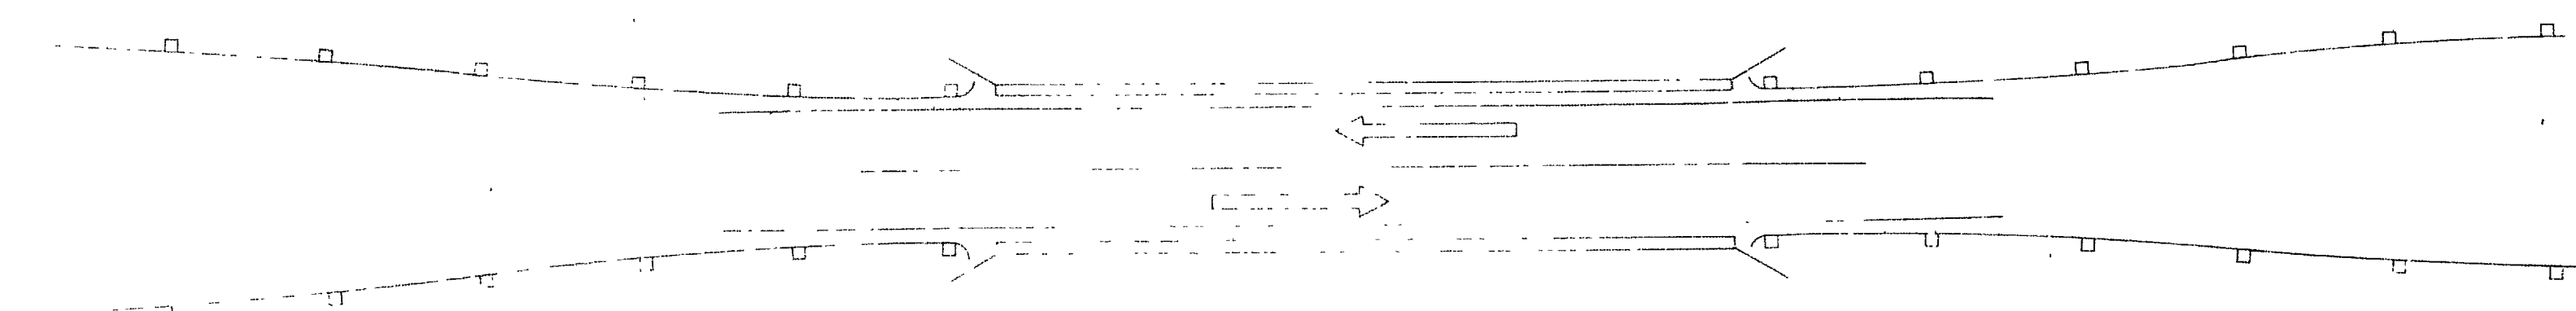


TWO WAY STRUCTURE

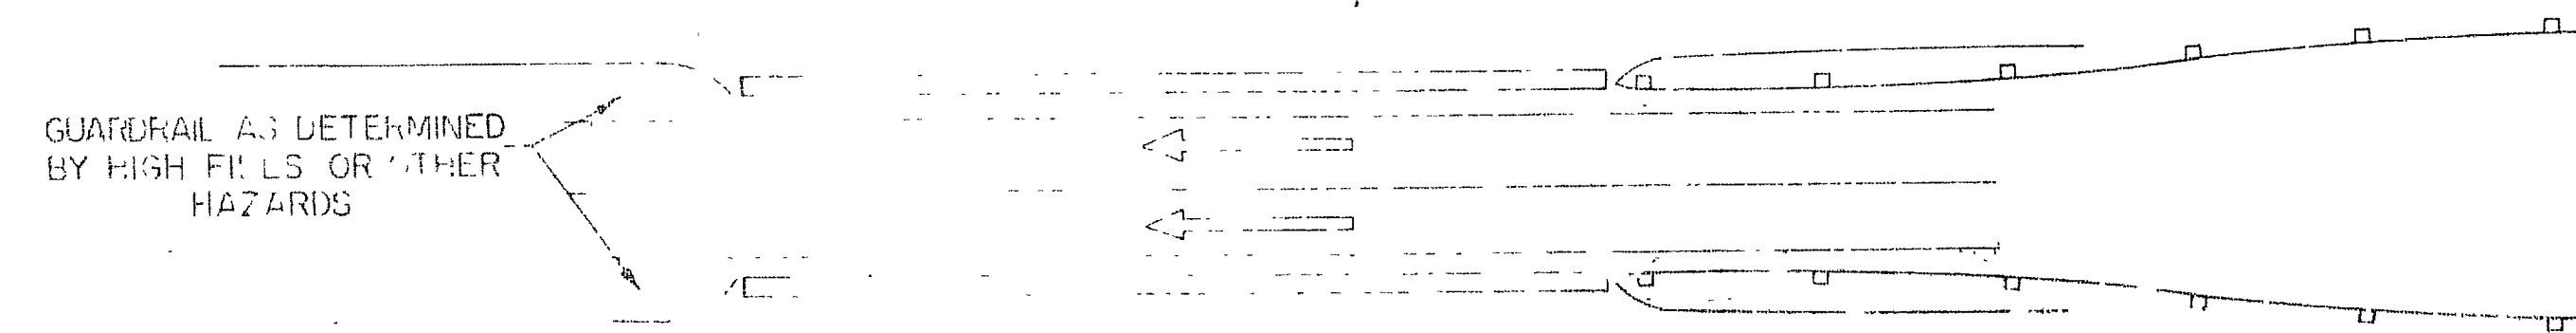

ONE WAY STRUCTURE

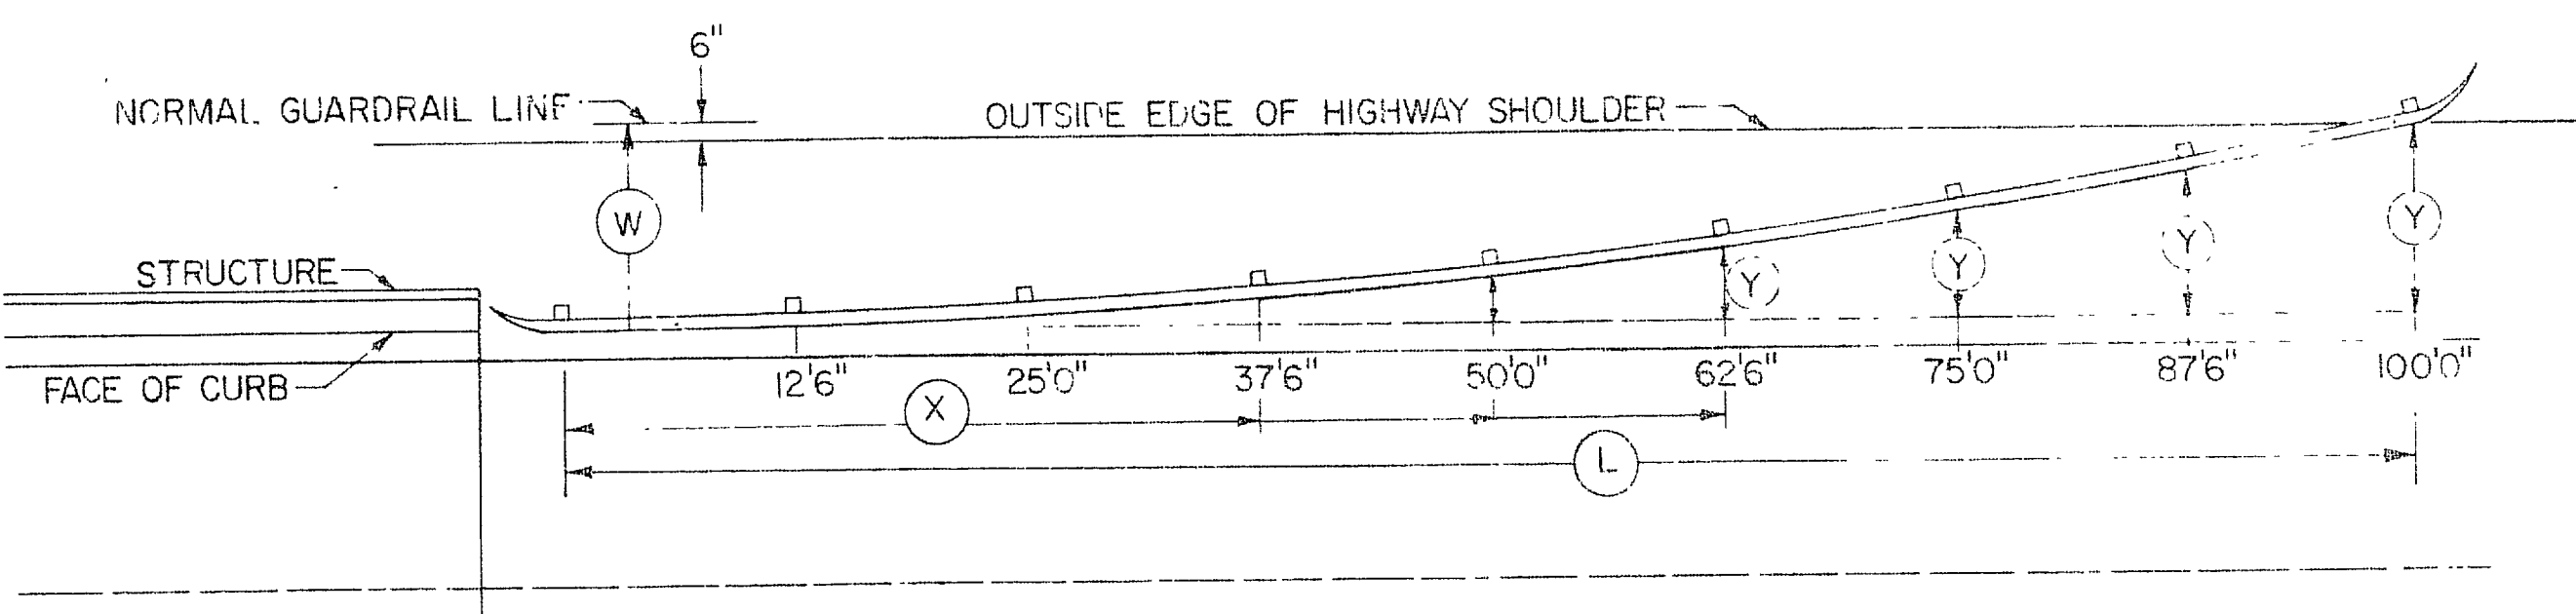


W = OFFSET FROM BRIDGE CURB TO NORMAL GUARDRAIL LINE
L = LENGTH OF GUARDRAIL
 $Y = W \frac{X^2}{L^2}$ X = DISTANCE FROM BEGINNING OF GUARDRAIL AT BRIDGE
Y = OFFSET AT EACH POINT

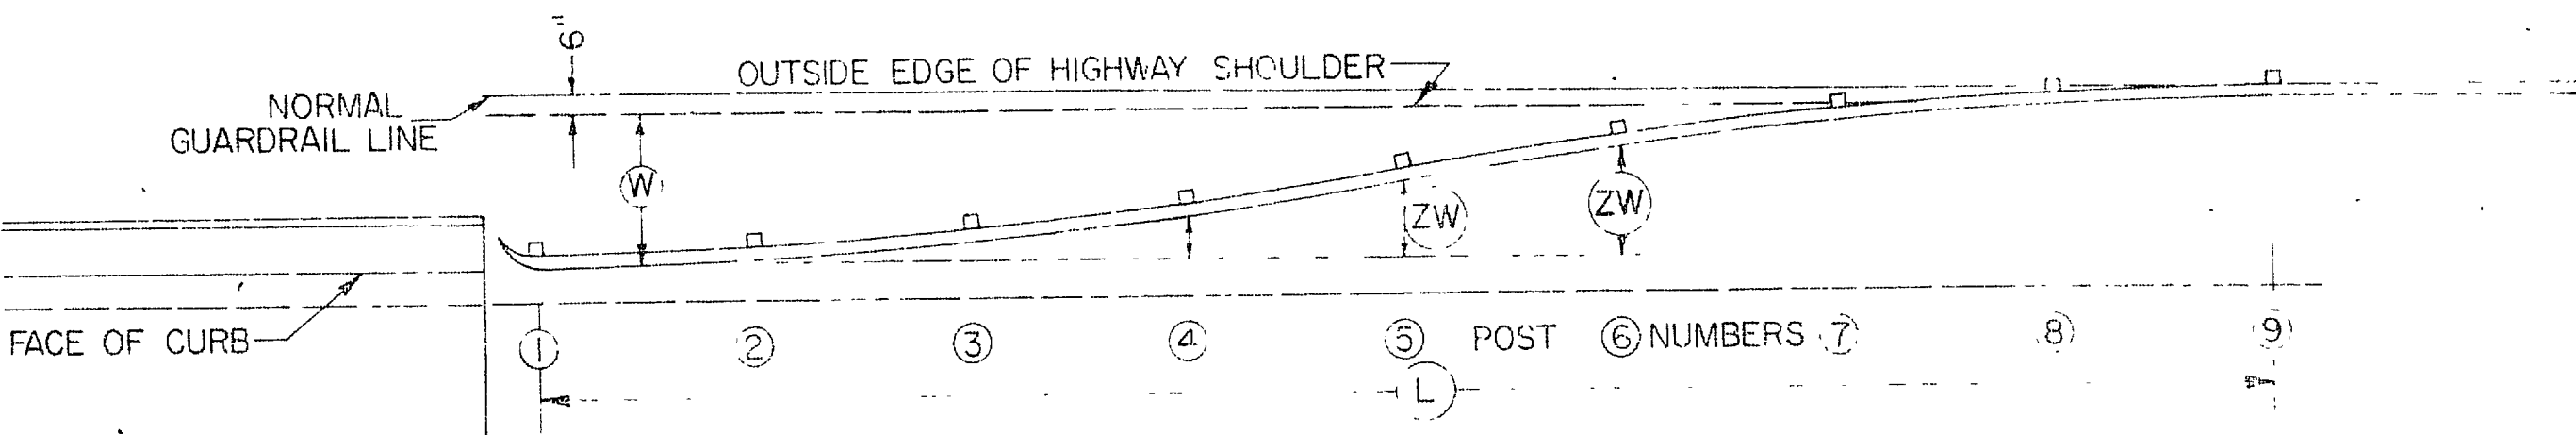


		Z = % OF TOTAL OFFSET FOR EACH POST																
		POST NUMBERS (12' 6" MAXIMUM SPACING)																
W	L	1	2	3	4	5	6	7	8	9	10	11	12	13	14	15	16	17
0-4'	50	0	12.5	30.0	87.5	100												
4'-6'	100	0	3.0	12.5	28.0	50.0	72.0	87.5	97.0	100								
OVER 6'	200	0	0.8	3.1	7.0	12.5	19.5	28.2	38.3	50.0	61.7	71.8	80.5	87.5	93.0	96.9	99.2	100
Z = % OF TOTAL OFFSET (W) FOR EACH POST																		
W = TOTAL WIDTH OF OFFSET FROM NORMAL GUARDRAIL LINE TO FACE OF CURB																		
L = TRANSITION LENGTH																		

TYPICAL STRUCTURE APPROACH INSTALLATION

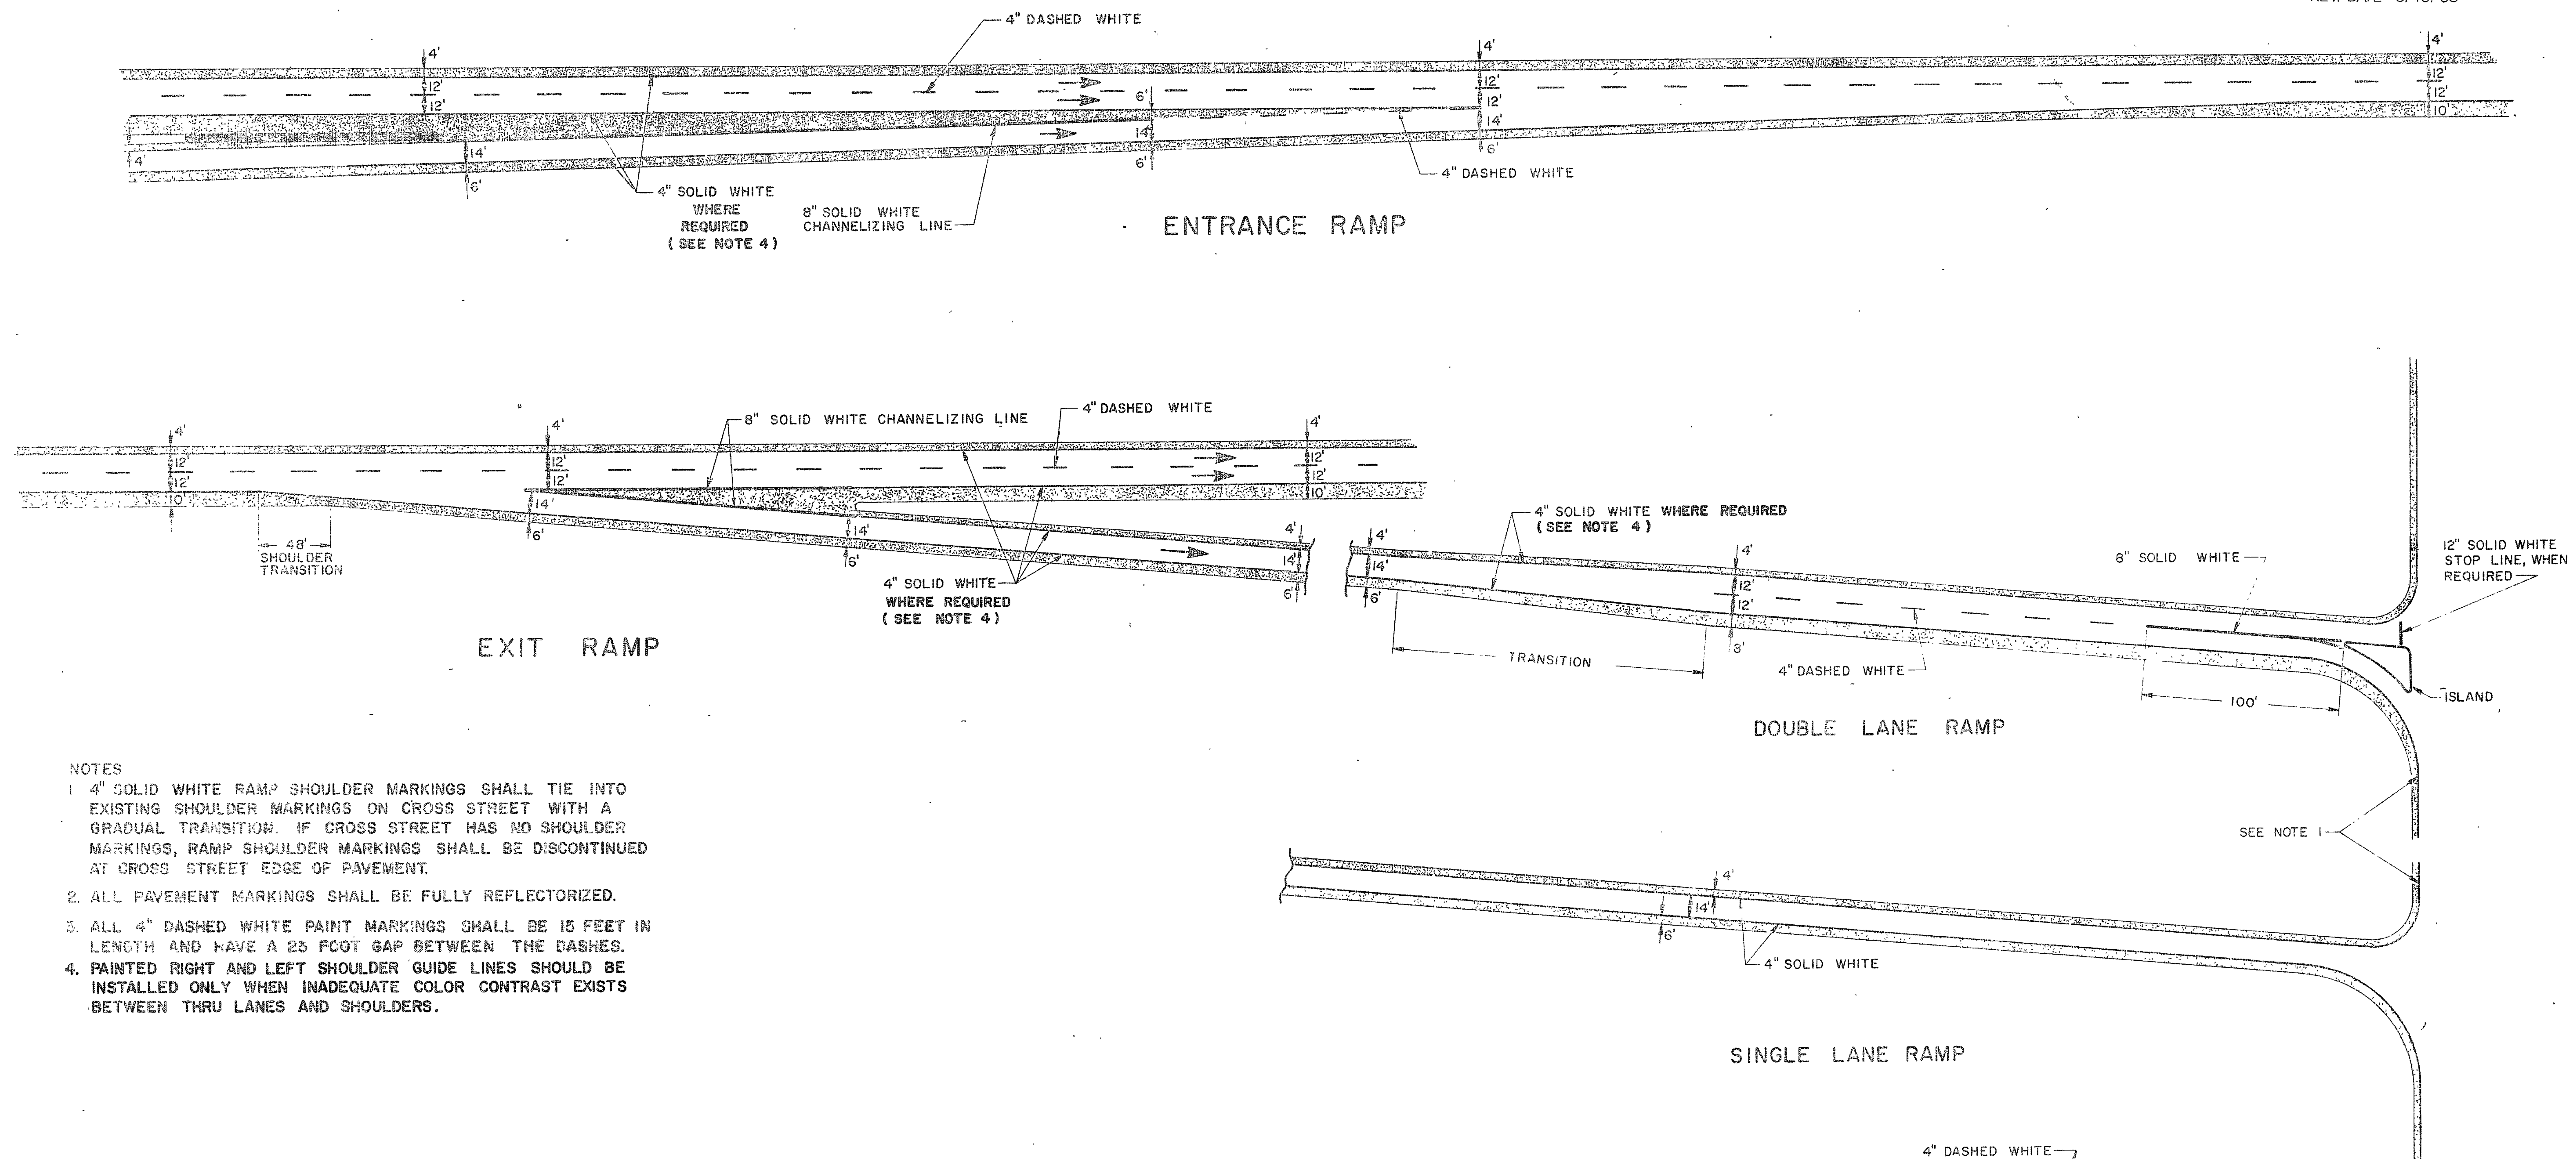


NOTES


1. 4" SOLID WHITE RAMP SHOULDER MARKINGS SHALL TIE INTO EXISTING SHOULDER MARKINGS ON CROSS STREET WITH A GRADUAL TRANSITION. IF CROSS STREET HAS NO SHOULDER MARKINGS, RAMP SHOULDER MARKINGS SHALL BE DISCONTINUED AT CROSS STREET EDGE OF PAVEMENT.
2. ALL PAVEMENT MARKINGS SHALL BE FULLY REFLECTORIZED.
3. ALL 4" DASHED WHITE PAINT MARKINGS SHALL BE 15 FEET IN LENGTH AND HAVE A 25 FOOT GAP BETWEEN THE DASHES.
4. PAINTED RIGHT AND LEFT SHOULDER GUIDE LINES SHOULD BE INSTALLED ONLY WHEN INADEQUATE COLOR CONTRAST EXISTS BETWEEN THRU LANES AND SHOULDERS.

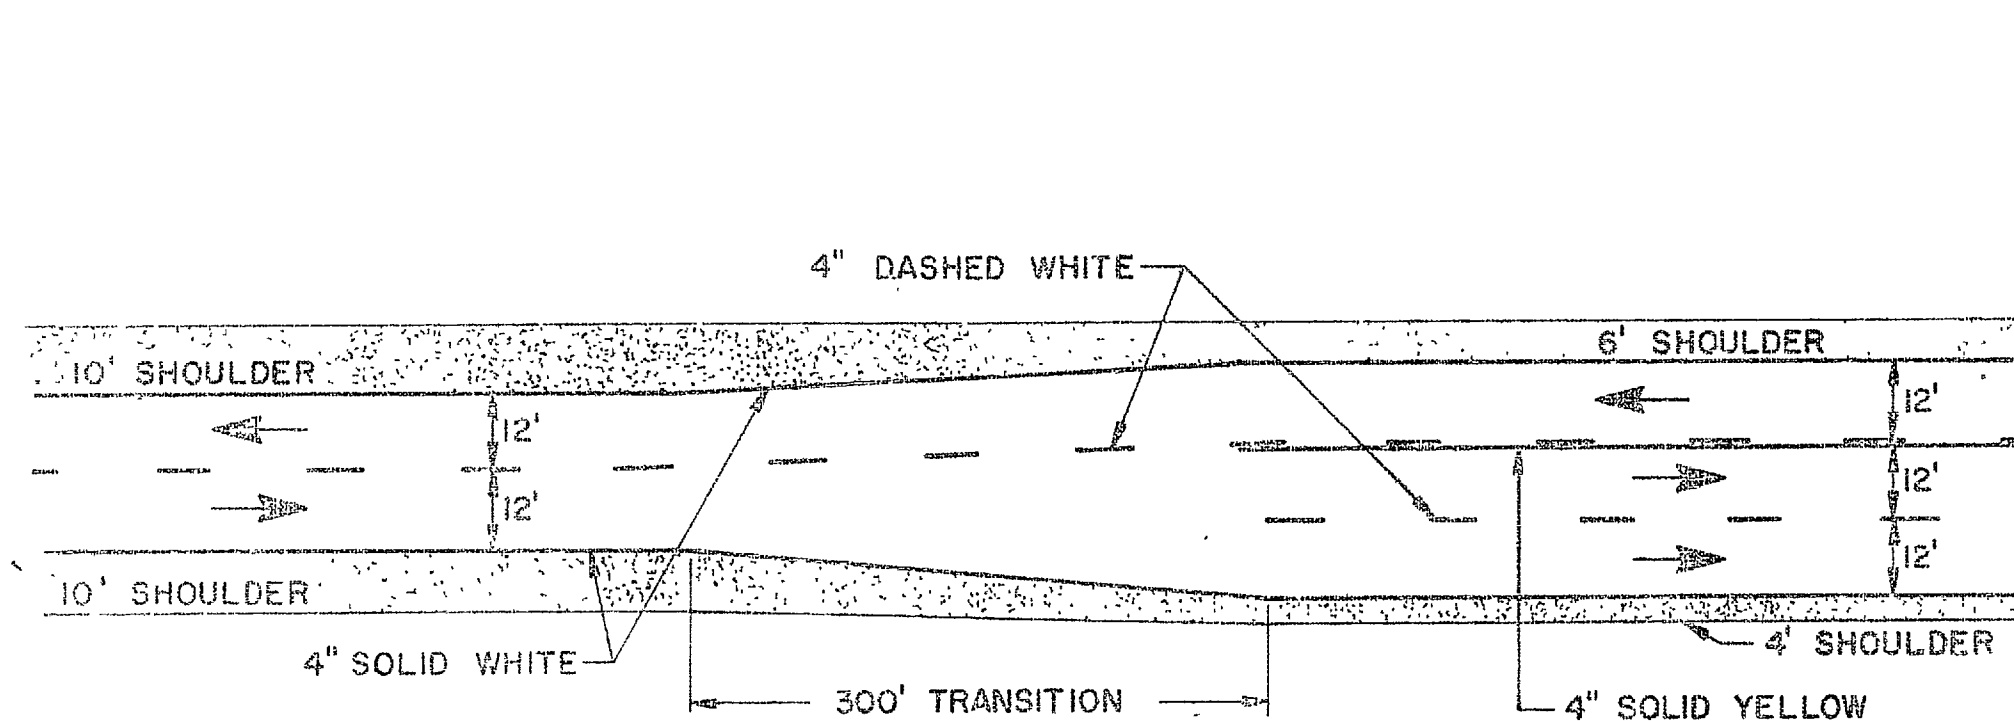


TWO LANE, TWO WAY, WITH TRUCK LANE

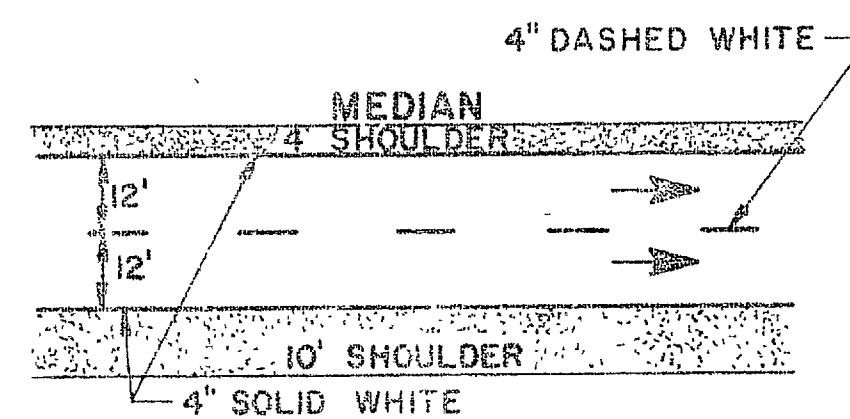

TWO LANES

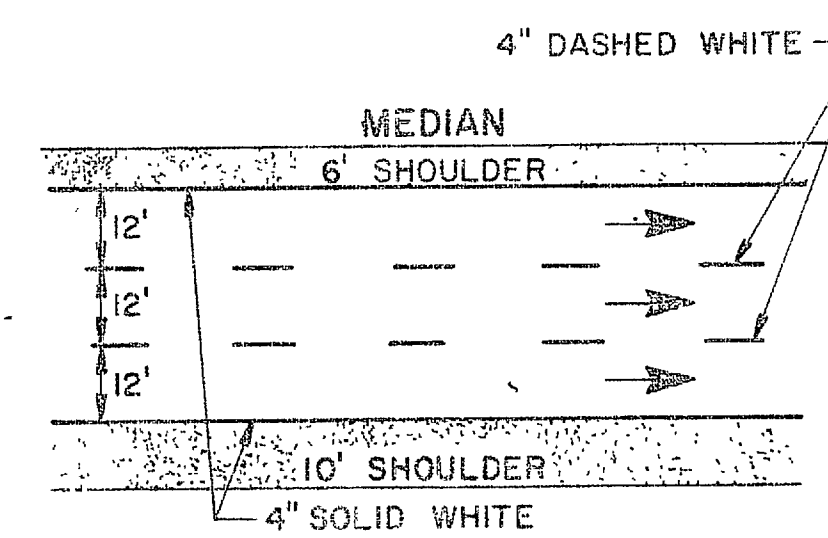

THREE LANES

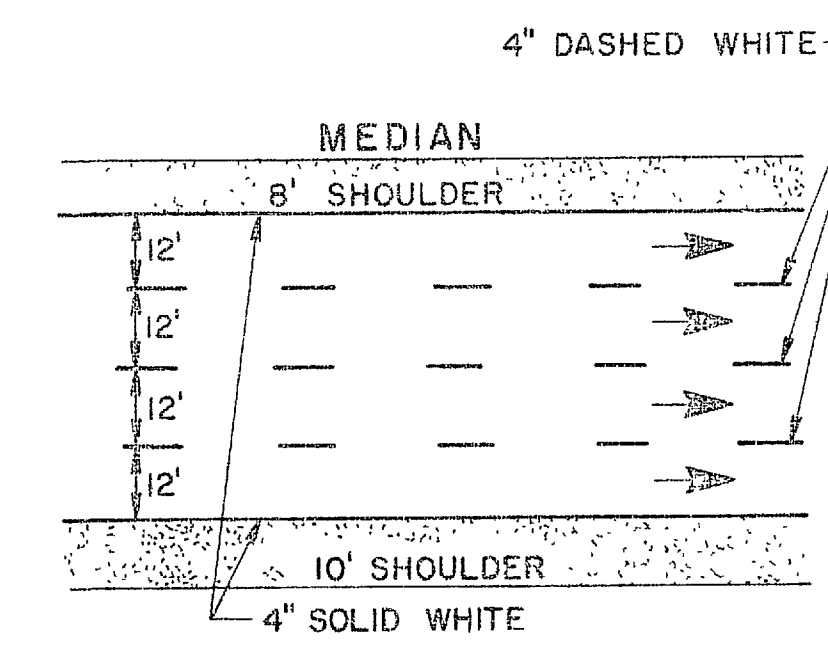

FOUR LANES

ROADWAY SECTION

UTAH DEPARTMENT OF HIGHWAYS

TYPICAL PAVEMENT MARKINGS INTERSTATE SYSTEM

SUPERSEDES	
REVISIONS	
Date	Appr.

RECOMMENDED FOR APPROVAL	Date	19
CHAIRMAN STANDARDS COMMITTEE APPROVED	Date	19
DIRECTOR OF HIGHWAYS	Date	19
STD. DWG. NO.		

[illegible][illegible]

SMALL STRUCTURES AND PIPE SUMMARY																					
LINE	STATION	12 CSP		12 CSP PERF		18 CSP		18 CSP PERF		24 RCP		12 END SECT	18 END SECT	24 END SECT	BOX DWG & LINE NO	REINF STEEL LBS	STRUC STEEL LBS	CLASS A CON (AE) CUYD	STRUCT EXC CUYD	RIP RAP CUYD	REMARKS
		LT	RT	LT	RT	LT	RT	LT	RT	LT	RT										
		FT	FT	FT	FT	FT	FT	FT	FT	FT	FT										
5600 SO	NE COR STRUC			56.0								1			V 751 - 2	184	310	1.8	17.30	00	SLOPE PROTECTION
	NW COR			58.0								1			V 751 - 2	184	310	1.8	24.18	00	" "
	SW COR			80.0								1			V 751 - 3	220	310	1.9	21.00	00	" "
	SE COR			57.0								1			V 751 - 2	184	310	1.8	22.10	00	" "
RAILROAD	SW COR STRUC			49.0								1			V 751 - 2	184	310	1.8	14.50	00	" "
	NE COR			59.0								1			V 751 - 2	184	310	1.8	17.70	2.0	" "
	NW COR			130.0								1			V 751 - 2	184	310	1.8	45.60	2.0	" "
RIVERDALE ROAD	SE COR			33.0								1			V 751 - 2	184	310	1.8	15.75	2.0	" "
	NE COR			39.0								1			V 751 - 2	184	310	1.8	18.30	2.0	" "
	SW COR			49.0								1			V 751 - 2	184	310	1.8	25.90	2.0	" "
F 5 LINE															V 750 - 1	181	310	1.3	5.20	00	
5600 SO	SW COR STRUC							56.0					1						11.40	00	
R 9 LINE								210.0											72.30	00	
I 15	896+00							30 med.											1.60	00	
I 15	880+00							103.0					2						31.60	00	
F 1	17+82							68.0					2						27.47	00	
RIVERDALE ROAD	52 TO 55+00									3200					V 750 - 2	188	310	1.5	156.8	00	
"															V 750 - 1	181	310	1.3	5.2	00	
"	43+00									86.0					V 750 - 2	188	310	1.5	50.0	00	
UNDER	RR STRUCTURE											-4.0							25.5		
I 15	937+90-943+95					600									V 777 - 6	244	479	1.9	319.17	00	
															V 777 - 6	244	479	1.9	8.0		
I 15	944+00					820									V 777 - 5	214	474	1.8	39.4		
I 15	944+00 949+00					500.0													250.0		
I 15	950+00					1300									V 777 - 5	214	474	1.8	72.8		
I 15	947+00					1020									V 777 - 5	214	474	1.8	69.20		
I 15	945+50					800									V 777 - 5	214	474	1.8	49.70		
I 15	944+00 945+00					1200									V 777 - 5	214	474	1.8	70.8		
"	TOTALS			610.0		15140	201.0	2660	3200	86.0	440	10	5			4172.0	7668.0	36.5	1488.47	10	

CONCRETE CURB AND GUTTER TYPE "A"			
LINE	STATION	STATION	LINE FT
5600 SO	STRUCTURE NBL	NE COR	11.16
	SBL	NW COR	11.42
	SBL	SW COR	13.60
	NBL	SE COR	12.60
RAILROAD	STRUCTURE SBL	SW COR	13.00
	NBL	NE COR	13.90
RIVERDALE	ROAD STRUCTURE	SE COR	15.00
		NE COR	8.00
		SW COR	9.20
	TOTAL		107.86

CONCRETE		CURB	TYPE	"E"
LINE	STATION	STATION		LIN FT
	864 + 39	866 + 00		340.4
F 3	19 + 50	24 + 55		1122.0
RIVERDALE ROAD	26 + 00	28 + 25		457.5
"	31 + 96.6	43 + 26		2267.4
"	44 + 10	54 + 22		2049.2
R - 2	17 + 25	18 + 40		114.8
R - 1	23 + 40	27 + 15		374.7
F 1	11 + 25			595.5
T 1				329.1
5600 SO				193.8
TOTALS				7844.40

SUMMARY SHEET

FED DIST	STATE	PROJECT	SHEET
UTAH	UTAH	115 820334	3C

REV DATE 1/9/68


LI NEAR SUMMARY								
LINE	STATION		EQUATIONS STRUCTURES OVER 20' SPAN	LANES & PROJECT ROADS		RAMP ROADS		CROSSING ROADS
	FROM	TO		LIN FT		MILE	LIN FT	LIN FT
I 15	836+15	845+15.15 BK	ROADWAY	900	10	0.171		
"	845+15.10 BK	845+08.72 AH	EQUATION					
"	845+08.72 AH	853+64.88	ROADWAY	856	16	0.162		
"	853+64.88	855+75.12	RAIL ROAD OVERPASS (210.24)					
"	855+75.12	866+95.97	ROADWAY	1320	85	0.250		
"	866+95.97	870+79.03	5600 SO STRUCTURE (183.06)					
"	870+79.03	1040+00	ROADWAY	16 920	97	3.205		
"			TOTAL STRUCTURE LENGTH (393.30)					
F 1	10+00	19+51.34	ROADWAY				951.34	
F 2	10+00	20+75.13					1075.13	
F 3	10+00	25+10.15					1510.15	
F 4	10+00	20+57.88					1057.88	
R 1	10+00	23+33.96					1333.96	
R 2	10+00	17+92.35					792.35	
RIVERDALE ROAD	23+00	28+39.36						539.36
"	28+39.36	31+83.19	RIVERDALE RD. STRUCTURE (343.83)					
"	31+83.19	54+22	ROADWAY					2238.81
				19998.08	3.288	5720.81	2778.17	
				393.30	0.074			
				20391.38	3.662			

8" C.S. PIPE				SUMMARY	
LINE	STATION	8 IN CS PIPE	STRUCTURAL EXCAVATION		
		LIN FT	CU YD		
I 80	964 + 15	52	5.1		
I 15 SB	910 + 00	62	6.1		
I 15 NB	910 + 00	62	6.1		
I 15 NB	964 + 50	62	8.6		
I 15 S.B	964 + 50	62	8.6		
I 15 SB	1038 + 50	68	6.7		
I 15 NB	1038 + 50	86	8.5		
R 1	22 + 75	34	3.5		
R 2	13 + 25	36	3.6		
F 2	16 + 00	36	3.6		
	TOTAL	560	60.4		

[illegible][illegible]

SURFACING


[illegible]

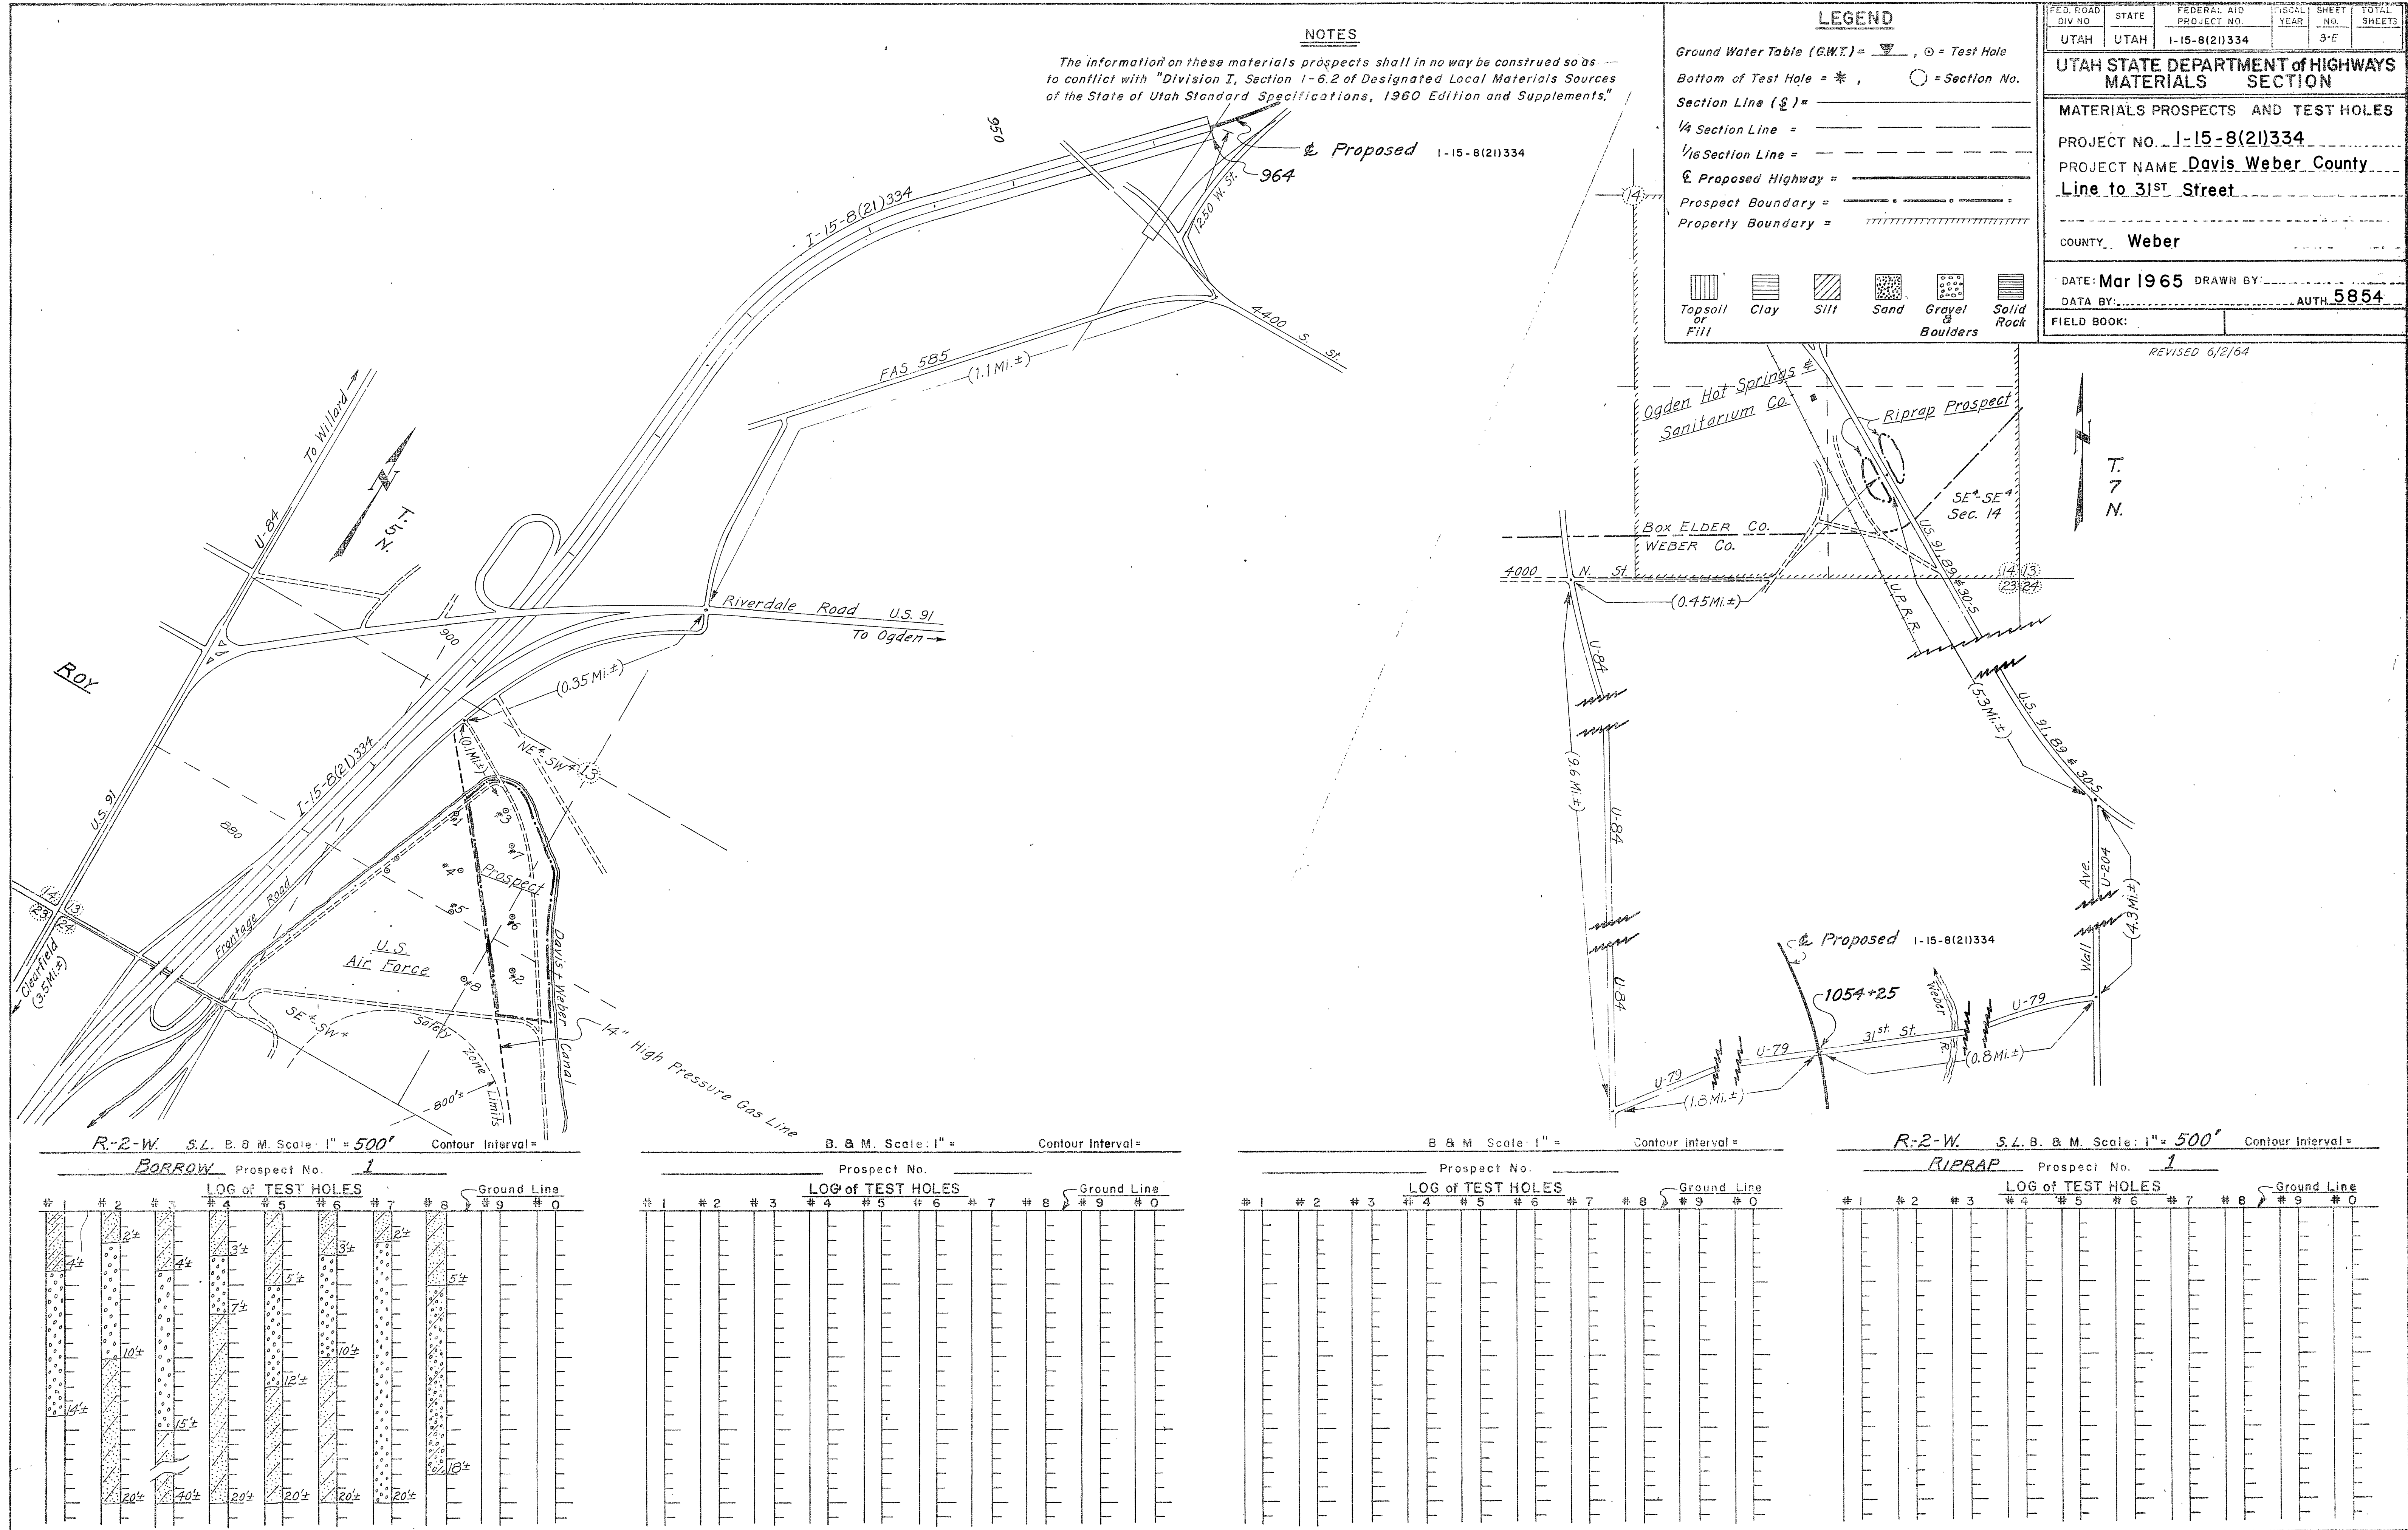

FOR INFORMATION ONLY

This information does not constitute a portion of the plans or contract and shall not be construed so as to conflict with Division I, Subsection 1-6.2. Designated Local Materials Sources of the State of Utah Standard specifications, Edition of 1960.

LEGEND

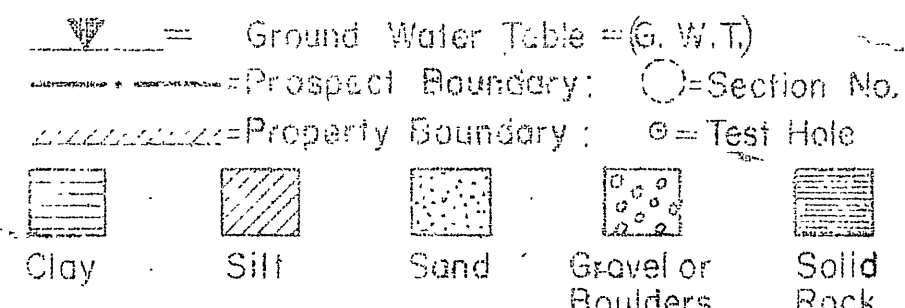

UTAH STATE DEPARTMENT OF HIGHWAYS

MATERIALS & RESEARCH DIVISION

MATERIALS PROSPECT & TEST HOLE QUALITY & GRADING DATA

PROJECT NUMBER I-15-8(21)334

PROJECT NAME Davis-Weber County Line


to 31st Street

COUNTY Weber


DATE Mar, 1965

FED. ROAD DIST. NO.	STATE	PROJ. NO.	PIECE NO.	SHEET NO.	TOTAL SHEETS
UTAH	UTAH			3-F	

These materials were sampled and tested for use as base and surfacing. Scarcity of borrow sources necessitated making them available for use as borrow.

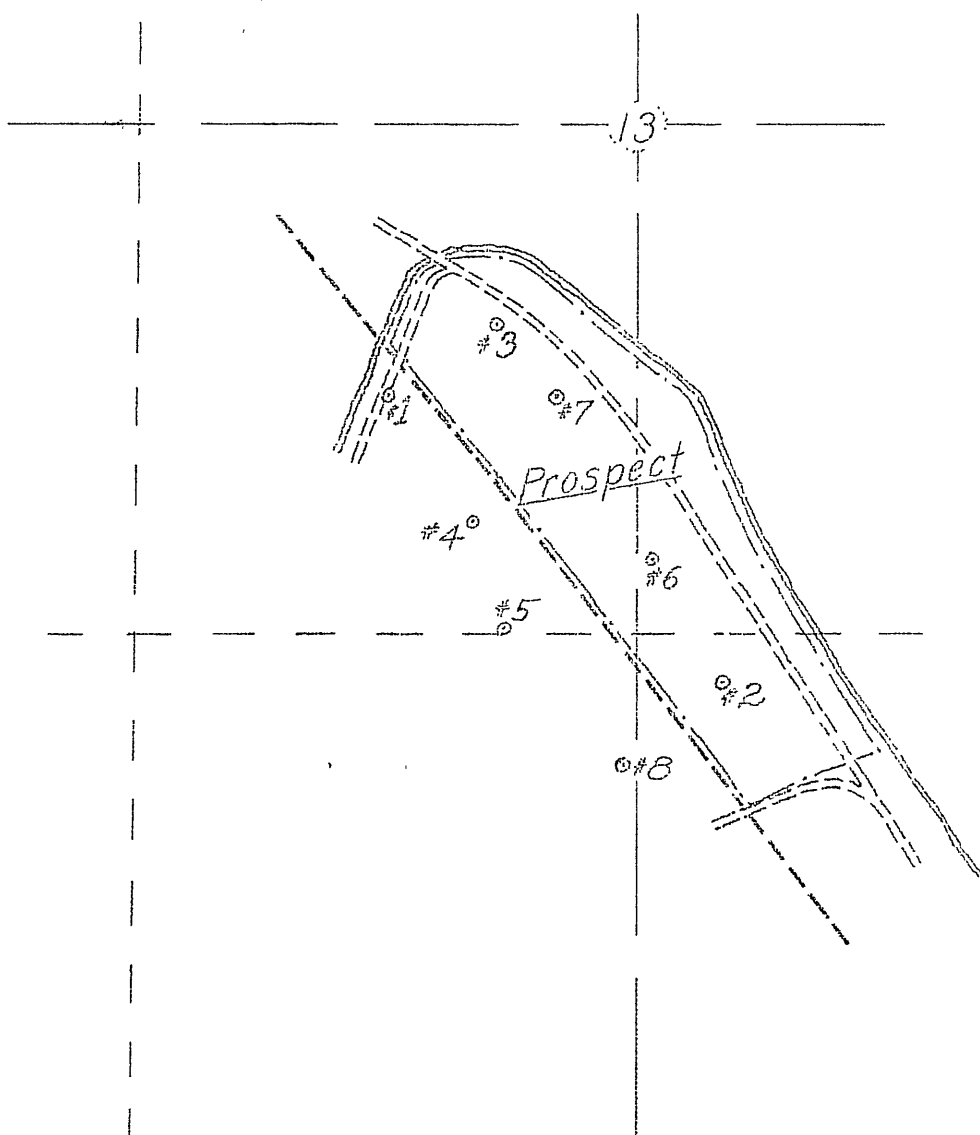

Lab. Number	757-SA-62	945-SA-62	925-SA-62	926-SA-62	927-SA-62	931-SA-62	962-SA-62	963-SA-62	964-SA-62	948-SA-62
Test Hole Number	1	2	3	3	3	4	5	6	7	8
Depth	0-14'			16-25'						
Screen Analysis:										
Before Crushing										
Passing 3" %		100.0	100.0	100.0	100.0	-	100.0	100.0	100.0	100.0
Passing 1" %		80.6	71.3	78.8	100.0	-	80.1	80.6	68.9	81.4
Passing No. 4 %		58.8	9.3	47.6	96.4	-	67.5	63.2	29.5	38.7
After Crushing										
Passing 1" %		100.0	100.0	100.0	100.0	100.0	100.0	100.0	100.0	100.0
Passing 3/4" %		93.6	73.8	89.1	99.4	100.0	94.3	94.3	88.0	89.2
Passing No. 4 %		63.1	13.1	53.2	96.4	97.0	71.4	66.8	34.7	41.1
Passing No. 10 %		53.6	11.5	50.8	95.8	96.3	68.9	63.3	28.9	34.7
Passing No. 200 %		21.8	3.4	18.3	11.0	29.8	17.1	18.4	3.9	3.9
Liquid Limit		18.0	18.9	16.5	18.7	18.6	19.3	18.5	17.2	15.3
Plasticity Index		N.P.	N.P.	N.P.	N.P.	N.P.	N.P.	N.P.	N.P.	N.P.
Swell	.010	.008	.007	.007	.010	.016	.012	.010	.010	.008
U.A. Rattler	18.20	22.00	18.00	22.00	-	-	20.00	22.00	19.80	20.00
P.F. Count		52.0	68.0	61.0	-	-	55.0	50.0	53.0	40.0
Medium Sulfate Loss										
Immersion Compression										
Marshall Stability										
Flow										
P.S.I. Without Lime										
P.S.I. With 1% Lime										



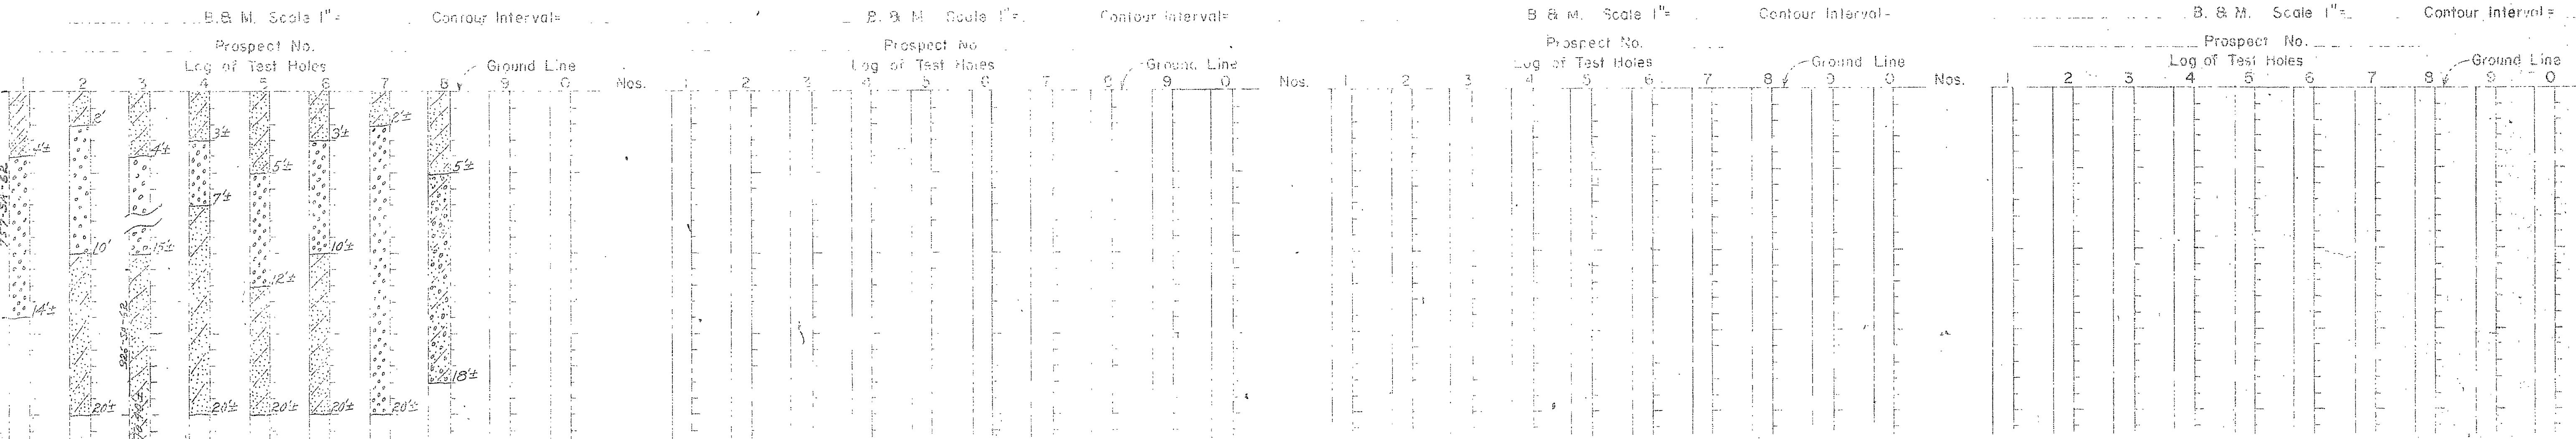


PROJ. NO.	STATE	PROJ. NO.	SHEET NO.	TOTAL SHEETS
UTAH	UTAH	I-15-8(2) 334	4	

REV. DATE: 3/10/65
6/18/65 CONST. CHANGE

8-19-65 B.

NOTE:
8" C.S.P. CASINGS AT VARIOUS STATIONS AS SHOWN ON SUMMARY SHEET TO BE USED ON LANDSCAPING CONTRACT TO CASE WATER LINES. THE ENDS OF THE 8" C.S. CROSSOVER PIPES SHALL NOT EXTEND THROUGH THE CUT OR FILL SLOPES BY 1' BUT SHALL BE PLUGGED AND MARKED FOR FUTURE EASE OF LOCATION.

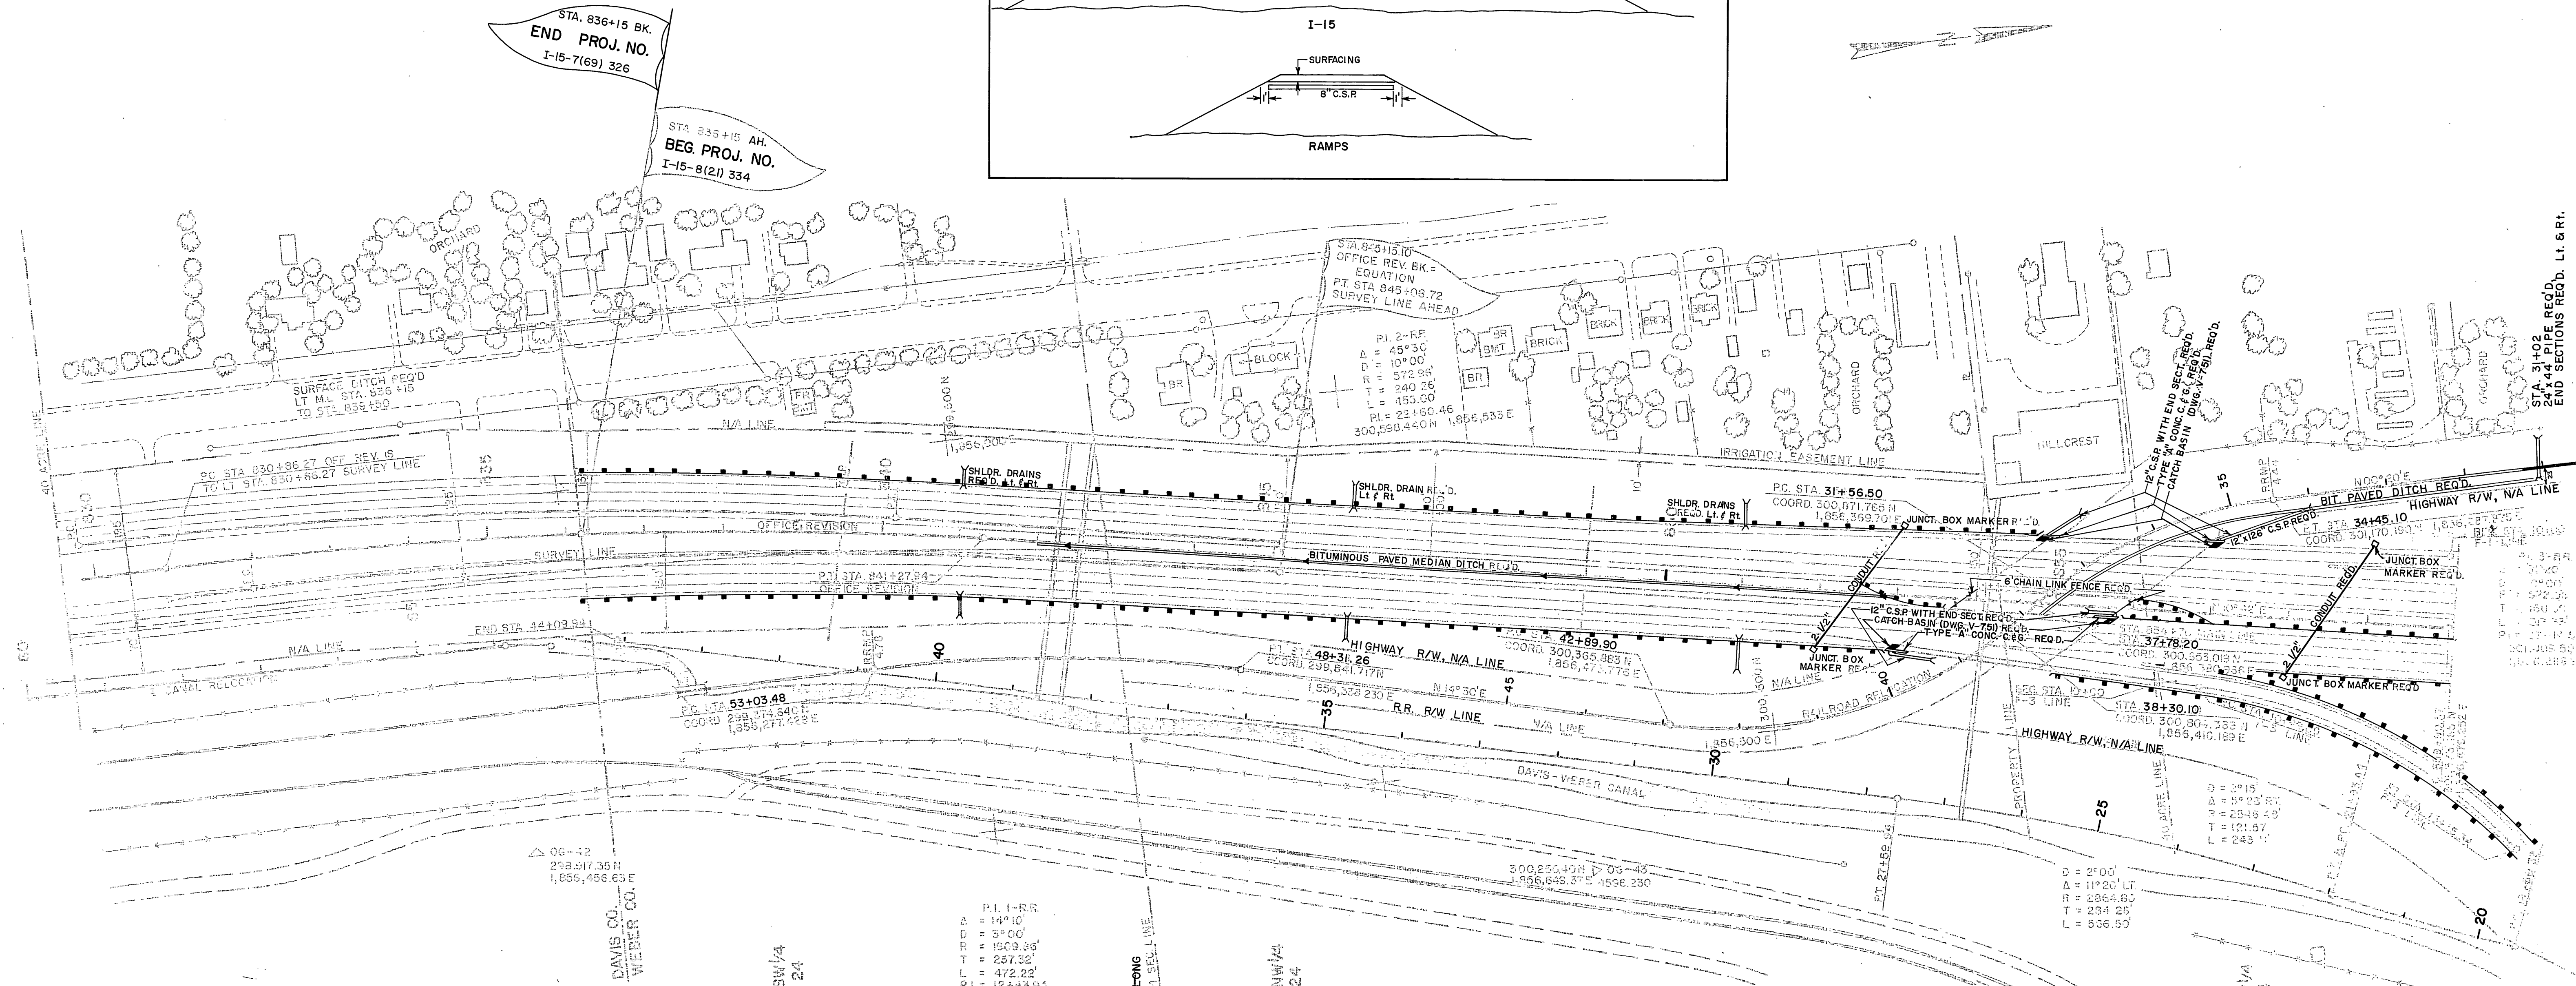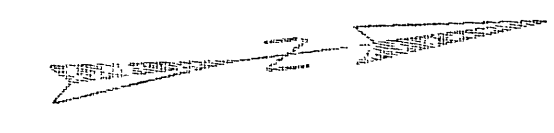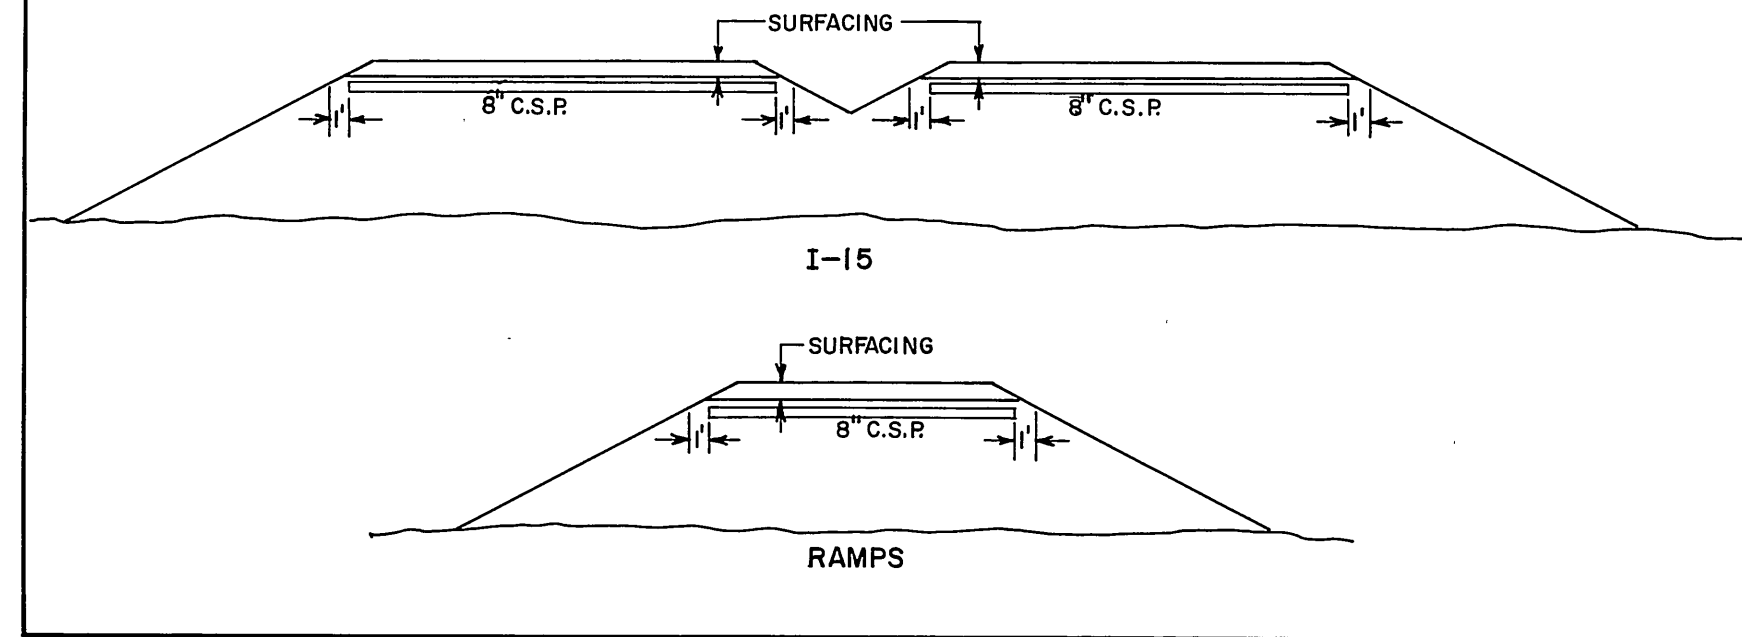

STA. 841+00	12" x 42"	C.S.P. WITH END SECTIONS REQ'D. LT. FOR SHOULDER DRAIN
STA. 841+00	12" x 14"	C.S.P.
STA. 846+00	12" x 14"	C.S.P.
STA. 846+00	12" x 14"	C.S.P.
STA. 851+00	12" x 54"	C.S.P.
STA. 851+00	12" x 54"	C.S.P.

STA. 842+00	12" x 12" C.S.P.
STA. 846+00	29" x 12" C.S.P.
STA. 846+00	16" x 12" C.S.P.
STA. 851+00	51" x 12" C.S.P.
STA. 851+00	63" x 12" C.S.P.

STRUCTURE DRAIN (RAILROAD STRUCTURE)
SBL SW CORNER 45" x 12" C.S.P.
NBL NE CORNER 39" x 12" C.S.P.
SBL NW CORNER 130" x 12" C.S.P.

STA 31+02 UNDERNEATH RR. STRUCTURE 44" x 24" RCP

STA 842+00 to STA 852+00
BITUMINOUS-PAVED-MEDIAN-DITCH REQ'D.

STA. 853+00 65' Rt. AND STA. 854+80 80' Lt.
STA. 856+70 16' Rt. AND STA. 857+00 90' Lt.
CATCH BASIN REQ'D. LONG V-70 REQ'D. IN MEDIAN
DRAINAGE BASIN REQ'D. IN MEDIAN
DRAINAGE BASIN REQ'D. IN MEDIAN
DRAINAGE BASIN REQ'D. IN MEDIAN
SEE SLOPE PROTECTION DETAIL SHEET NO. 2C

STA. 852+00 N.B. to STA. 853+00 S.B.
STA. 854+00 N.B. to STA. 855+00 S.B.
2 1/2" CONDUIT REQ'D. IN MEDIAN
JUNCTION BOX MARKERS DWG. 1128
REQ'D. LT. & RT.

ROLLED GUTTER FOR SHOULDER
SEE DETAIL SHEET NO. 2B
STA. 836+15 to STA. 854+75 ON LT.
STA. 836+15 to STA. 854+75 ON RT.
STA. 855+00 to STA. 859+40 ON RT.
STA. 855+00 to STA. 859+40 ON LT.

STA. 853+90 AND STA. 856+00 32' OF
CHAIN LINK FENCE REQ'D. IN MEDIAN
BETWEEN N.B. & S.B. LANE STRUCTURES

BITUMINOUS PAVED DITCH REQ'D.
RAILROAD STATIONING
STA. 37+90 to STA. 31+00

DEEP BEAM HIGHWAY GUARDRAIL REQ'D.
I-15

STA. 836+15 to STA. 854+90 ON LT.
STA. 836+15 to STA. 854+90 ON RT.
STA. 855+00 to STA. 859+00 ON RT.
STA. 855+75 to STA. 859+00 ON INSIDE SHOULDER N.B.L.
STA. 852+50 S.B.L. to STA. 853+50 N.B.L. 100' OF GUARDRAIL
REQ'D. IN MEDIAN
STA. 856+00 S.B.L. to STA. 857+00 N.B.L. 100' OF GUARDRAIL
REQ'D. IN MEDIAN
F-3" LINE
STA. 10+00 to STA. 18+00 ON LT. & RT.

STA. 31+02 RAIL ROAD
24" x 44" PIPE REQ'D. WITH
END SECTIONS REQ'D. LT. & RT.

NOTE:
MODIFY GUTTER ON 5600 SO.
TO FIT THE RAMP GRADES, AS
DIRECTED BY PROJ. ENG.

STA. 10+00 BEG. F-2 LINE
STA. 6+15.86 5600 SO.

NOTE:
5600 SOUTH
STRUCTURE INPLACE

NOTE:
F-5 LINE SURFACED ON
GRADING CONTRACT

NOTE:
FOR F-1, F-2, F-3, F-4 LINE
PROFILES SEE SHEET NO. 21

STA. 16+00 F-2 LINE 36" X 8" CASING

STRUCTURE DRAIN 5600 SO. ST. STRUCTURE
STA. 86+00 12" X 66" C.S.P.
STA. 876+00 12" X 42" C.S.P.
STA. 877+00 12" X 25" C.S.P.
STA. 882+00 12" X 28" C.S.P.
SHOULDER DRAINS
NBL. W. CORNER 56" X 12" C.S.P.
SBL. SW CORNER 58" X 12" C.S.P.
SBL. SW CORNER 80" X 12" C.S.P.
NBL. SW CORNER 57" X 12"

SBL. SW 56" X 18" C.S.P. 5600 SO. ST. STRUCTURE
STA. 880+00 103" X 18" C.S.P.
STA. 174.82 68" X 18" C.S.P.

NOTE:
MODIFY BITUMINOUS ROLLED GUTTER ON 5600 SO.
AT EXIT AND ENTRAPPS TO I-15

STA. 884+00 N.B. to STA. 885+00 S.B.
2 1/2" CONDUIT DWG. T.E.C. 1133 REQ'D.
WITH JUNCTION BOX MARKERS DWG.
T.E. 1128 REQ'D. L1 & R1

5600 SOUTH INTERCHANGE

STA. 12+10 F-4 LINE
18" X 96" C.S.P. WITH END SEC.
TO DRAIN LOW AREA BETWEEN I-15, F-3, AND F-4 LINES

STA. 869+00
18" X 96" C.S.P. WITH END SEC.
UNDER SBL. TO DRAIN MEDIAN

STA. 18+74 F-1 LINE
18" X 96" C.S.P. WITH END SEC.
REQ'D.

STA. 870+90 72" L1 AND STA. 871+20 75" R1
CATCH BASIN REQ'D. DWG. V-751
OUTLET TO DRAIN SHOULDER ON 5600 SOUTH
FROM THE STRUCTURE TO THE CATCH BASIN FOR PEAKING SLOPE
PROTECTION ON STRUCTURE SEE SHEET NO. 20

STA. 880+00 to STA. 927+00
BITUMINOUS PAVED MEDIAN DITCH REQ'D.
BITUMINOUS PAVED CUT DITCHES REQ'D. L1 & R1

F-1 LINE
F-2 LINE
F-3 LINE
F-4 LINE
F-5 LINE

STA. 12+50 to STA. 18+74 ON R1
STA. 10+60 to STA. 19+00 ON R1
STA. 10+00 to STA. 20+00 ON L1
STA. 10+00 to STA. 18+00 ON L1

STA. 875+50 I-15
8" X 12" C.S.P. CASING REQ'D.
SEE NOTE SHEET NO. 4

STA. 16+00 F-2 LINE
8" X 34" C.S.P. CASING REQ'D.
SEE NOTE SHEET NO. 4

STA. 10+00 to STA. 14+60 ON L1
I-15
STA. 14+00 to STA. 866+00 ON R1
STA. 14+42 to STA. 20+00 ON R1
TYPE "E" CONC. CURB REQ'D.

FOR SHLDR. DRAIN DETAIL SEE SHEET NO. 2 B

STA. 862+00	12" X 98" C.S.P. WITH END SECTIONS REQ'D.	FOR SHOULDER DRAIN
STA. 863+00	12" X 98" C.S.P.	
STA. 867+00	12" X 72" C.S.P.	
STA. 867+00	12" X 64" C.S.P.	
STA. 877+00	12" X 36" C.S.P.	
STA. 878+00	12" X 28" C.S.P.	
STA. 882+00	12" X 28" C.S.P.	

STA. 869+30 AND STA. 871+00
32' OF 6" CHAIN LINK FENCE REQ'D. IN MEDIAN
BETWEEN THE N.B. AND S.B. LANE STRUCTURES

DEEP BEAM HIGHWAY GUARDRAIL REQ'D.

I-15
STA. 855+00 to STA. 869+00 ON R1
STA. 855+75 to STA. 869+00 ON INSIDE SHLDR. N.B.L.
STA. 871+00 to STA. 883+00 ON R1
STA. 871+00 to STA. 885+00 ON INSIDE SHLDR. N.B.L.

F-1 LINE
STA. 10+00 to STA. 17+00 ON L1

F-2 LINE
STA. 12+50 to STA. 20+00 ON L1

F-3 LINE
STA. 10+00 to STA. 18+50 ON L1
STA. 10+00 to STA. 24+50 ON R1

F-4 LINE
STA. 10+00 to STA. 14+50 ON R1
STA. 10+00 to STA. 14+50 ON L1

I-15
STA. 861+50 to STA. 869+00 ON L1
STA. 871+00 to STA. 879+00 ON L1
STA. 871+00 S.B.L. to STA. 872+00 N.B.L. 100' OF GUARDRAIL
IN MEDIAN

F-2 LINE
STA. 20+25 to STA. 20+75 ON R1


ROLLED GUTTER FOR SHOULDER
SEE TYPICAL SHEET NO. 2B
STA. 855+00 to STA. 869+40 ON R1
STA. 857+00 to STA. 869+00 ON L1
STA. 871+00 to STA. 878+00 ON L1
STA. 871+25 to STA. 882+00 ON R1

NOTE:
R-1 LINE AND RIVERDALE ROAD DETOUR
REMOVE BITUMINOUS SURFACING AS DIRECTED
BY THE PROJECT ENGINEER.

FED. ROAD DIST. NO.	STATE	PROJ. NO.	SHEET NO.	TOTAL SHEETS
UTAH	UTAH	I-15-8(2) 334	6	

REV. DATE 3/10/65

AC 8-19-68

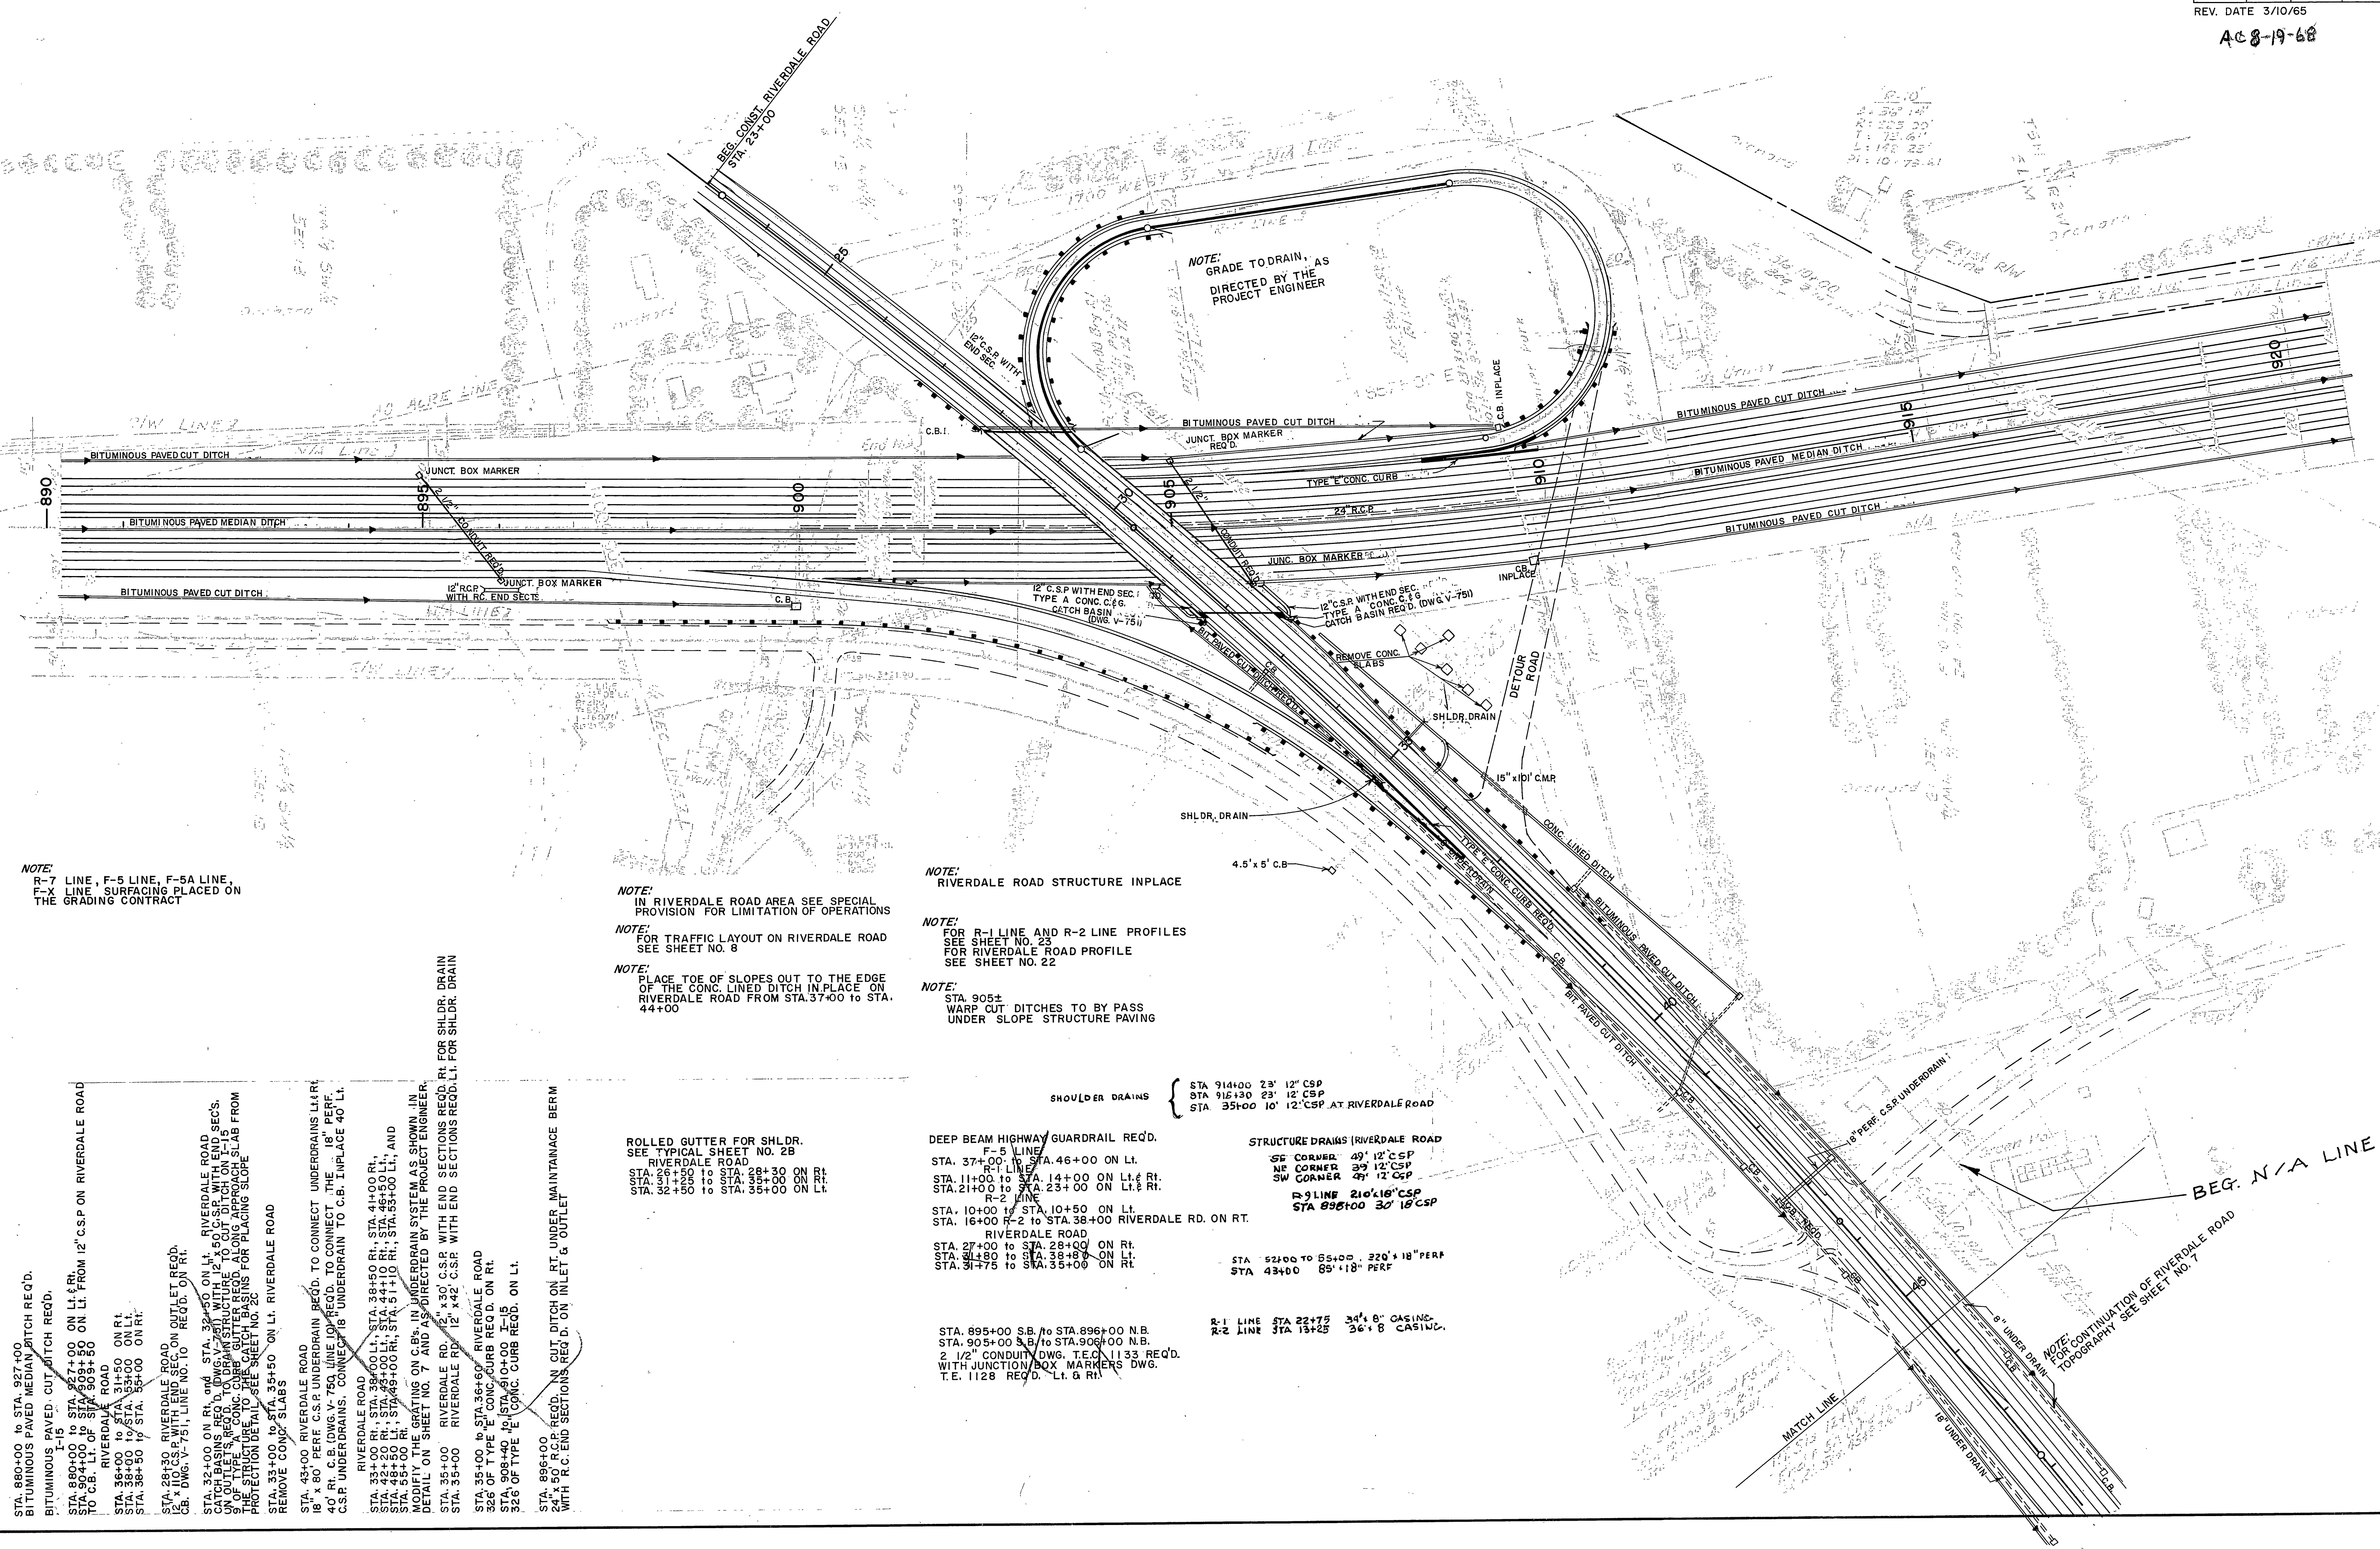

NOTE:
R-7 LINE, F-5 LINE, F-5A LINE,
F-X LINE SURFACING PLACED ON
THE GRADING CONTRACT

NOTE:
IN RIVERDALE ROAD AREA SEE SPECIAL
PROVISION FOR LIMITATION OF OPERATIONS

NOTE:
FOR TRAFFIC LAYOUT ON RIVERDALE ROAD
SEE SHEET NO. 8

NOTE:
PLACE TOE OF SLOPES OUT TO THE EDGE
OF THE CONC. LINED DITCH IN PLACE. ON
RIVERDALE ROAD FROM STA. 37+00 TO STA.
44+00

NOTE:
RIVERDALE ROAD STRUCTURE INPLACE

NOTE:
FOR R-1 LINE AND R-2 LINE PROFILES
SEE SHEET NO. 23
FOR RIVERDALE ROAD PROFILE
SEE SHEET NO. 22

NOTE:
STA. 905±
WARP CUT DITCHES TO BY PASS
UNDER SLOPE STRUCTURE PAVING

ROLLED GUTTER FOR SHLDR.
SEE TYPICAL SHEET NO. 28
RIVERDALE ROAD
STA. 26+50 TO STA. 32+50 ON R.L.
STA. 33+00 TO STA. 38+50 ON R.L.
STA. 39+00 TO STA. 44+00 ON R.L.
STA. 45+00 TO STA. 50+00 ON R.L.
STA. 51+00 TO STA. 56+00 ON R.L.
STA. 993+00 TO STA. 998+00 ON R.L.
STA. 999+00 TO STA. 1000+00 ON R.L.

DEEP BEAM HIGHWAY GUARDRAIL REQ'D.
F-5 LINE
STA. 37+00 TO STA. 46+00 ON L.I.
R-1 LINE
STA. 11+00 TO STA. 14+00 ON L.I. & R.I.
STA. 21+00 TO STA. 23+00 ON L.I. & R.I.
R-2 LINE
STA. 10+00 TO STA. 10+50 ON L.I.
STA. 16+00 R-2 TO STA. 38+00 RIVERDALE RD. ON RT.

RIVERDALE ROAD
STA. 27+00 TO STA. 28+00 ON R.I.
STA. 31+80 TO STA. 38+80 ON L.I.
STA. 31+75 TO STA. 35+00 ON R.I.

STA. 895+00 S.B. TO STA. 896+00 N.B.
STA. 905+00 S.B. TO STA. 906+00 N.B.
2 1/2" CONDUIT DWG. T.E.O. 11-33 REQ'D.
WITH JUNCTION BOX MARKERS DWG.
T.E. 1128 REQ'D. L.I. & R.I.

STRUCTURE DRAINS RIVERDALE ROAD
SE CORNER 49' 12" C.S.P.
NE CORNER 29' 12" C.S.P.
SW CORNER 49' 12" C.S.P.
R-1 LINE 210' 18" C.S.P.
STA. 895+00 30' 18" C.S.P.

STA. 521+00 TO 55+00 220' 18" PERF.
STA. 43+00 85' 18" PERF.

R-1 LINE STA. 22+75 34' 8" CASING.
R-2 LINE STA. 13+25 36' 8" CASING.

BEG. N/A LINE


NOTE:
FOR CONTINUATION OF RIVERDALE ROAD
TOPOGRAPHY, SEE SHEET NO. 7

REV. DATE 3/10/65


STA. 33+00 Rt., STA. 38+00 Lt., STA. 38+50 Rt., STA. 41+00 Rt.,
STA. 42+20 Rt., STA. 43+00 Lt., STA. 44+10 Rt., STA. 46+50 Lt.,
STA. 48+50 Lt., STA. 49+00 Rt., STA. 51+10 Rt., STA. 53+00 Lt., AND
STA. 55+00 Rt.

MODIFY THE GRATING ON C.B.'S. IN UNDERDRAIN SYSTEM AS SHOWN
IN DETAIL ON THIS SHEET AND AS DIRECTED BY THE PROJECT ENGINEER


INTERCHANGE
I-15 RIVERDALE ROAD

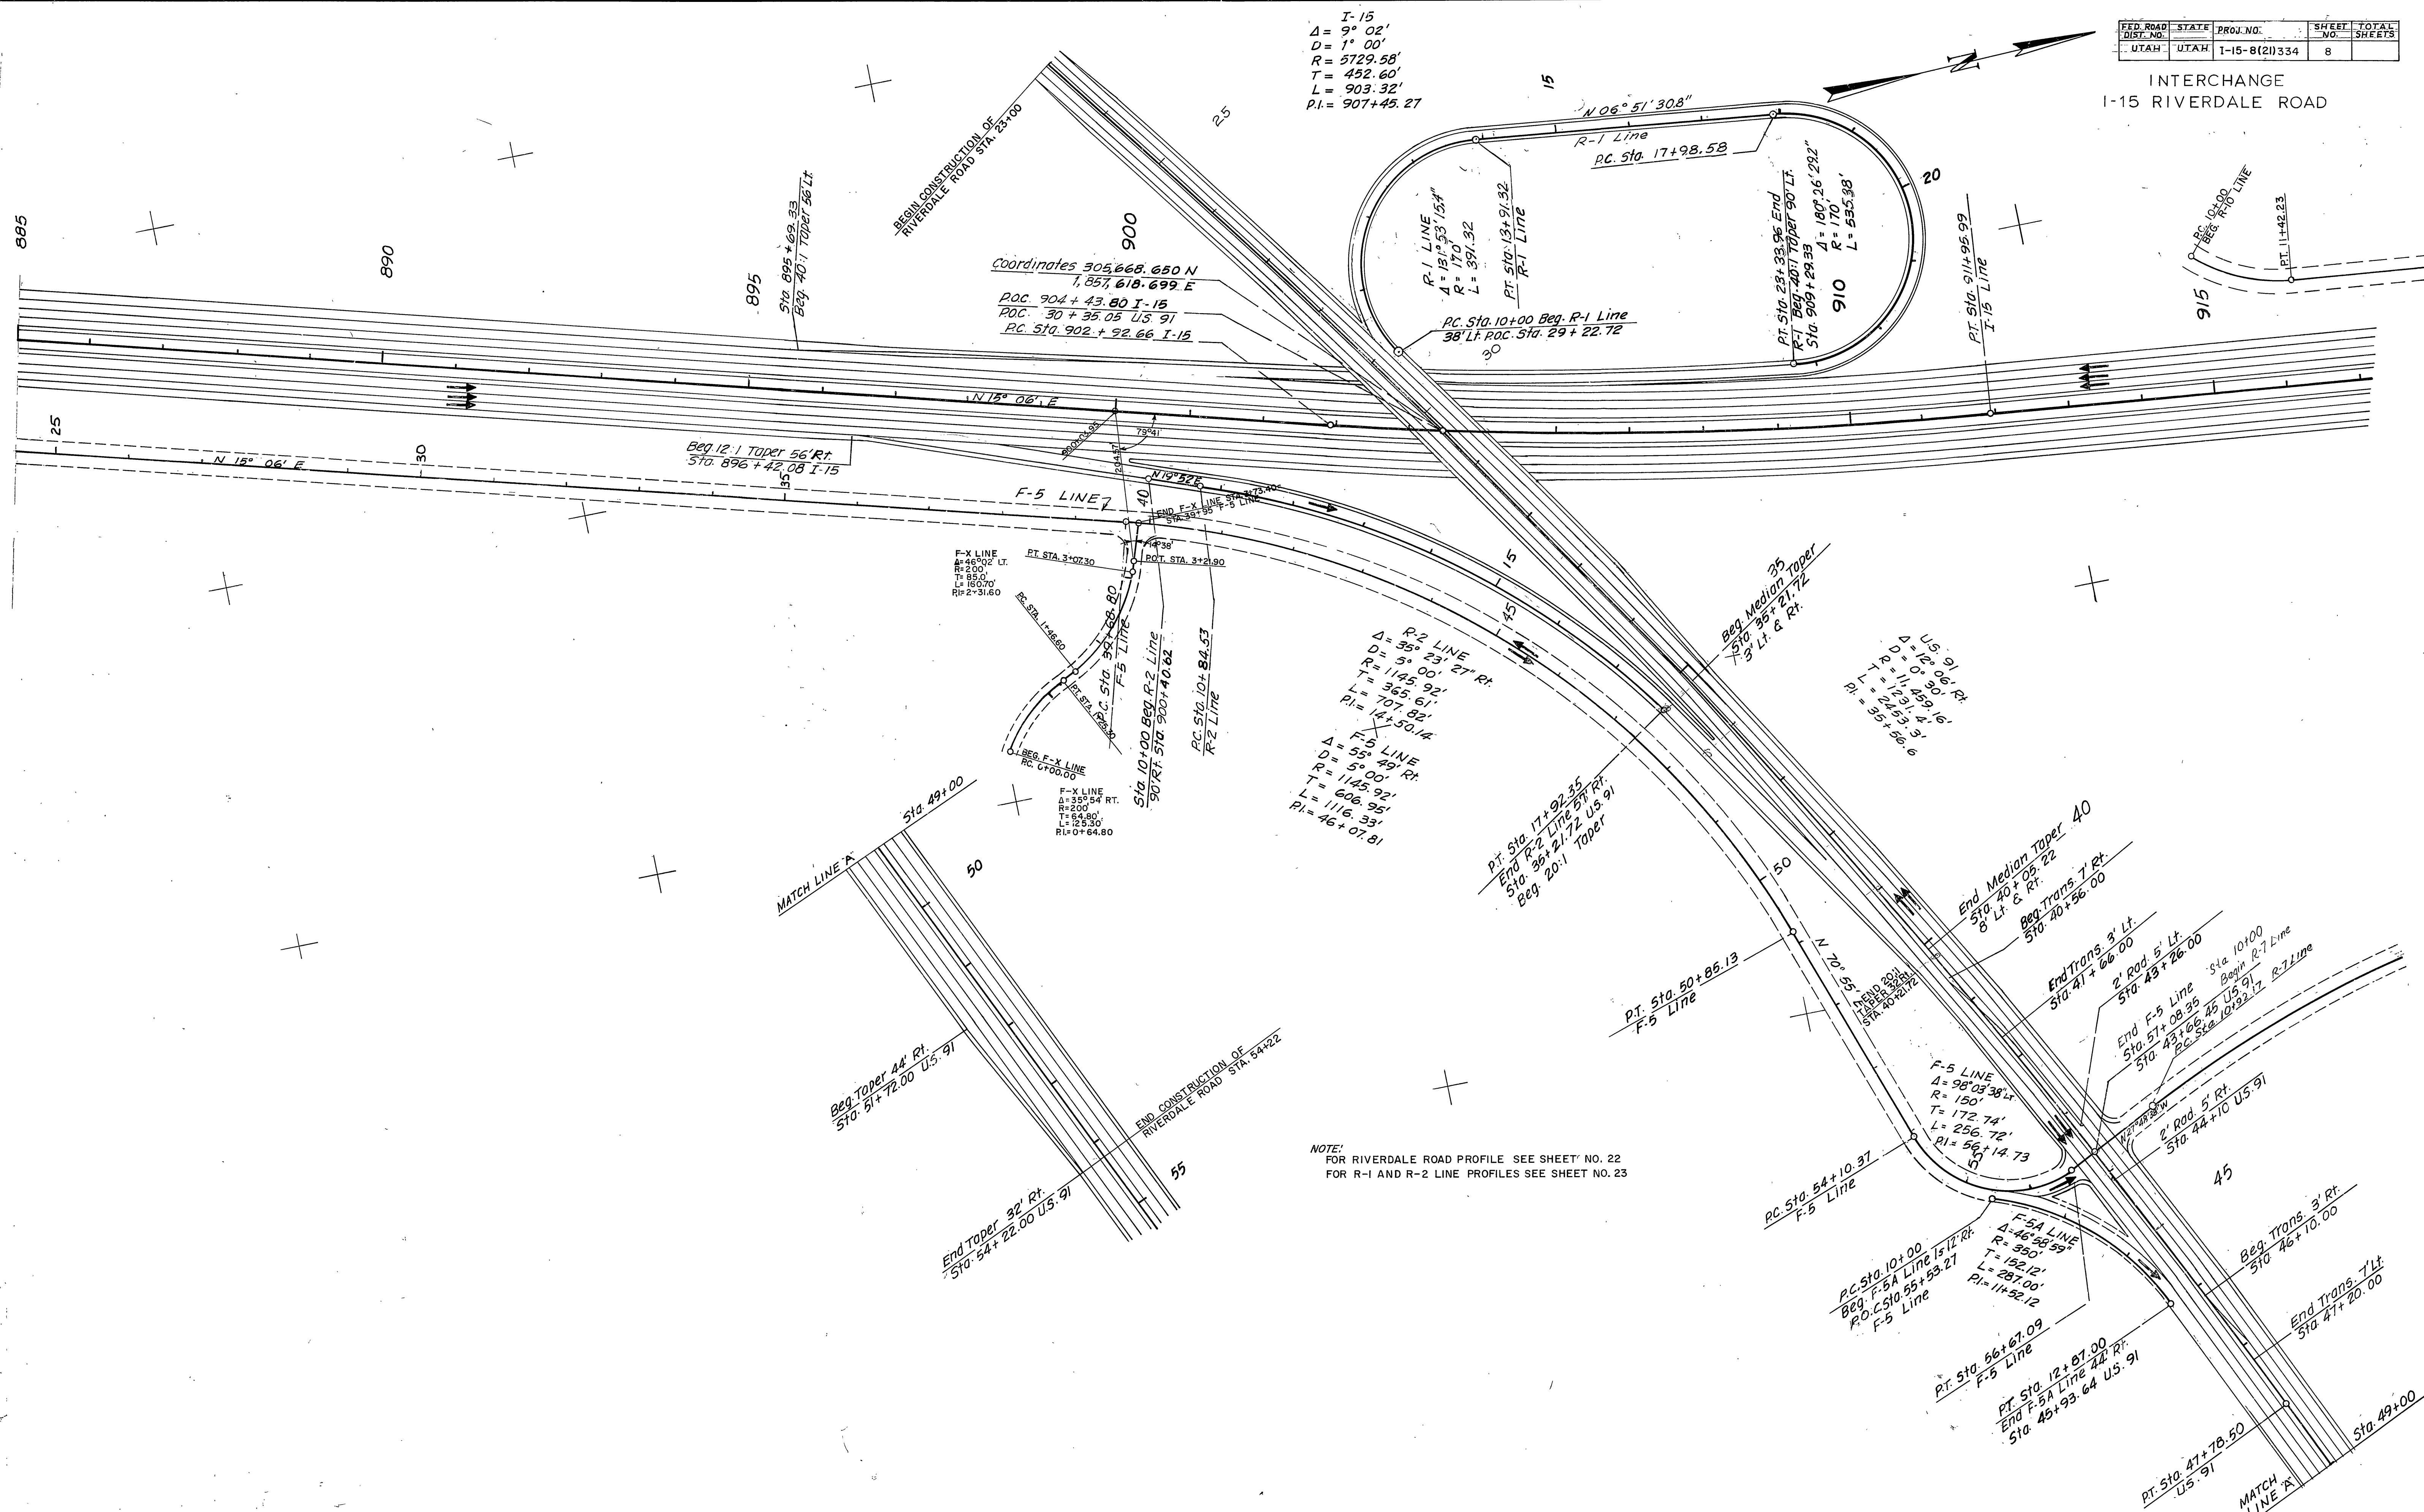

STA. 880+00 to STA. 927±
BITUMINOUS PAVED CUT DITCH 14'± Ft.
STA. 880+00 to STA. 927±
STA. 927+00 to STA. 976+00
BITUMINOUS PAVED MEDIAN DITCH REQD.

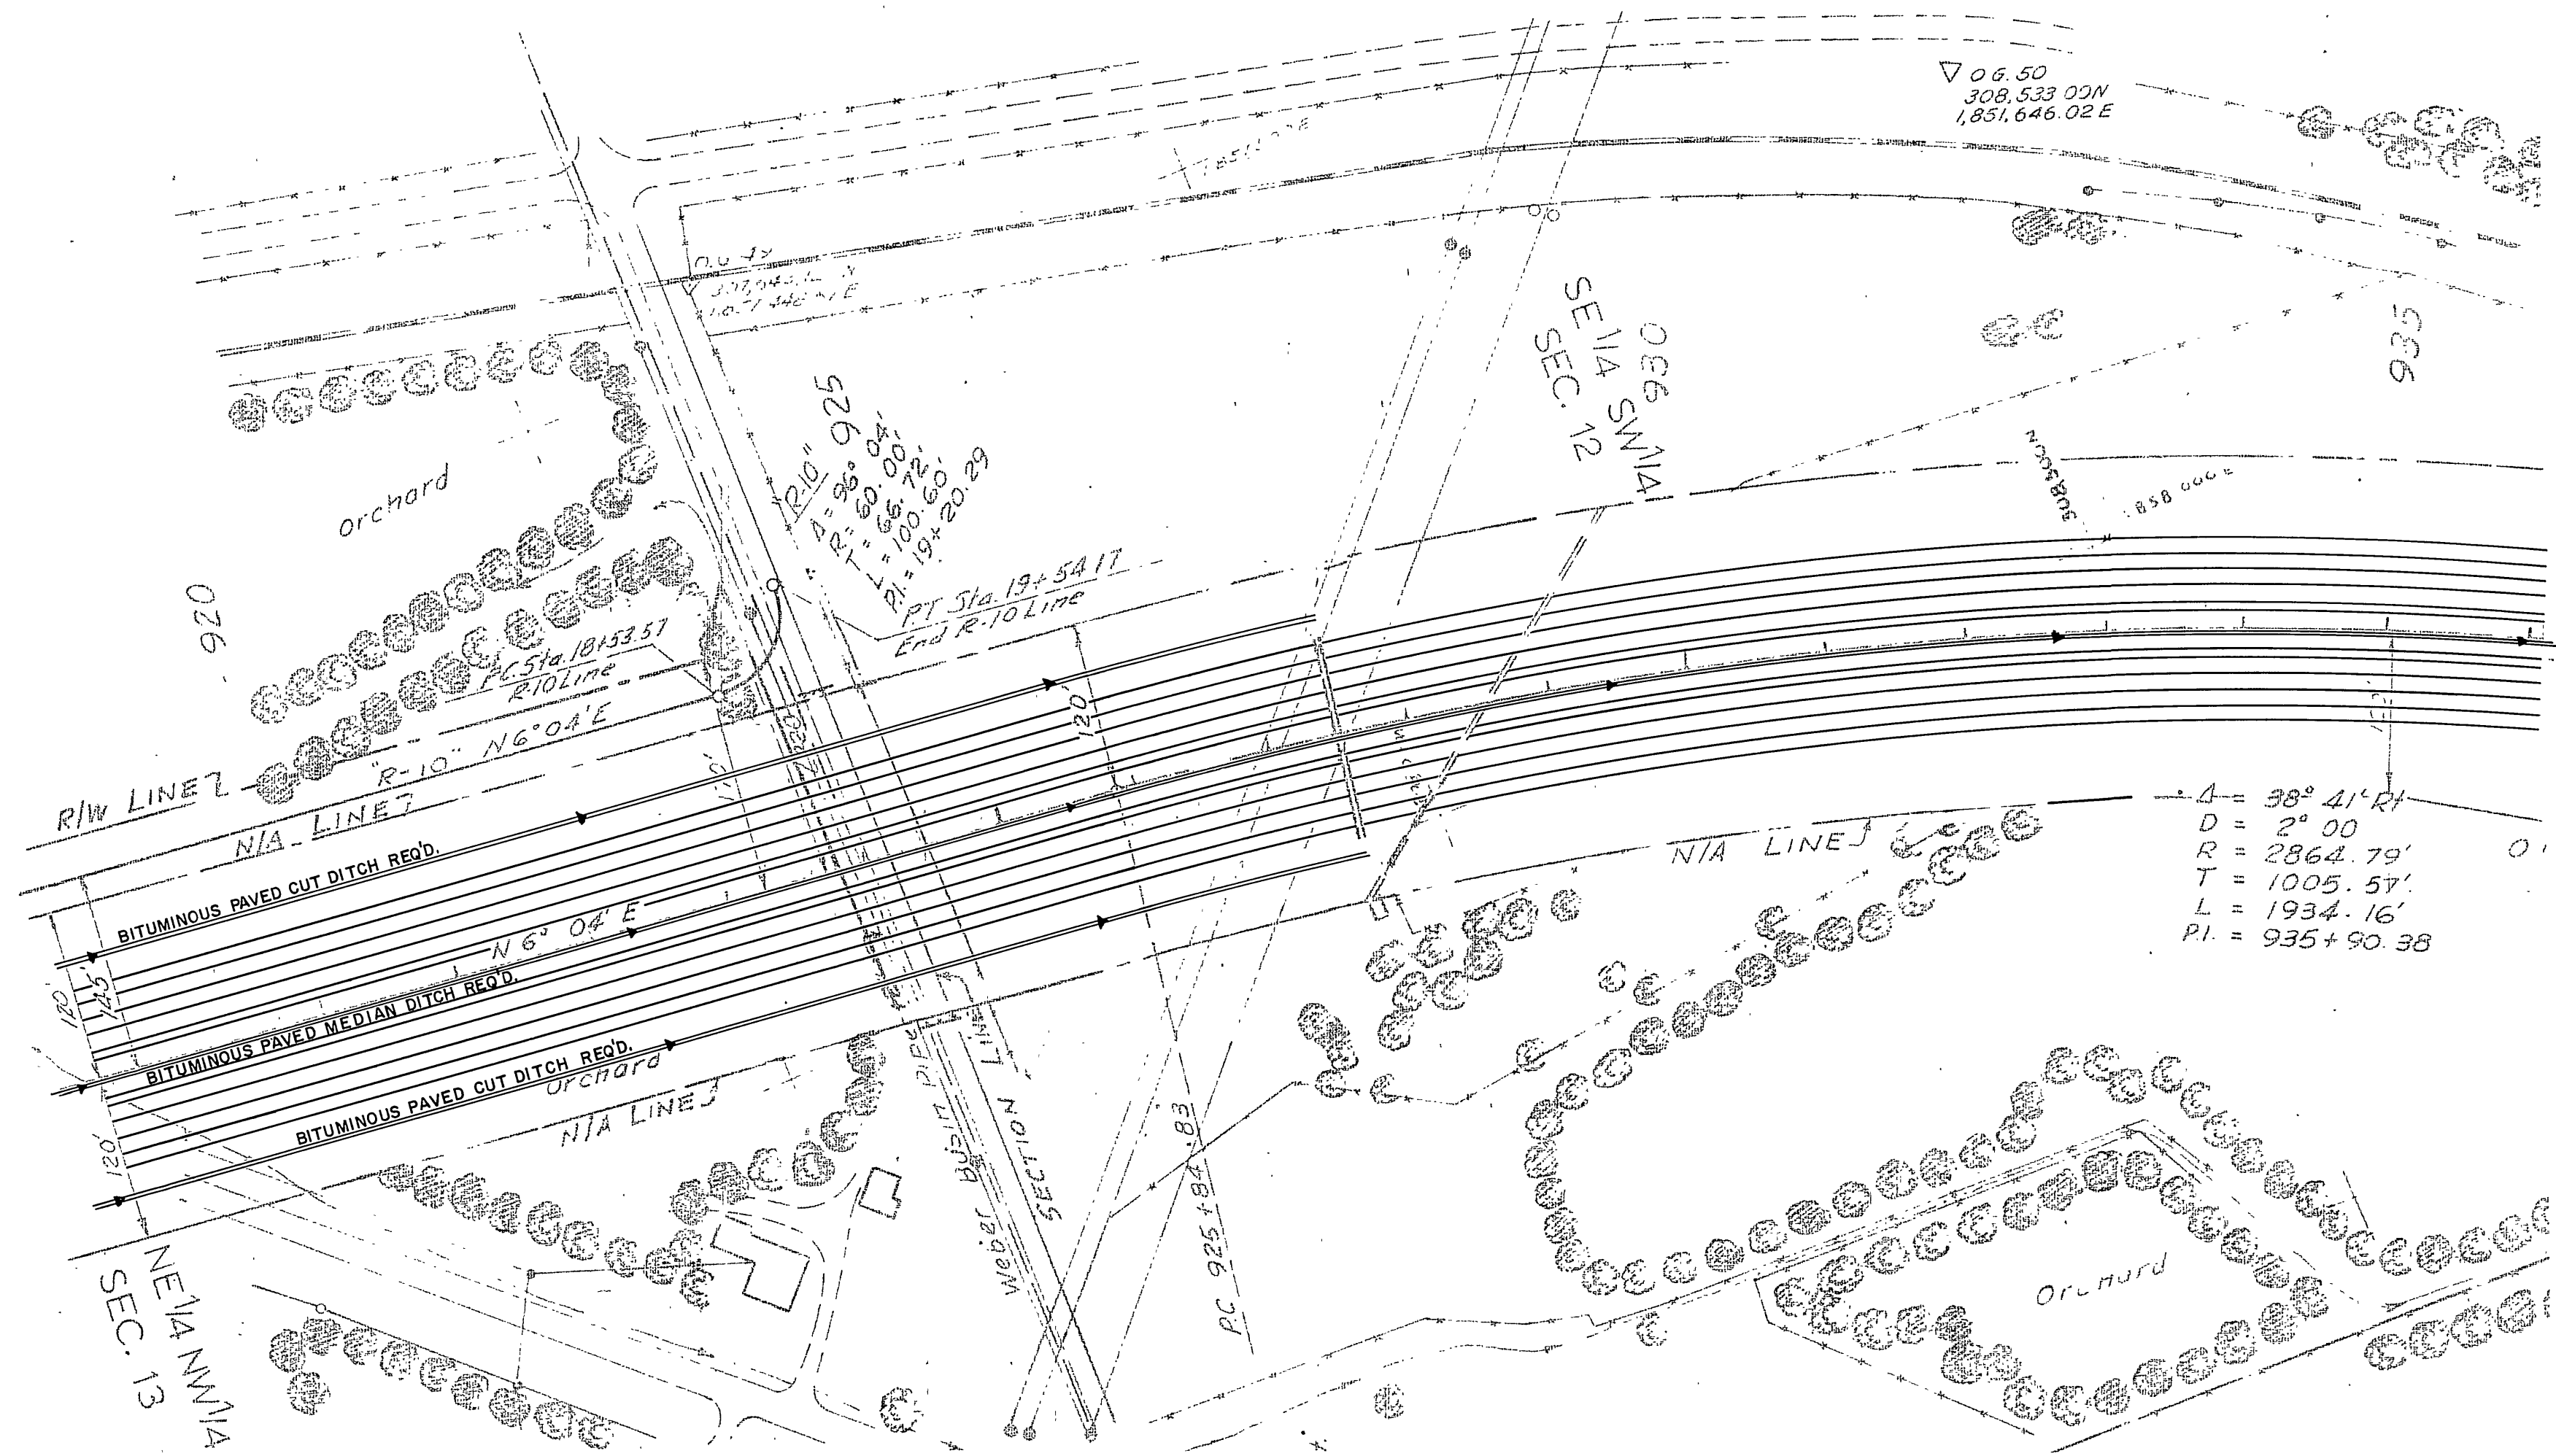

8-17-68 A

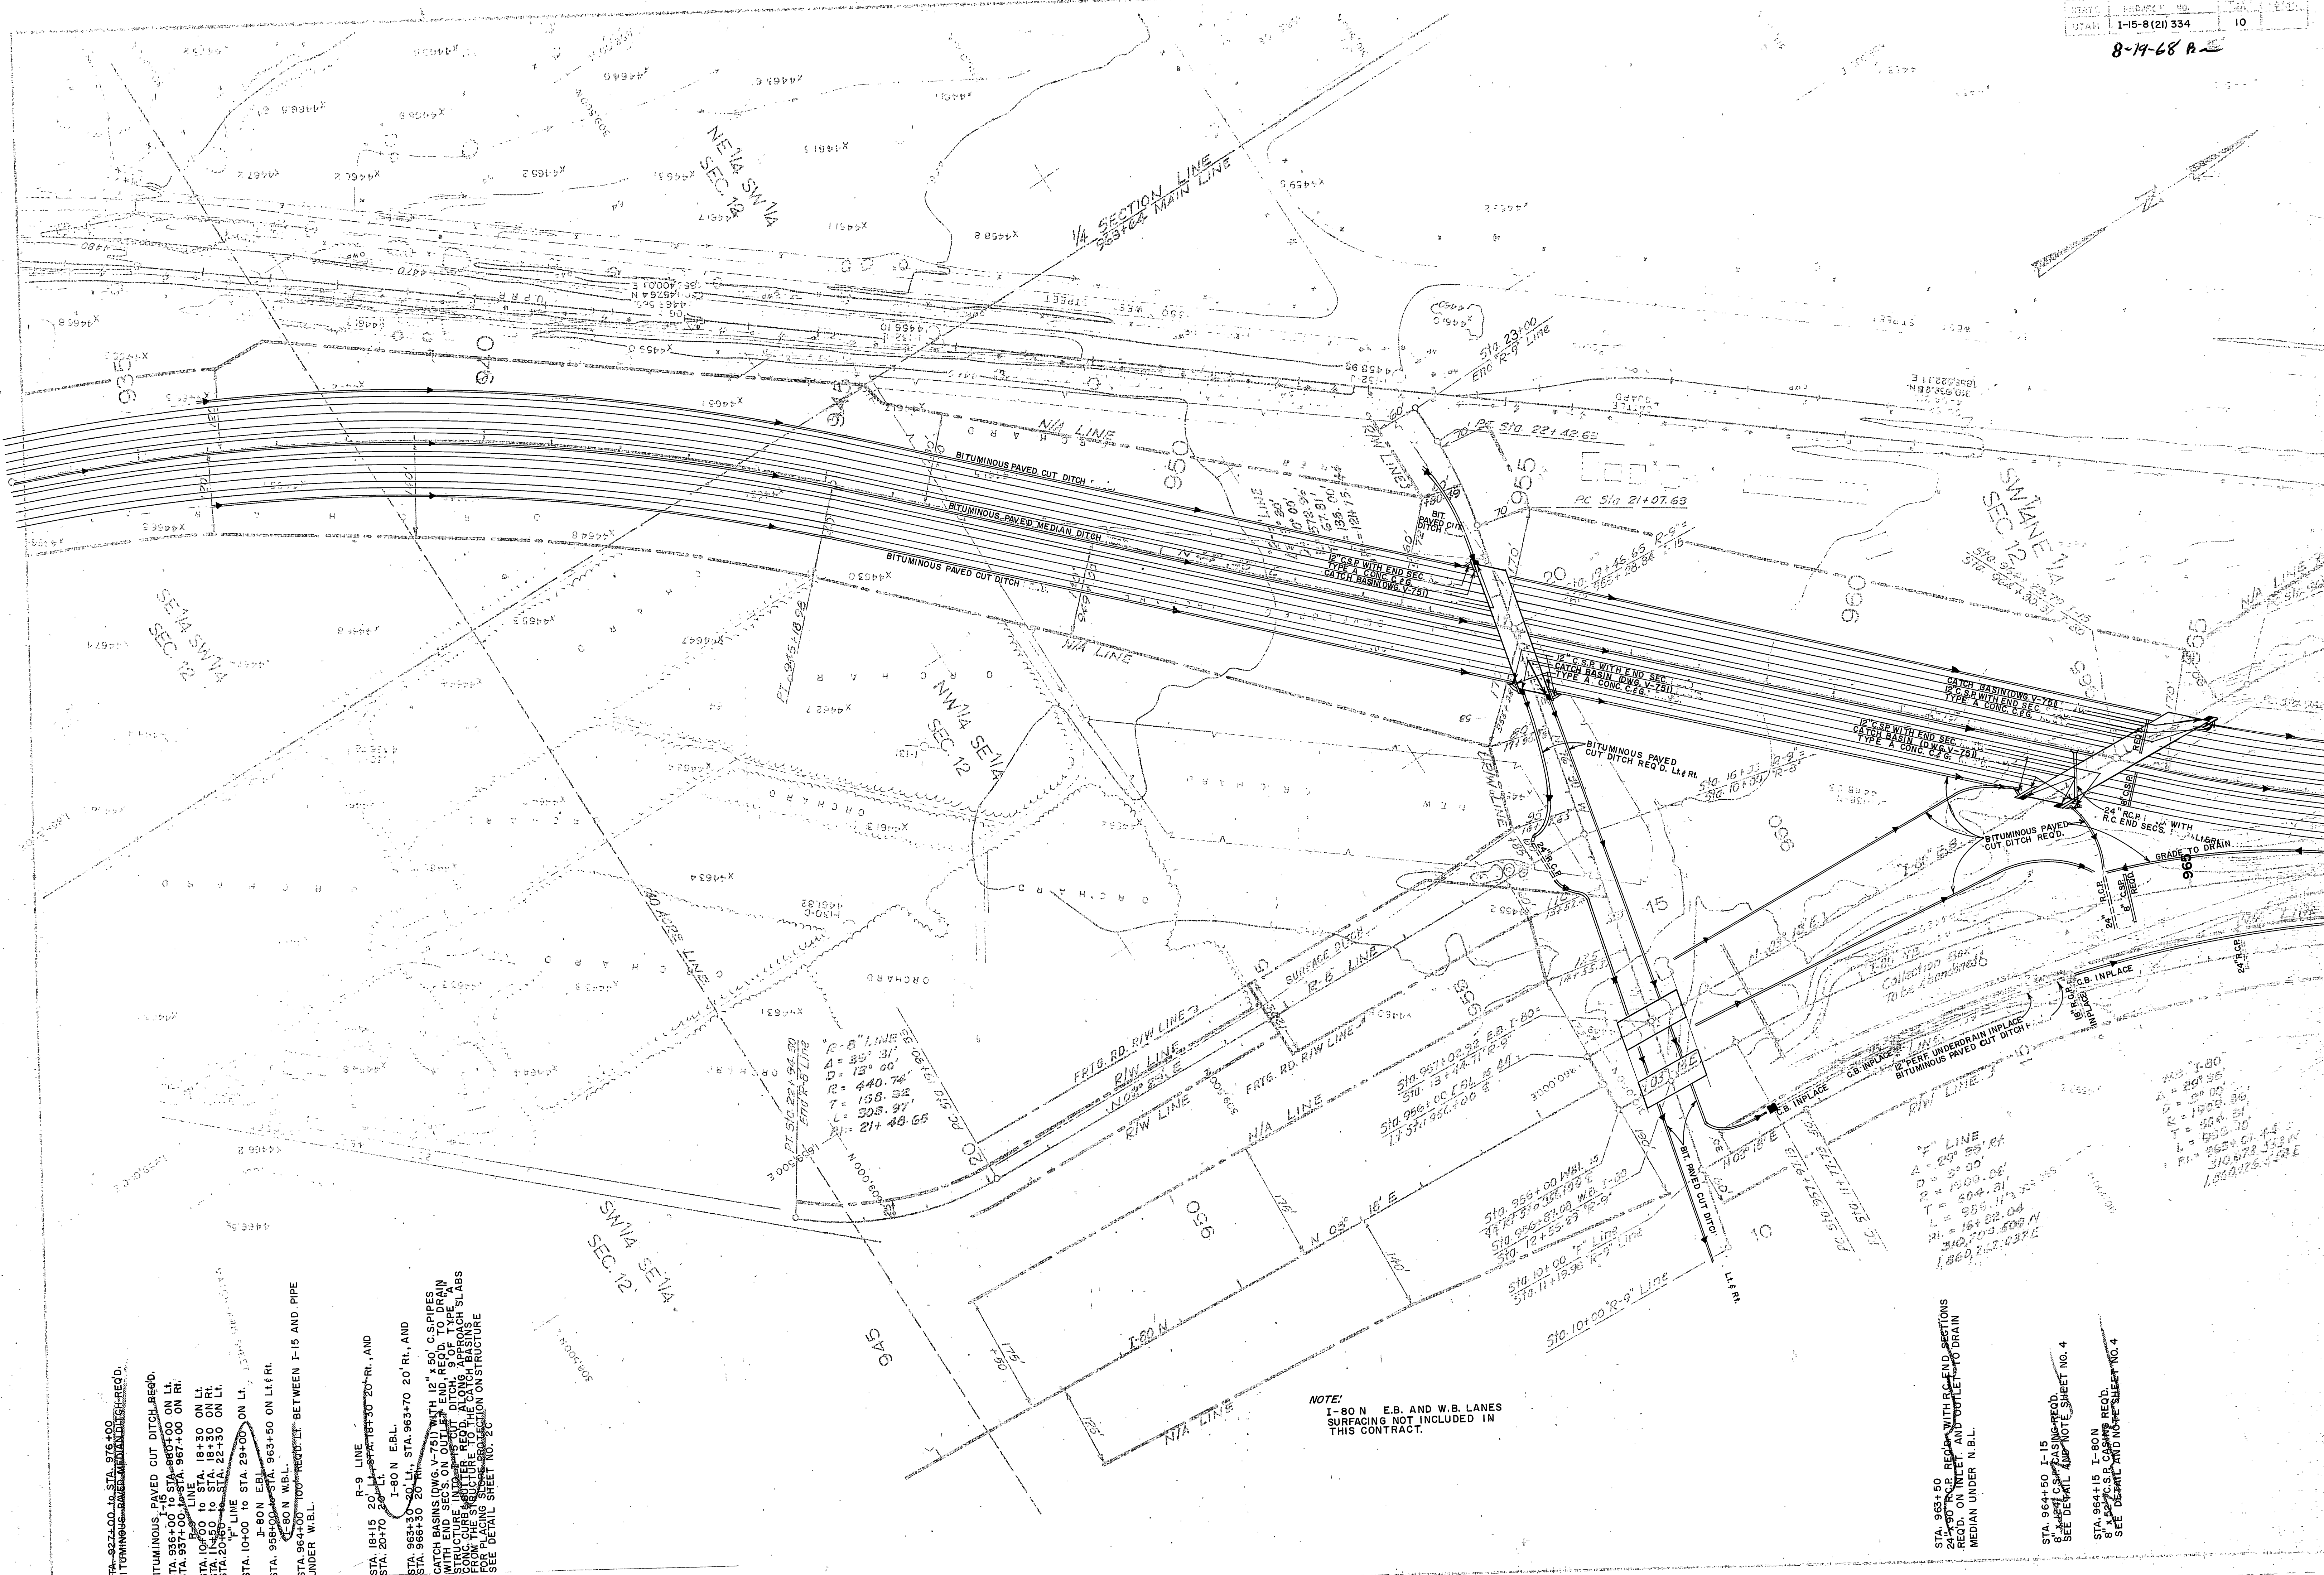

STA. 935+00 TO STA. 936+00
BITUMINOUS PAVED CUT DITCH REQD.

BITUMINOUS PAVED CUT DITCH REQD.
STA. 936+00 TO STA. 937+00 ON LI.
STA. 937+00 TO STA. 938+00 ON LI.
STA. 938+00 TO STA. 939+00 ON LI.
STA. 939+00 TO STA. 940+00 ON LI.
STA. 940+00 TO STA. 941+00 ON LI.
STA. 941+00 TO STA. 942+00 ON LI.
STA. 942+00 TO STA. 943+00 ON LI.
STA. 943+00 TO STA. 944+00 ON LI.
STA. 944+00 TO STA. 945+00 ON LI.
STA. 945+00 TO STA. 946+00 ON LI.
STA. 946+00 TO STA. 947+00 ON LI.
STA. 947+00 TO STA. 948+00 ON LI.
STA. 948+00 TO STA. 949+00 ON LI.
STA. 949+00 TO STA. 950+00 ON LI.
STA. 950+00 TO STA. 951+00 ON LI.
STA. 951+00 TO STA. 952+00 ON LI.
STA. 952+00 TO STA. 953+00 ON LI.
STA. 953+00 TO STA. 954+00 ON LI.
STA. 954+00 TO STA. 955+00 ON LI.
STA. 955+00 TO STA. 956+00 ON LI.
STA. 956+00 TO STA. 957+00 ON LI.
STA. 957+00 TO STA. 958+00 ON LI.
STA. 958+00 TO STA. 959+00 ON LI.
STA. 959+00 TO STA. 960+00 ON LI.
STA. 960+00 TO STA. 961+00 ON LI.
STA. 961+00 TO STA. 962+00 ON LI.
STA. 962+00 TO STA. 963+00 ON LI.
STA. 963+00 TO STA. 964+00 ON LI.
STA. 964+00 TO STA. 964+50 ON LI.

1-80 N. E.B. AND W.B. LANES
SURFACING NOT INCLUDED IN THIS CONTRACT.

1-80 N. E.B. AND W.B. LANES
SURFACING NOT INCLUDED IN THIS CONTRACT.


1-80 N. E.B. AND W.B. LANES
SURFACING NOT INCLUDED IN THIS CONTRACT.

1-80 N. E.B. AND W.B. LANES
SURFACING NOT INCLUDED IN THIS CONTRACT.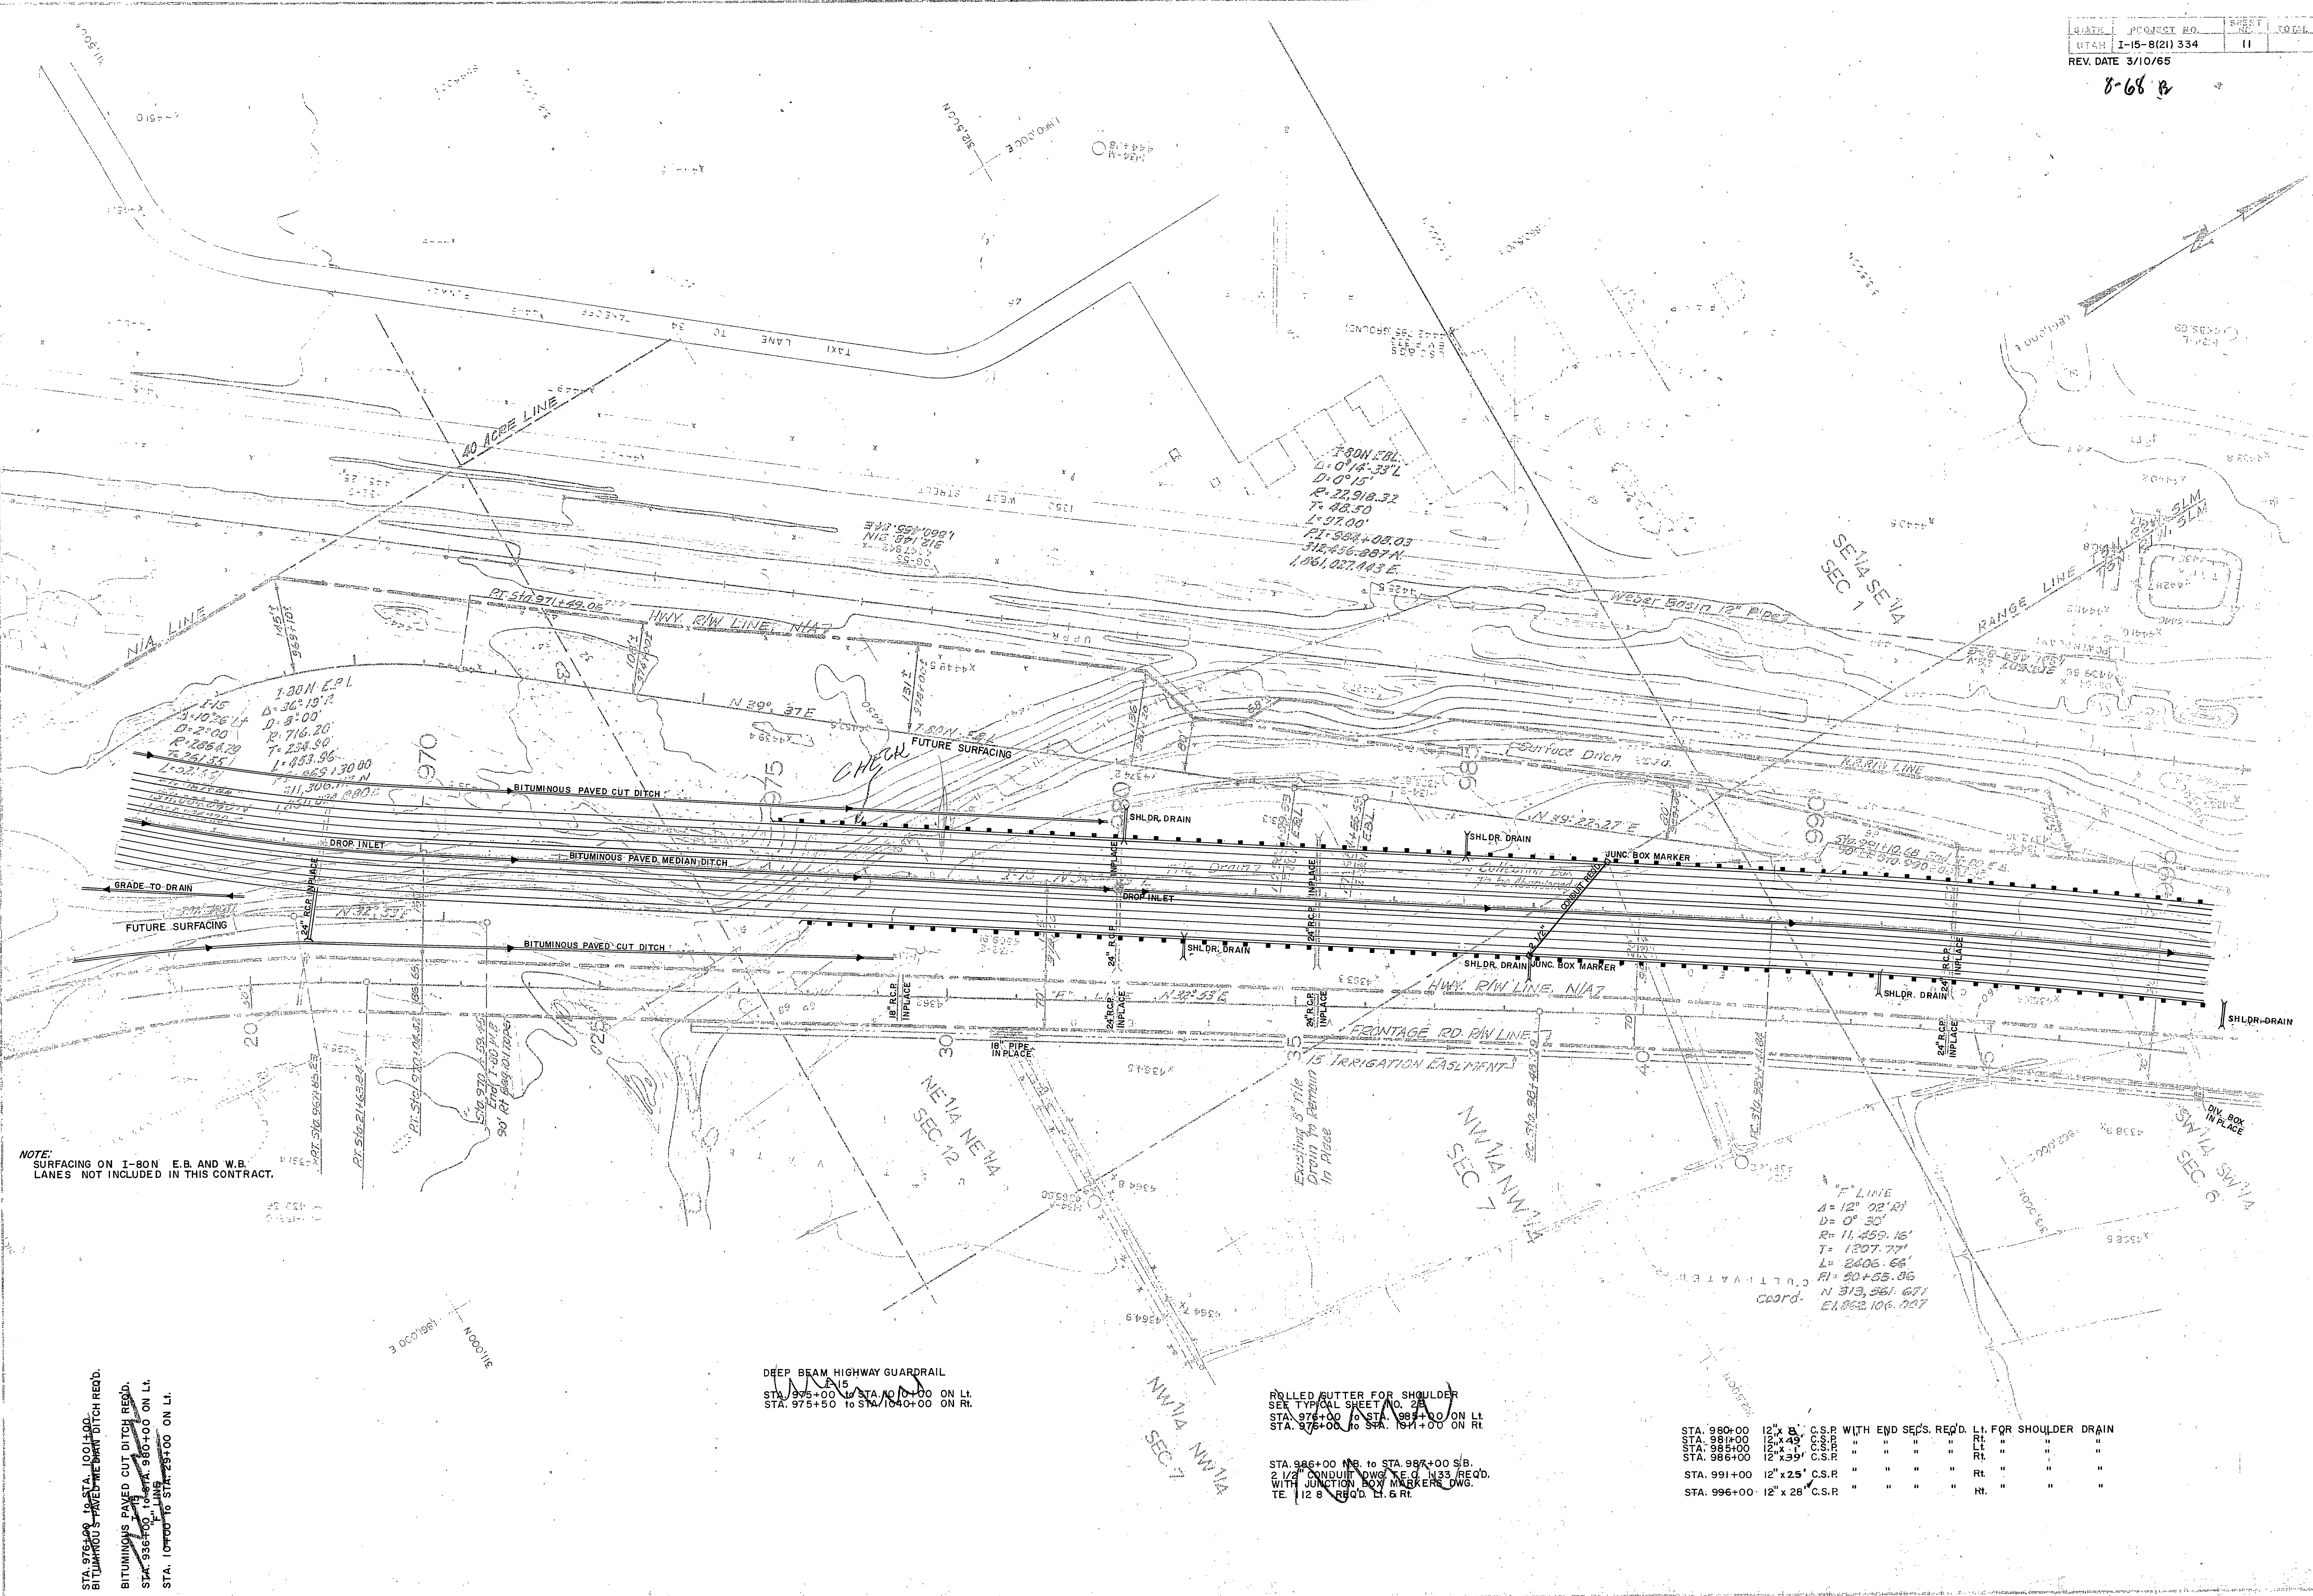

NOTE: SURFACING ON I-80N E.B. AND W.B. LANES NOT INCLUDED IN THIS CONTRACT.

STA. 975+00 TO STA. 1001+00
BITUMINOUS PAVED MEDIAN DITCH REQ'D.
BITUMINOUS PAVED CUT DITCH REQ'D.
STA. 936+00 TO STA. 980+00 ON L.
STA. 1000+00 TO STA. 291+00 ON L.



DEEP BEAM HIGHWAY GUARDRAIL
STA. 975+00 TO STA. 1001+00 ON L.
STA. 975+50 TO STA. 1001+00 ON R.

ROLLED BUTTER FOR SHOULDER
SEE TYPICAL SHEET NO. 218
STA. 975+00 TO STA. 989+00 ON L.
STA. 975+00 TO STA. 1001+00 ON R.

STA. 986+00 TO STA. 987+00 S.B.
2 1/2\" CONDUIT DWG. E.C. IN 33\" REQ'D.
WITH JUNCTION BOX MARKERS DWG.
TE. 12\" B\" REQ'D. L.F. 6\" R.

STA. 980+00	12\" x 8\" C.S.R.	WITH END SECS. REQ'D.	L.F. FOR SHOULDER DRAIN
STA. 981+00	12\" x 8\" C.S.R.	" " " "	" " " "
STA. 982+00	12\" x 8\" C.S.R.	" " " "	" " " "
STA. 983+00	12\" x 8\" C.S.R.	" " " "	" " " "
STA. 984+00	12\" x 8\" C.S.R.	" " " "	" " " "
STA. 985+00	12\" x 8\" C.S.R.	" " " "	" " " "
STA. 986+00	12\" x 8\" C.S.R.	" " " "	" " " "
STA. 987+00	12\" x 8\" C.S.R.	" " " "	" " " "
STA. 988+00	12\" x 8\" C.S.R.	" " " "	" " " "
STA. 989+00	12\" x 8\" C.S.R.	" " " "	" " " "
STA. 990+00	12\" x 8\" C.S.R.	" " " "	" " " "
STA. 991+00	12\" x 8\" C.S.R.	" " " "	" " " "
STA. 992+00	12\" x 8\" C.S.R.	" " " "	" " " "
STA. 993+00	12\" x 8\" C.S.R.	" " " "	" " " "
STA. 994+00	12\" x 8\" C.S.R.	" " " "	" " " "
STA. 995+00	12\" x 8\" C.S.R.	" " " "	" " " "
STA. 996+00	12\" x 8\" C.S.R.	" " " "	" " " "
STA. 997+00	12\" x 8\" C.S.R.	" " " "	" " " "
STA. 998+00	12\" x 8\" C.S.R.	" " " "	" " " "
STA. 999+00	12\" x 8\" C.S.R.	" " " "	" " " "
STA. 1000+00	12\" x 8\" C.S.R.	" " " "	" " " "
STA. 1001+00	12\" x 8\" C.S.R.	" " " "	" " " "

B-20-68

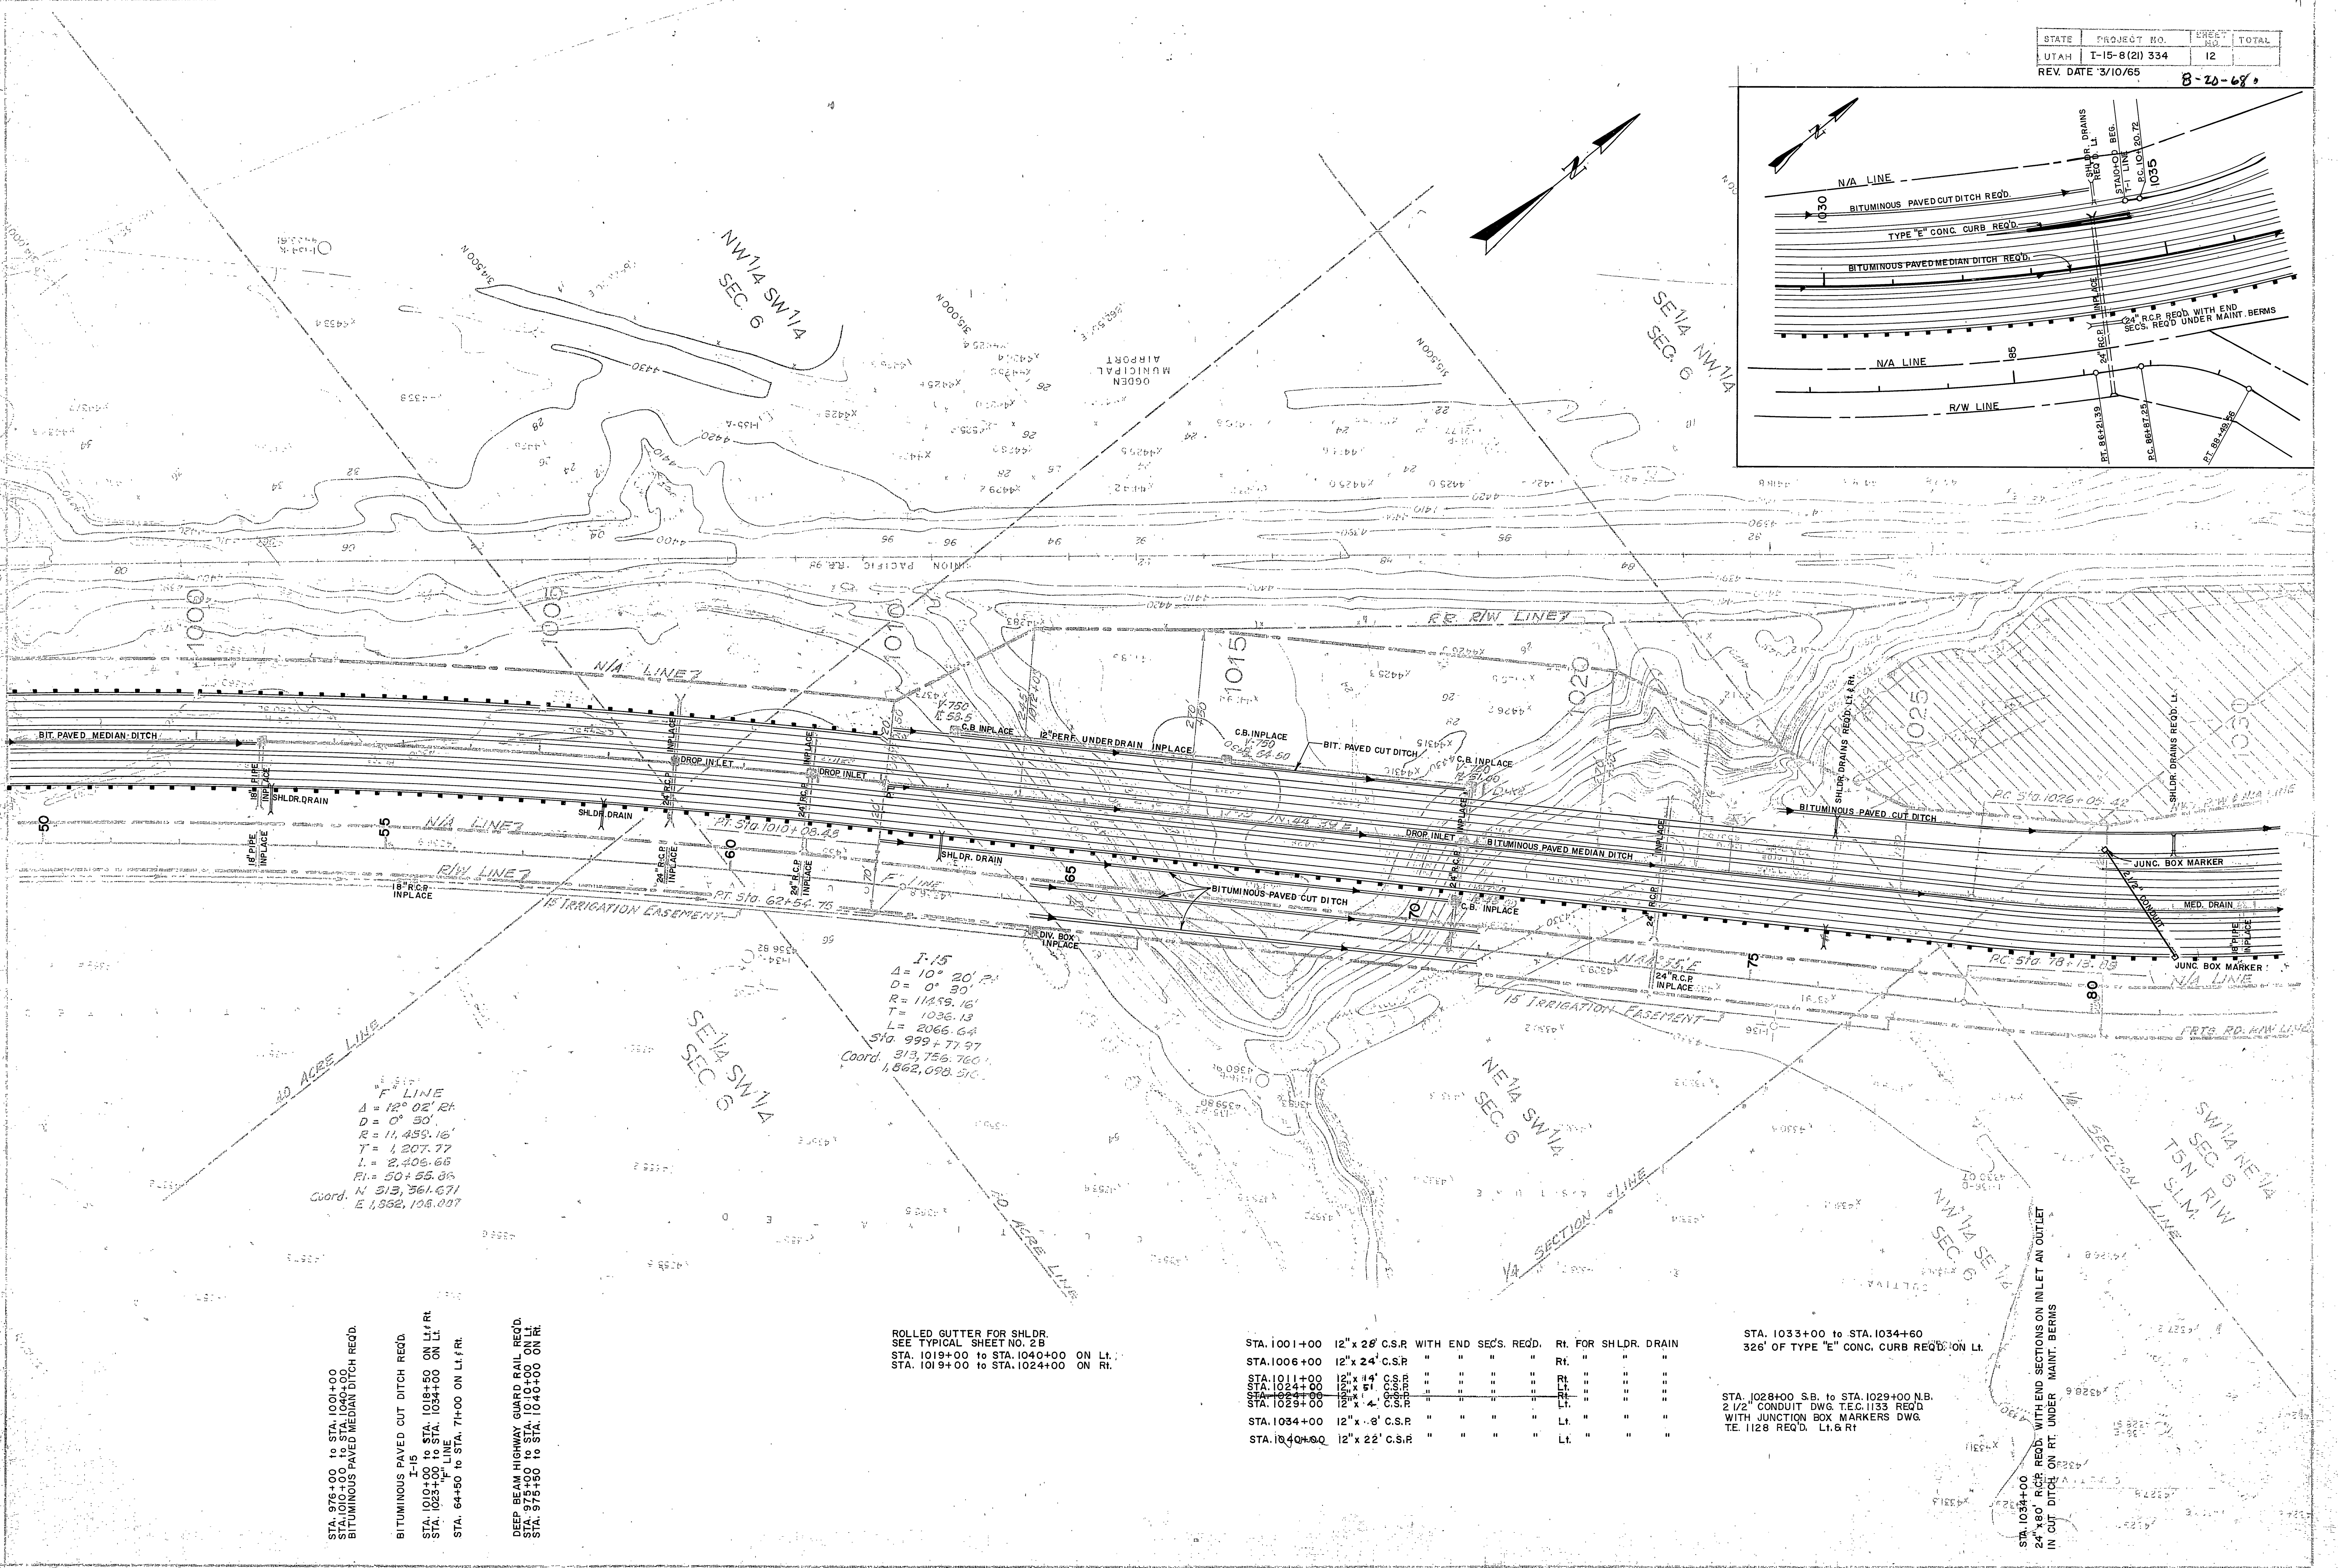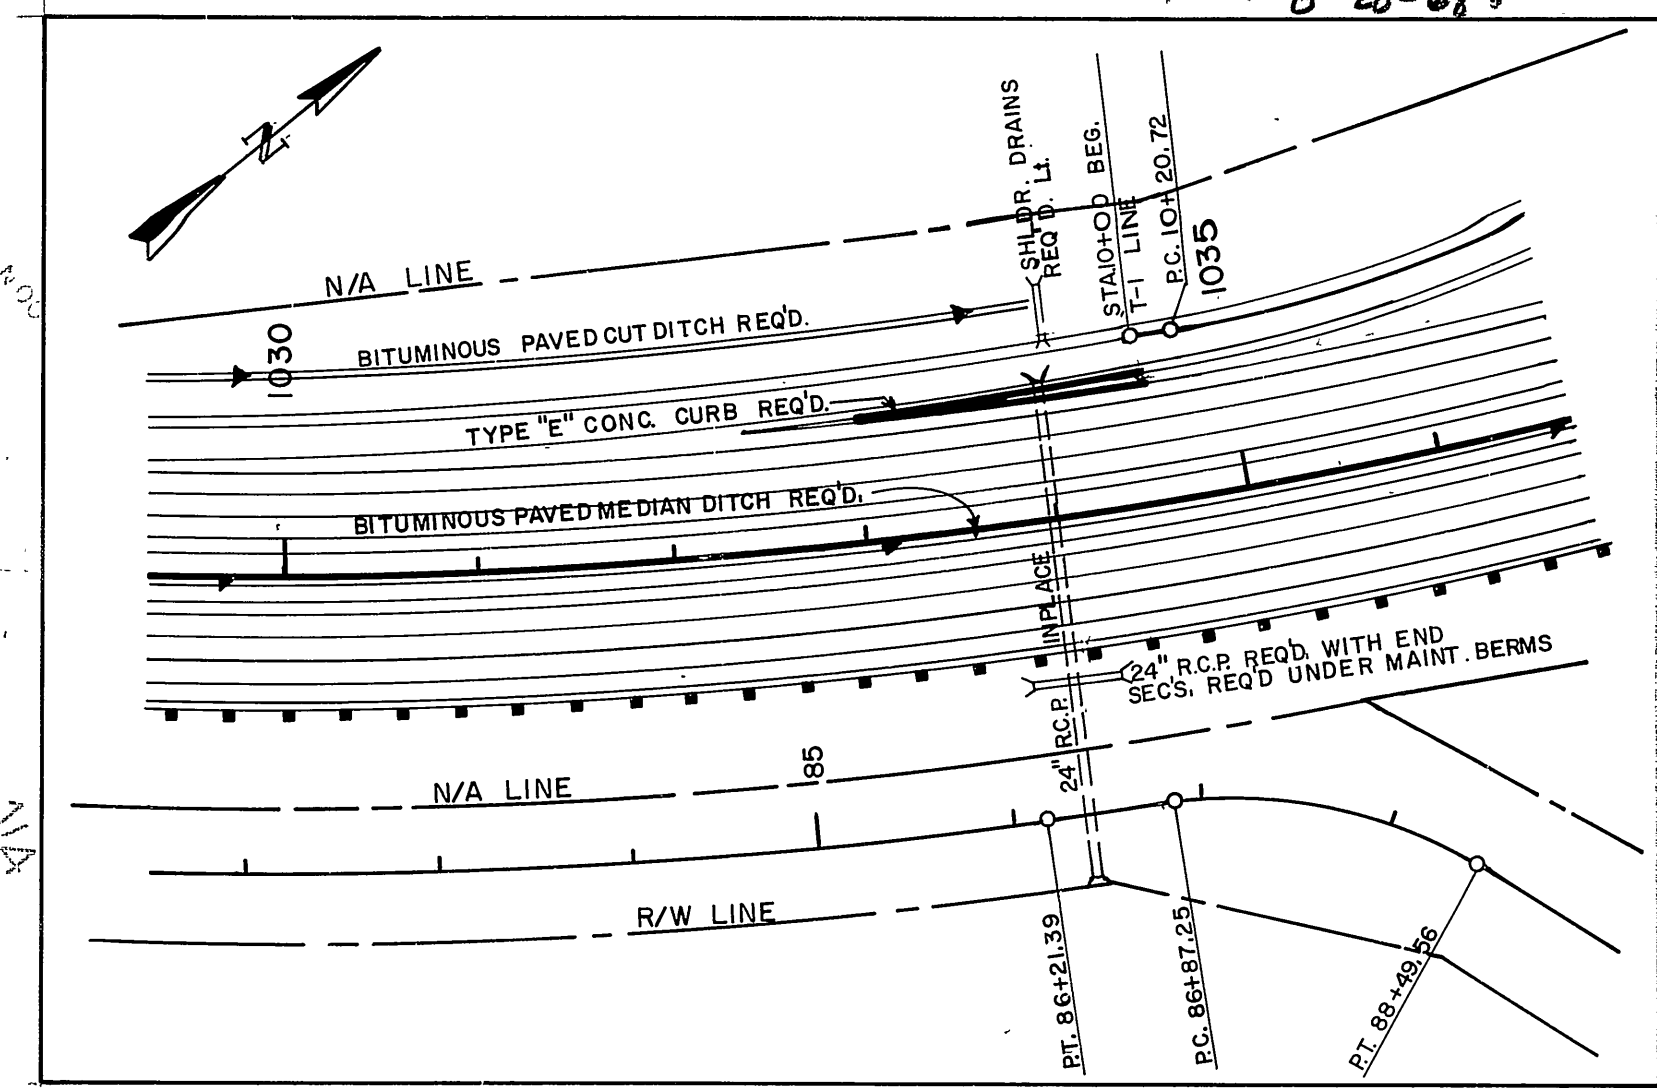

STA. 976+00 to STA. 1001+00
 STA. 1001+00 to STA. 1004+00
 BITUMINOUS PAVED MEDIAN DITCH REQ'D.
 BITUMINOUS PAVED CUT DITCH REQ'D.
 STA. 1004+00 to STA. 1019+00 ON LI.
 STA. 1019+00 to STA. 1024+00 ON RT.
 STA. 1024+00 to STA. 1034+00 ON LI.
 STA. 1034+00 to STA. 1040+00 ON RT.


DEEP BEAM HIGHWAY GUARD RAIL REQ'D.
 STA. 976+00 to STA. 1001+00 ON LI.
 STA. 1001+00 to STA. 1004+00 ON RT.


STA. 1001+00	12" x 28' C.S.P.	WITH END SECS. REQ'D.	RT. FOR SHLDR. DRAIN
STA. 1006+00	12" x 24' C.S.P.	" " " " " "	" " " " " "
STA. 1011+00	12" x 14' C.S.P.	" " " " " "	" " " " " "
STA. 1024+00	12" x 14' C.S.P.	" " " " " "	" " " " " "
STA. 1029+00	12" x 4' C.S.P.	" " " " " "	" " " " " "
STA. 1034+00	12" x 8' C.S.P.	" " " " " "	" " " " " "
STA. 1040+00	12" x 22' C.S.P.	" " " " " "	" " " " " "

STA. 1033+00 to STA. 1034+00
 326' OF TYPE "E" CONC. CURB REQ'D. ON LI.


STA. 1028+00 S.B. to STA. 1029+00 N.B.
 2 1/2" CONDUIT DWG. T.E.C. 1133 REQ'D.
 WITH JUNCTION BOX MARKERS DWG.
 T.E. 1128 REQ'D. LI & RT

STA. 1034+00
 24" x 80" RCP REQ'D. WITH END SECTIONS ON INLET AN OUTLET
 IN CUT DITCH ON RT. UNDER MAINT. BERMS


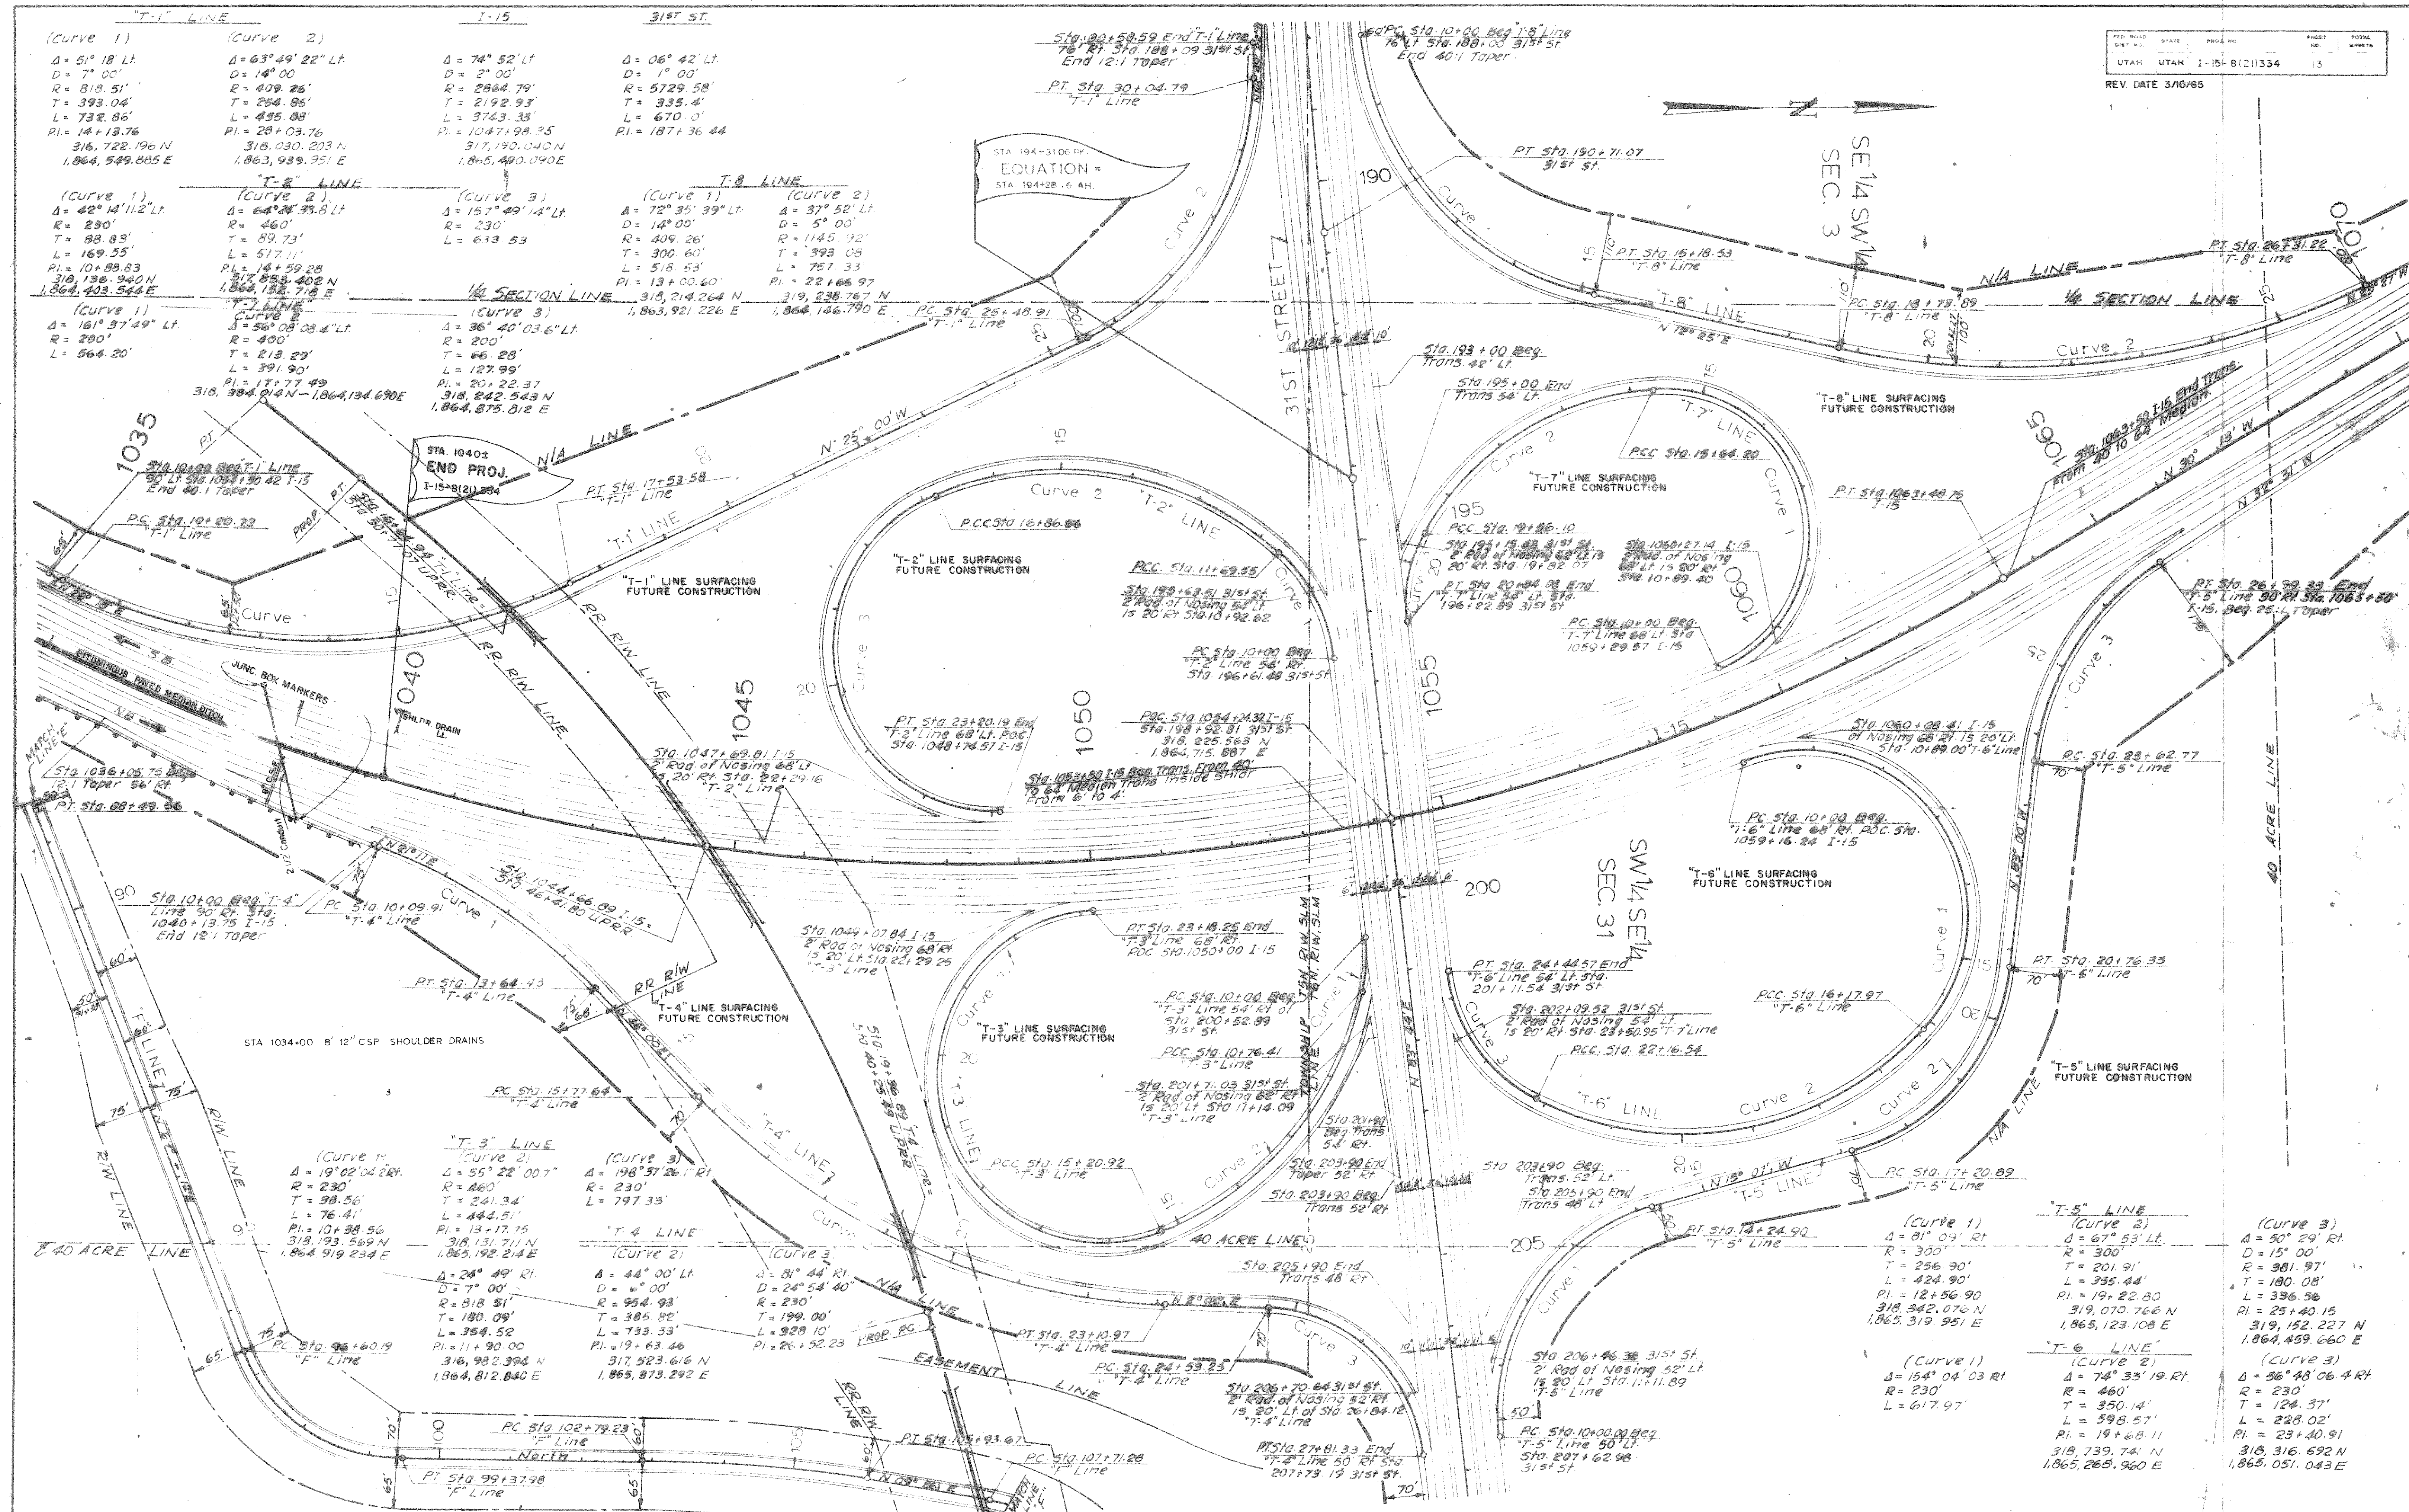



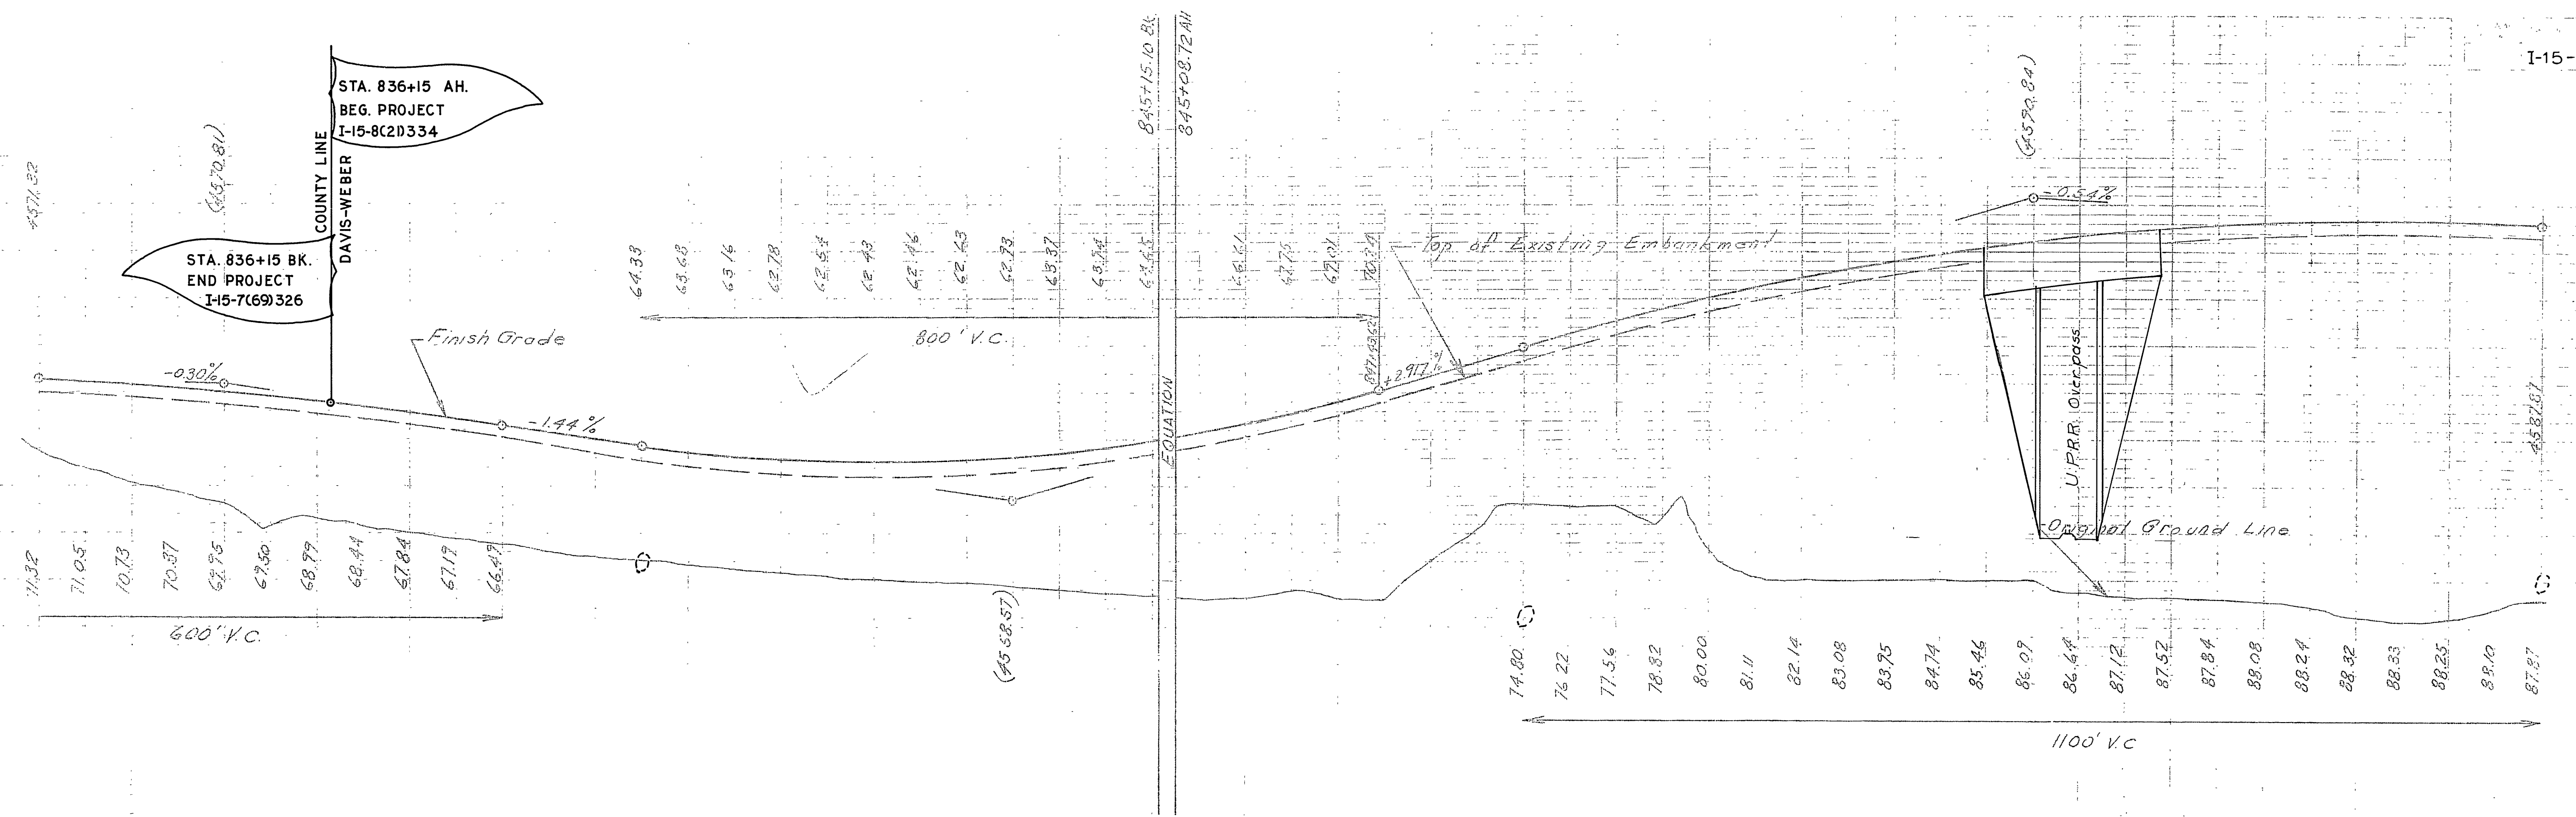




NORTH BOUND LANE


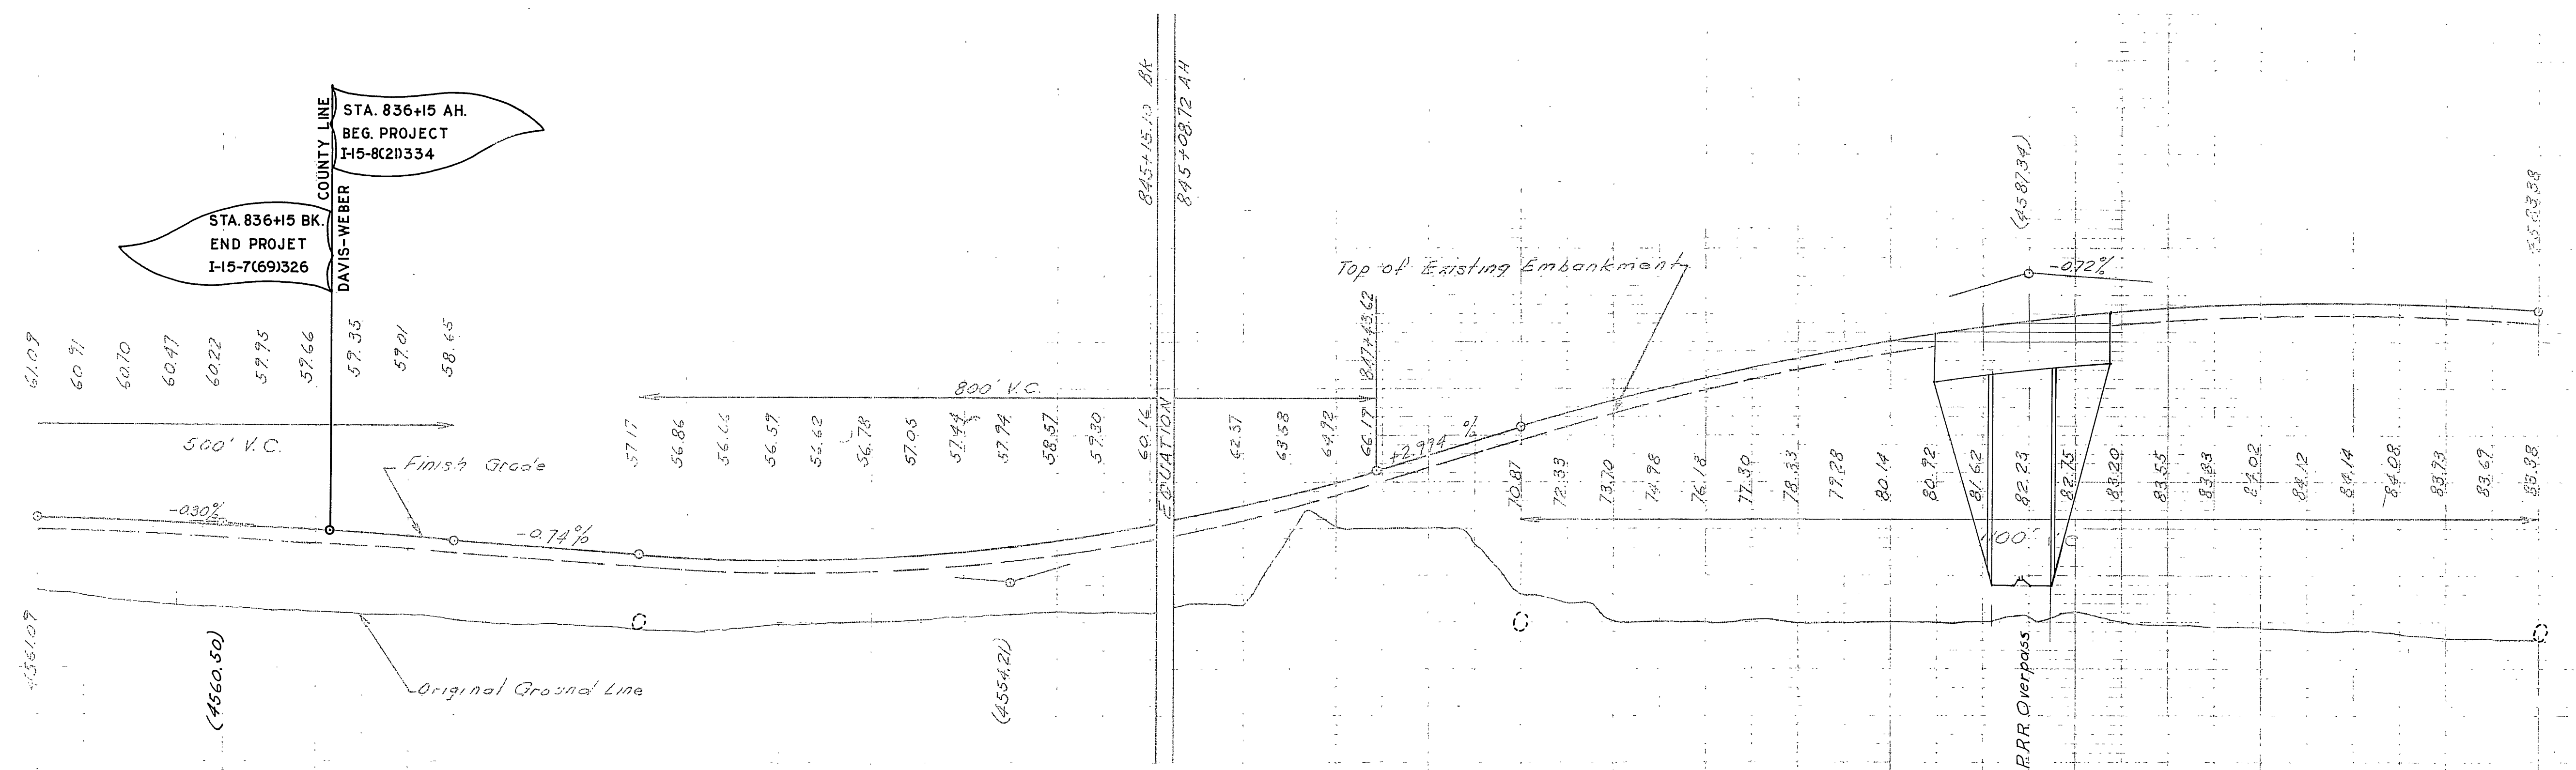




SOUTH BOUND LANE

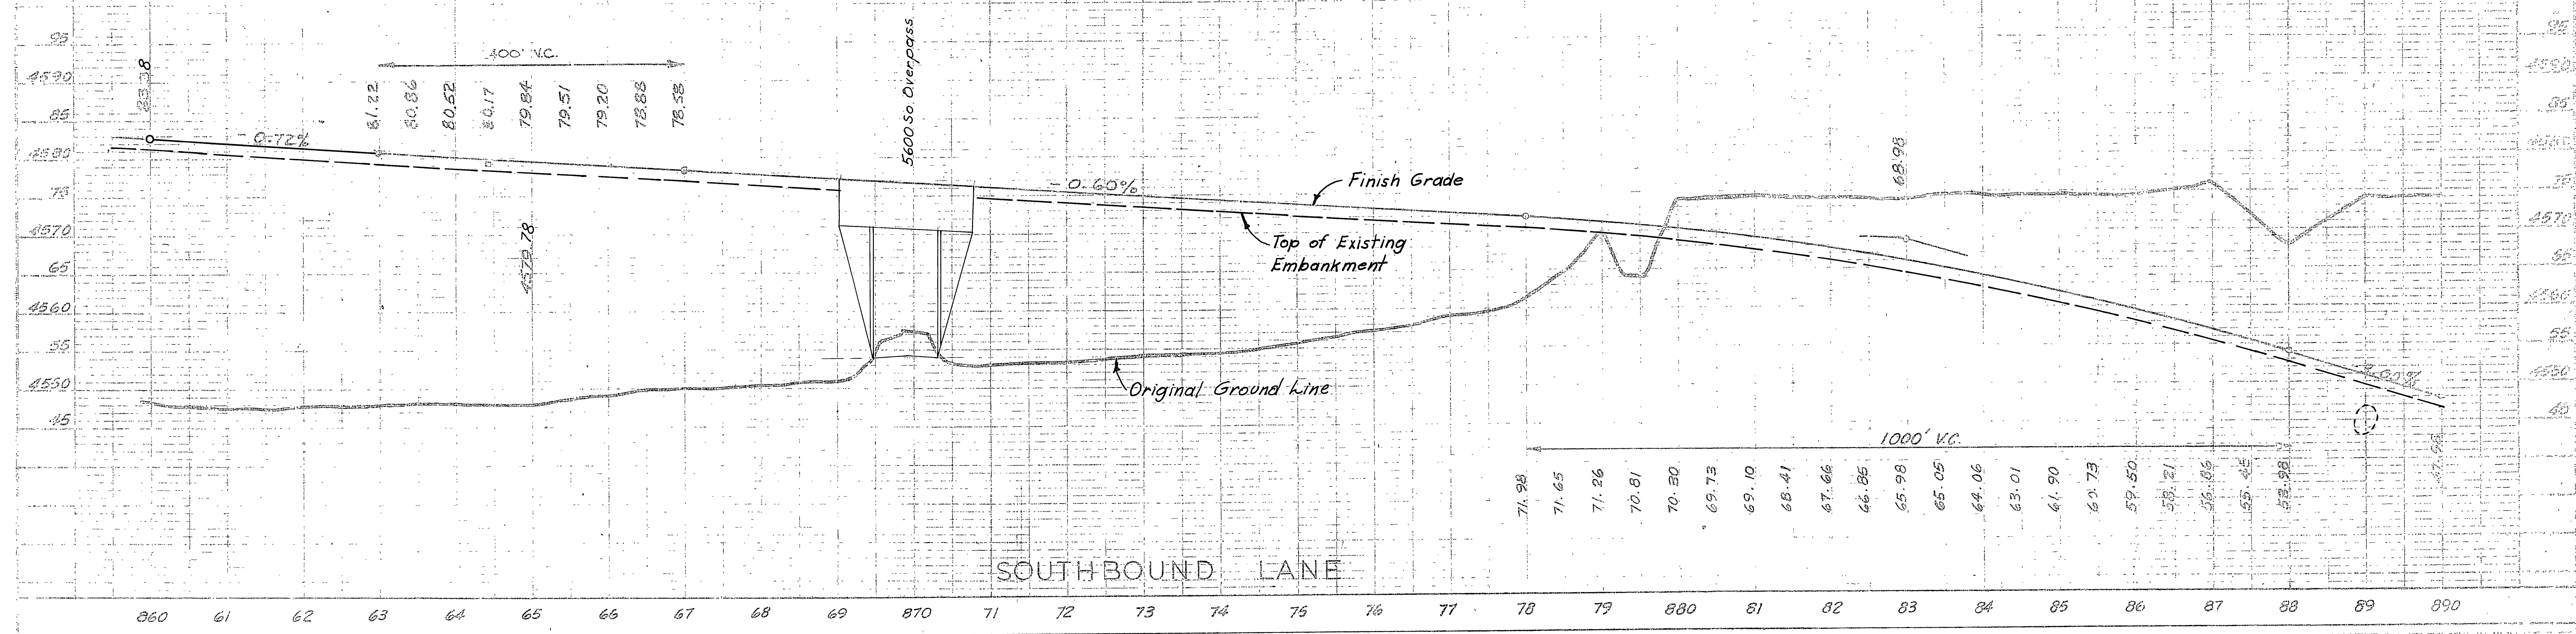
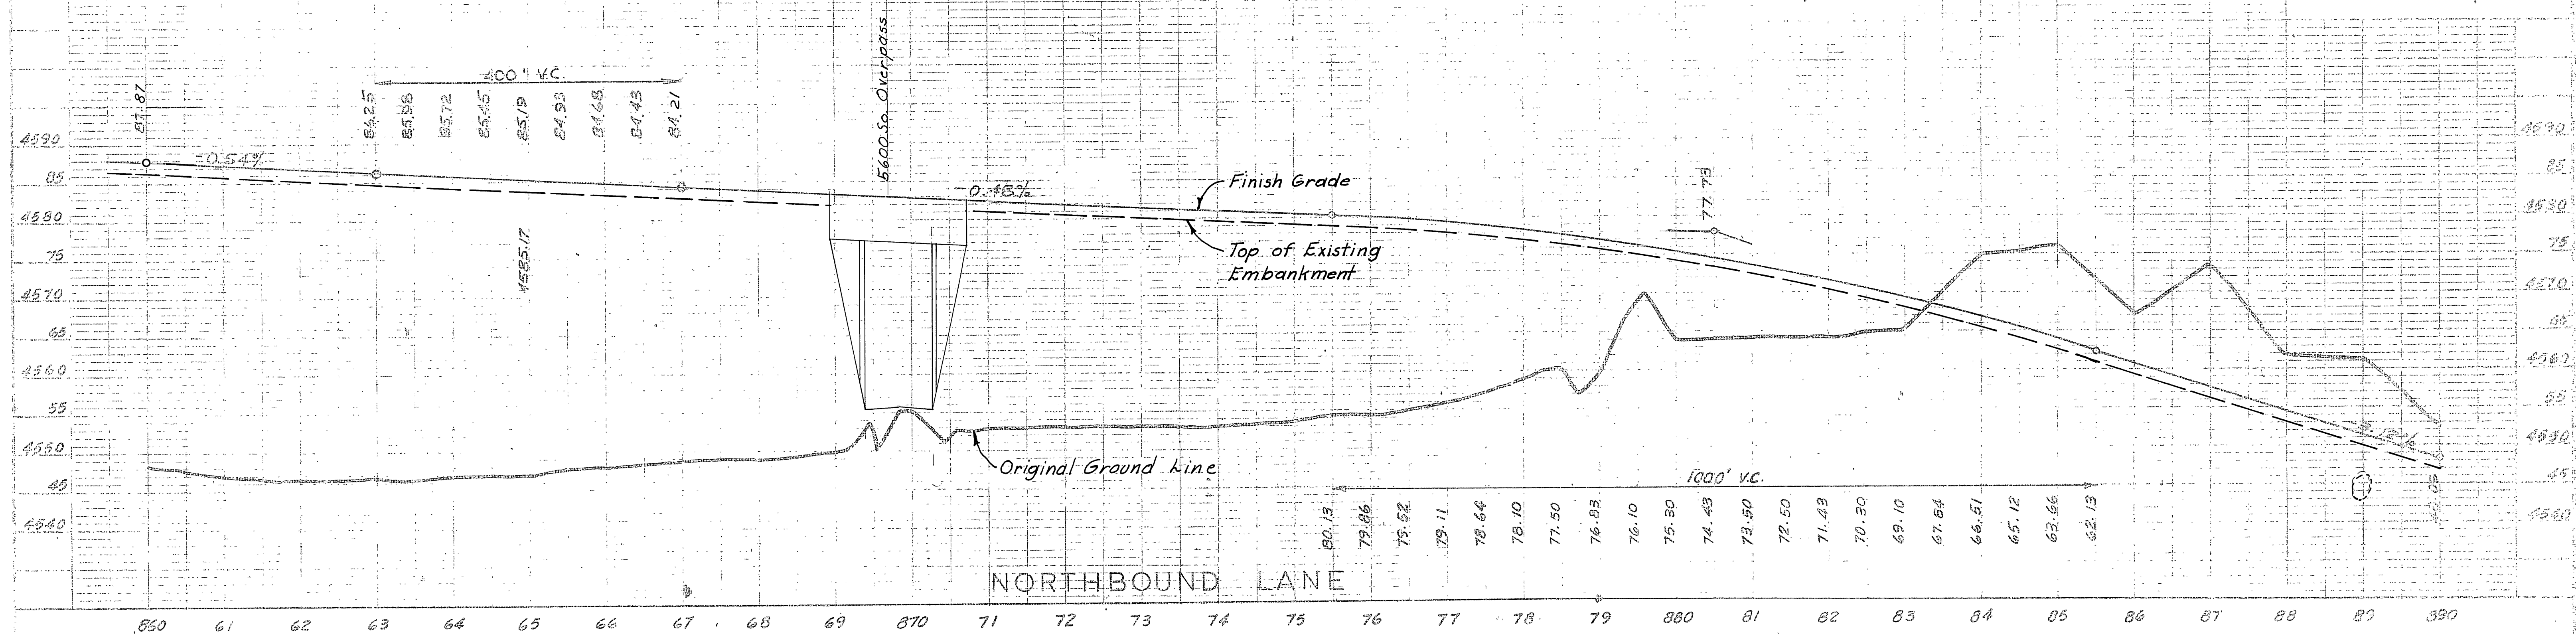


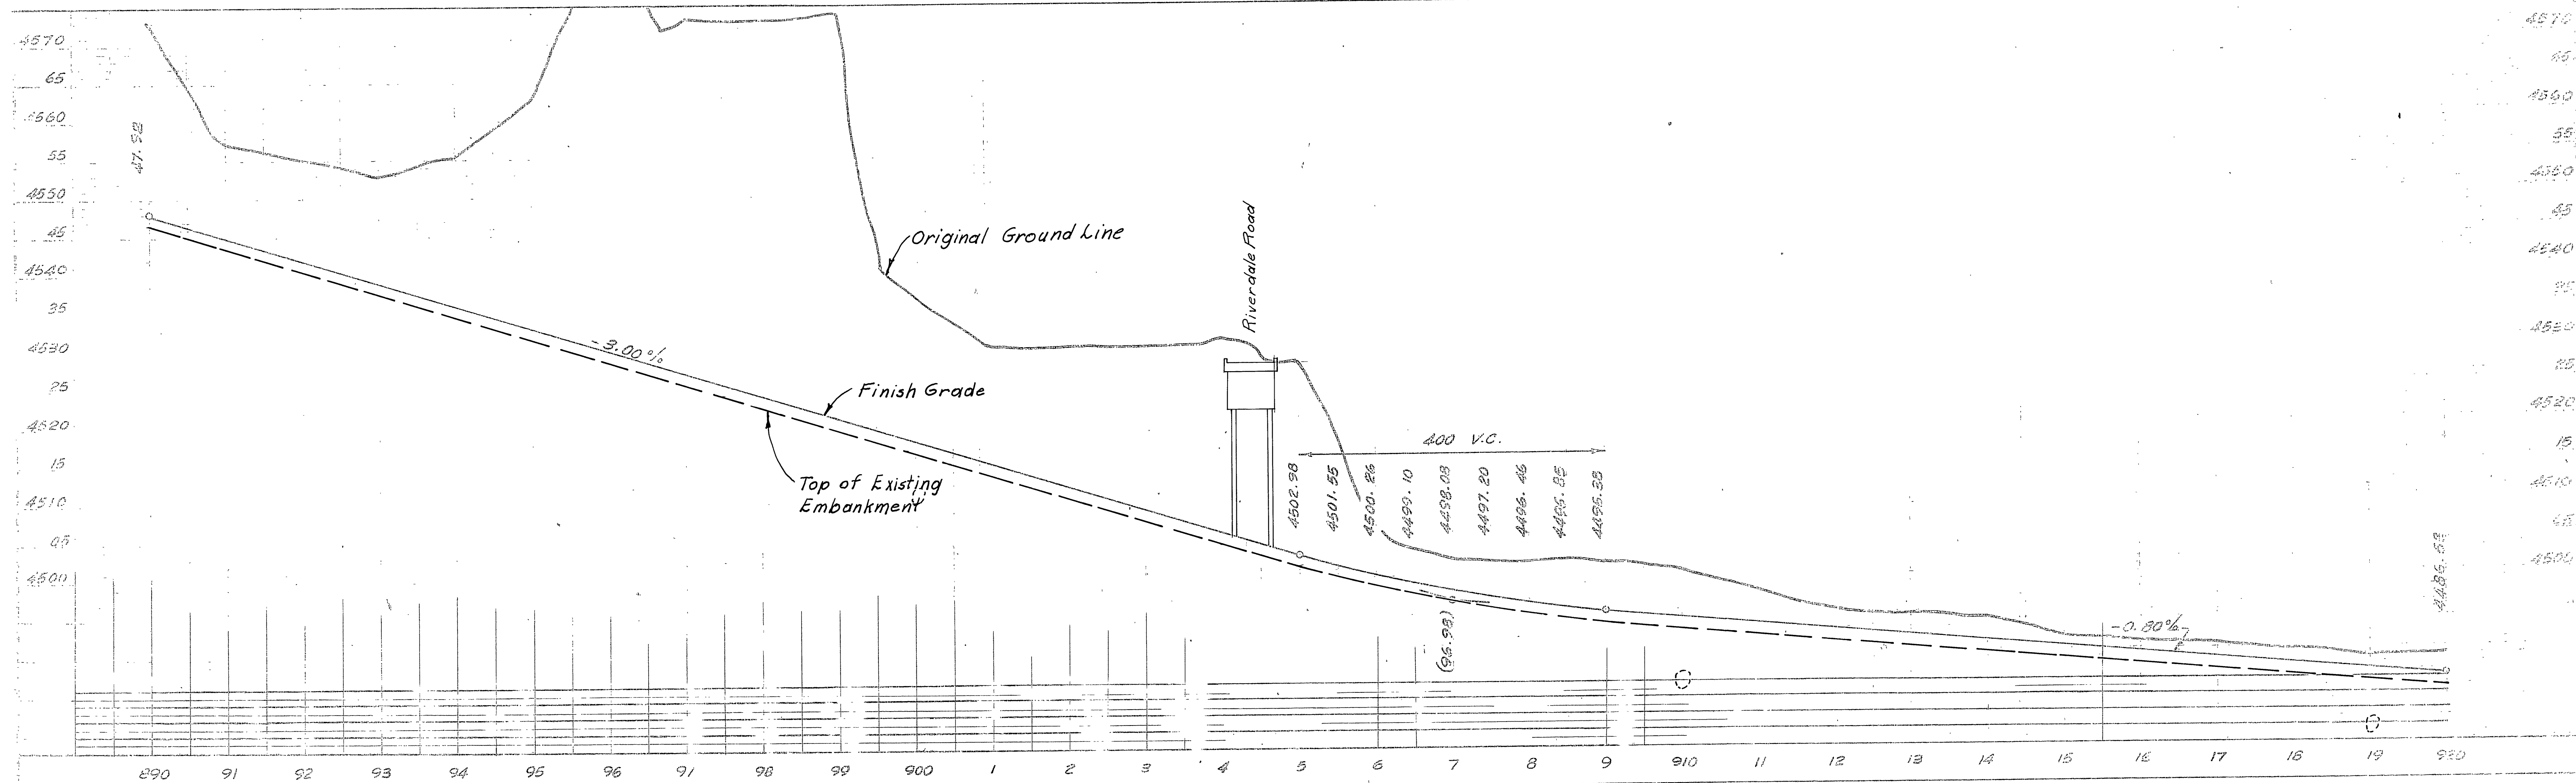
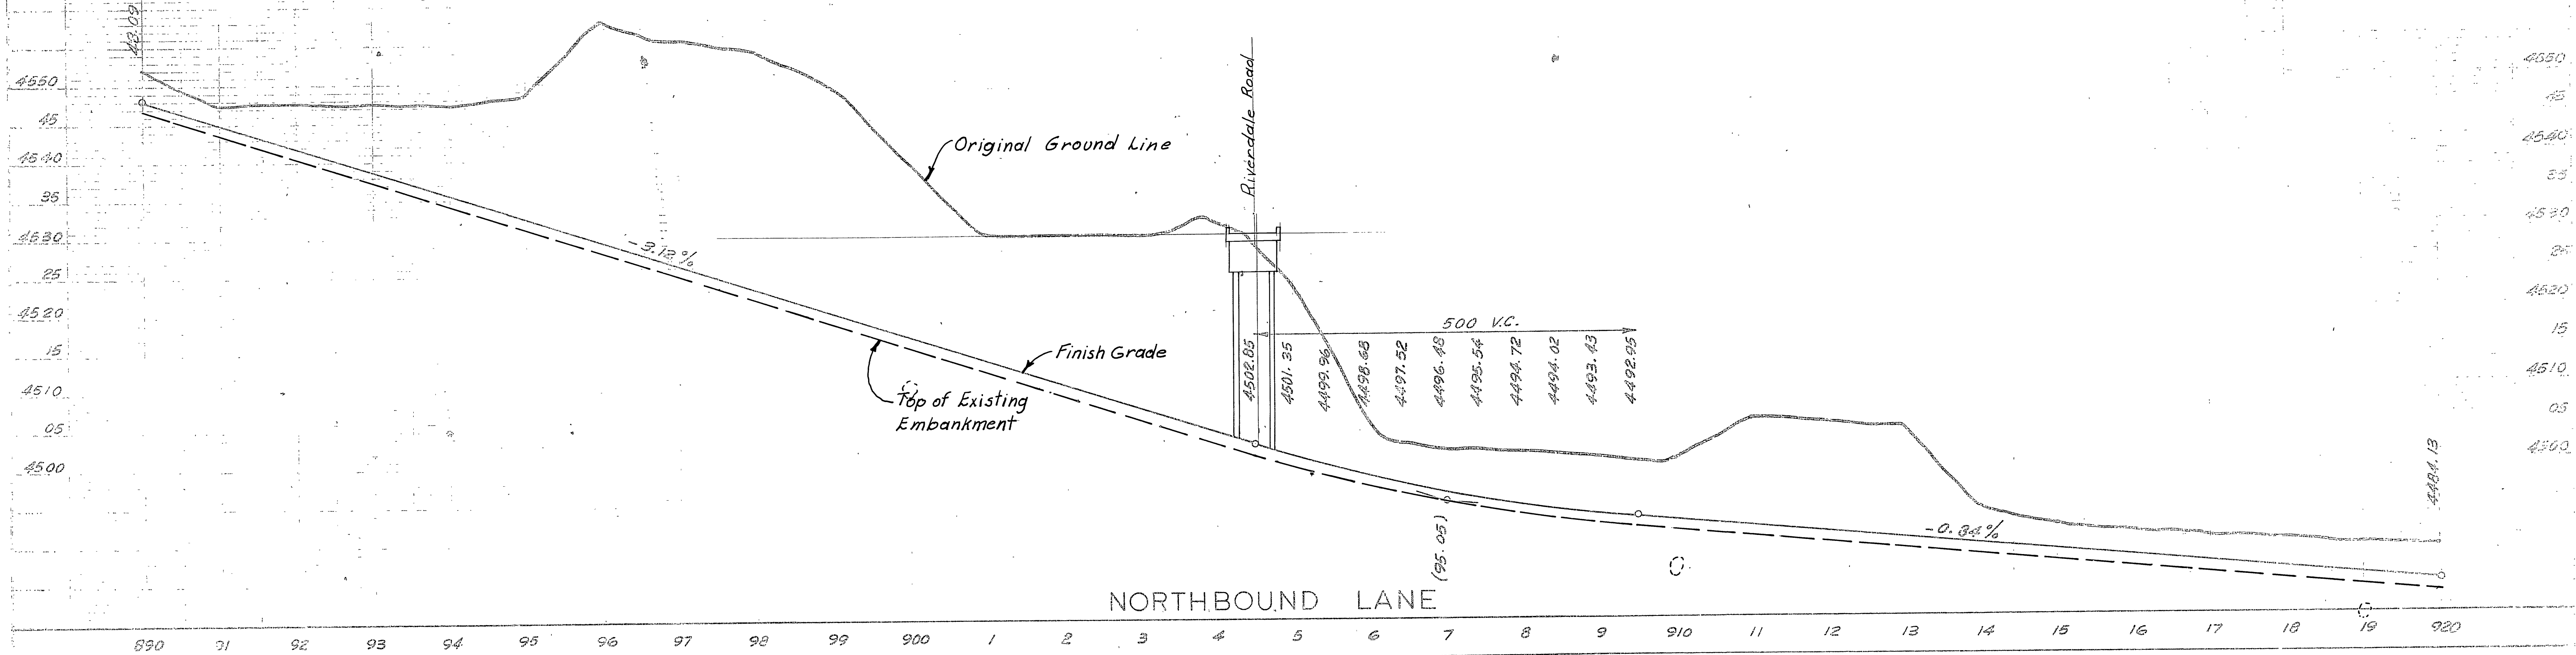


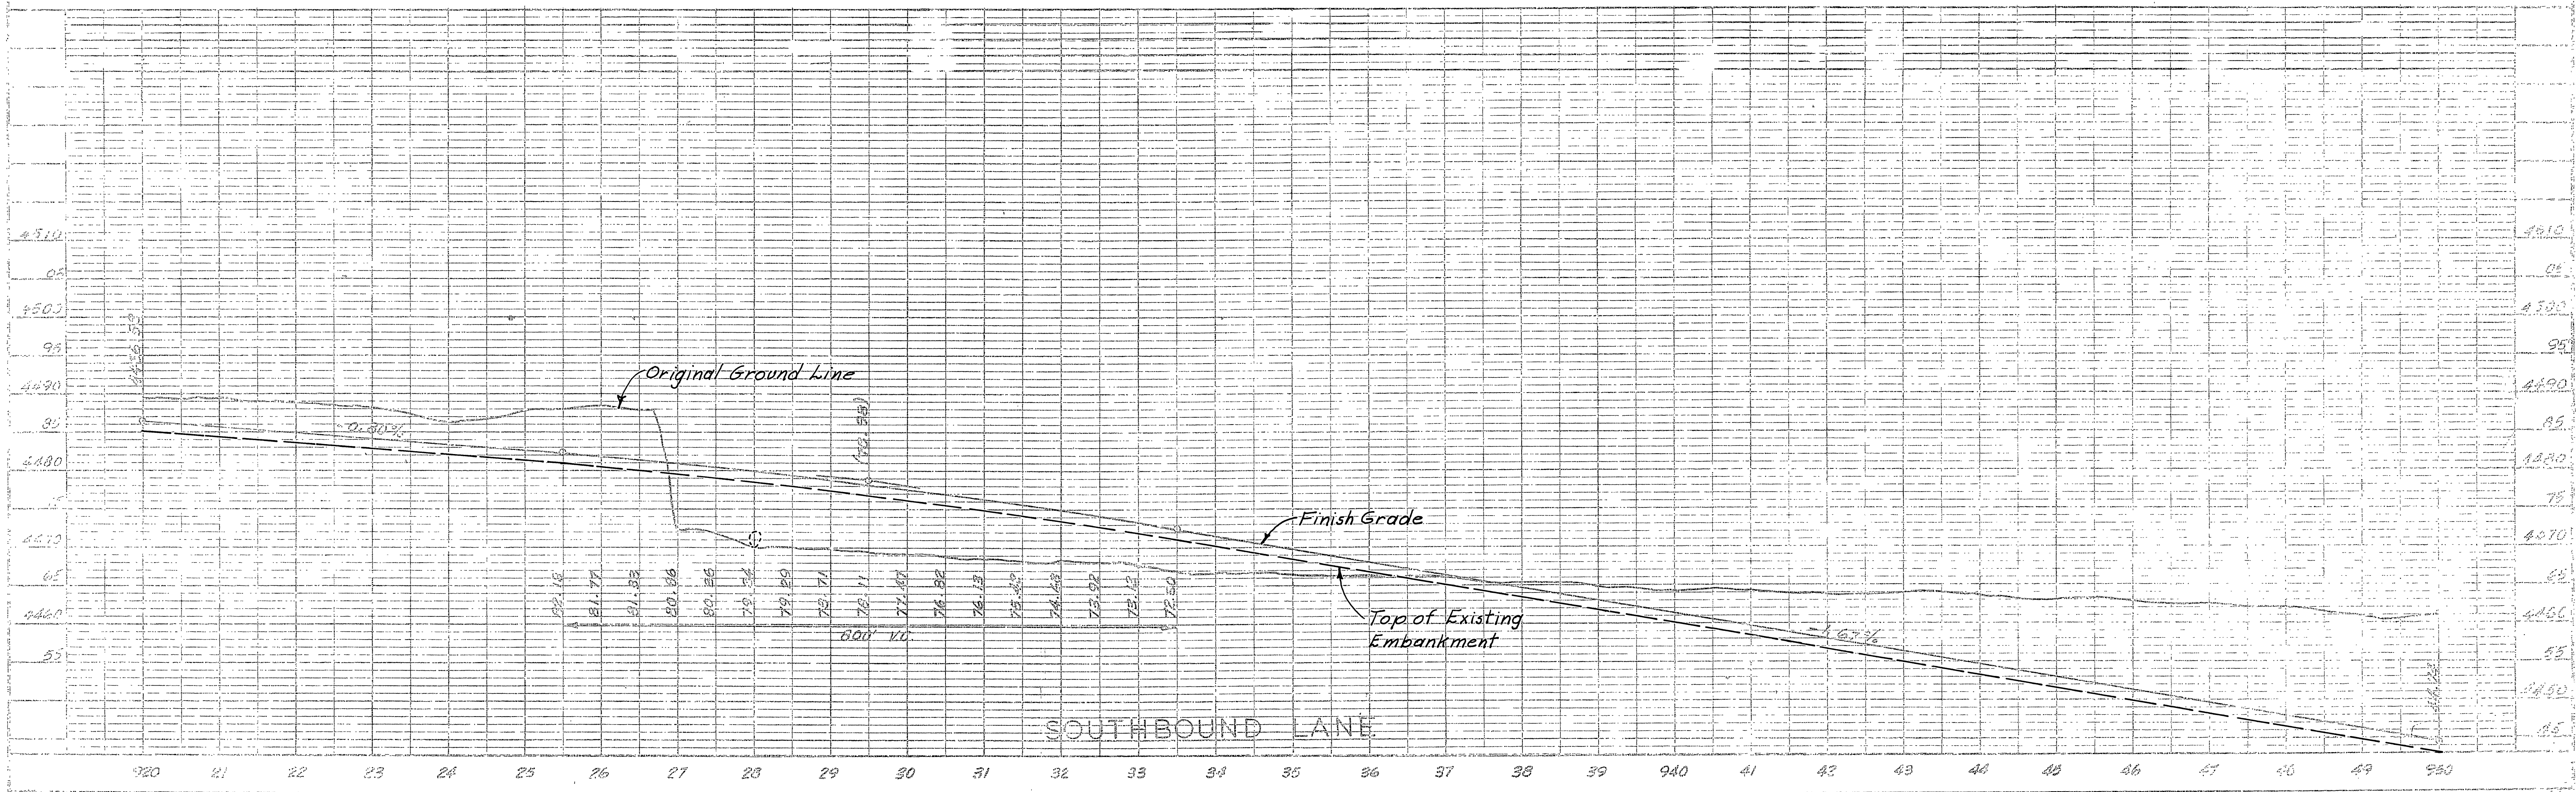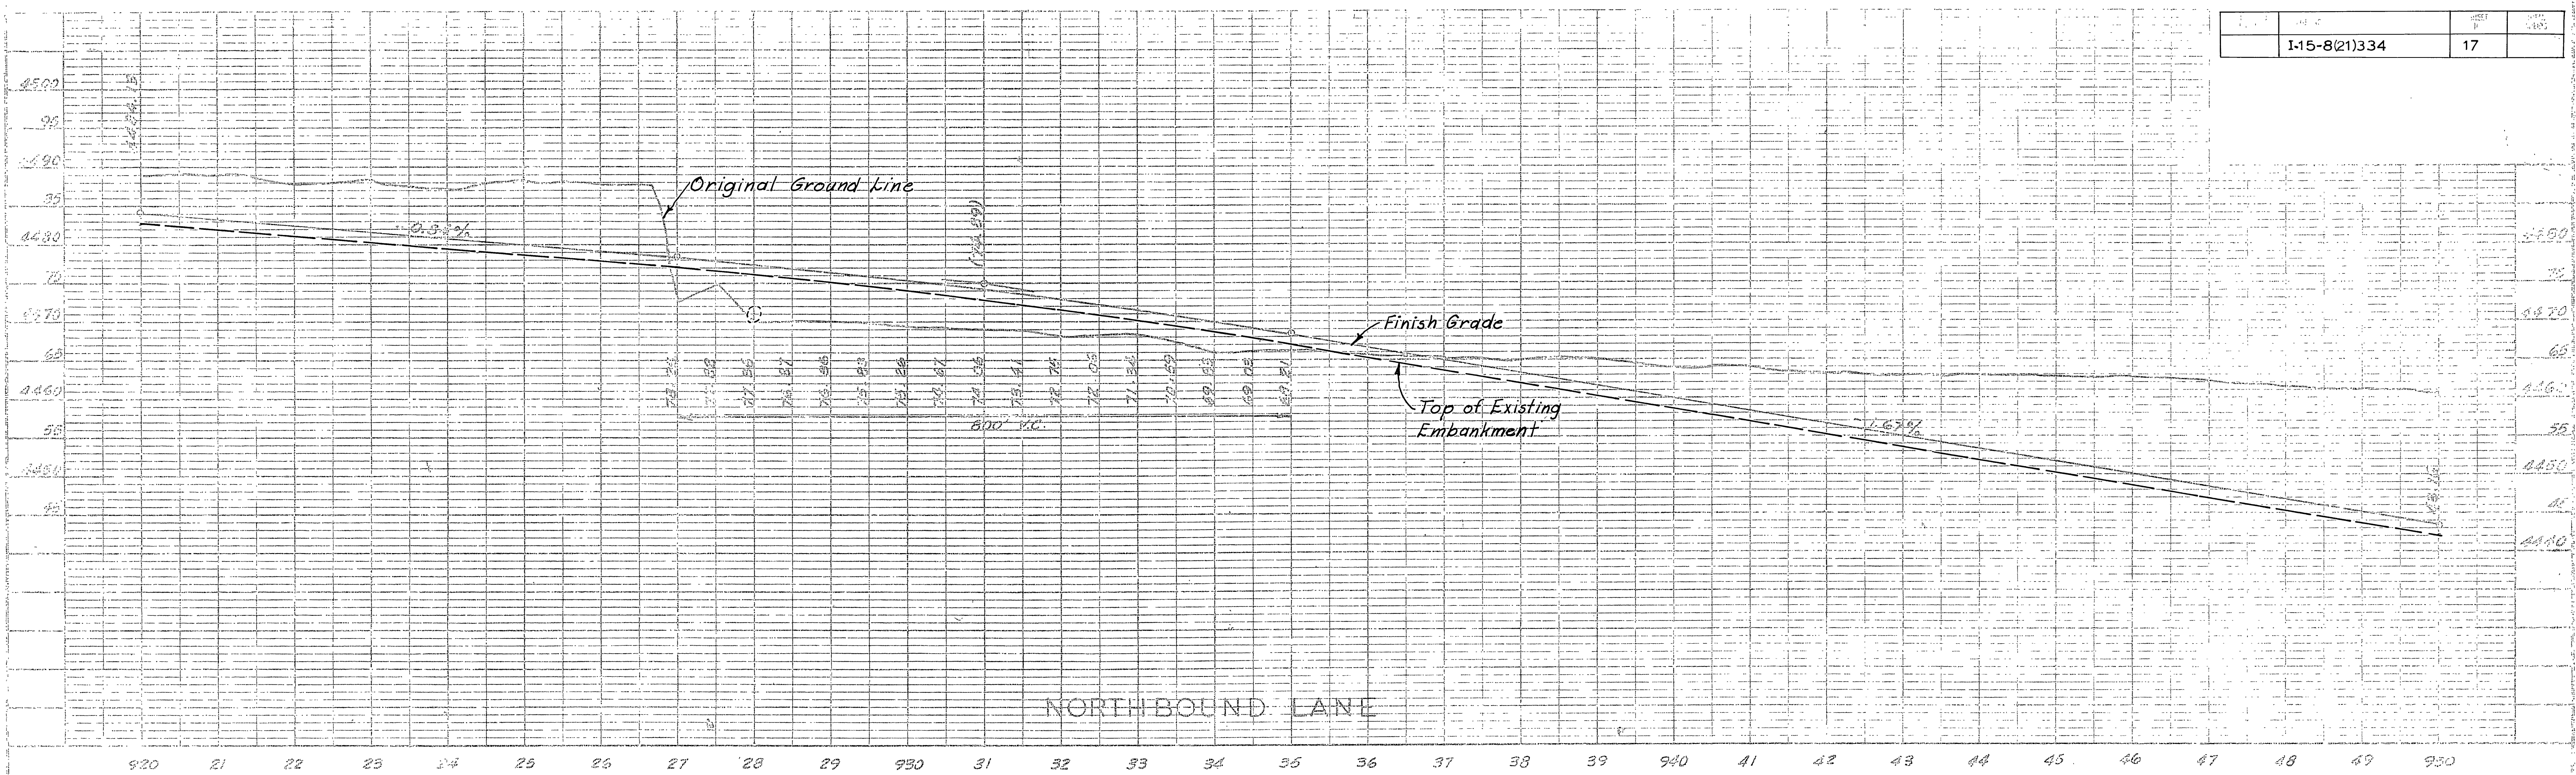


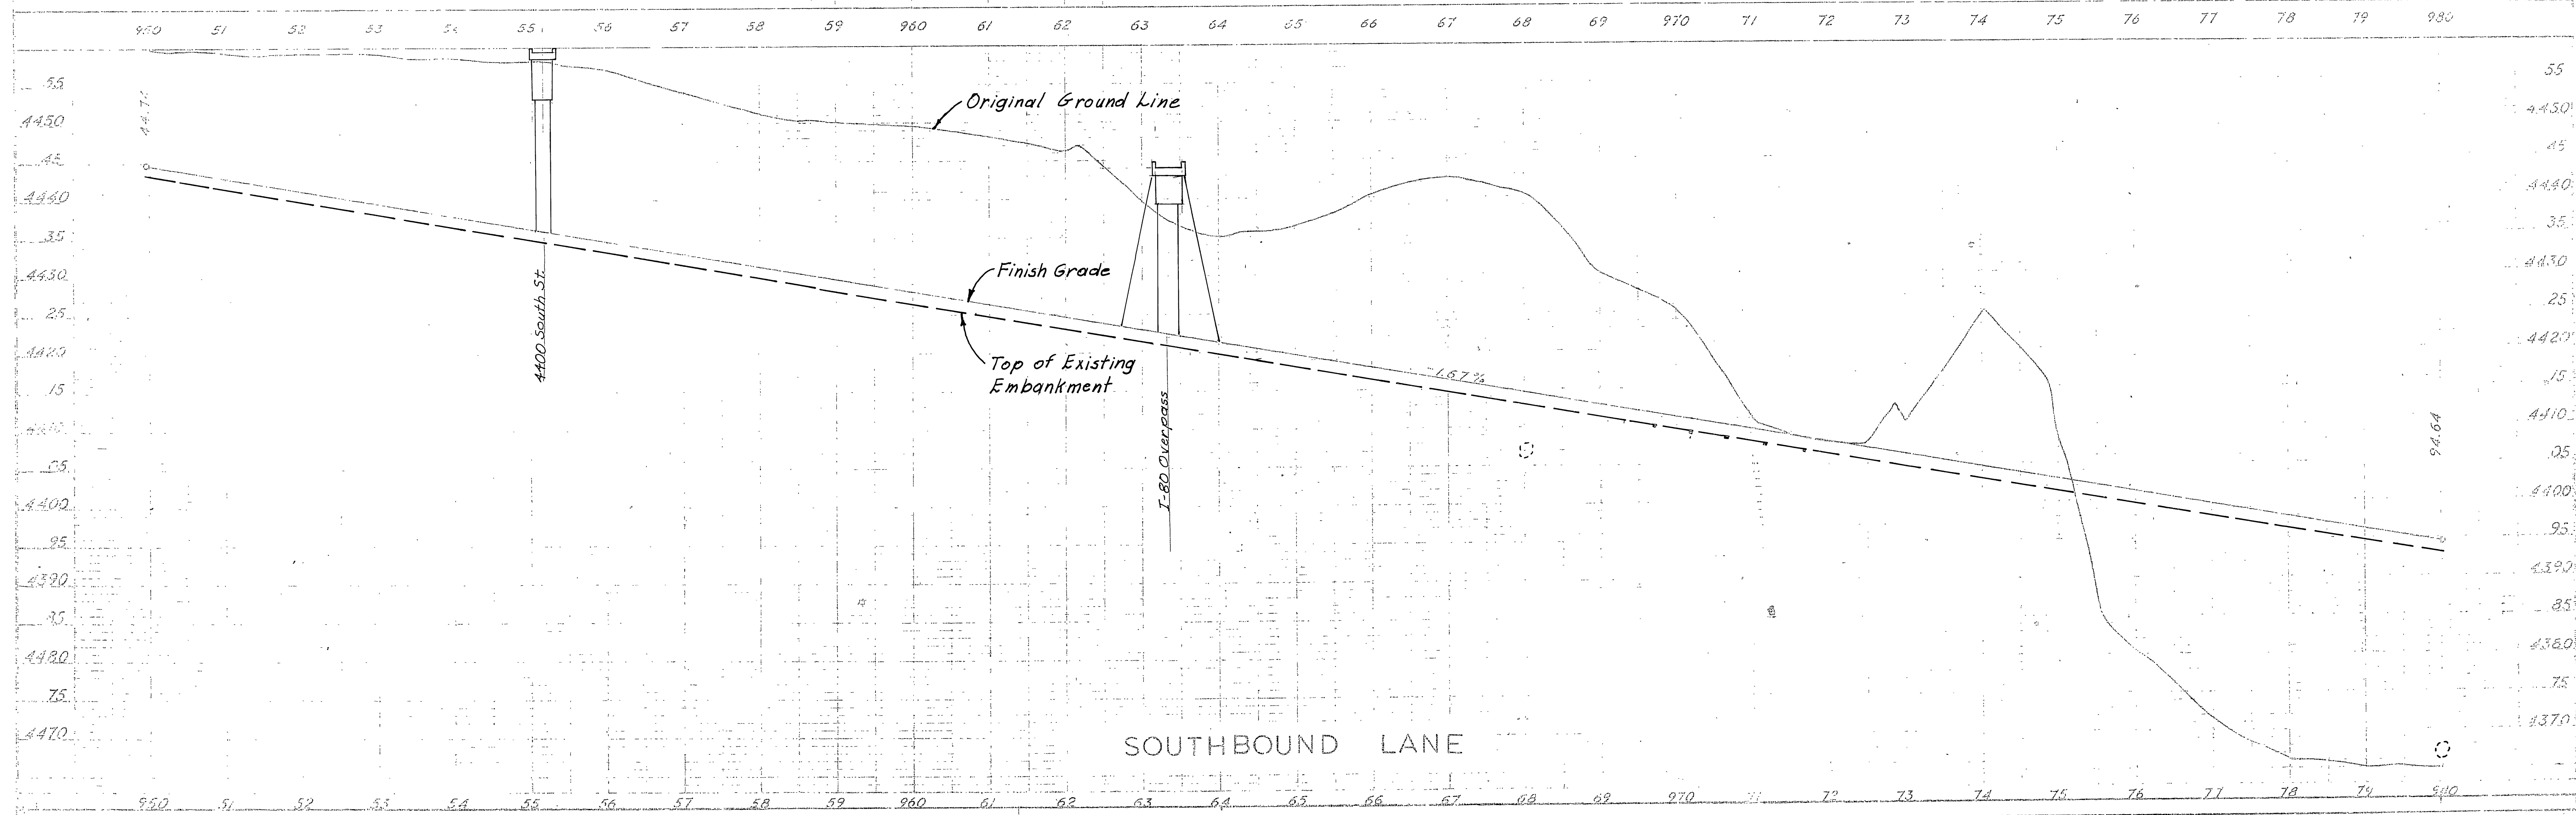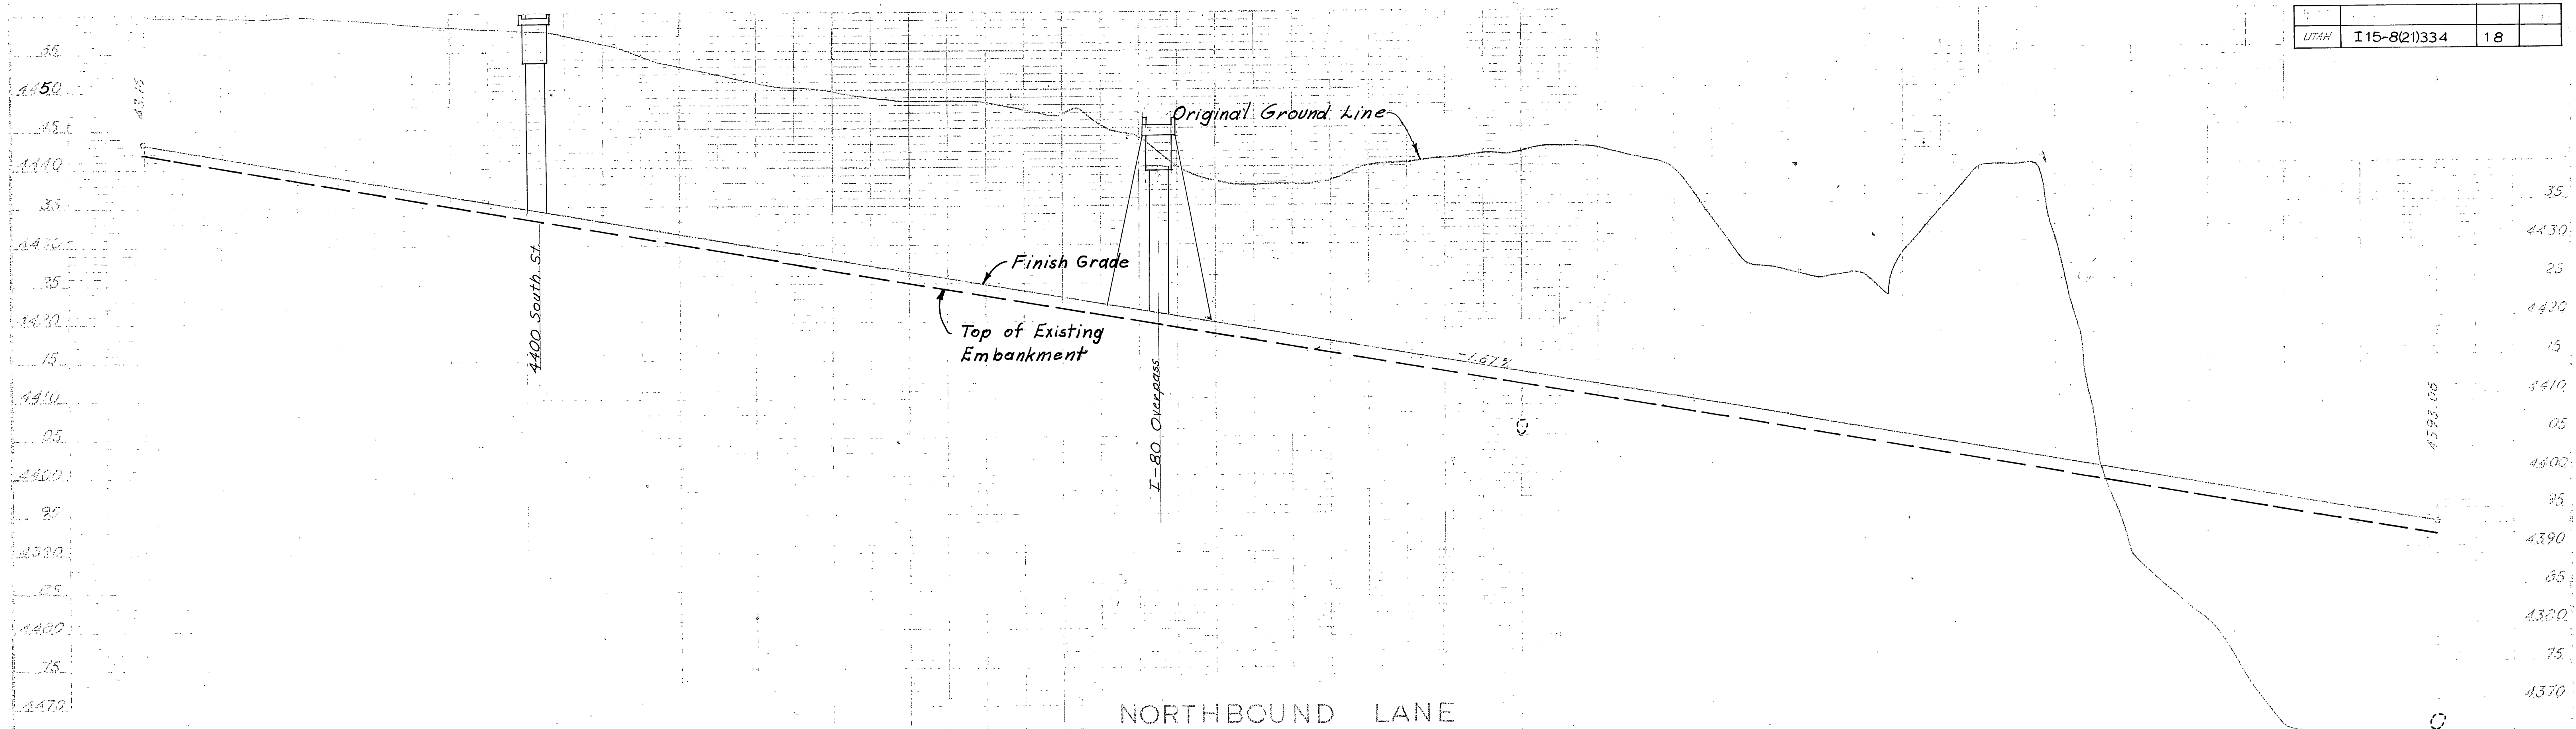

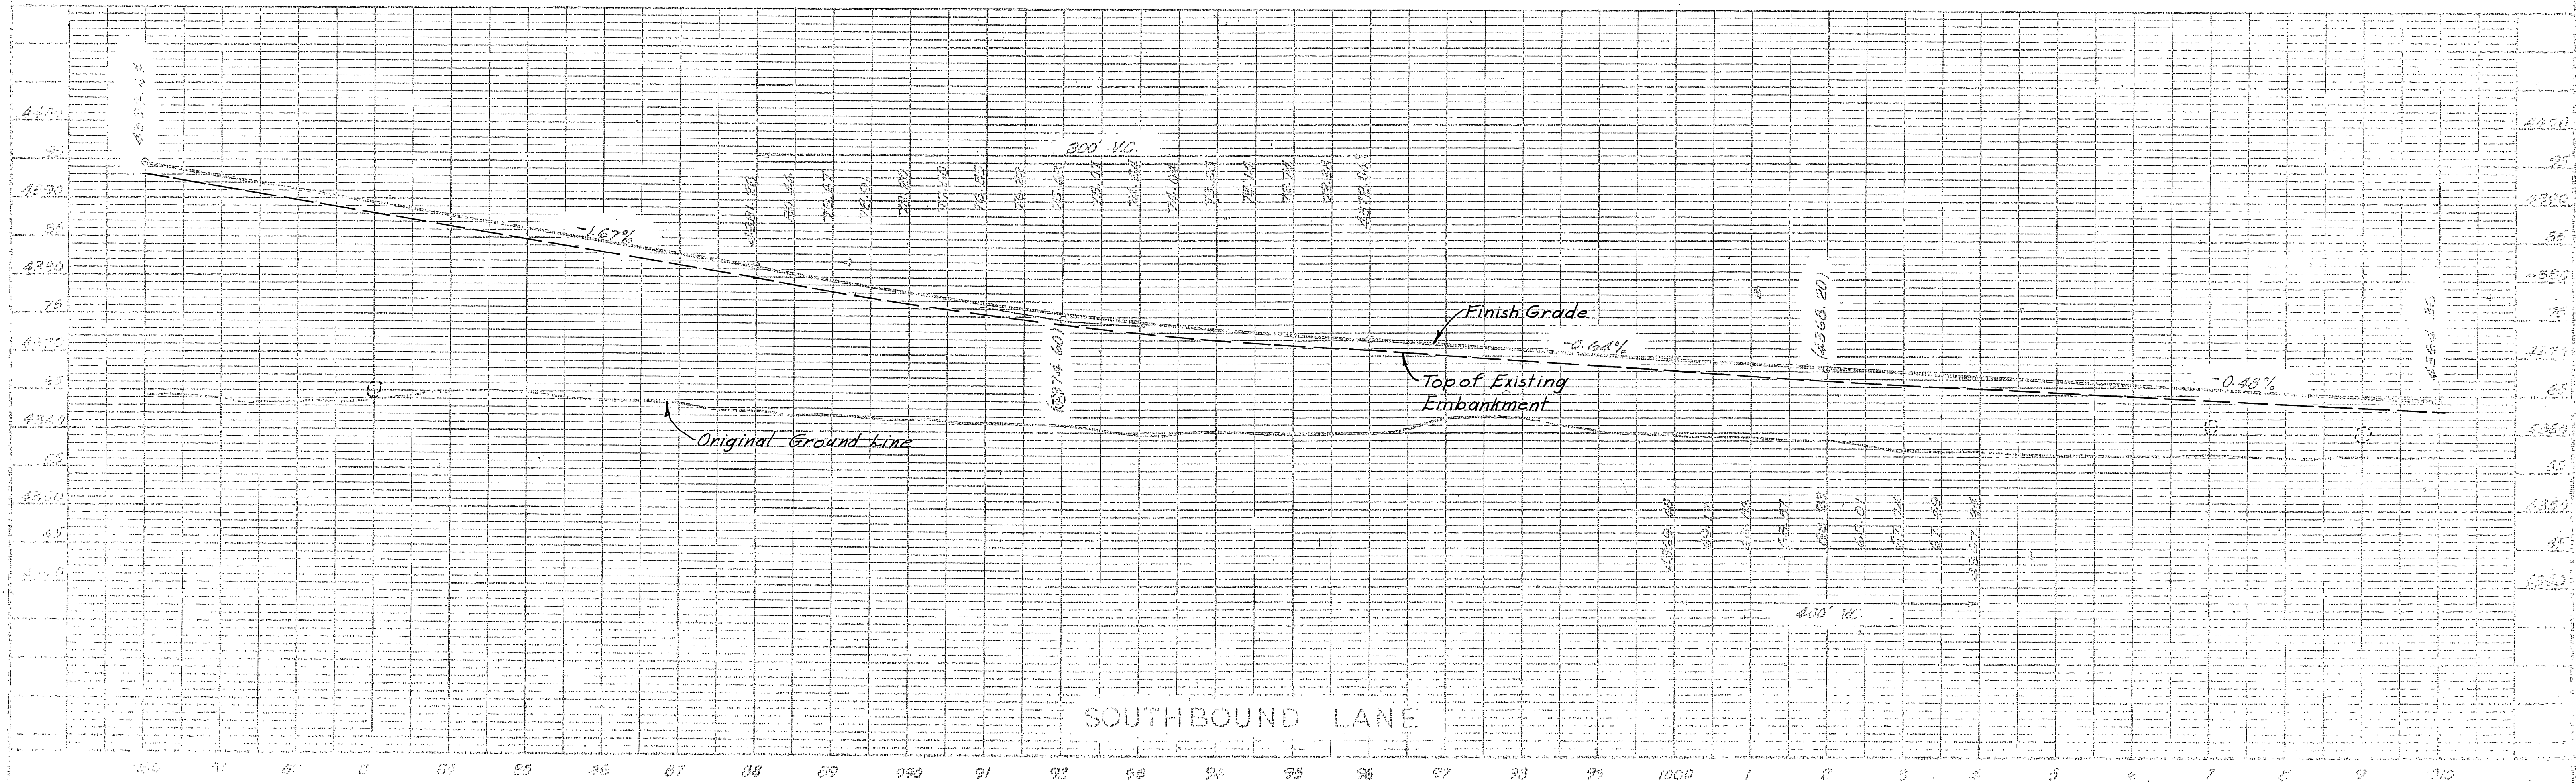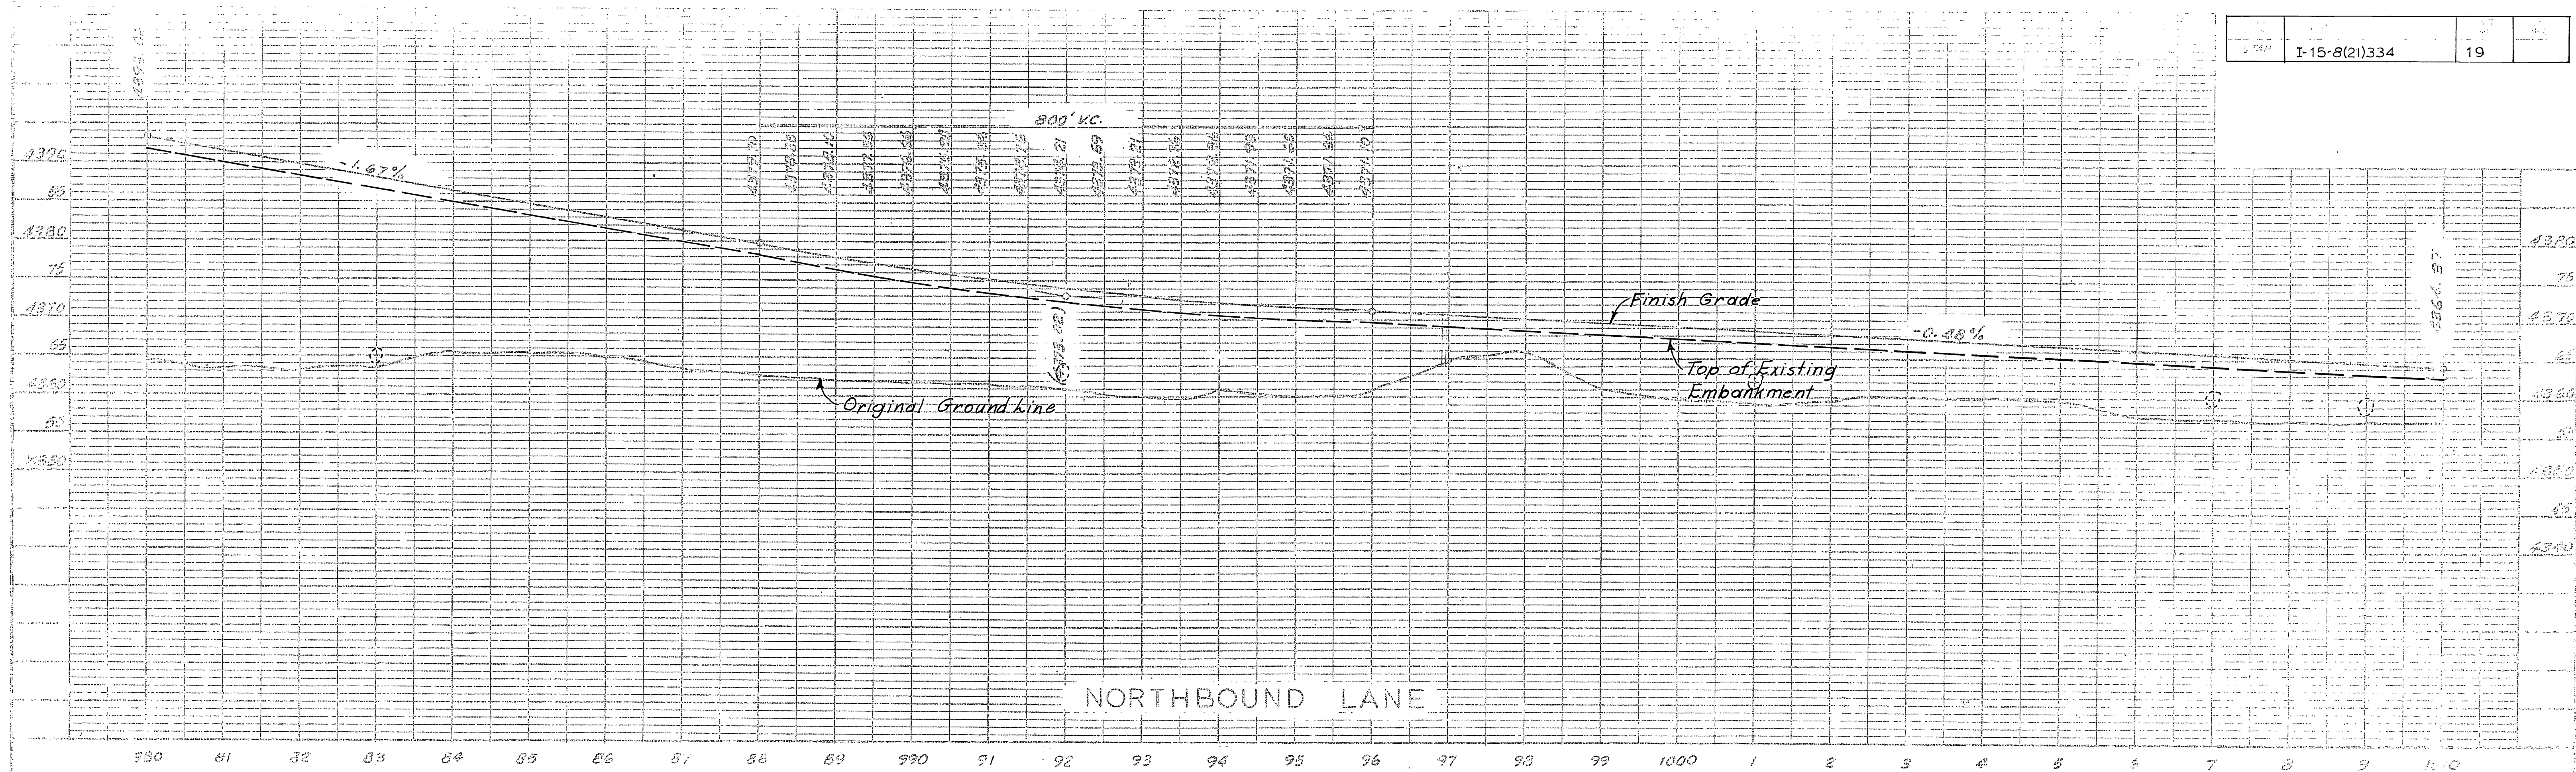

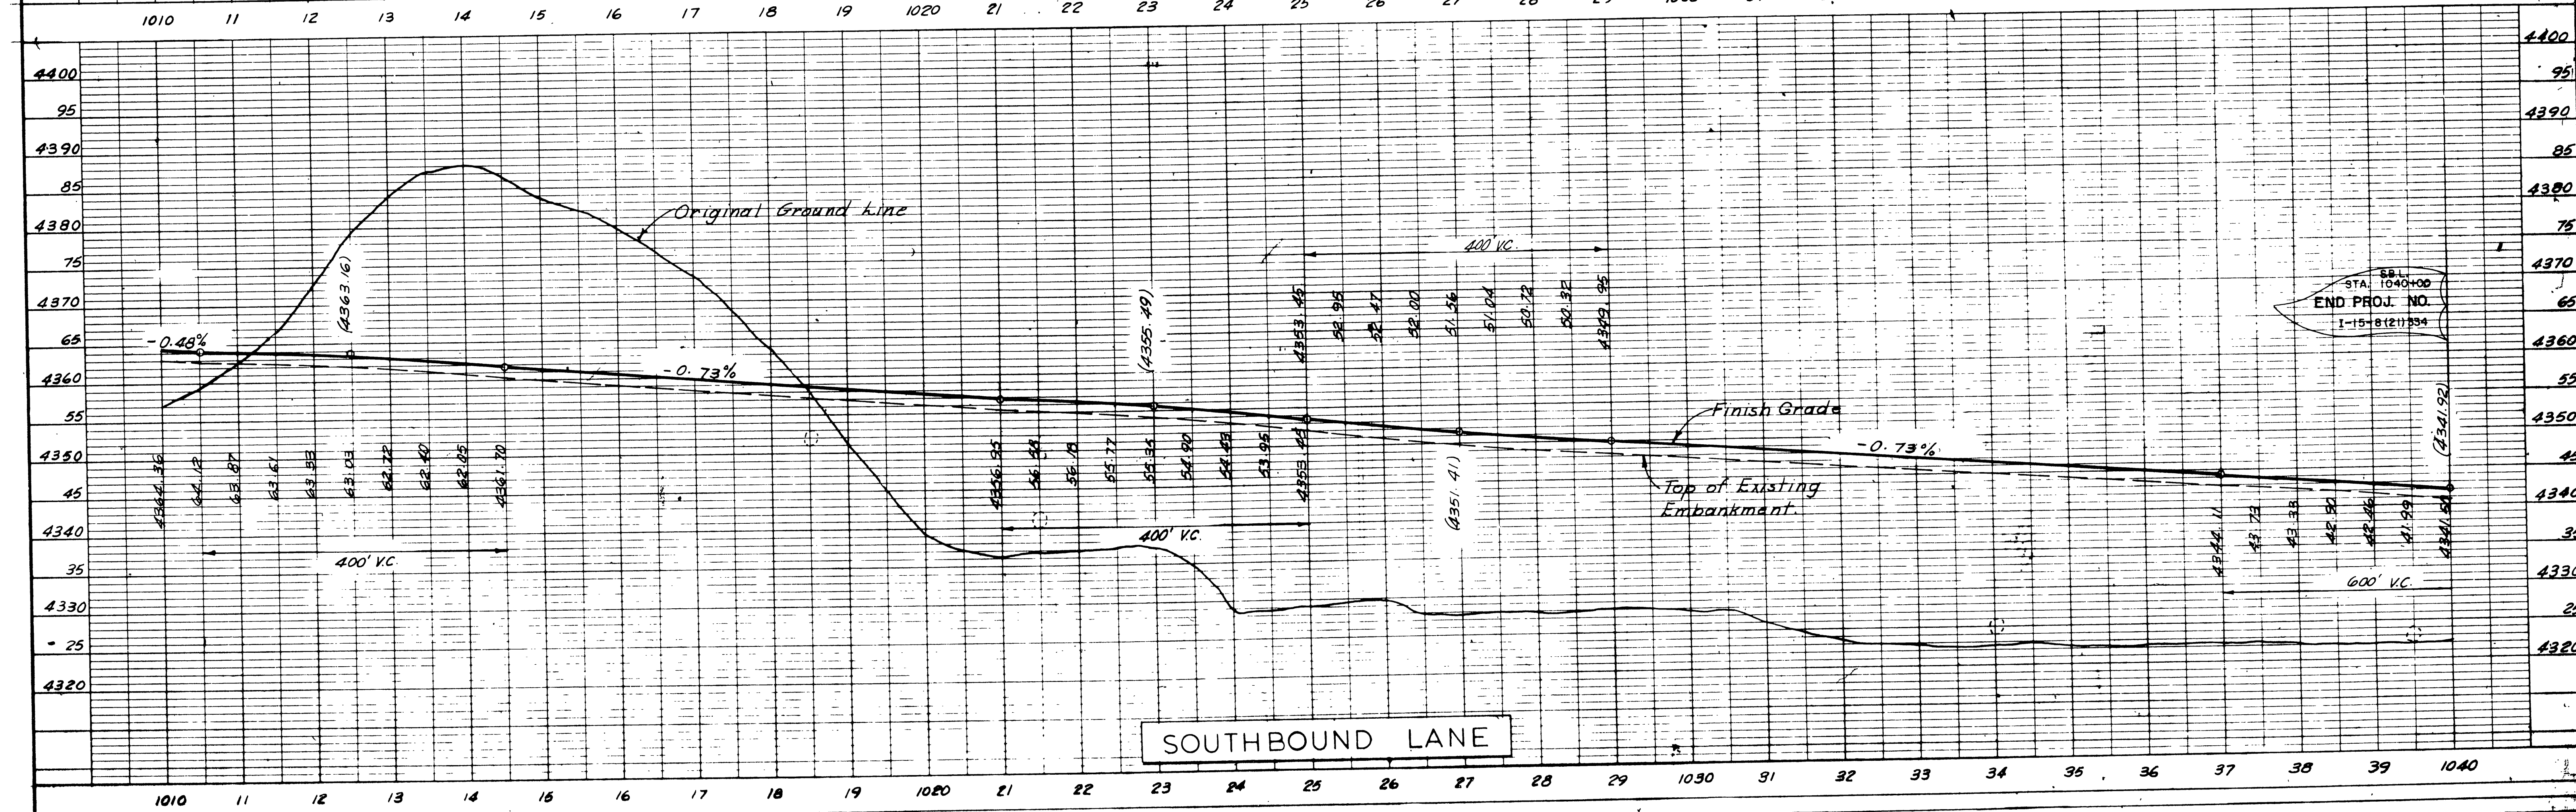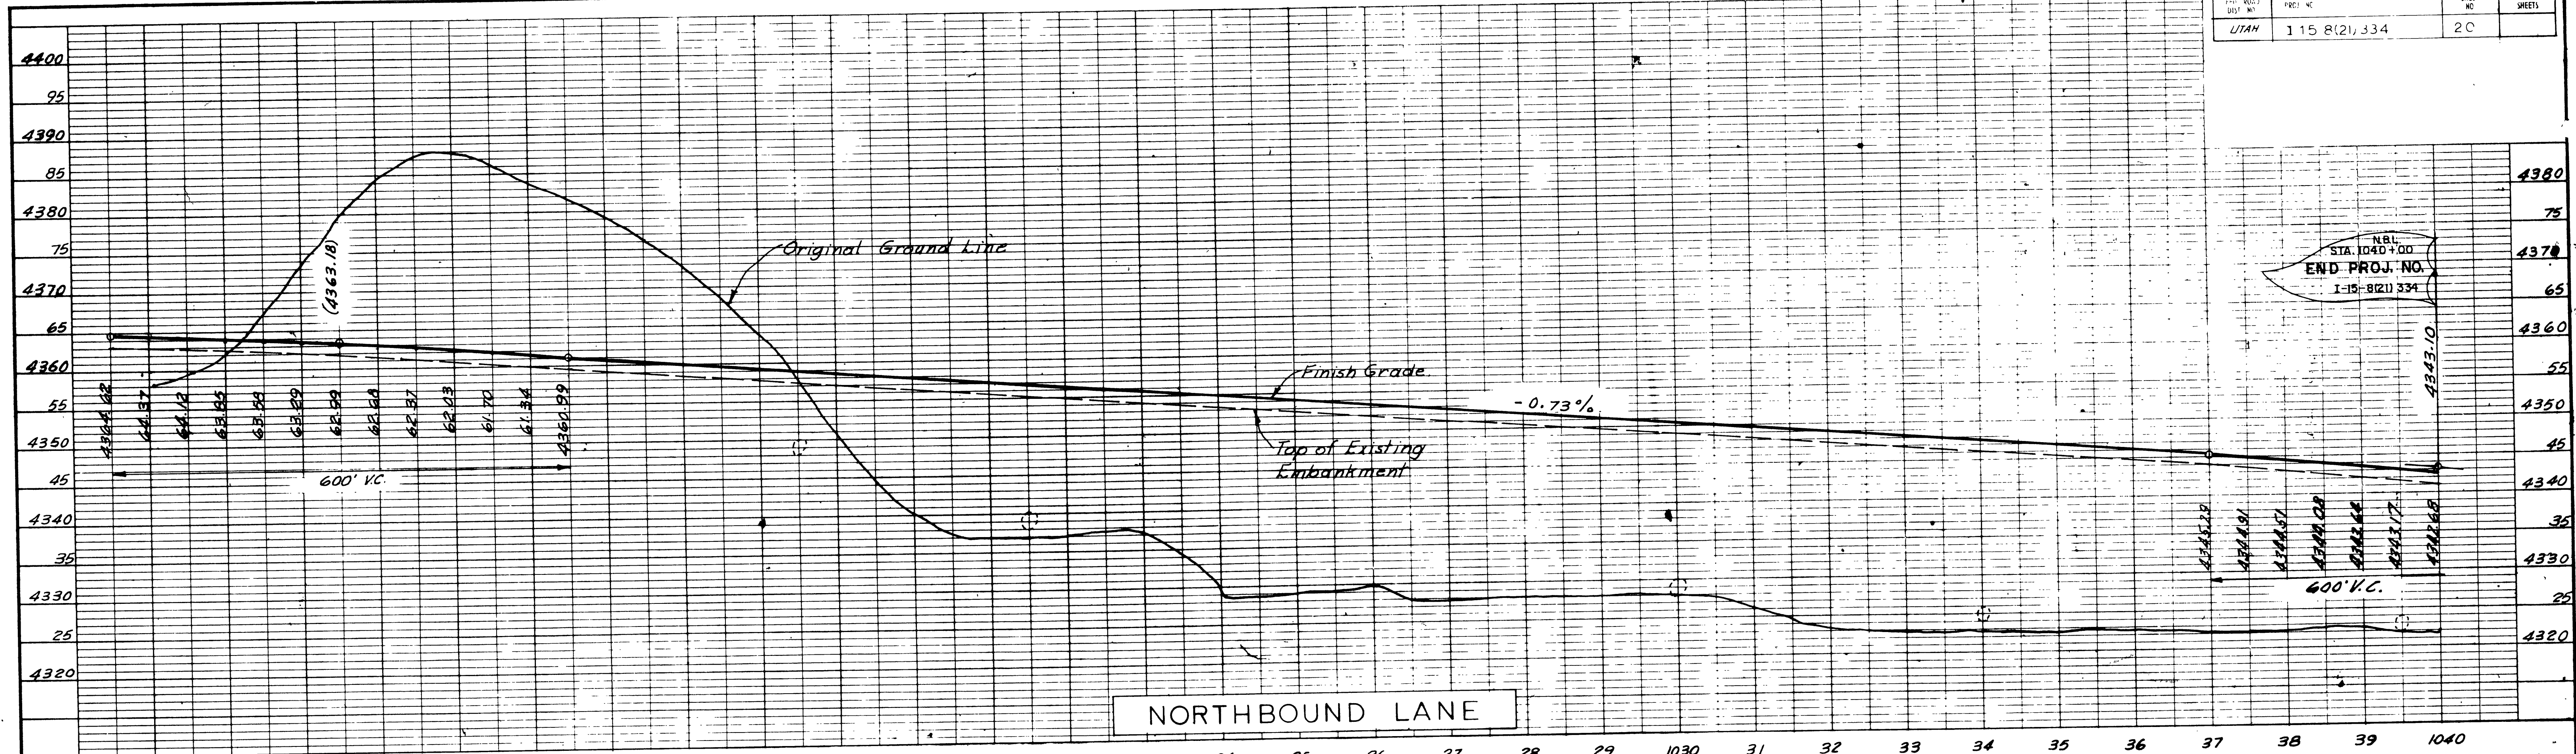

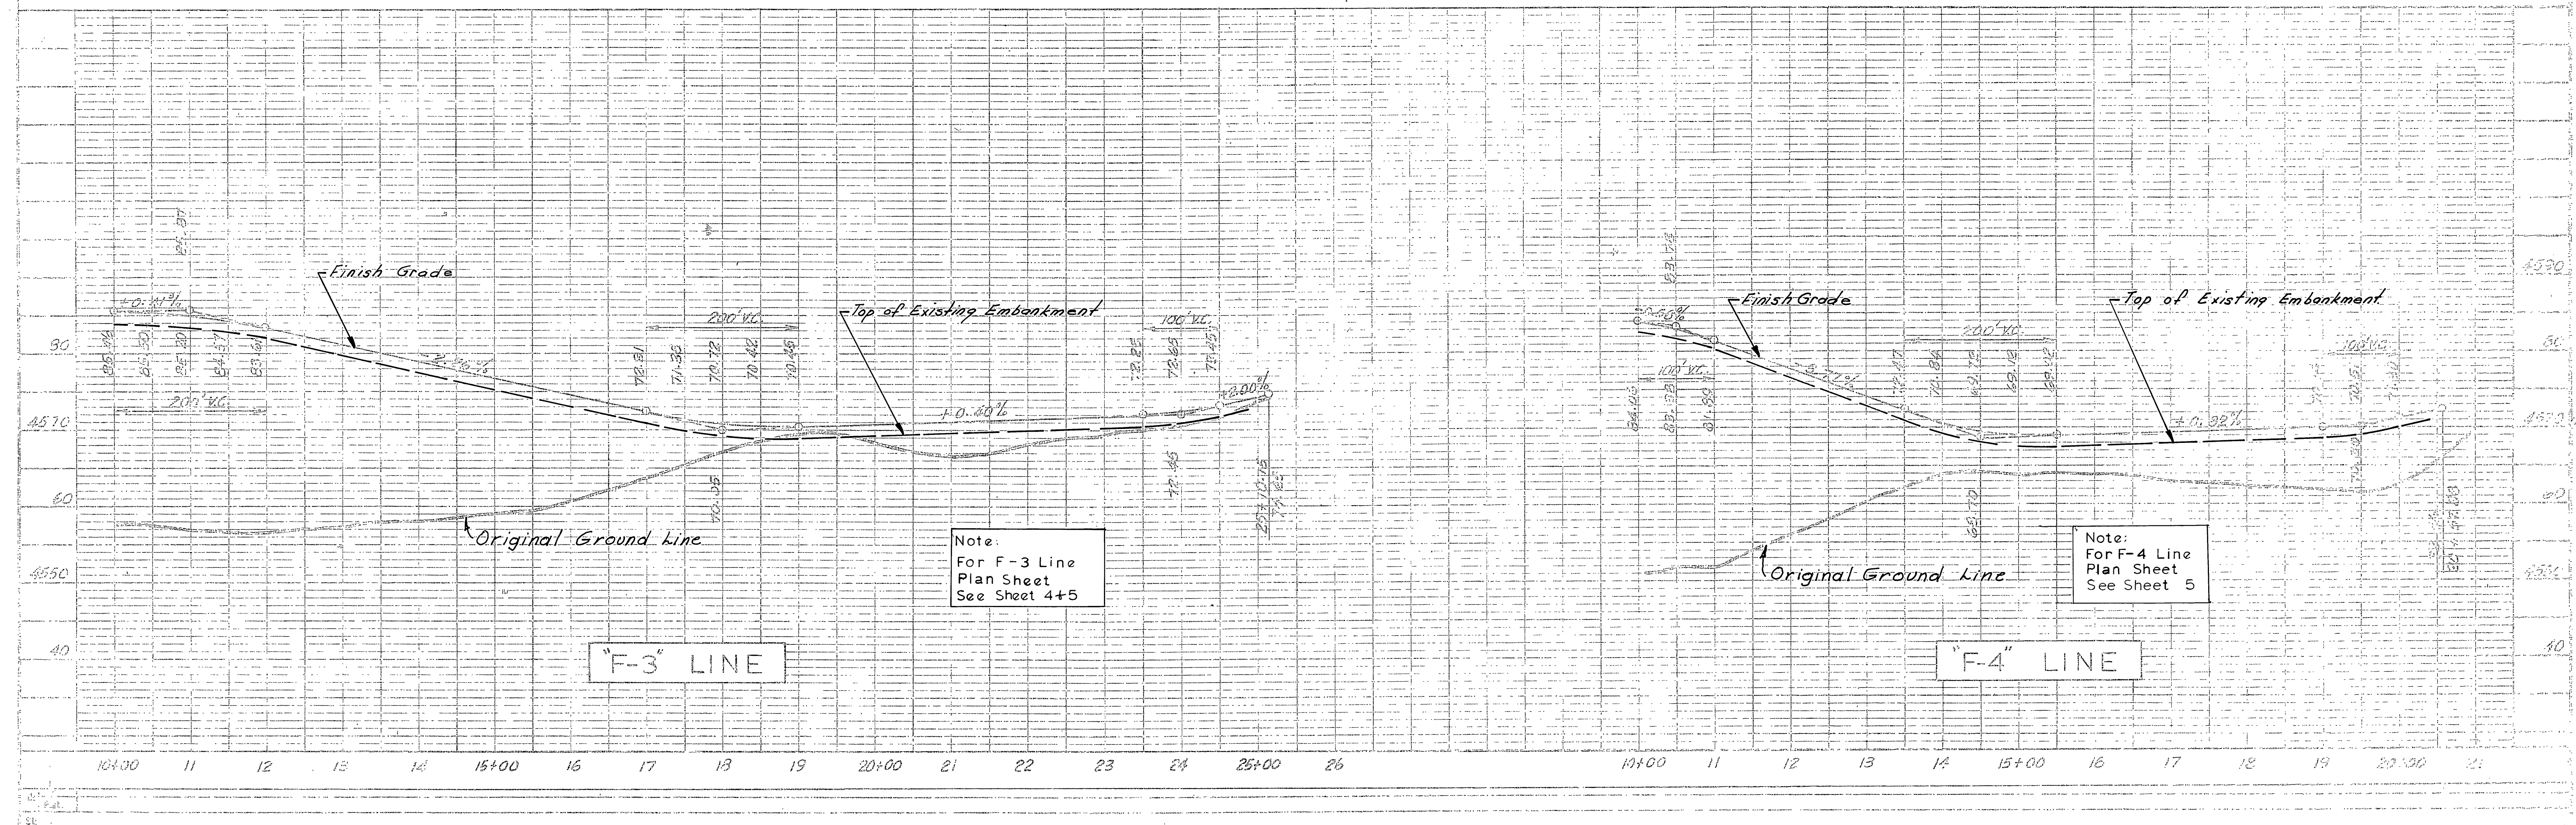
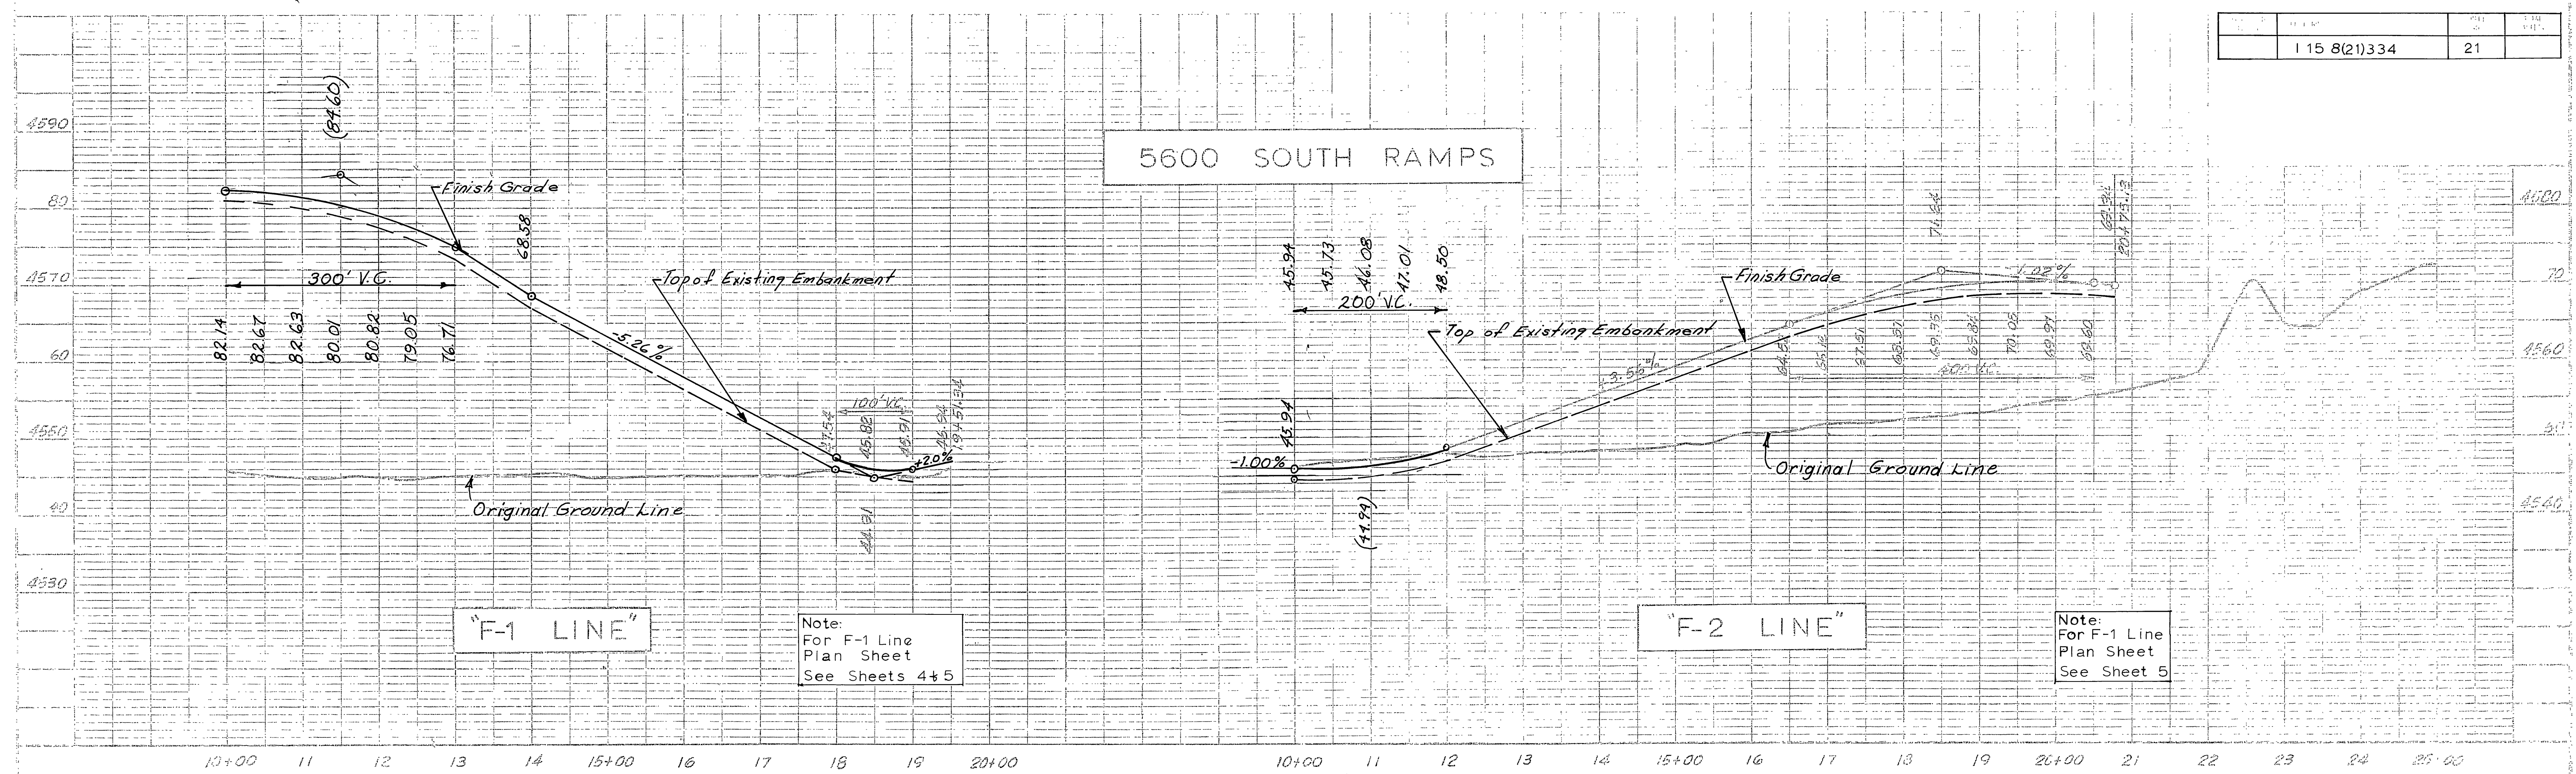


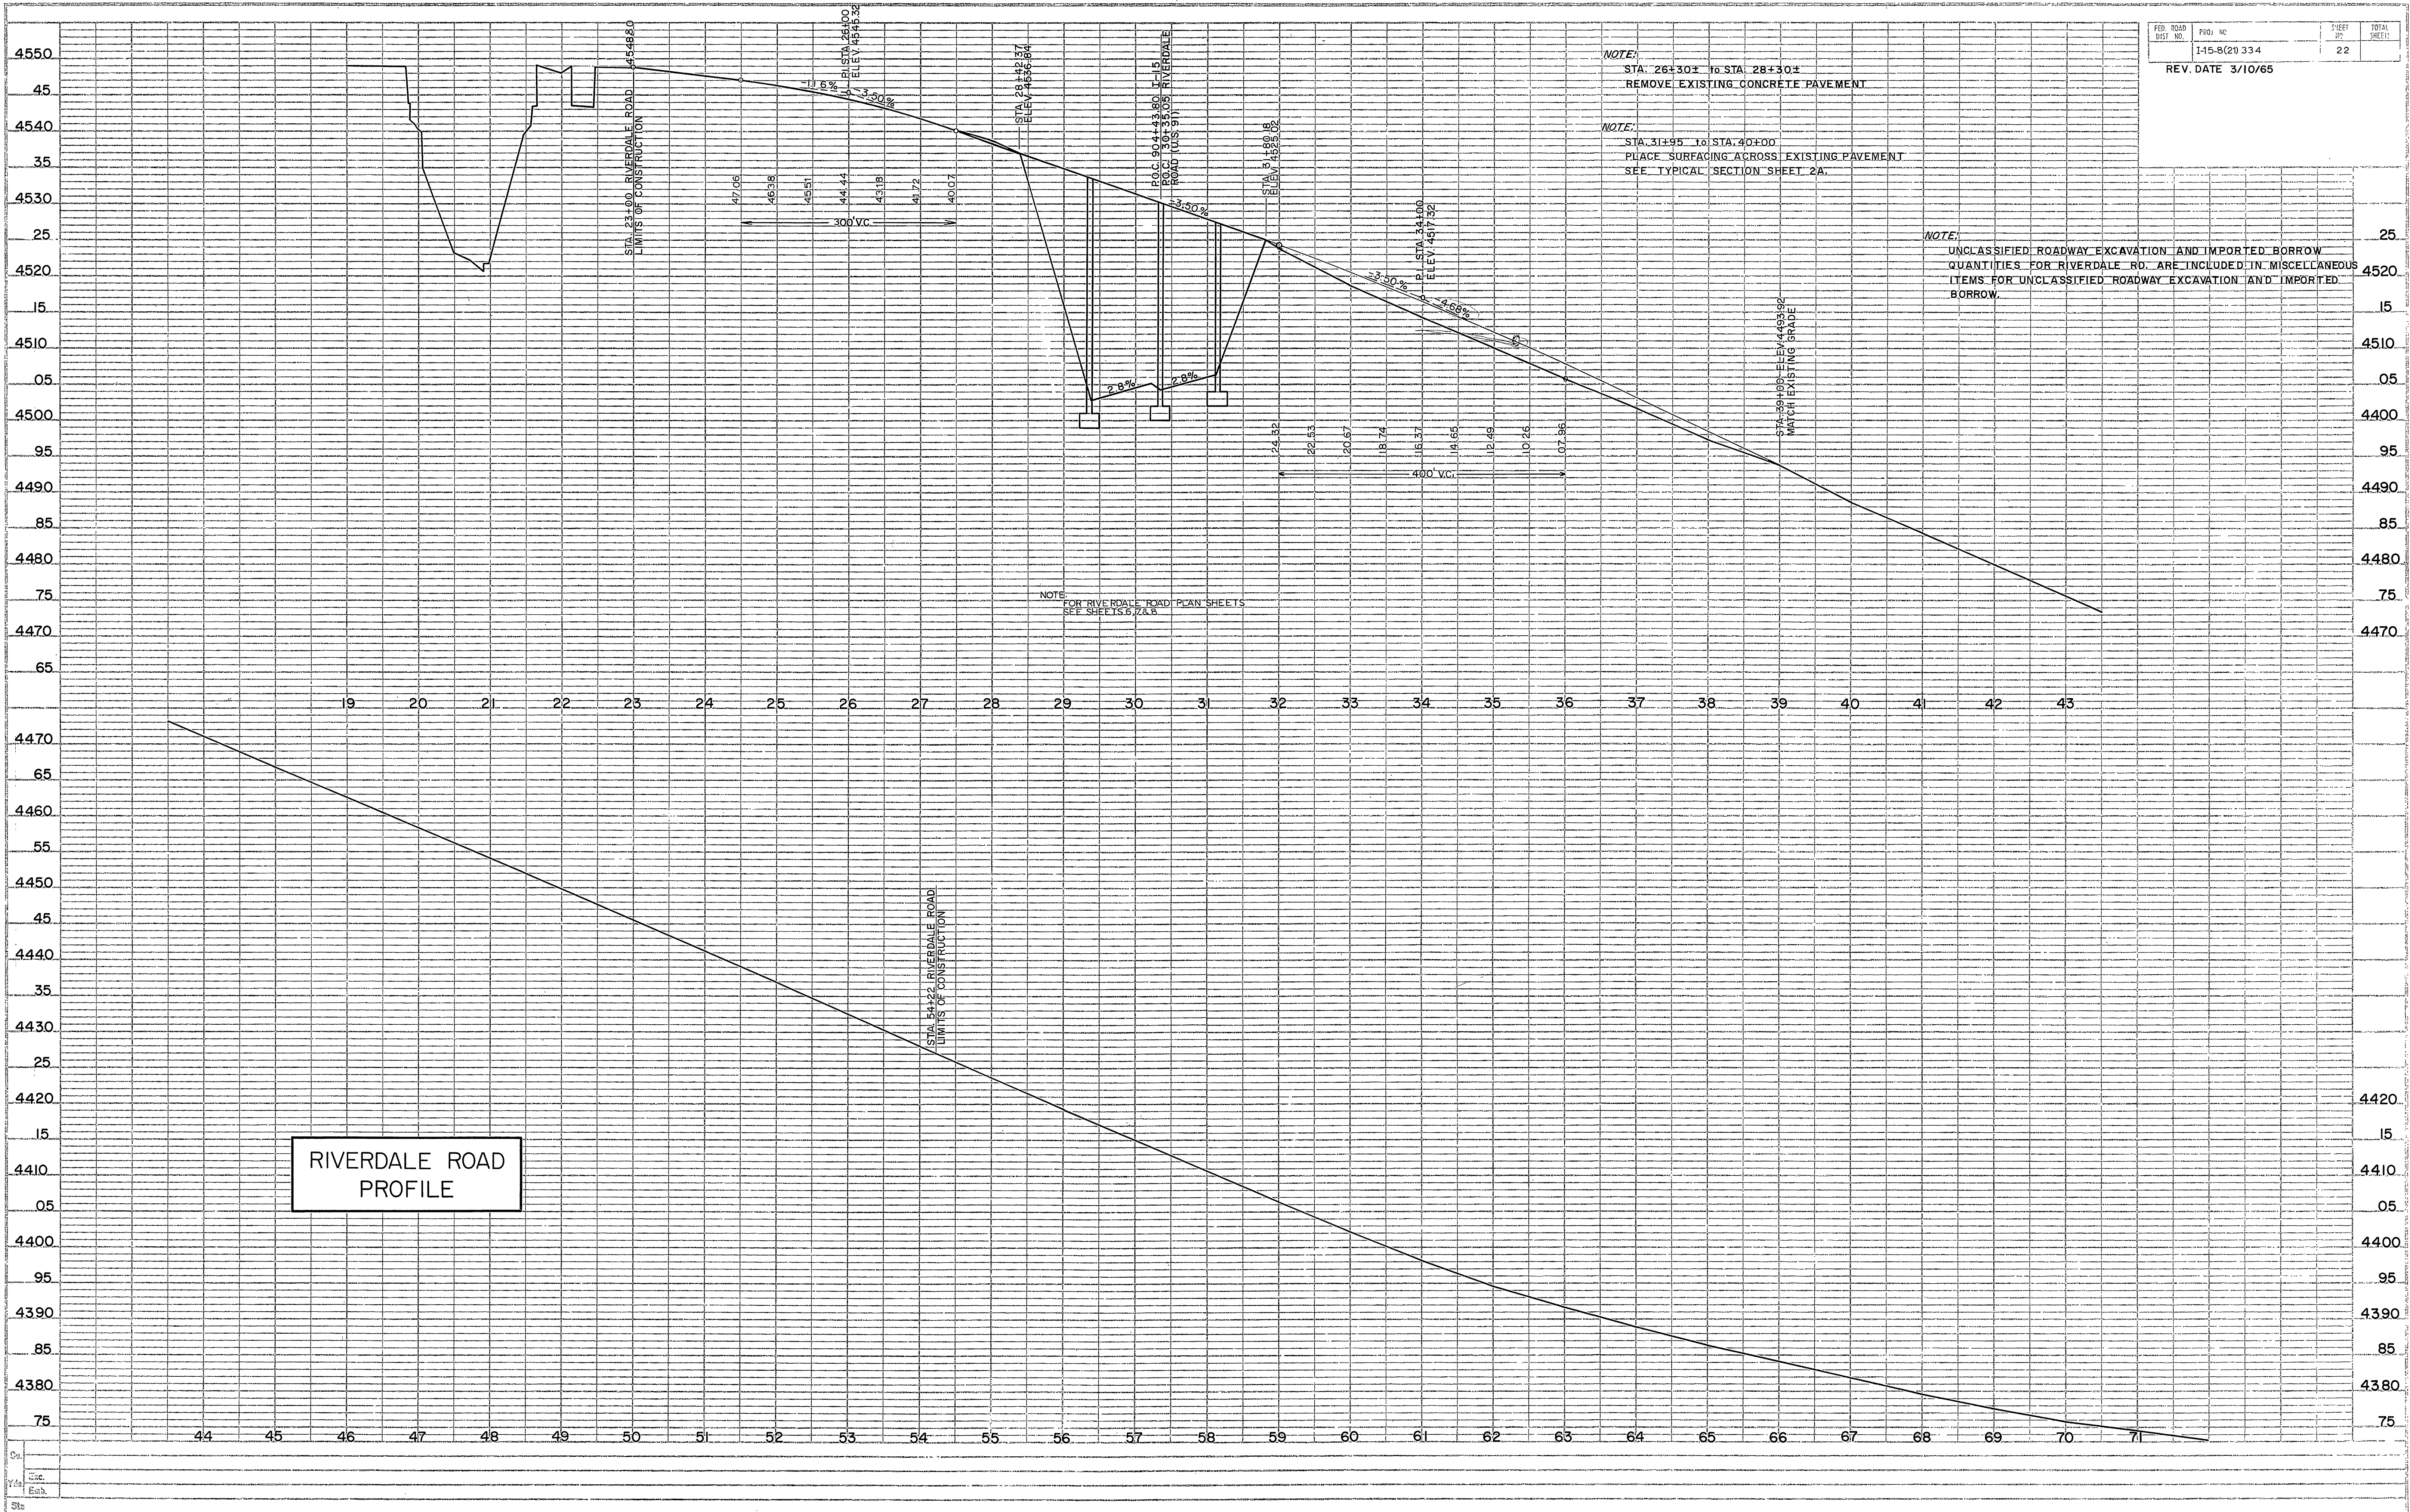


FED. ROAD DIST. NO.	PROJ. NO.	SHEET NO.	TOTAL SHEETS
145-8(21) 334	145-8(21) 334	22	
REV. DATE 3/10/65			

RIVERDALE ROAD
PROFILE

Co.	
Dist.	
Yr.	
Em.	
Sta.	

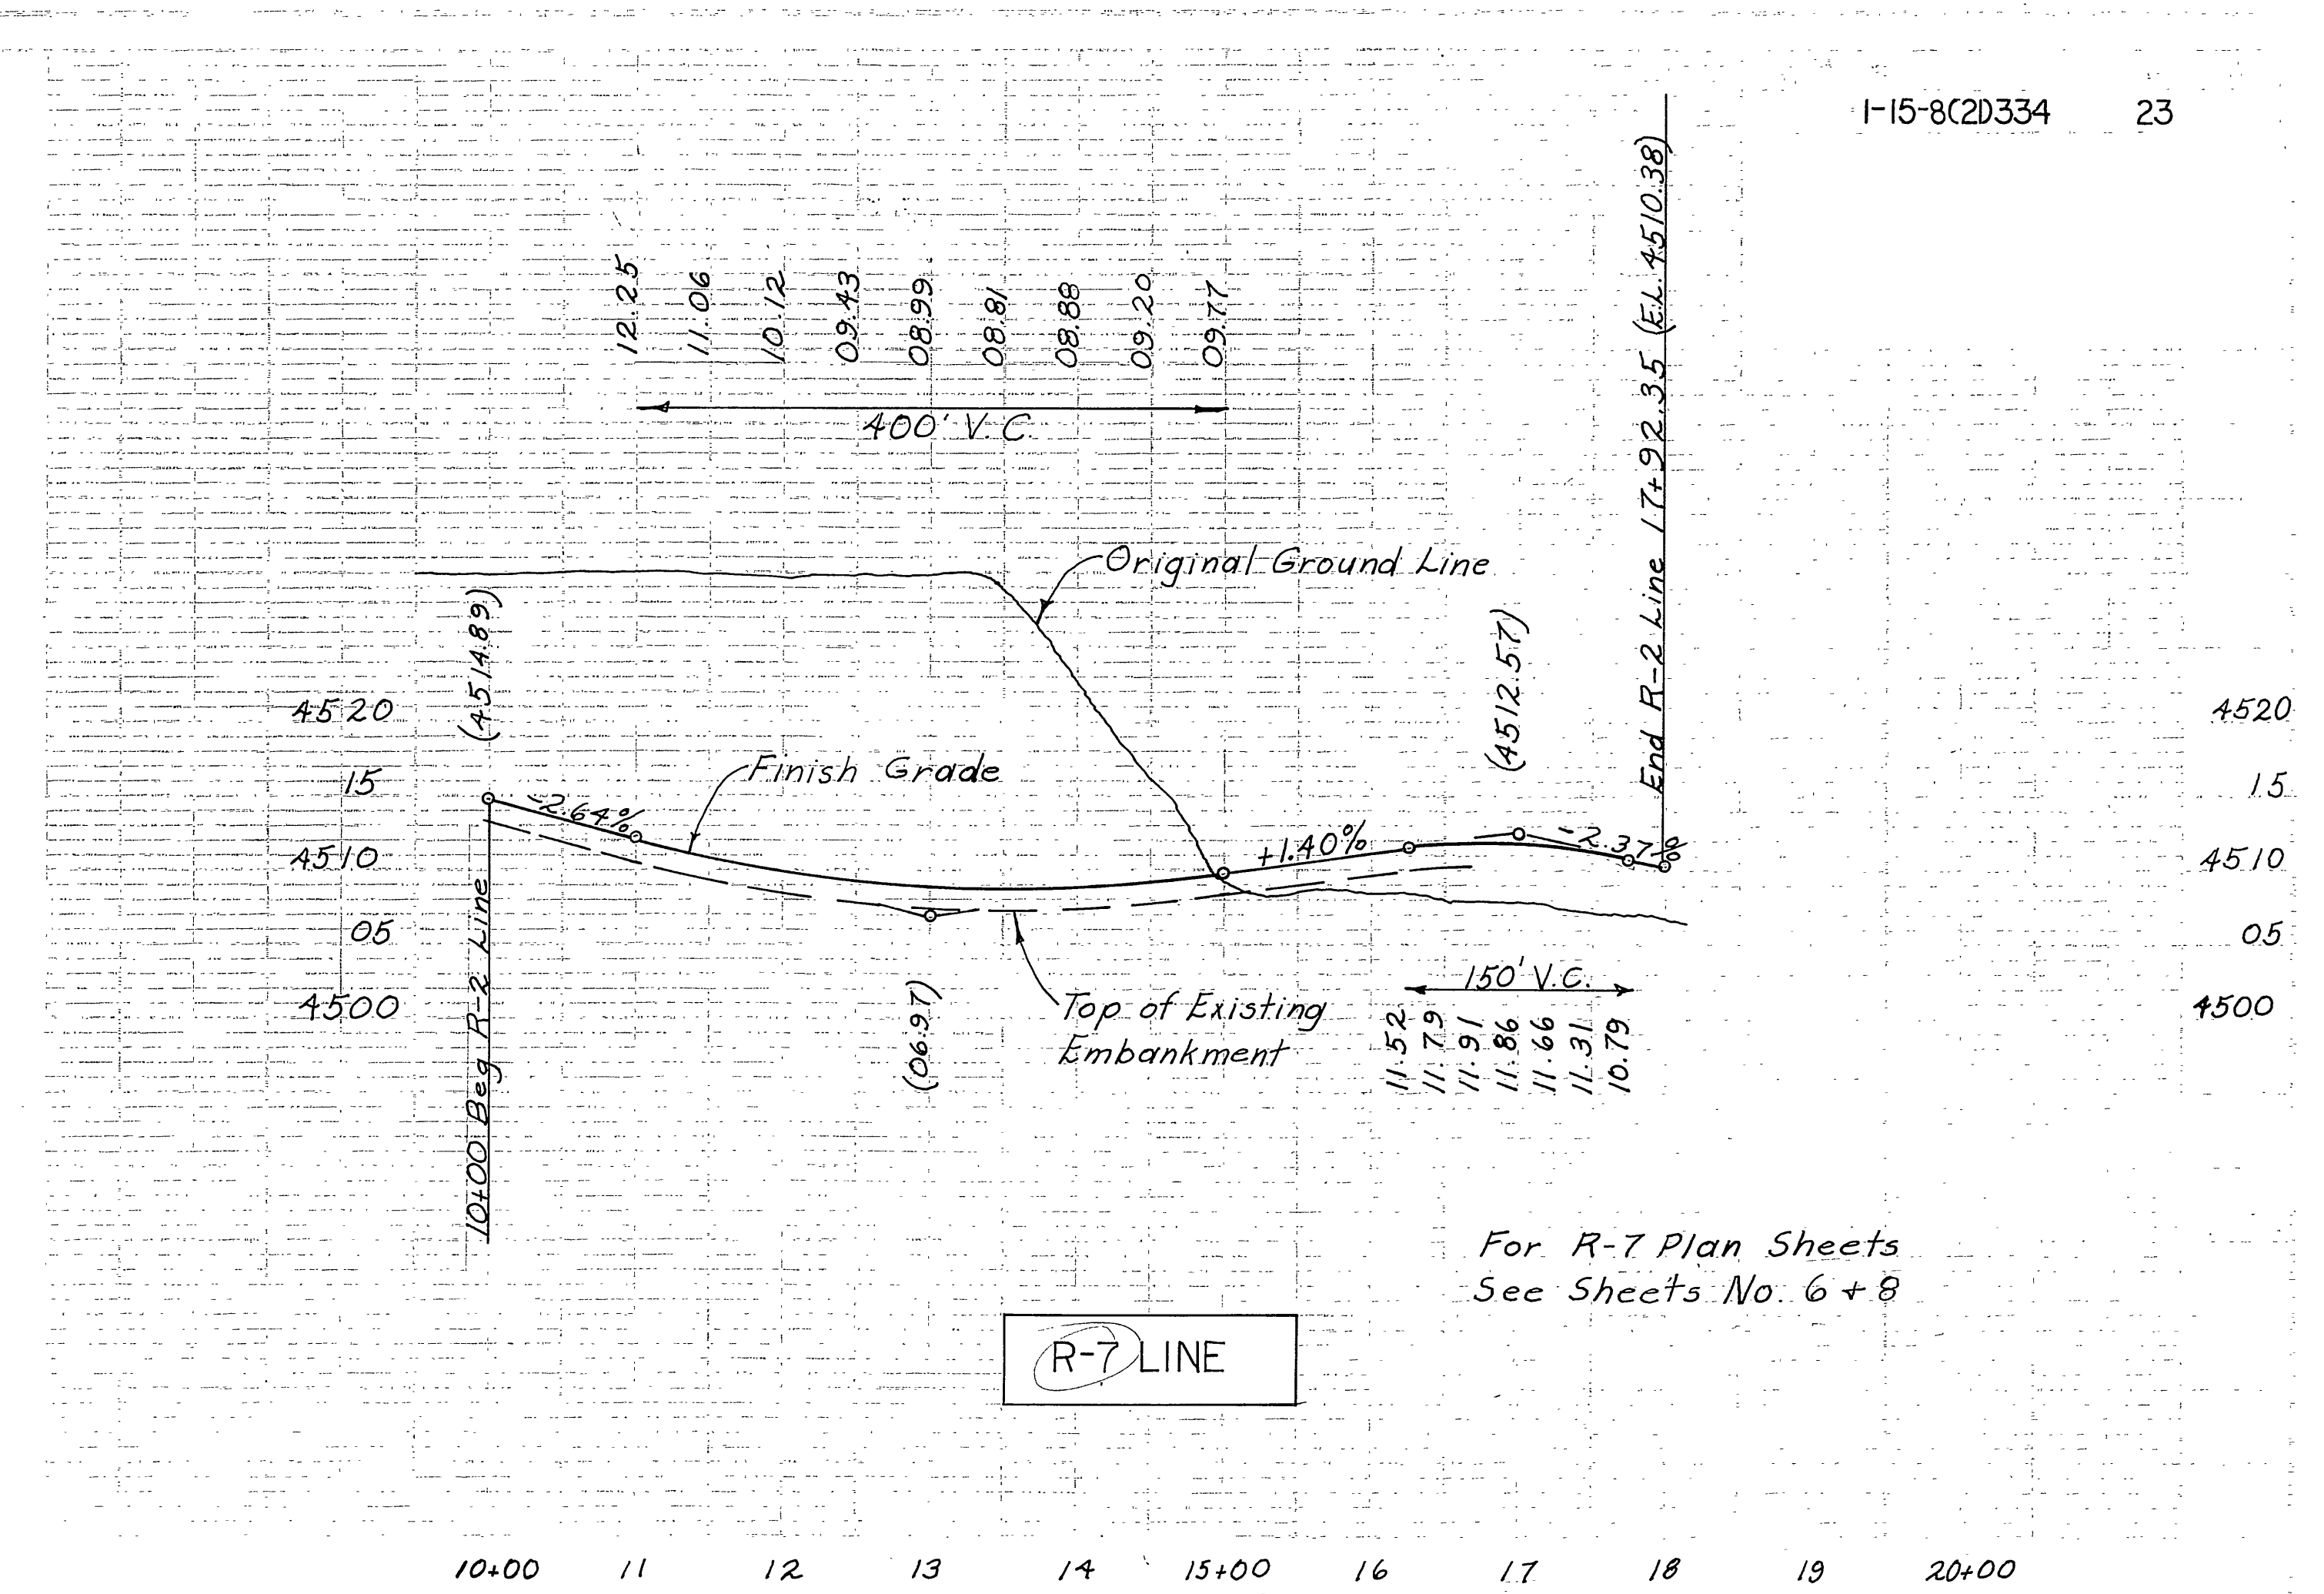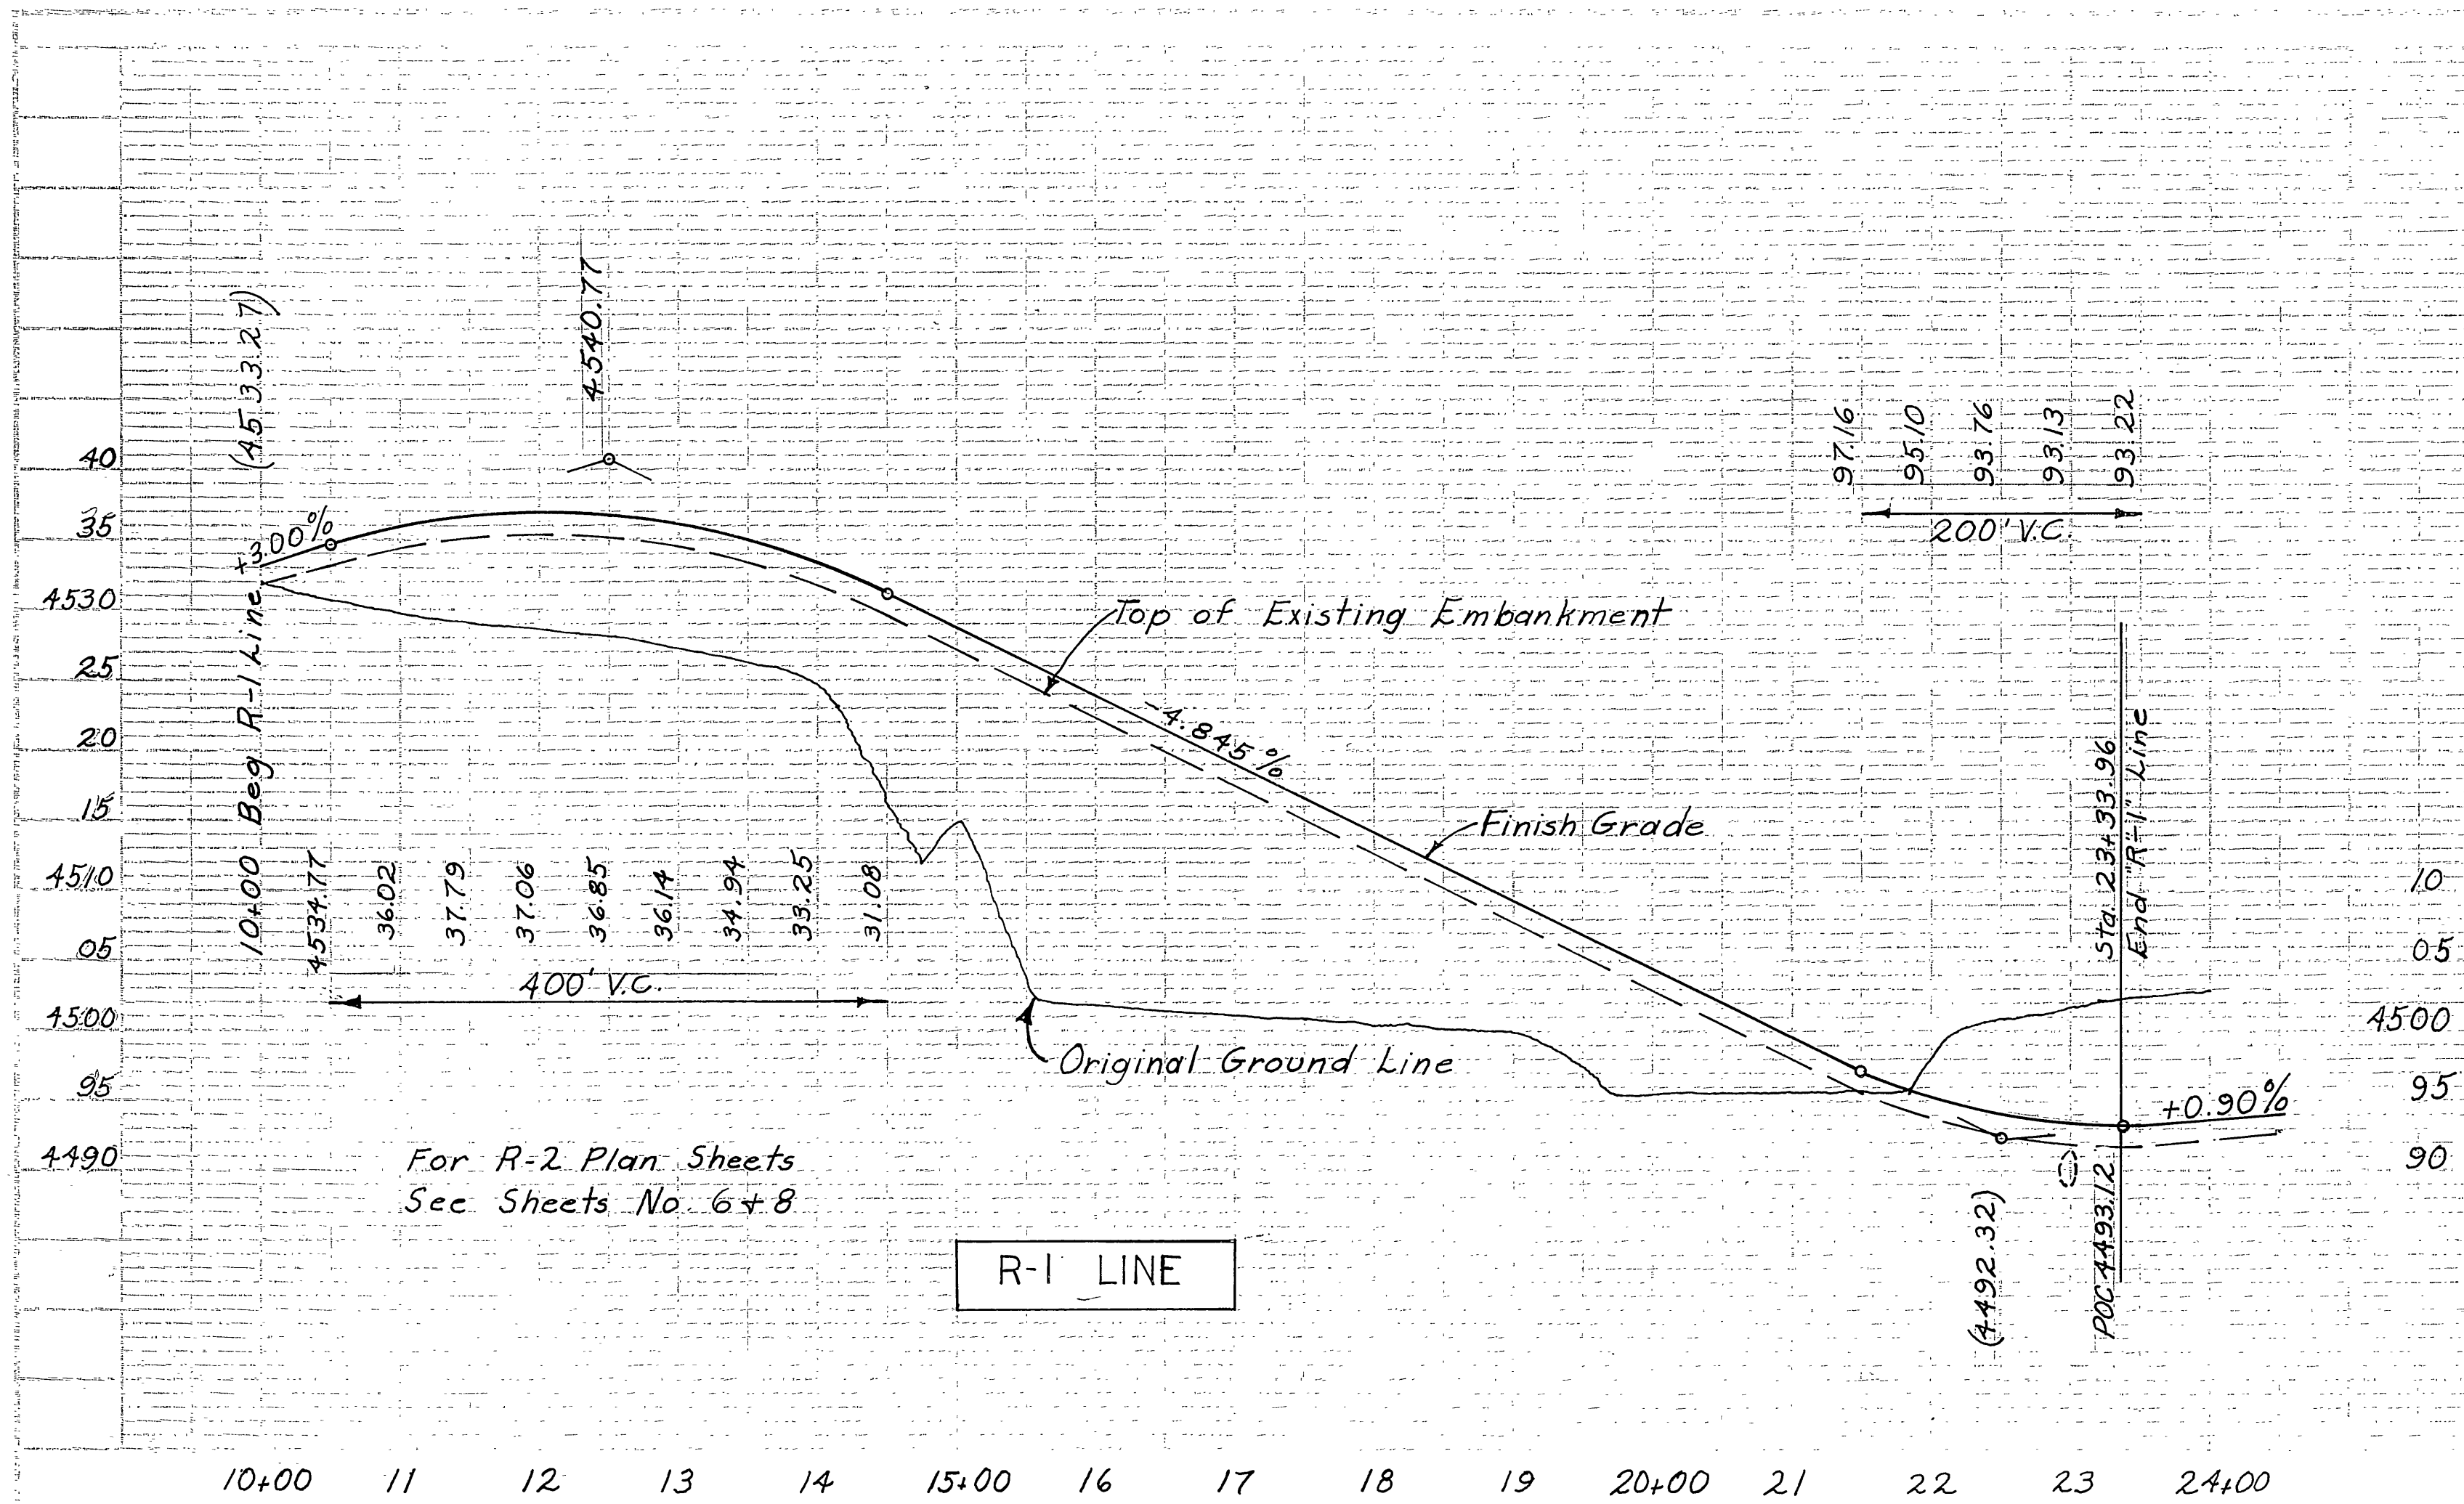

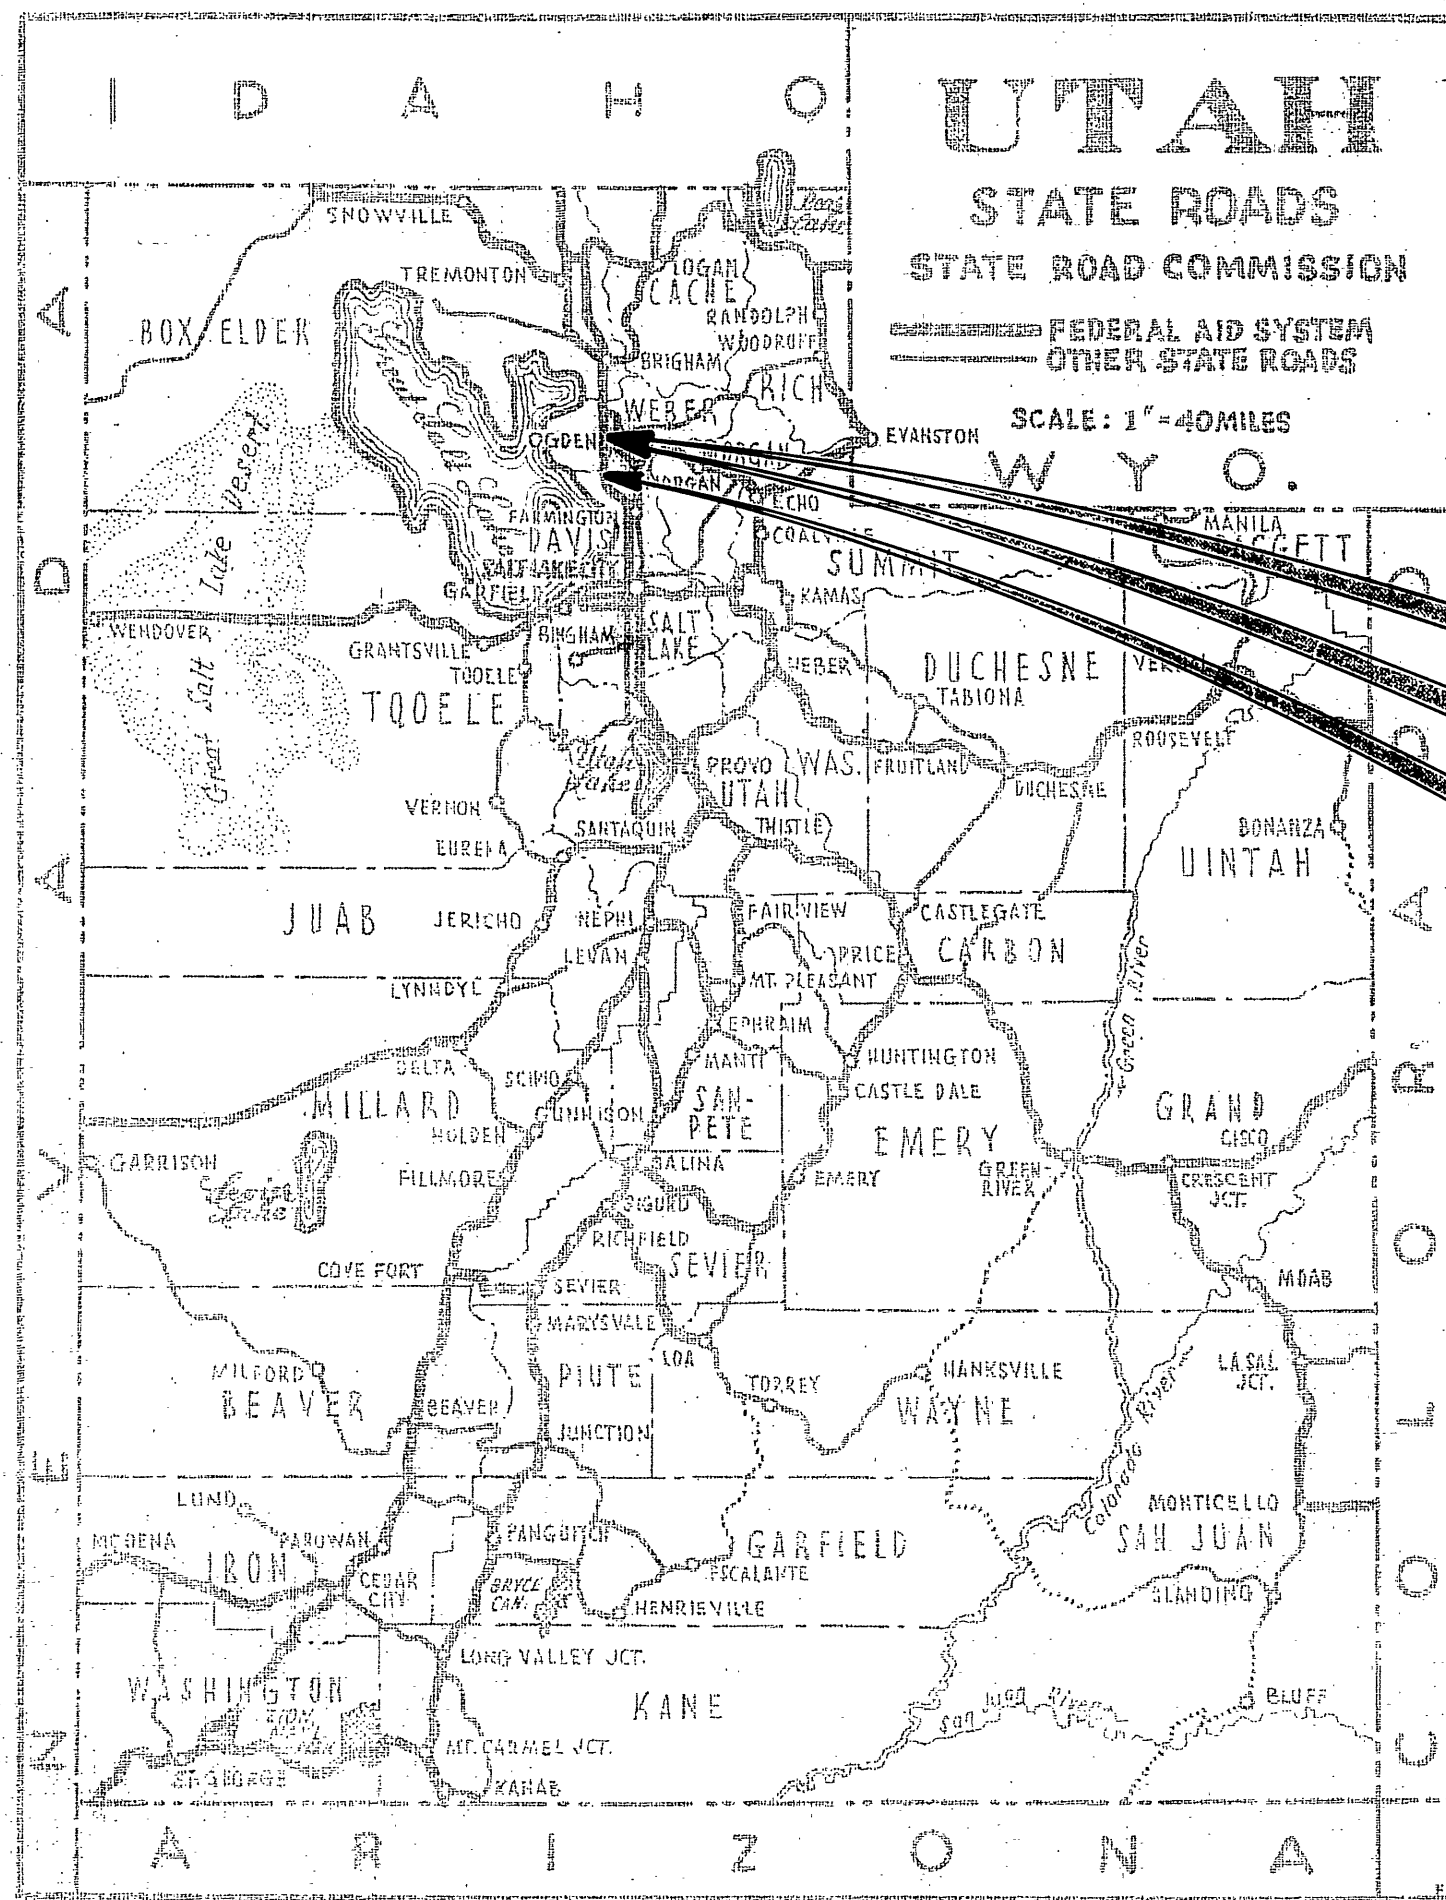

STATE OF UTAH STATE ROAD COMMISSION


PLANS OF PROPOSED STATE ROAD

FEDERAL AID PROJECT

I-15-8(21) 334 FOURTH CONTRACT
31st STREET INTERCHANGE
WEBER COUNTY
LENGTH 1.988 MILE

I-80N-6 (19) 45
I-80N FROM RIVERDALE ROAD
TO I-15 CONNECTION
WEBER COUNTY
LENGTH 0.814 MILE

I-15-7(69) 326 FIFTH CONTRACT
SYRACUSE ROAD ("M" LINE)
DAVIS COUNTY
LENGTH 0.303 MILE

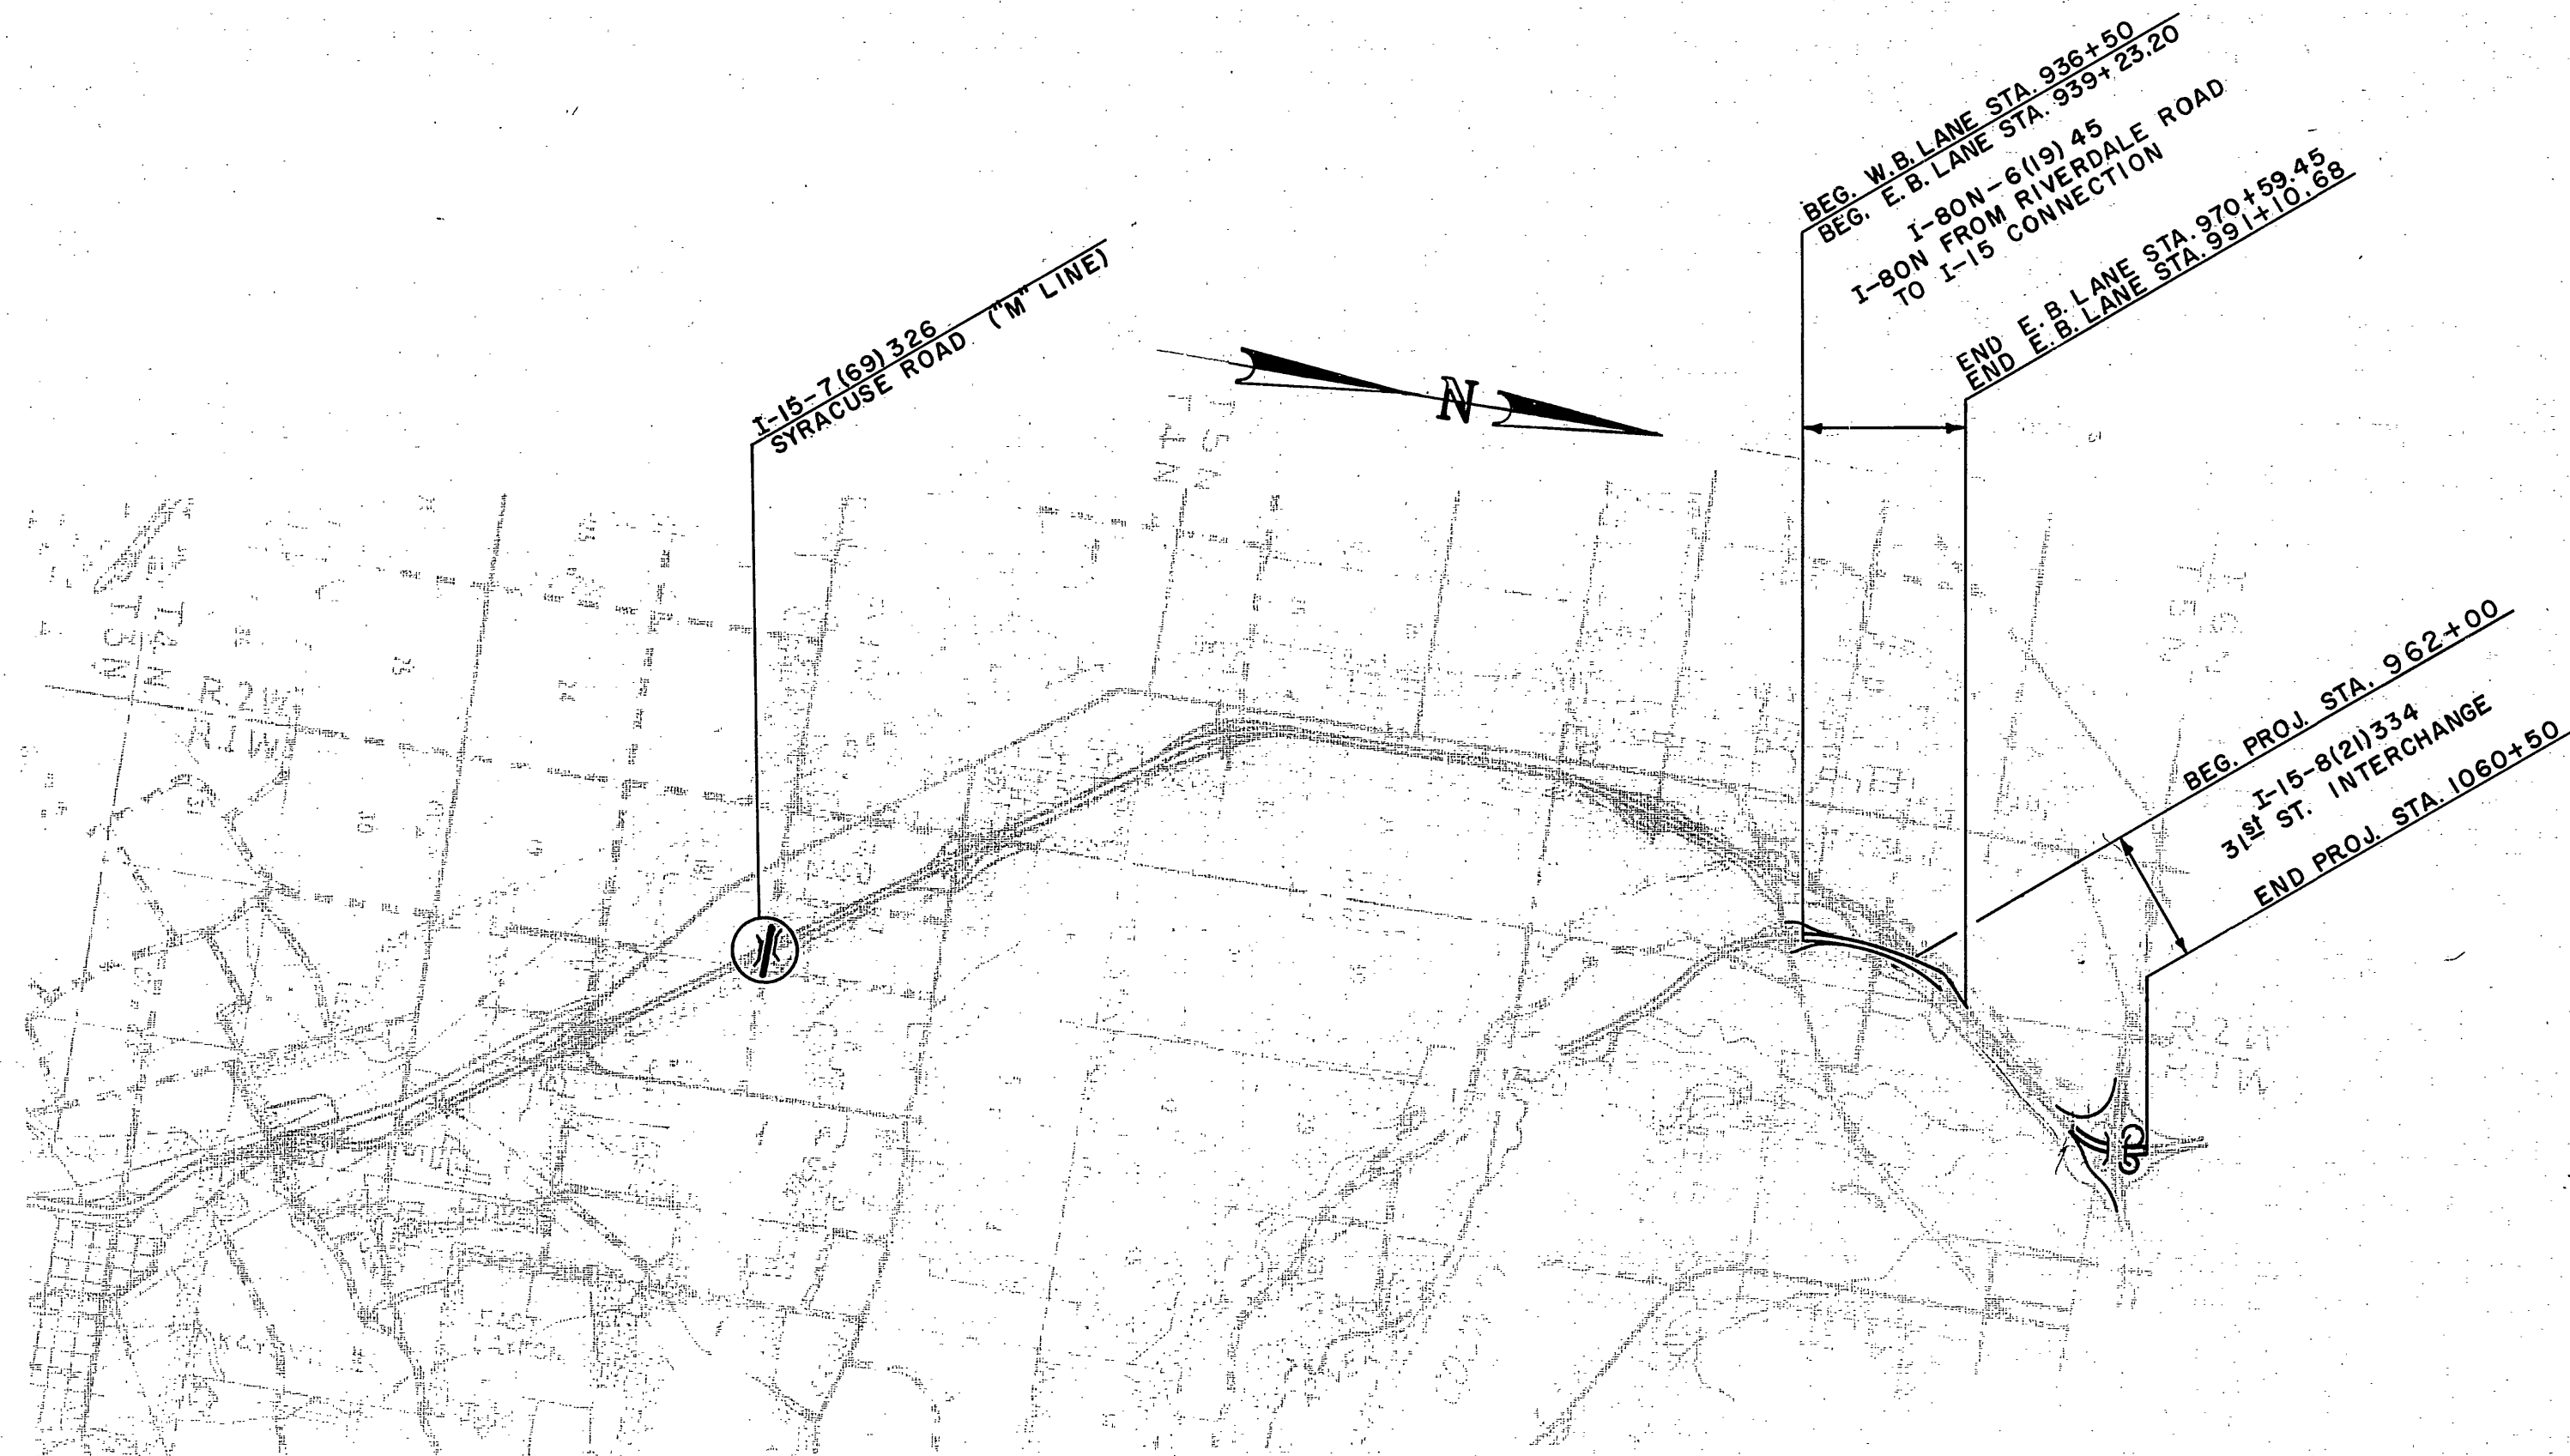

FED. RD. DIST. NO.	STATE	PROJ. NO.	SHEET NO.	TOTAL SHEETS
UTAH	UTAH	I-15-8(21) 334	I	1

REVISION DATE 6/10/66

INDEX TO SHEETS NO. I-15-8(21) 334 4TH CONT.

SHEET NO.	DESCRIPTION	DRAWING NO.	STATION
1	TITLE SHEET		
2-2C	TYPICAL SECTIONS - MAT'L'S. SHT.		
3-3B	SUMMARY SHEETS		
4-14	PLAN AND PROFILE		
15	STANDARD CATCH BASIN	V-750	
16	STANDARD CATCH BASIN	V-753	
17	STD. C.O.B. & CATCH BASIN-48" PIPE	V-755	
18	STD. C.O.B. & CATCH BASIN-42" PIPE	V-813	
19-20	SUPERELEVATION AND WIDENING	203(I-2)	
21	Entrance & Exit Ramp Geometrics	207	
22	CONCRETE CURB & GUTTER	220	
23	GUARD RAIL INSTALL. & LOCATION	231	
24	CORRUGATED METAL PIPE CULVERT	300	
25	METAL CULVERT END SECTIONS	302	
26	REINFORCED CONCRETE CULVERTS	320	
27	REINFORCED CONC. CULV. END SECT.	322	
28	DIPSTONE INLET AND OUTLET	351	
29-34	CONSTRUCTION SIGNING	500(I-5)	
35	CONSTRUCTION IDENT. SIGNS	504	
36	TYPICAL PAVEMENT MARKINGS	507	
37	STD. CATCH BASIN 36" PIPE	V-754	
38	DEEP BM. HWY. GUARD RAIL	230-1	
39	GUARD RAIL APP. ELEMENT INSTALL.	230-2	

INDEX TO SHEETS NO. I-80N-6(19) 45

SHEET NO.	DESCRIPTION	DRAWING NO.	STATION
1	TITLE SHEET		
2-2C	TYPICAL SECTIONS - MAT'L'S. SHT.		
3	SUMMARY SHEET		
4-11	PLAN AND PROFILE		
12-13	SUPERELEVATION AND WIDENING	203(I-2)	
14	Entrance & Exit Ramp Geometrics	207	
15	CONCRETE CURB AND GUTTER	220	
16	GUARD RAIL INSTALL. & LOCATION	231	
17	CORRUGATED METAL PIPE CULVERT	300	
18	METAL CULVERT END SECTION	302	
19	DIPSTONE INLET AND OUTLET	351	
20-24	CONSTRUCTION SIGNING	500(I-5)	
25	CONSTRUCTION IDENT. SIGNS	504	
26	TYPICAL PAVEMENT MARKINGS	507	
27	DEEP BEAM HWY. GUARD RAIL	230-1	
28	GUARD RAIL APP. ELEMENT INSTALL.	230-2	

INDEX TO SHEETS NO. I-15-7(69) 326 5TH CONT.

SHEET NO.	DESCRIPTION	DRAWING NO.	STATION
1	TITLE SHEET		
2-2B	TYPICAL SECTIONS - MAT'L'S. SHT.		
3	SUMMARY SHEET		
4-6	PLAN AND PROFILE		
5	CONCRETE CURB AND GUTTER	220	
6	GUARD RAIL INSTALL. & LOCATION	231	
7	CORRUGATED METAL PIPE CULV.	300	
8	METAL CULVERT END SECTIONS	302	
9	DIPSTONE INLET AND OUTLET	351	
10-14	CONSTRUCTION SIGNING	500(I-5)	
15	CONSTRUCTION IDENT. SIGNS	504	
16	TYPICAL PAVEMENT MARKINGS	507	
17	DEEP BEAM HWY. GUARD RAIL	230-1	
18	GUARD RAIL APP. ELEMENT INSTALL.	230-2	

UTAH STATE DEPARTMENT OF HIGHWAYS

RECOMMENDED FOR APPROVAL MAY 1966

E. L. Skoultz
ENGINEER OF ROADWAY DESIGN

RECOMMENDED FOR APPROVAL MAY 1966

David L. Hargrett
ENGINEER OF PLANS AND CONTRACTS

APPROVED MAY 1966

Blaine J. Kay
STATE HIGHWAY ENGINEER


DEPARTMENT OF COMMERCE
BUREAU OF PUBLIC ROADS

APPROVED

DIRECTOR ENGINEER DATE

FED. ROAD DIST. NO.	STATE	PROJ. NO.	FISCAL YEAR	SHEET NO.	TOTAL SHEETS
UTAH	UTAH	1-15-8 (21) 334	1966	2-A	

4THC

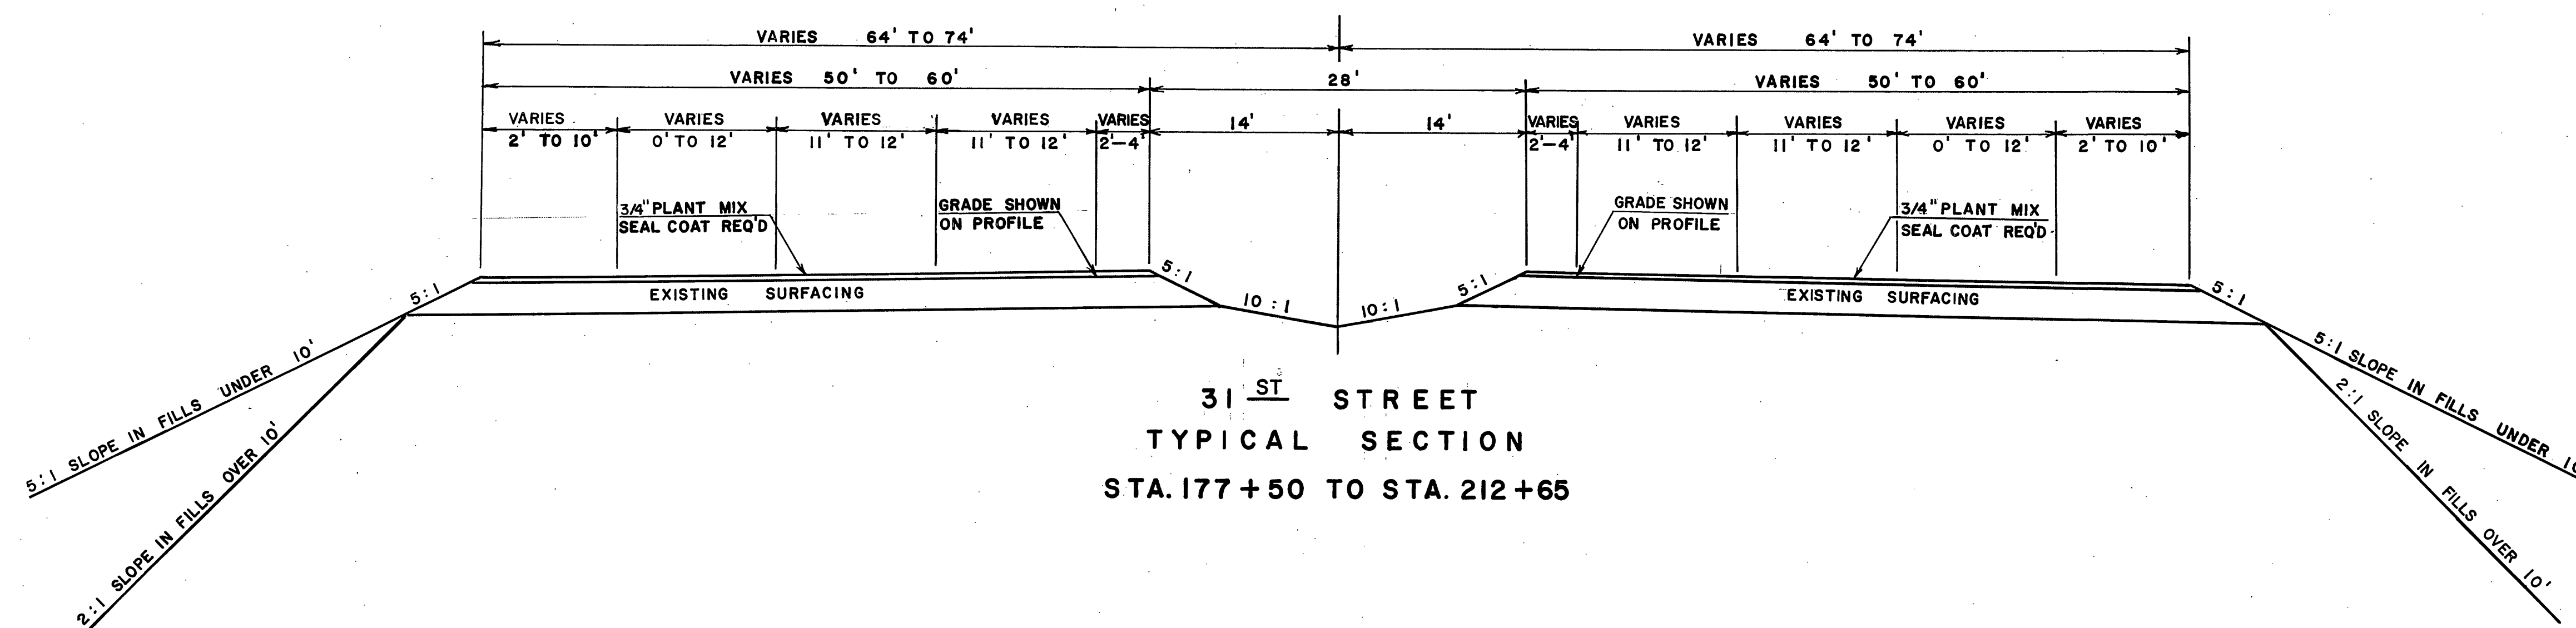


FED. ROAD DIST. NO.	STATE	PROJ. NO.	FISCAL YEAR	SHEET NO.	TOTAL SHEETS
UTAH	UTAH	I-15-8(2)334	1966	2-B	

PTHC


STRUCTURE END DRAIN

SEE PLAN SHEET NO. 4

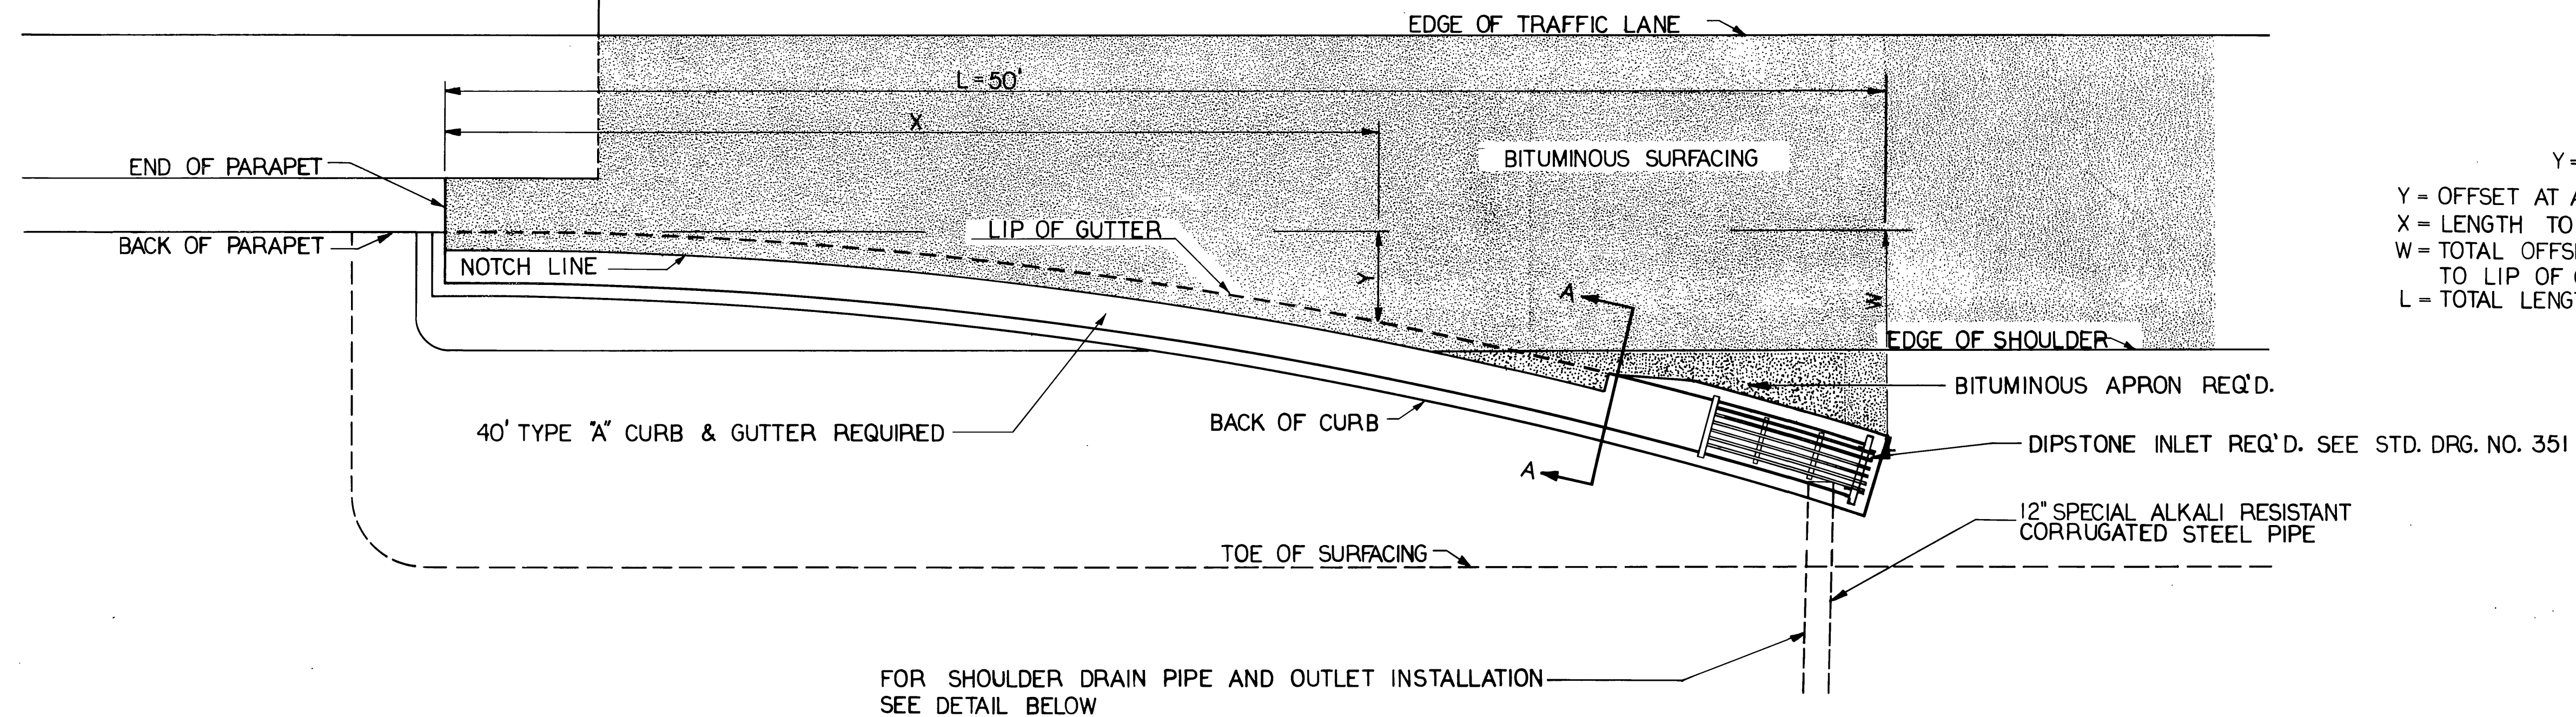


$$Y = W \frac{X^2}{L^2}$$

Y = OFFSET AT ANY POINT
X = LENGTH TO "Y" FROM END OF PARAPET
W = TOTAL OFFSET FROM BACK OF PARAPET TO LIP OF GUTTER
L = TOTAL LENGTH OF END DRAIN

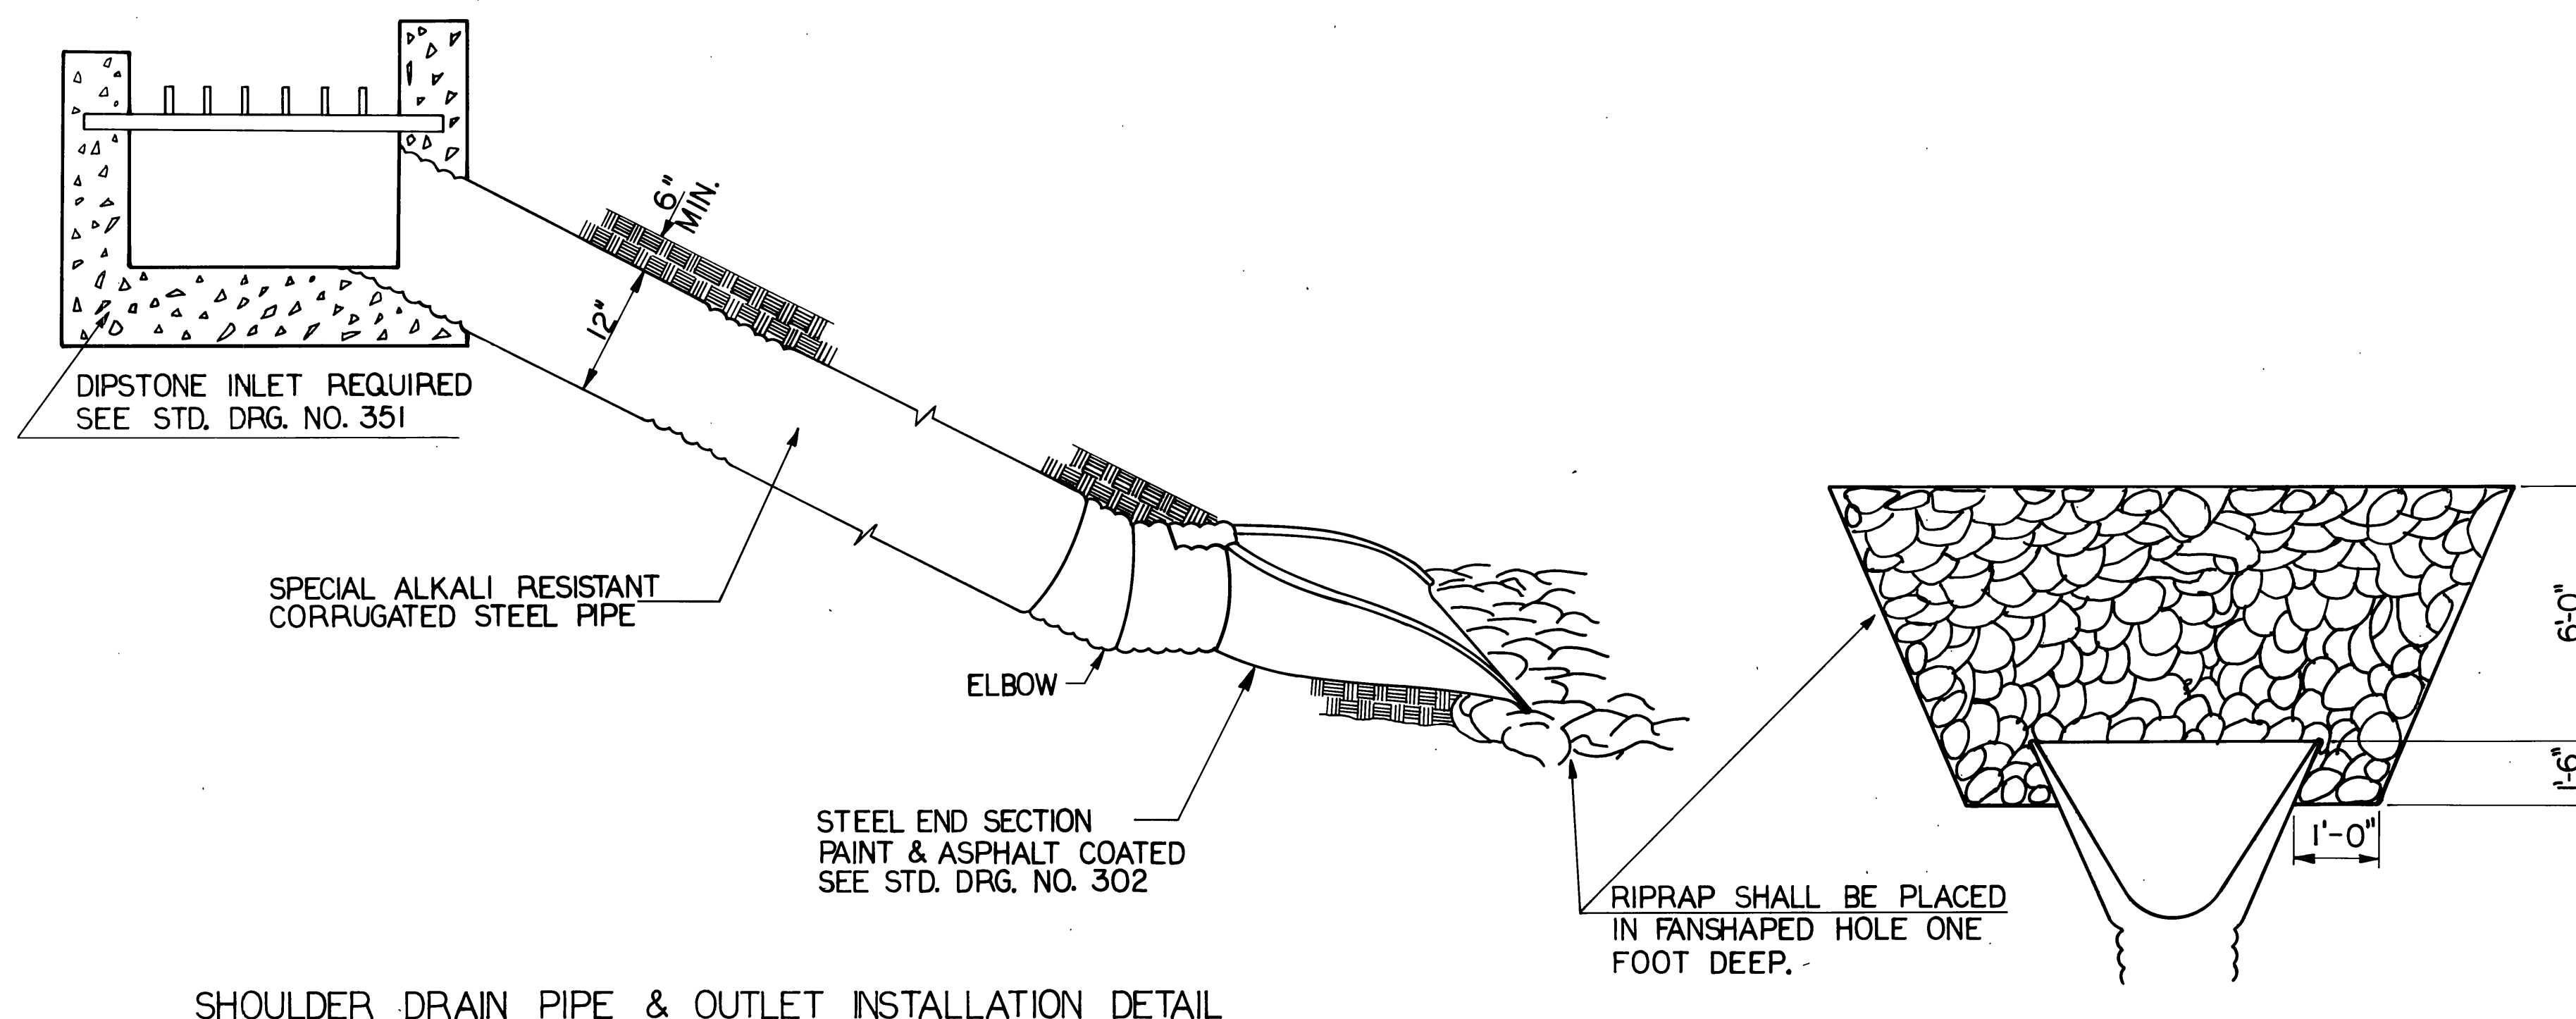

SHOULDER DRAIN PIPE & OUTLET INSTALLATION DETAIL

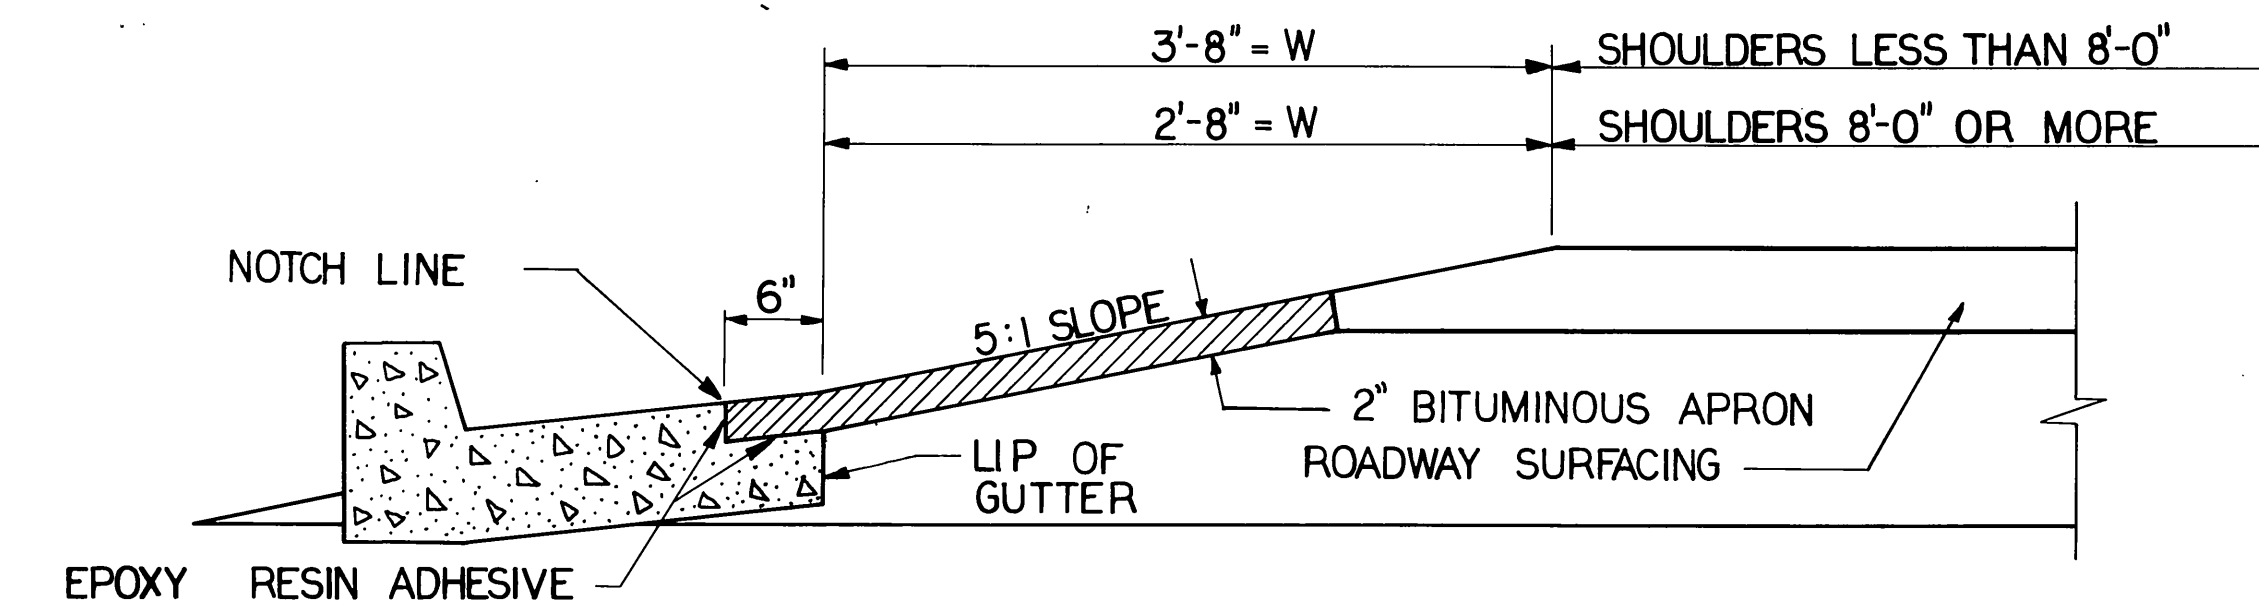

SECTION A-A
(TYPE "A" CURB AND GUTTER, MODIFIED WITH NOTCH TO RECEIVE PAVEMENT COURSE.) SEE STD. DRG. NO. 220

The information on these materials prospects shall in no way be construed so as to conflict with "Division I, Section 1-6.2 of Designated Local Materials Sources of the State of Utah Standard Specifications, 1960 Edition and Supplements,"

Ground Water Table (G.W.T.) = , = Test Hole

Bottom of Test Hole = * , = Section No.

Section Line ($\frac{1}{2}$) = _____

$\frac{1}{4}$ Section Line = _____

$\frac{1}{16}$ Section Line = _____

$\frac{1}{32}$ Section Line = _____

$\frac{1}{64}$ Section Line = _____

$\frac{1}{128}$ Section Line = _____

$\frac{1}{10384593717$

FED. ROAD DIV. NO.	STATE	FEDERAL AID PROJECT NO.	SHEET YEAR	SHEET NO.	TOTAL SHEETS
UTAH	UTAH	I-15-8(21)334	1966	2C	

UTAH STATE DEPARTMENT OF HIGHWAYS
MATERIALS SECTION

MATERIALS PROSPECTS AND TEST HOLES

PROJECT NO I-15-8(21)334


PROJECT NAME 31ST STREET, OGDEN,
INTERCHANGE; I-80N CONNECTION AND
SYRACUSE ROAD OVERPASS

COUNTY DAVIS & WEBER

DATE: MAY 1966. DRAWN BY: W. CLAPTON.

DATA BY: AUTH:

FIELD BOOK: SHEET NO. 1 OF 1

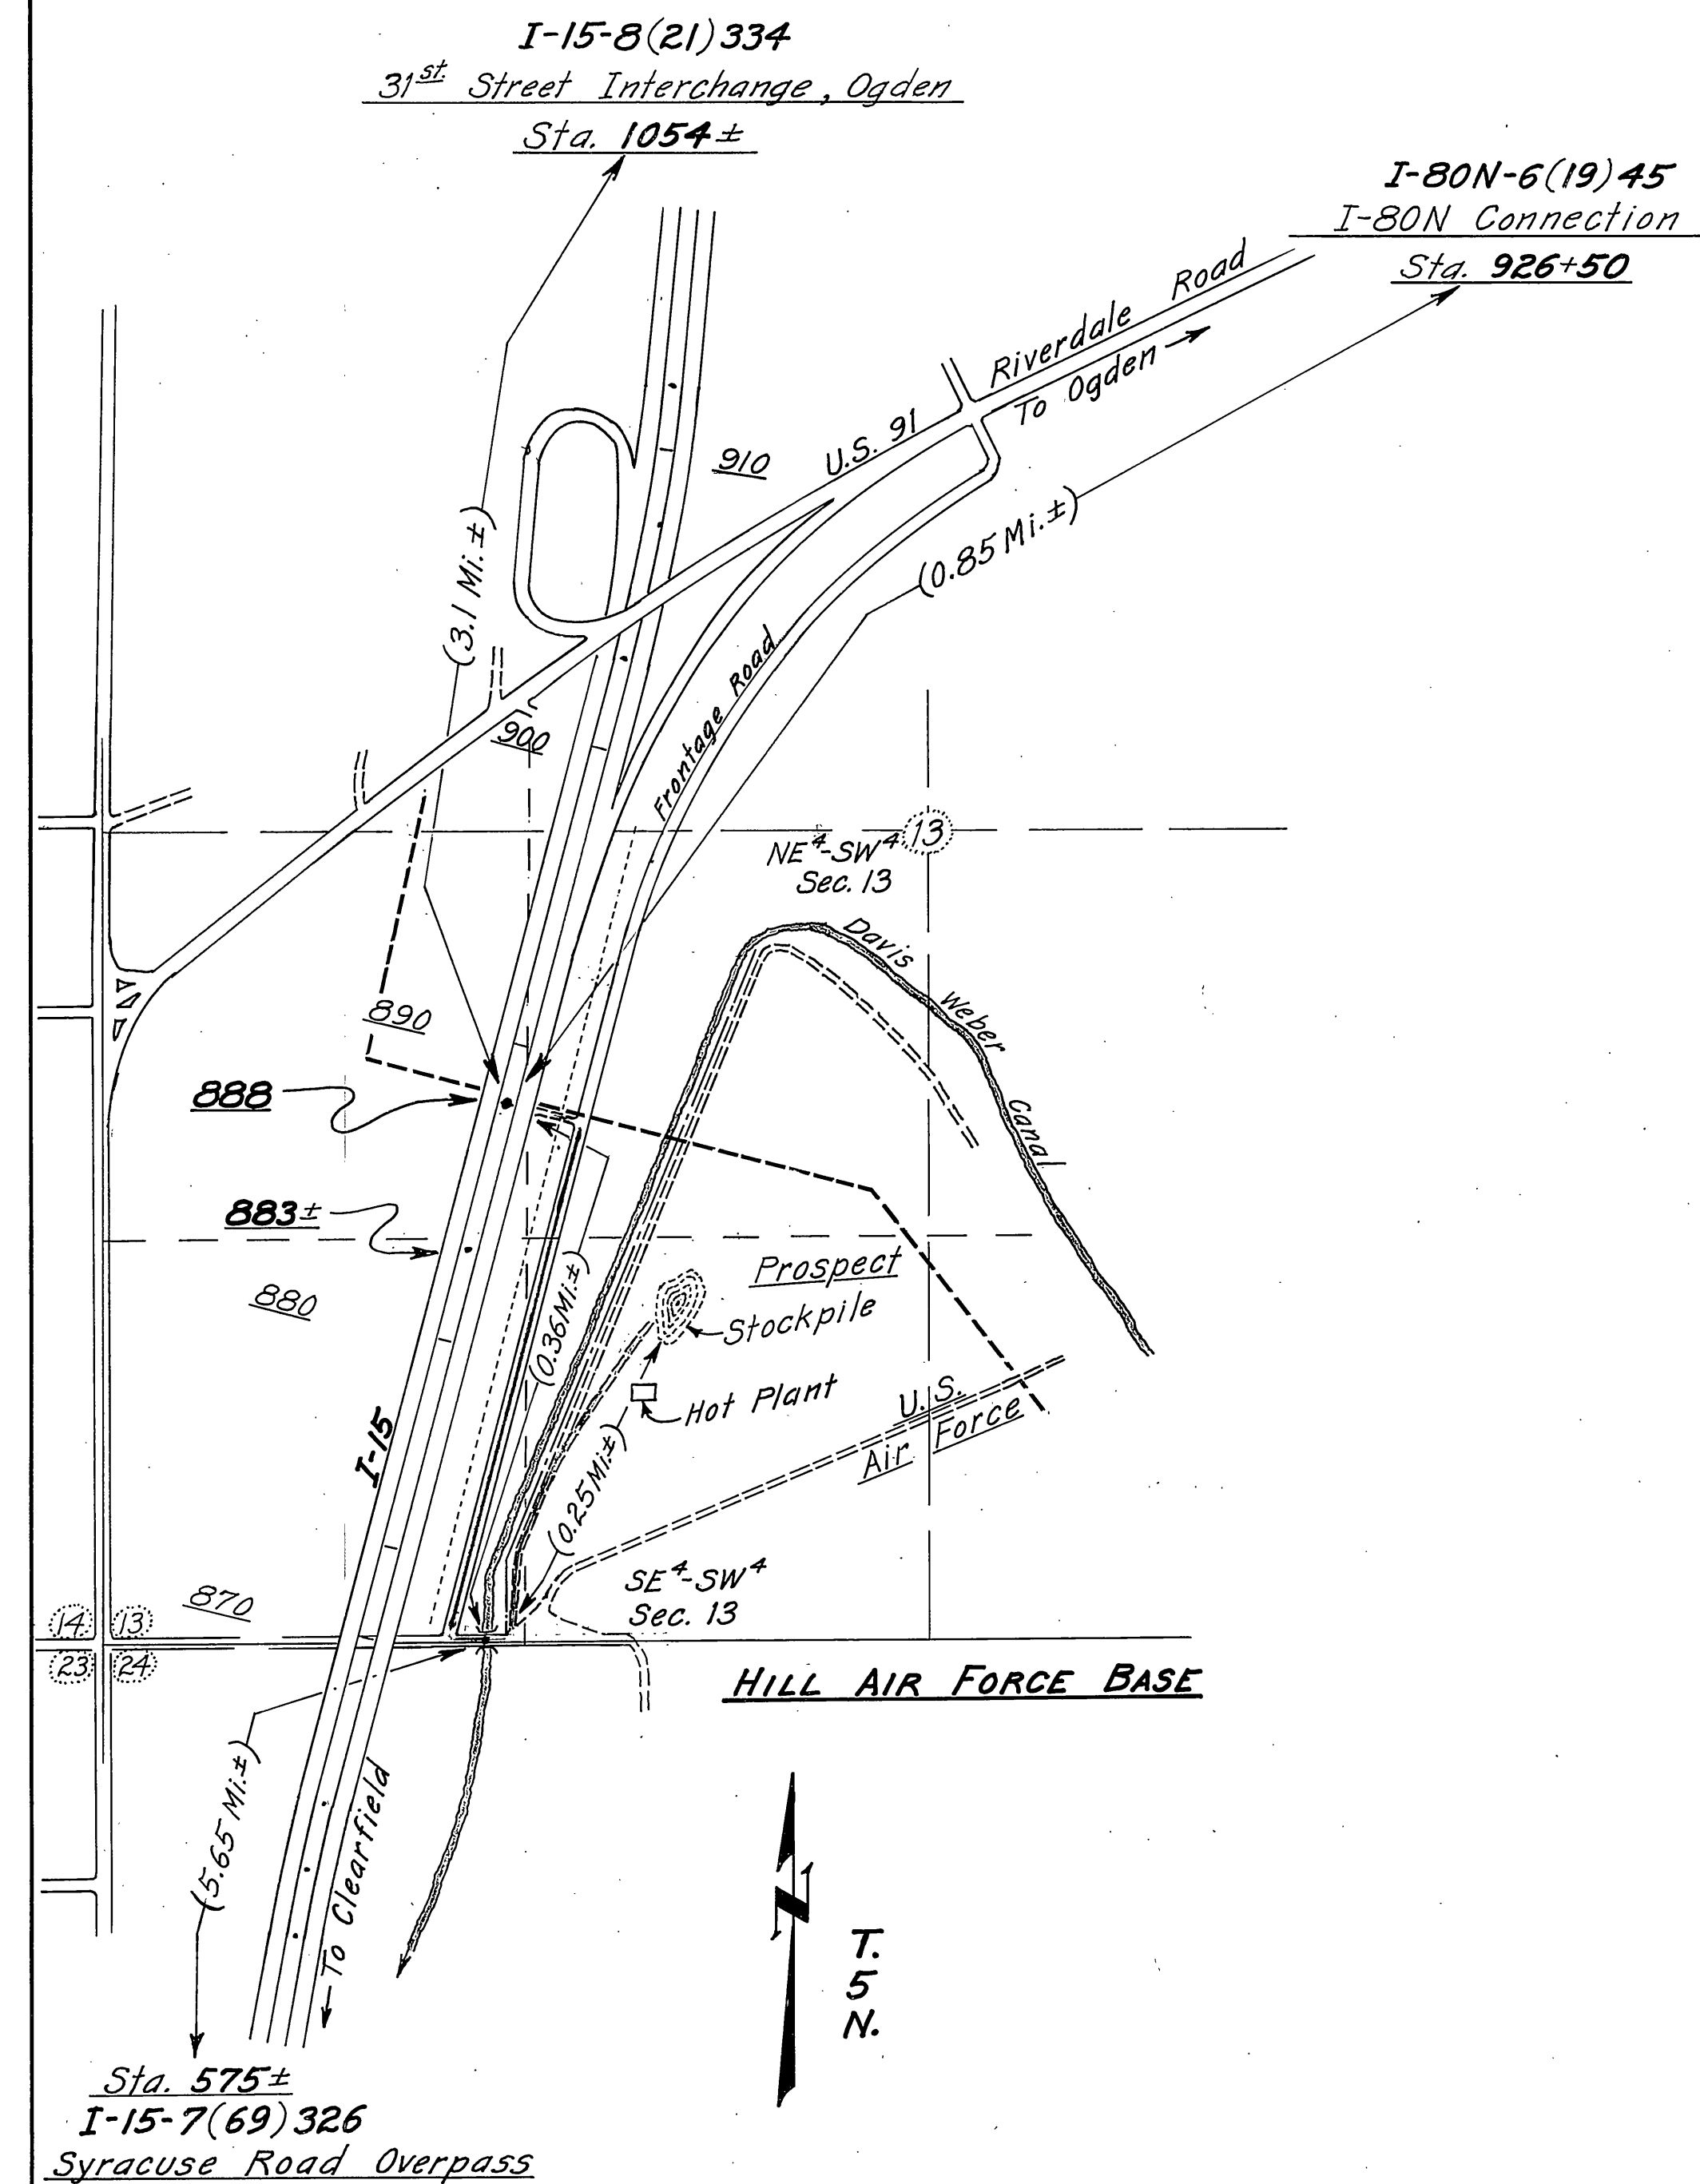

Fife's Crusher Belt Sampling								Stock Pile Sampling				
Sample Number	1	2	4	5	6	7	8	65-1-A-1009	65-1-A-1010	65-1-A-1011	65-1-A-1012	65-1-A-1013
Test Hole								4	3	5	1	2
Passing 2".....%		100						100	100	100	100	100
" 1½".....%	100	97	100	100	100	100	100	100	96	100	100	99
" 1".....%	88	79	79	74	72	78	68	89	84	90	87	84
" ¾".....%	72	68	74	65	61	68	56	79	71	80	80	75
" ½".....%	56	54	60	50	52	55	47	67	60	69	67	64
" ⅜".....%	49	47	52	43	45	47	43	62	53	61	60	57
" No. 4.....%	38	38	43	35	38	39	38	53	45	50	51	48
" No. 10.....%	34	34	39	31	34	35	35	49	41	45	46	44
" No. 40.....%	25	23	28	21	23	23	26	38	30	33	33	32
" No. 80.....%	11	14	15	10	11	12	12					
" No. 100.....%								16	12	15	15	14
" No. 200.....%	6	8	8	5	5	6	6	9	8	10	10	9

R-2-W. S.L. B. 8 M. Scale: 1" = 500' Contour Interval =

GRAVEL Prospect No. 1

LOG of TEST HOLES

Ground Line

1 # 2 # 3 # 4 # 5 # 6 # 7 # 8 # 9 # 0

[illegible][illegible][illegible]

LINE LANE	STATION		ROADWAY EXCAVATION CUBIC YARD
	FROM	TO	
I - 15	1048+77	1062+00	38,885
T - 4	21+00	27+50	3,709
T - 6	10+00	19+50	7,292
T - 7	10+00	19+55	8,025
TOTAL			57,915
USE			61,000

REV. 6/10/66 4TH
9-20-68

DRAINAGE SUMMARY																
BOXS NO.	LANES OR LINE	STATION		CROSSING ANGLE OR REMARKS	PIPE CULVERTS					HEIGHT OF FILL	END SECT.		STRUCT. EXC.	MECH. TAMP.	GRANULAR BACKFILL	
		FROM	TO		LINEAR FEET						C.S.P.	EACH				
					C.S.P.	REINFORCED	CONC.	PIPE	C.S.P.			R.C.P.				
FROM - TO					12"	24"	30"	42"	48"		12"	24"	CUBIC YARD	HOUR	CUBIC YARD	
SOUTH STORM SEWER																
1 - 2	T - 1	22+51	17+00	90°		100				1.8			70.1	9.5		
2 - 3	T - 2	17+00	18+50	RT.		155				1.7				37.3	223.9	
3 - 4	T - 2	18+50	20+00	RT.		172				2.3				34.7	208.1	
4 - 5	T - 2	20+00	21+50	RT.		179				2.4				36.3	217.9	
5-A - 5	T - 2	21+50	1046+90	90°		70				1.5				20.2	121.0	
5 - 6	T-2-I-15	1046+90	1047+27	MEDIAN		91				2.4						
6 - 7	I-15	1047+27	1047+50	RT.		91				5.6				17.8	106.5	
7-A - 7	I-15	1048+50	1047+70	RT.		90				5.2				24.2	145.2	
7 - 8	I-15-T-3	1047+70	19+00	RT.		274				8.3						
8 - 9	T - 3	19+00	20+74	T-4 LT		190				9.0				30.3	181.5	
9 - 10	T - 4	20+74	OUTFALL	RT		163				10.0				37.3	223.9	
10 - 11	T - 4	21+40		-70° TO-OUTFALL		200				6.0				40.3	242.0	
SOUTH STORM SEWER																
5 - 6	I-15	1067+00	1063+50	MEDIAN		352				2.3			254.4	33.9		
6-A - 6	I-15	1063+50		-90° ON LT.		140				2.3			119.2	15.9		
6-B - 6	I - 15	1063+50	1063+50	90° ON RT.		160				2.3			170.2	22.7		
6 - 7	I - 15	1063+50	1061+10	MEDIAN		232				2.7			275.0	37.3		
7-A - 7	I - 15	1061+04	1061+04	90° ON LT.		80				2.2			77.7	10.3		
7-B - 7	I - 15	1061+04	1061+04	90° ON RT		80				5.0			118.7	17.2		
7 - 8	I - 15	1061+04	1058+22	MEDIAN		280				2.2			311.3	39.1		
8 - 9	I - 15	1058+22	1055+80	MEDIAN		288				1.0			384.2	39.2		
9-B - 9-C	T - 7-I-15	1055+80	1055+80	130°		384				14.9			555.2	87.1		
9-C - 9-A	T-7-I-15	1055+80	1055+80	ON LT.		86				8.5			718.6	105.6		
9-D - 9-A	I - 15	1053+48	1055+80	ON LT.		170				1.2			108.7	13.6		
9-E - 9-D	I - 15	1053+48	1055+80	ON LT.		60				1.8			87.6	11.0		
9-A - 9	I - 15	1055+80	1055+80	90° ON LT.		92				4.1			181.9	22.7		
9 - 10	I - 15	1055+80	1055+38	90° ON RT.		250				6.3			214.5	35.8		
10-A - 10	I - 15	1053+48	1055+38	ON RT.		189										
10 - 11	I-15-T-6	1055+38	22+25	ON RT.		304				4.9			699.4	86.5		
11 - 12	T - 6	22+25	12+60	70°		220				4.2			556.0	66.9		
12 - 13	T - 5	12+60	12+60	160° TO OUTFALL		290				4.9			400.0	49.5		
13 - 14	T - 5	11+50	1067+00	TO-OUTFALL		80				2.9			241.2	38.6		
	31 STREET	200+00 LT.		STRUCTURE END DRAIN		96				1.0	1		26.4	3.9		
	31 STREET	200+00 RT.		STRUCTURE END DRAIN		160				1.0	1		27.8	4.1		
	T-4	25+30		90°		48				3.9	2		34.2	3.8		
	I-15	1041+80	1046+85			504							128.9	10.4	62.3	
	I-15	1061+00	1067+00			286							126.7	10.2	61.2	
	I-15-T-7	1055+80	12+23			702							160.0	12.9	77.3	
	T-7	11+39	13+39			200										
	I-15	1052+88				40										
	31 ST ST	197+35				3340	716	392	850		2	2	6047.9	1066.1	1870.8	

* 12" CORRUGATED PERFORATED STEEL PIPE UNDERDRAIN
** SPECIAL ALKALI RESISTANT
TOTAL USED 162.0 1990.0 35.91 371 343 814 3 4 16071.8 716.0

SMALL STRUCTURE AND DRAINAGE SUMMARIES COMPOSITE																	
SUMMARY SHEET ITEMS	PIPE CULVERTS							END SECTION		STRUCT. EXC.	MECH. TAMP.	STRUCT. STEEL	REINF. STEEL	CONC. CLASS A (A.E.)	RIPRAP	DIPSTONE INLET	GRANULAR BACKFILL
	LINEAR FEET							EACH									
	C.S.P		REINFORCED		CONC. PIPE		UNDER- DRAIN	C.S.P	R.C.P								
	**	**	**	**	**	**	**	**	**	**	CUBIC YARD	HOUR	LBS.	LBS.	CUBIC YARD	CUBIC YARD	EACH
DRAINAGE SUMMARY	196		3340	716	392	850	936	2	2	6047.9	1066.1						1870.8
SMALL STRUCTURE																	
SUMMARY										433.5	37.5	9300	11,250	104.0	22.2	2	
DRAINAGE NO. 2		1450	1370		4328					9593.1	1114.8						
SMALL STRUCTURE																	
SUMMARY NO.2										379.6	63.3	7675	8955	87.2	9.3		
TOTAL	196	1450	4710	716	4720	850	936	2	2	16,454.1	2281.7	16,975	20,205	191.2	31.5	2	1870.8
USE	162	1450	4710	716	4638	814	1440	2	4	25,377	2300	17,000	16,370	146	30	2	2006

* 12" CORRUGATED PERFORATED STEEL PIPE UNDERDRAIN
** SPECIAL ALKALI RESISTANT

SMALL STRUCTURES SUMMARY													
LANES OR LINE	STATION	LEFT OR RIGHT	BOX NO.	CONCRETE STRUCTURES		STRUCT. EXC.	MECH. TAMP	STRUCT. STEEL	REINFORC STEEL	CONCRETE CLASS A	RIPRAP	DIPSTONE INLET	DWG 302
				DWG. NO.	LINE NO.								
SOUTH STORM SEWER													
T-1	22+00	LT.	1	V-750	49	CATCH BASIN	7.5	0.7	310	232	1.8		
T-2	17+00	RT.	2	V-750	4	" "	7.5	0.7	310	232	1.8		
T-2	18+48	LT.	3	V-750	2	" "	8.2	0.8	310	265	1.9		
T-2	20+00	LT.	4	V-750	4	" "	9.7	0.9	310	305	2.2		
T-2	21+50	RT.	5	V-750	4	" "	8.2	0.8	310	265	1.9		
T-2	21+50	LT.	5-A	V-750	4	CATCH BASIN	6.7	0.6	310	225	1.6		
I-15	1047+50	MED	6	V-750	8	" "	11.2	1.0	310	344	2.5		
I-15	1047+50	RT.	7	V-750	16	" "	18.2	1.6	310	471	5.0		
I-15	1048+50	RT.	7-A	V-750	7	" "	9.7	0.9	310	305	2.2		
T-3	19+00	LT.	8	V-750	18	" "	20.2	1.9	310	550	5.8		
T-3	20+74	LT.	9	V-750	13	CATCH BASIN	20.7	1.8	310	543	5.6		
I-15	1042+70	LT.	10	V-750	4	CATCH BASIN	12.4	1.5	310	464	4.7		
T-4	21+40	RT.				OUTFALL NO. 1					8.5		
NORTH STORM SEWER													
I-15	1067+00	MED	5	V-750	3	CATCH BASIN	8.9	0.8	310	272	2.1		
I-15	1065+50	LT.	6-A	V-750	3	" "	8.9	0.8	310	272	2.1		
I-15	1063+50	MED	6	V-750	3	" "	9.7	0.9	310	305	2.2		
I-15	1064+00	RT.	6-B	V-750	3	" "	8.9	0.8	310	272	2.1		
I-15	1061+04	LT.	7-A	V-750	4	" "	8.2	0.8	310	265	1.9		
I-15	1061+04	MED	7	V-750	8	" "	11.5	1.0	310	292	2.4		
I-15	1061+04	RT.	7-B	V-750	164	CATCH BASIN	18.2	1.6	310	471	5.0		
I-15	1058+22	MED	8	V-750	1	" "	12.4	1.0	310	269	2.9		
T-7	18+50	RT.	9-B	V-750	264	" "	31.0	2.6	310	709	7.3		
I-15	1055+80	LT.	9-C	V-750	344	" "	36.3	3.0	310	831	8.5		
I-15	1055+80	LT.	9-A	V-750	3	" "	9.8	0.8	310	254	2.1		
I-15	1055+68	MED	9	V-750	25	CATCH BASIN	13.3	1.1	310	301	3.1		
I-15	1053+04	LT.	9-D	V-750	2	" "	7.4	0.6	310	204	1.6		
I-15	1055+50	RT.	10	V-750	14	" "	24.7	2.0	310	559	5.8		
I-15	1052+88	RT.	10-A	V-750	2	" "	13.1	1.2	310	330	2.8		
T-6	22+00	RT.	11	V-750	222	" "	18.1	1.5	310	400	4.2		
T-5	12+40	LT.	12	V-750	6	" "	21.9	1.8	310	484	5.1		
I-15	1067+00	LT.	13	V-750	144	CATCH BASIN	24.7	2.0	310	559	5.8		
T-5	11+30	RT.				OUTFALL NO. 2					9.3		
31 STREET	200+00	LT.		SEE SHT. 2-B		STRUCTURE END DRAIN					2.2		1
31 STREET	200+00	RT.		SEE SHT. 2-B		STRUCTURE END DRAIN					2.2		1
T-4	26+57	RT.				SHOULDER DRAIN							
I-15	1054+00	LT.	8A	V-750	3	CATCH BASIN	6.7		310				
I-15	1053+04	LT.	9E	V-750	4	" "	5.9		310				
I-15	1052+88	RT.	10B	V-750	2								
TOTAL USED							361.3	37.5	9300	11,250	104.0	22.8	2
TOTAL USED							361.3		9875	9451	81.8	22.8	-

Br 9-23-68

DRAINAGE SUMMARY NO-2

BOX NO.	LANES OF LINE	STATION		CROSSING OR ANGLE REMARKS	PIPE CULVERT			STRUCT. EXC. CUBIC YARD	MECH. TAMP. HOURS
		FROM	TO		LINEAR FEET				
					24"	36"	42"		
FROM-TO									
BOX IN-1	F-LINE	16+00	16+80	RT LT	86				
1 2	I-15	964+00	964+80	RT LT	394			92.1	13.1
2 3	" I-15	16+00 20+81	20+81 23+35	RT LT	250			459.9	66.1
3 4	" I-15	968+50	971+50	RT "	300			441.6	65.1
4 5	" I-15	26+40 974+50	29+75 974+20	RT "	350 300			648.7	99.6
5 6	F I-15	23+75 974+50	32+48 974+20	RT "	320	273		478.4	70.6
6 7	F LT-15	32+48 974+20	35+35 980+20	RT "	67 280			269.9	30.0
7 8	F LT-15	33+35 980+20	36+08 980+20	RT "	260 300			350.3	40.4
8 9	" I-15	36+08 983+20	38+48 986+20	RT "	240 300			400.0	48.7
9 10	" I-15	38+48 986+20	41+46 989+20	RT "	300			427.0	53.2
10 11	" I-15	44+46 989+20	44+53 992+20	RT "	300			347.2	39.9
11 12	" I-15	44+53 992+20	48+26 995+05	RT "	370 220			325.9	30.7
12 13	F I-15	48+26 995+05	50+80 997+30	RT LT	250 285			381.4	40.0
13 14	F I-15	50+80 997+30	53+14 1000+30	RT "	230 290			411.8	44.6
14 15	F I-15	53+14 1000+30	55+67 1003+45	RT "	250 265			368.7	39.7
15 16	F I-15	55+67 1003+45	58+10 1006+05	RT "	240 265			380.6	41.7
16 17	I-15	58+10 1006+05	61+14 1008+10	RT "	260 264			386.9	42.6
17 18	I-15	61+14 1008+10	68+98 1017+65	RT "	280 300			364.8	36.0
18 19	I-15	68+98 1017+65	71+05 1014+05	RT "	300 314			436.6	46.7
19 20	I-15	71+05 1014+05	75+50 1020+10	RT "	320 375			525.9	61.6
20 21	I-15	75+50 1020+10	76+04 1021+20	RT "	320			477.6	53.1
21 22	I-15	76+04 1021+20	80+44 1024+25	RT "	255 300			435.3	47.1
22 23	I-15	80+44 1024+25	83+90 1027+25	RT "	430 300			408.3	43.2
23 24	I-15	83+90 1027+25	85+00 1030+25	RT "	300 300			383.2	39.0
24 25	I-15	85+00 1030+25	OUTFALL 1031+95	RT	418 720			195.5	18.5
25 End	I-15	1031+95	OUTFALL	RT	350			195.5	3.6
1	F-LINE	16190	PIPE IN PLACE	LT	32				
				* Total	1370	1450	4320	9593.1	1114.8
				TOTAL USED	1391	1450	4245	8602.7	


SMALL STRUCTURES SUMMARY NO.2

LANE OR LINE	STATION	BOX NO.	CONCRETE		STRUCTURES	STRUCT.	MECH.	STRUCT.	REINF.	CONC.	RIPRAP
			DWG. NO.	LINE NO.		EXC.	TAMP.	STEEL	STEEL	CLASS "A"	
						CUBIC YARD	HOURS	LBS	LBS	CUBIC YARD	CUBIC YARD
"F" LINE 16	16790 964+00	1	V-750	76	Catch Basin	8.2	1.37	310	265	1.9	
" I-15	20481 964+80	2	V-750	18	" "	19.9	3.32	310	510	5.4	
" I-15	55175 968+20	3	V-750	57	" "	9.7	1.62	310	305	2.2	
" I-15	76140 971+50	4	V-750	24	" "	24.8	4.13	310	629	6.6	
" I-15	29175 974+50	5	V-750	24	" "	24.8	4.13	310	629	6.6	
" I-15	32148 977+20	6	V-754	5	" "	11.5	1.92	310	280	2.7	
" I-15	34175 980+20	7	V-754	46	" "	12.3	2.05	310	287	2.9	
" I-15	36108 983+20	8	V-754	56	" "	12.3	2.05	310	287	2.9	
" I-15	38142 986+20	9	V-754	10	" "	15.6	2.60	310	362	3.7	
" I-15	40175 989+20	10	V-754	48	" "	14.0	2.33	305	325	3.3	
" I-15	44155 992+20	11	V-755	1	" "	12.4	2.07	305	271	2.6	
" I-15	48126 995+05	12	V-755	42	" "	13.3	2.22	305	301	2.9	
" I-15	50180 997+90	13	V-755	35	" "	16.2	2.70	305	358	3.5	
" I-15	53114 1000+80	14	V-755	34	" "	15.2	2.53	305	350	3.3	
" I-15	55189 1003+65	15	V-755	35	" "	16.2	2.70	305	358	3.5	
" I-15	58110 1006+05	16	V-755	35	" "	16.2	2.70	305	358	3.5	
" I-15	61114 1008+20	17	V-755	35	" "	16.2	2.70	305	358	3.5	
" I-15	63128 1011+85	18	V-755	41	" "	12.4	2.07	305	271	2.6	
" I-15	67103 1014+65	19	V-755	18	" "	19.0	3.17	305	433	4.2	
" I-15	70127 1016+00	20	V-755	5	" "	16.2	2.70	305	358	3.5	
" I-15	73136 1021+20	21	V-755	5	" "	16.2	2.70	305	358	3.5	
" I-15	75125 1023+25	22	V-755	4	" "	15.2	2.53	305	350	3.3	
" I-15	80144 1027+25	23	V-755	4	" "	15.2	2.53	305	350	3.3	
" I-15	83140 1030+25	24	V-755	42	" "	13.3	2.22	305	301	2.9	
" I-15	1031+95	25	V-755	2	" "	13.3	2.22	305	301	2.9	
	Outfall										9.3
					* Total	379.6	63.28	7675	8955	87.2	9.3
						292		7370	6914	64.5	7.5

* Note: For Use totals see Small Structures and Drainage Summaries Composite.

Rev. Date 6/10/66 JTH

4-2+68' B

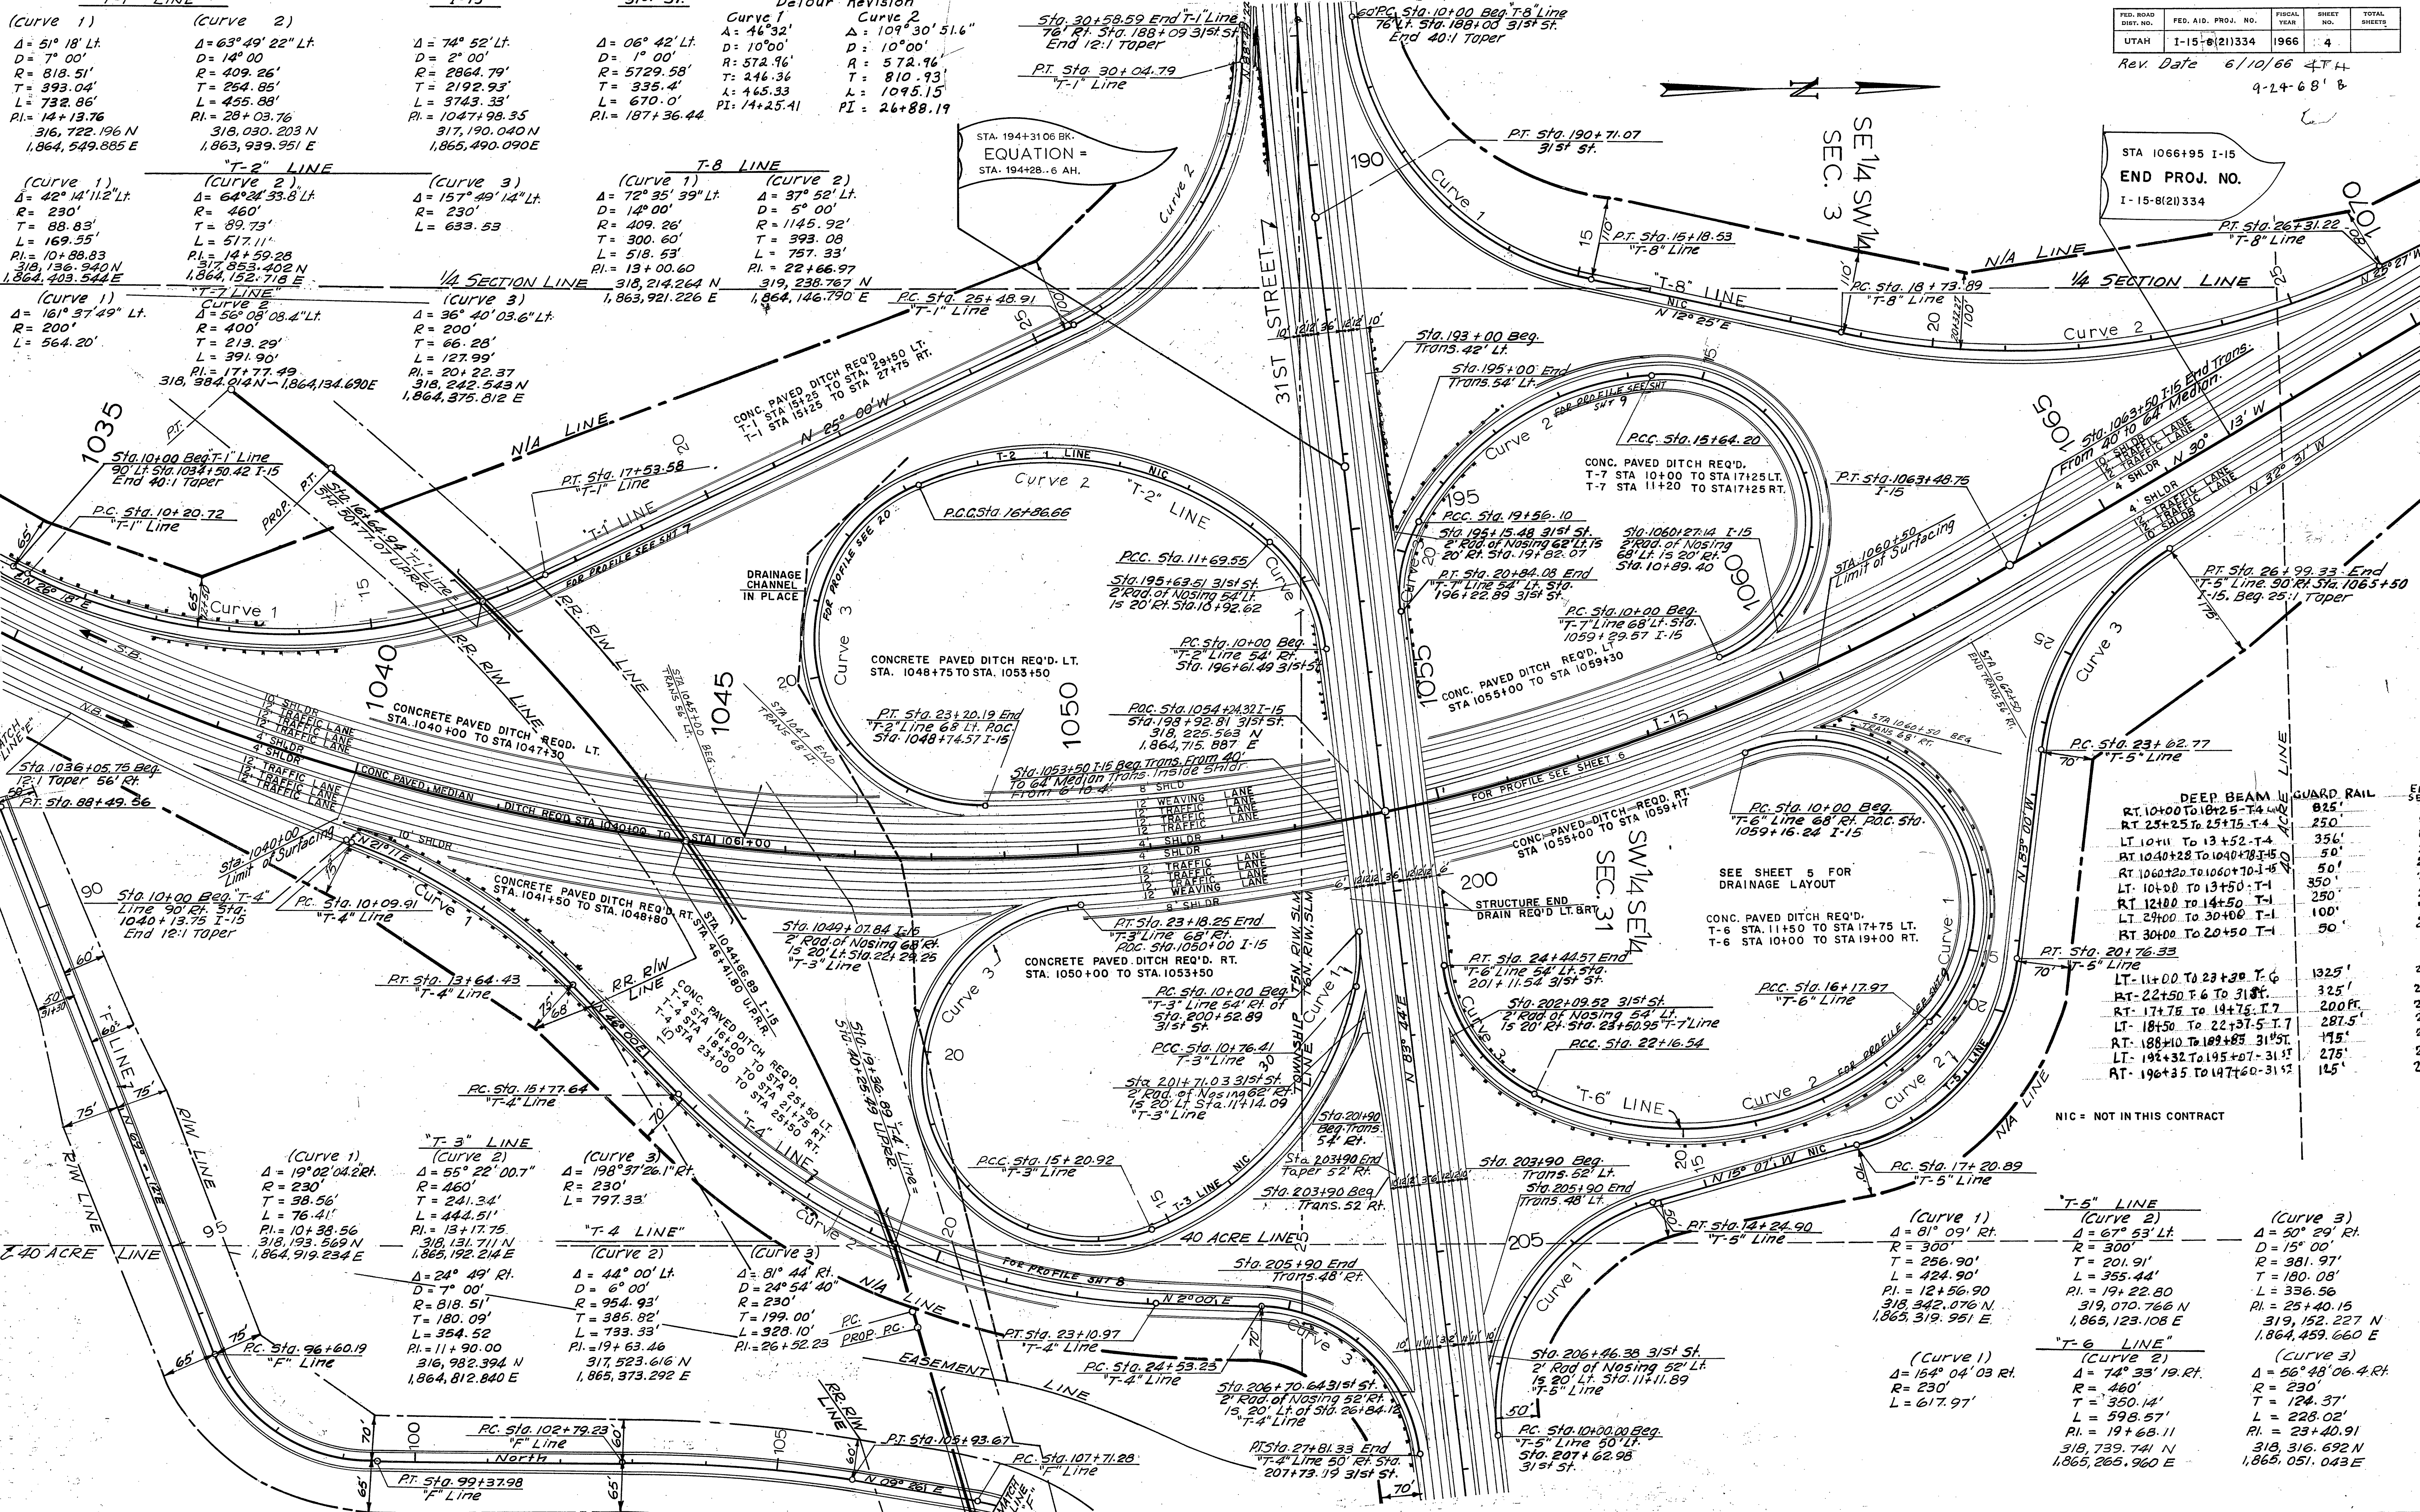


T-5 LINE		(Curve 1)		(Curve 2)		(Curve 3)	
Δ = 67° 53' Lt.		Δ = 50° 29' Rt.		Δ = 67° 53' Lt.		Δ = 50° 29' Rt.	
R = 300'		R = 300'		R = 300'		R = 300'	
T = 256.90'		T = 256.90'		T = 201.91'		T = 381.97'	
L = 424.90'		L = 355.44'		L = 180.08'		L = 180.08'	
PI = 12+56.90		PI = 19+22.80		PI = 19+22.80		PI = 25+40.15	
318,342.076 N		319,070.766 N		319,070.766 N		319,152.227 N	
1,865,319.951 E		1,865,123.108 E		1,865,123.108 E		1,864,459.660 E	
T-6 LINE		(Curve 1)		(Curve 2)		(Curve 3)	
Δ = 154° 04' 03 Rt.		Δ = 74° 33' 19 Rt.		Δ = 74° 33' 19 Rt.		Δ = 56° 48' 06.4 Rt.	
R = 230'		R = 460'		R = 460'		R = 230'	
T = 350.14'		T = 350.14'		T = 350.14'		T = 124.37'	
L = 598.57'		L = 598.57'		L = 598.57'		L = 228.02'	
PI = 19+68.11		PI = 19+68.11		PI = 19+68.11		PI = 23+40.91	
318,739.741 N		318,739.741 N		318,739.741 N		318,316.692 N	
1,865,265.960 E		1,865,265.960 E		1,865,265.960 E		1,865,051.043 E	



FED. ROAD DIST. NO.	STATE	PROJ. NO.	FISCAL YEAR	SHEET NO.	TOTAL SHEETS
UTAH	UTAH	I-15-8(21)334	1966	5	


REV. DATE 6/10/66

4711 e

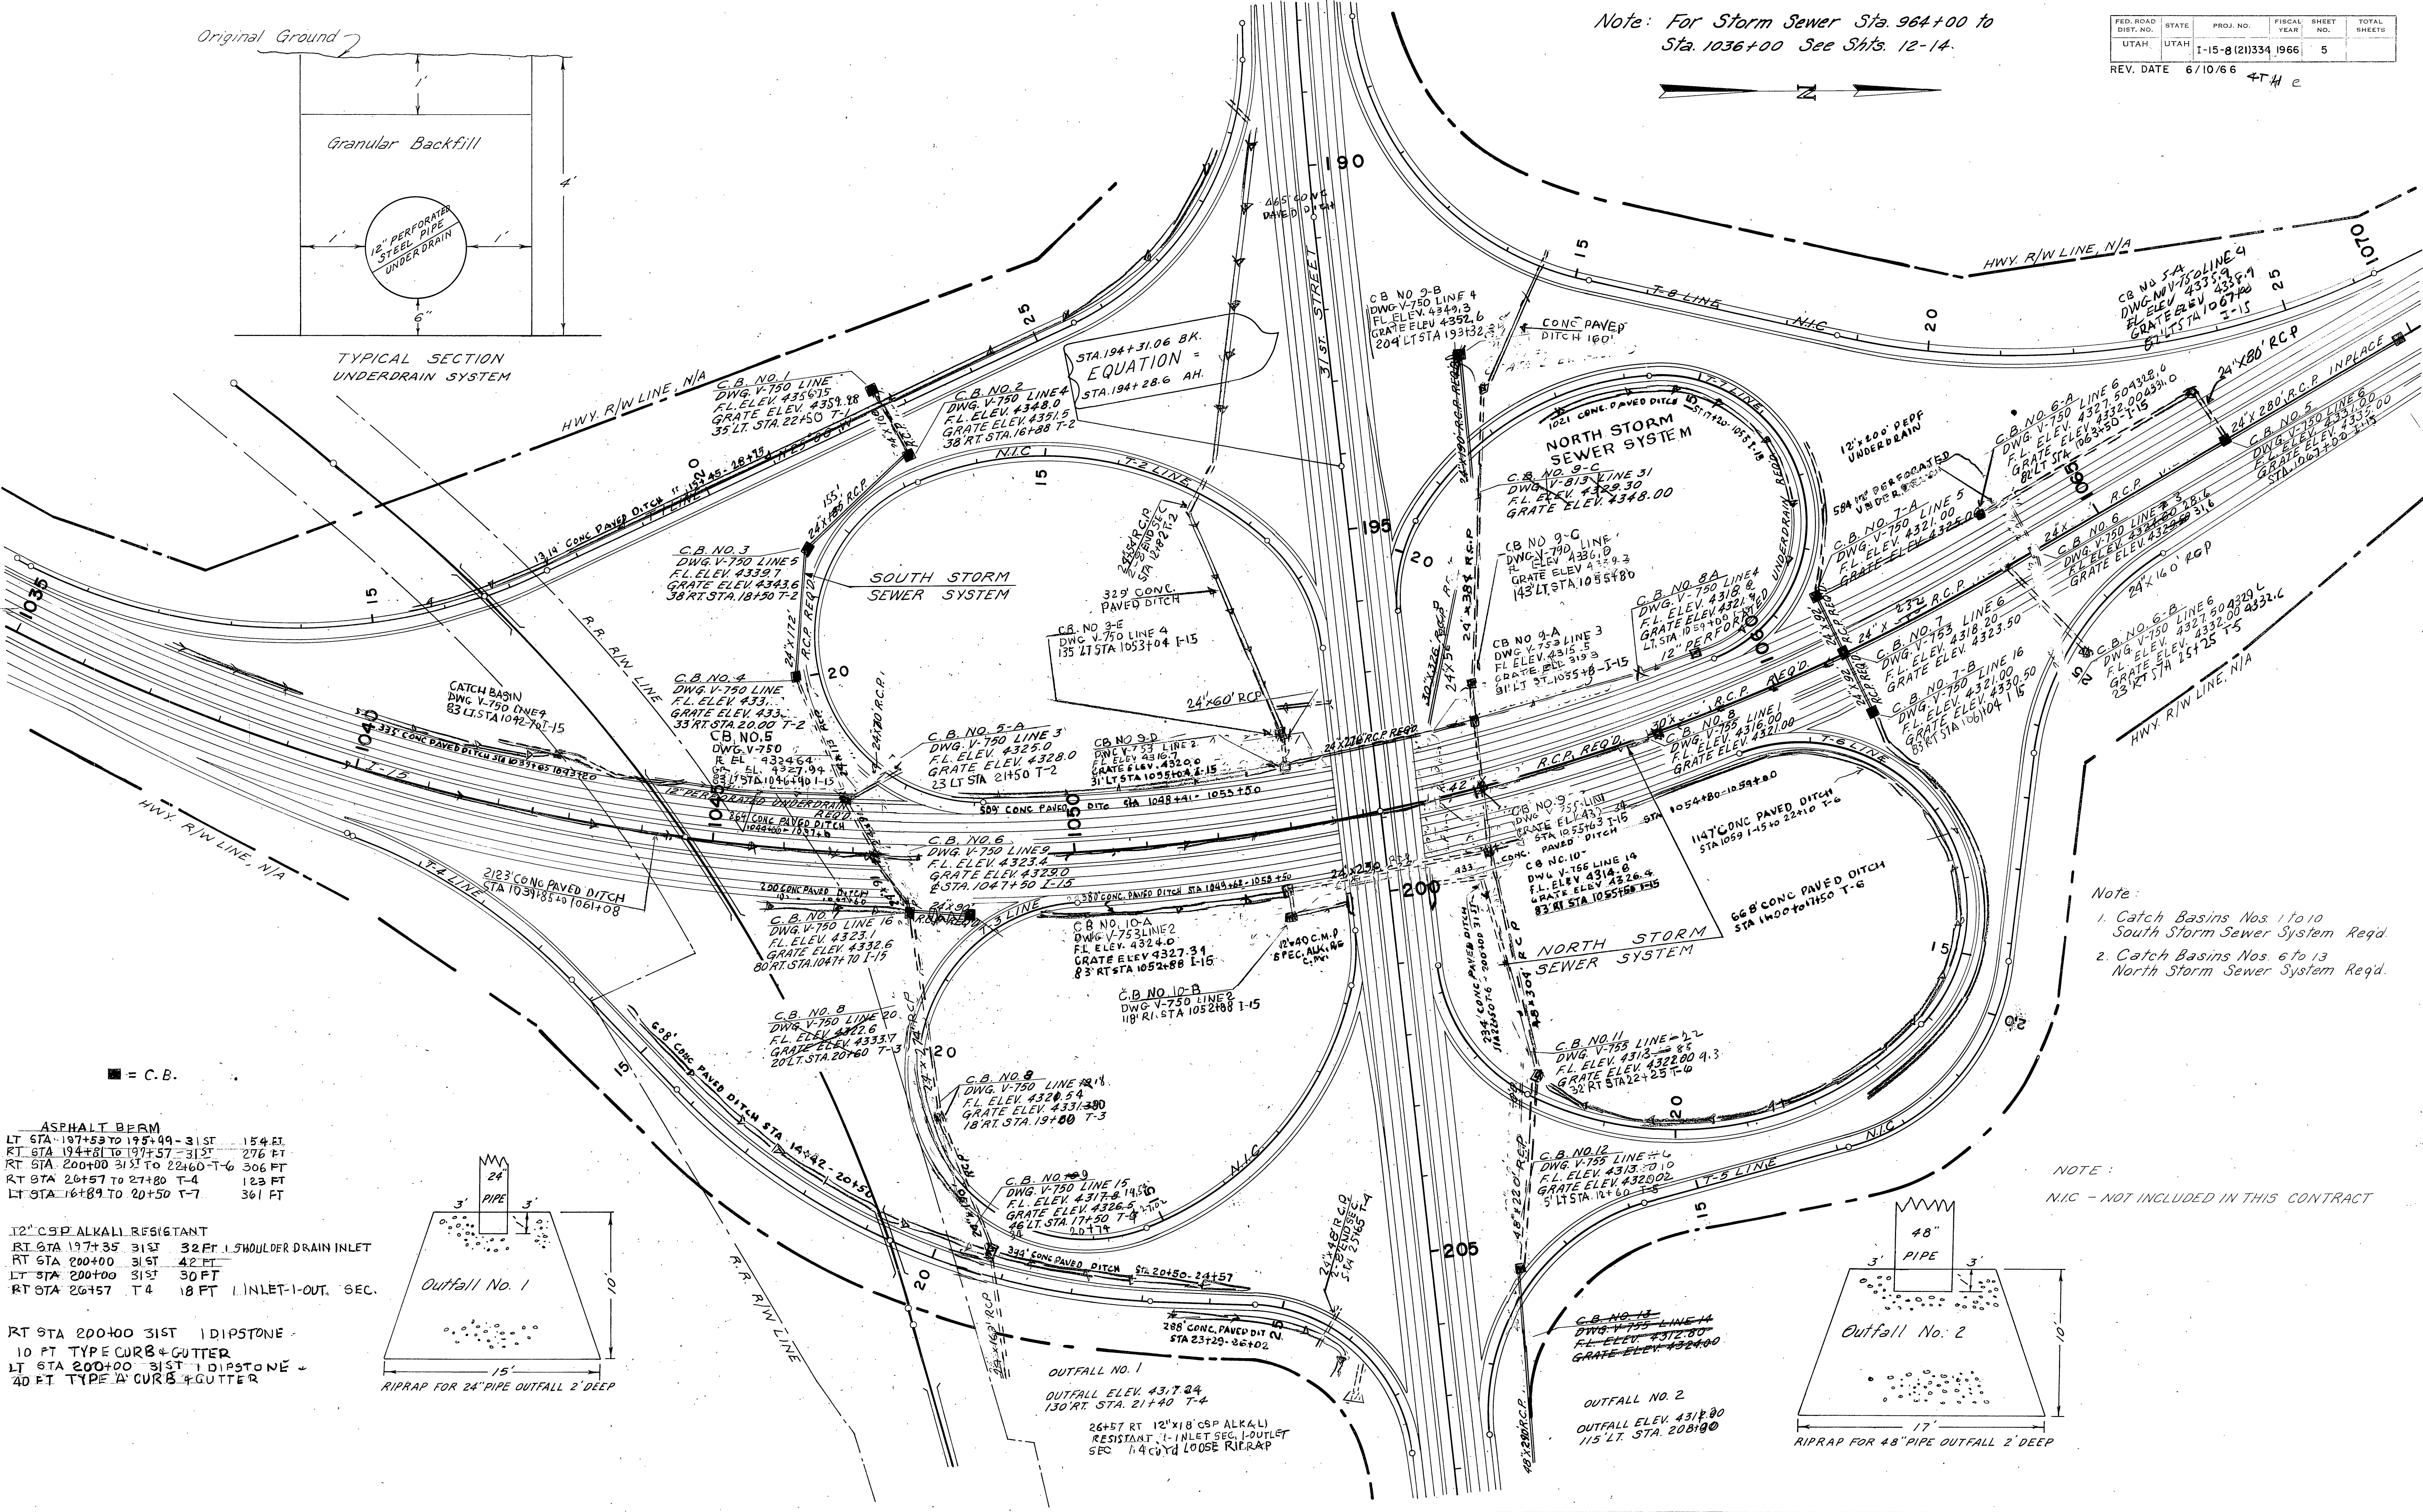

2TH C.

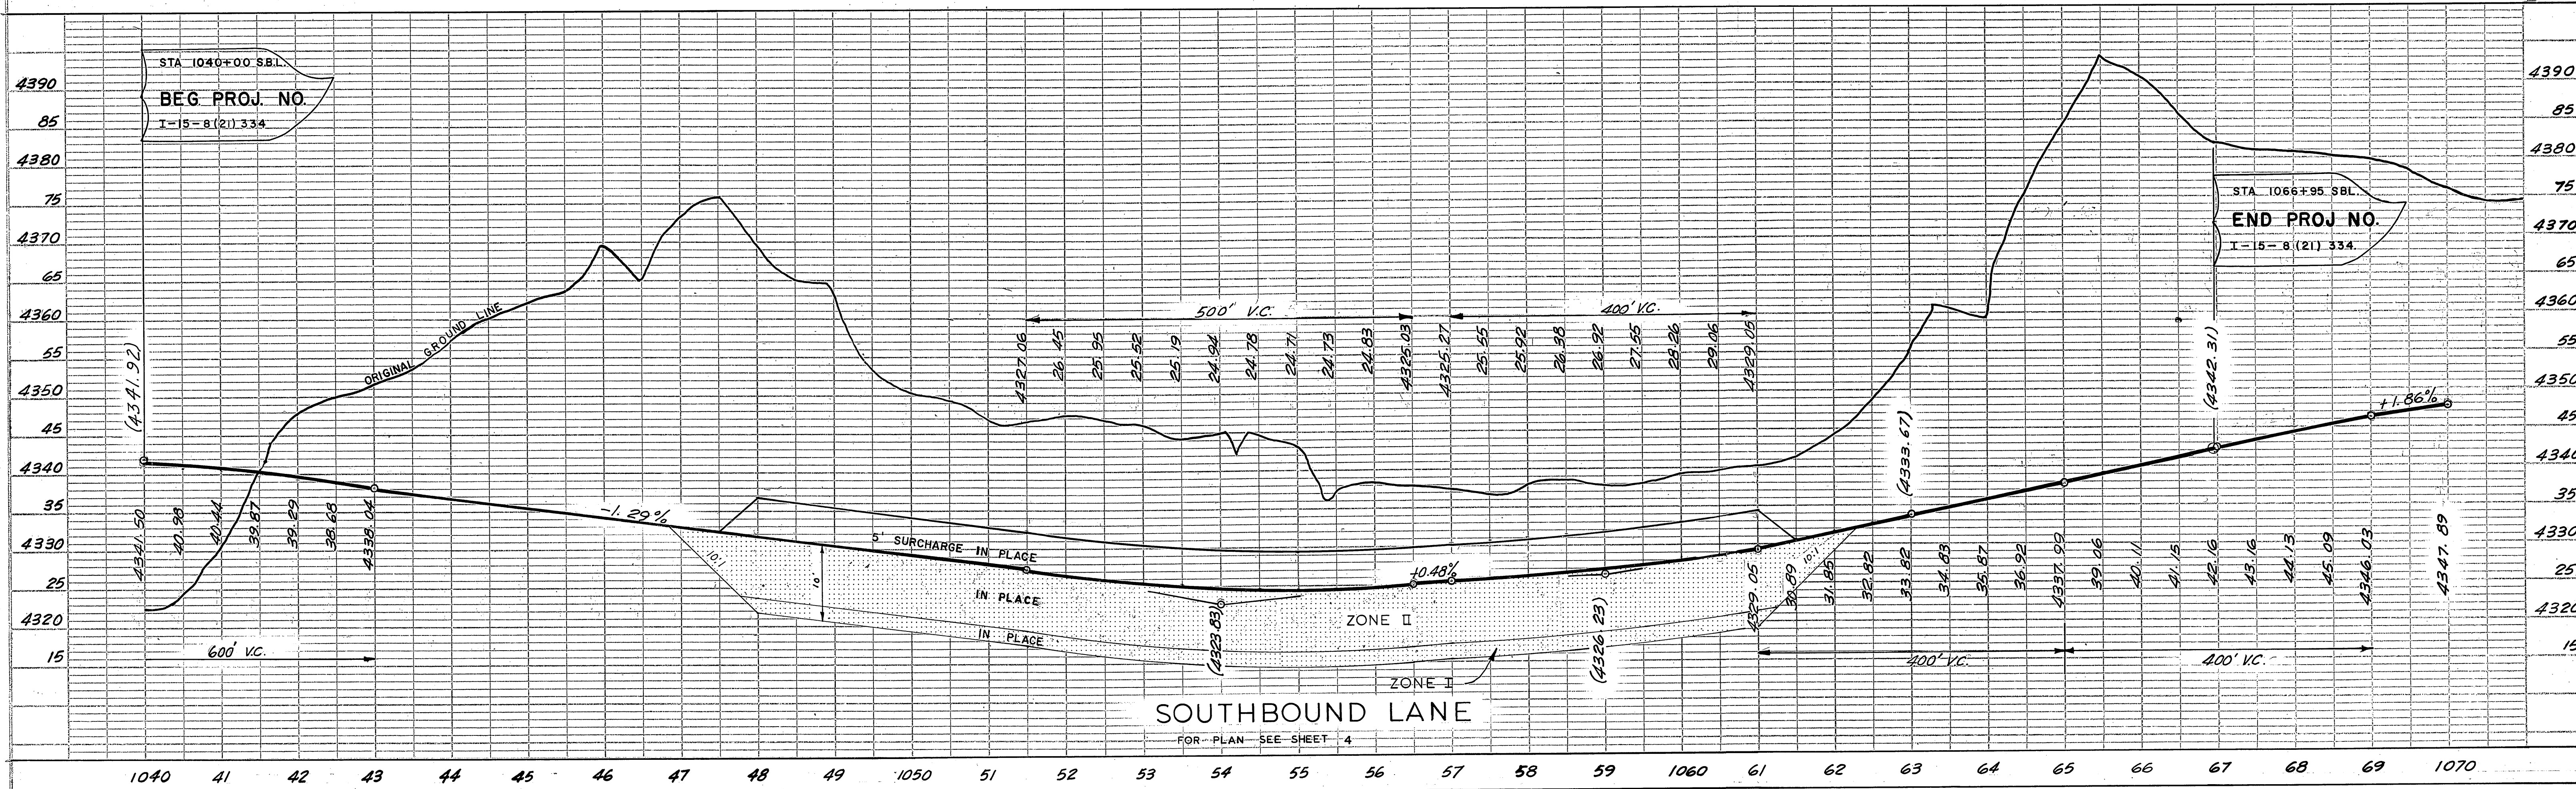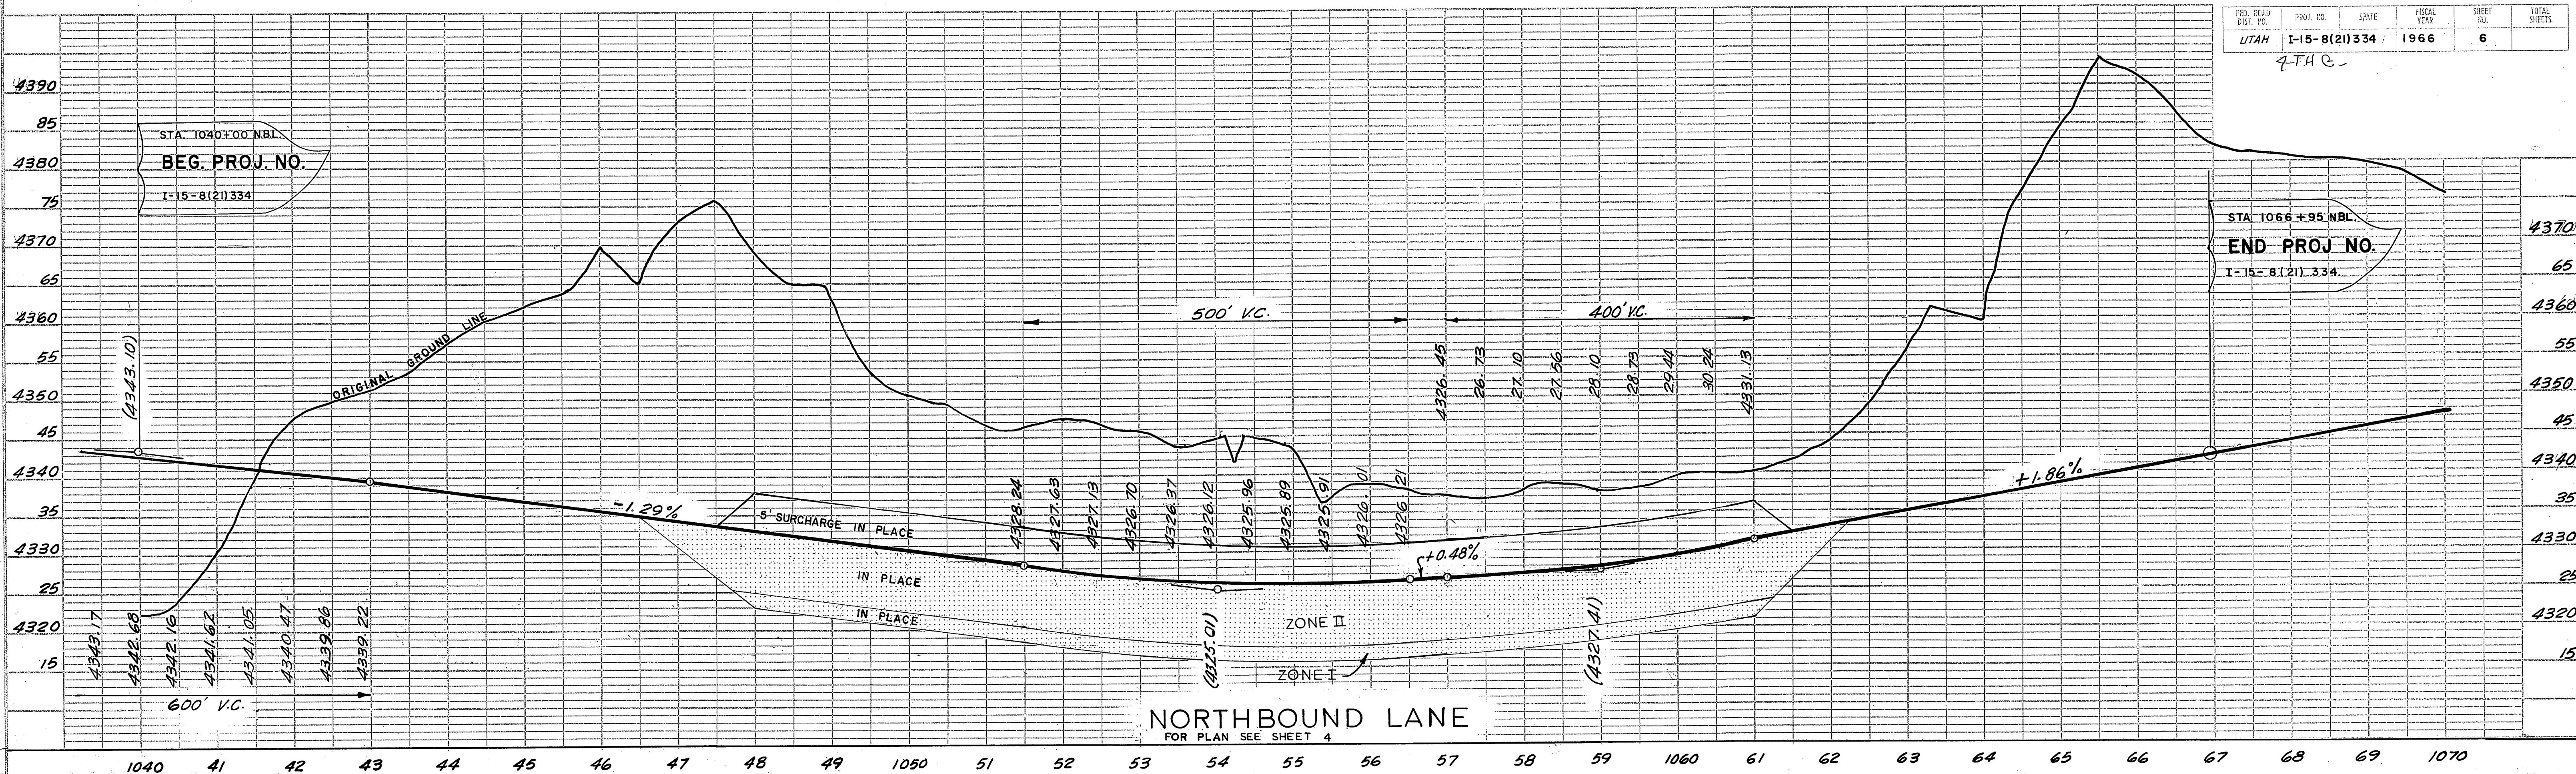

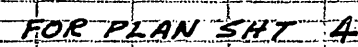

"T-1" LINE





"T-2" LINE




NOT IN CONTRACT

"T-3" LINE

REVISED 6-10-66
4TH C

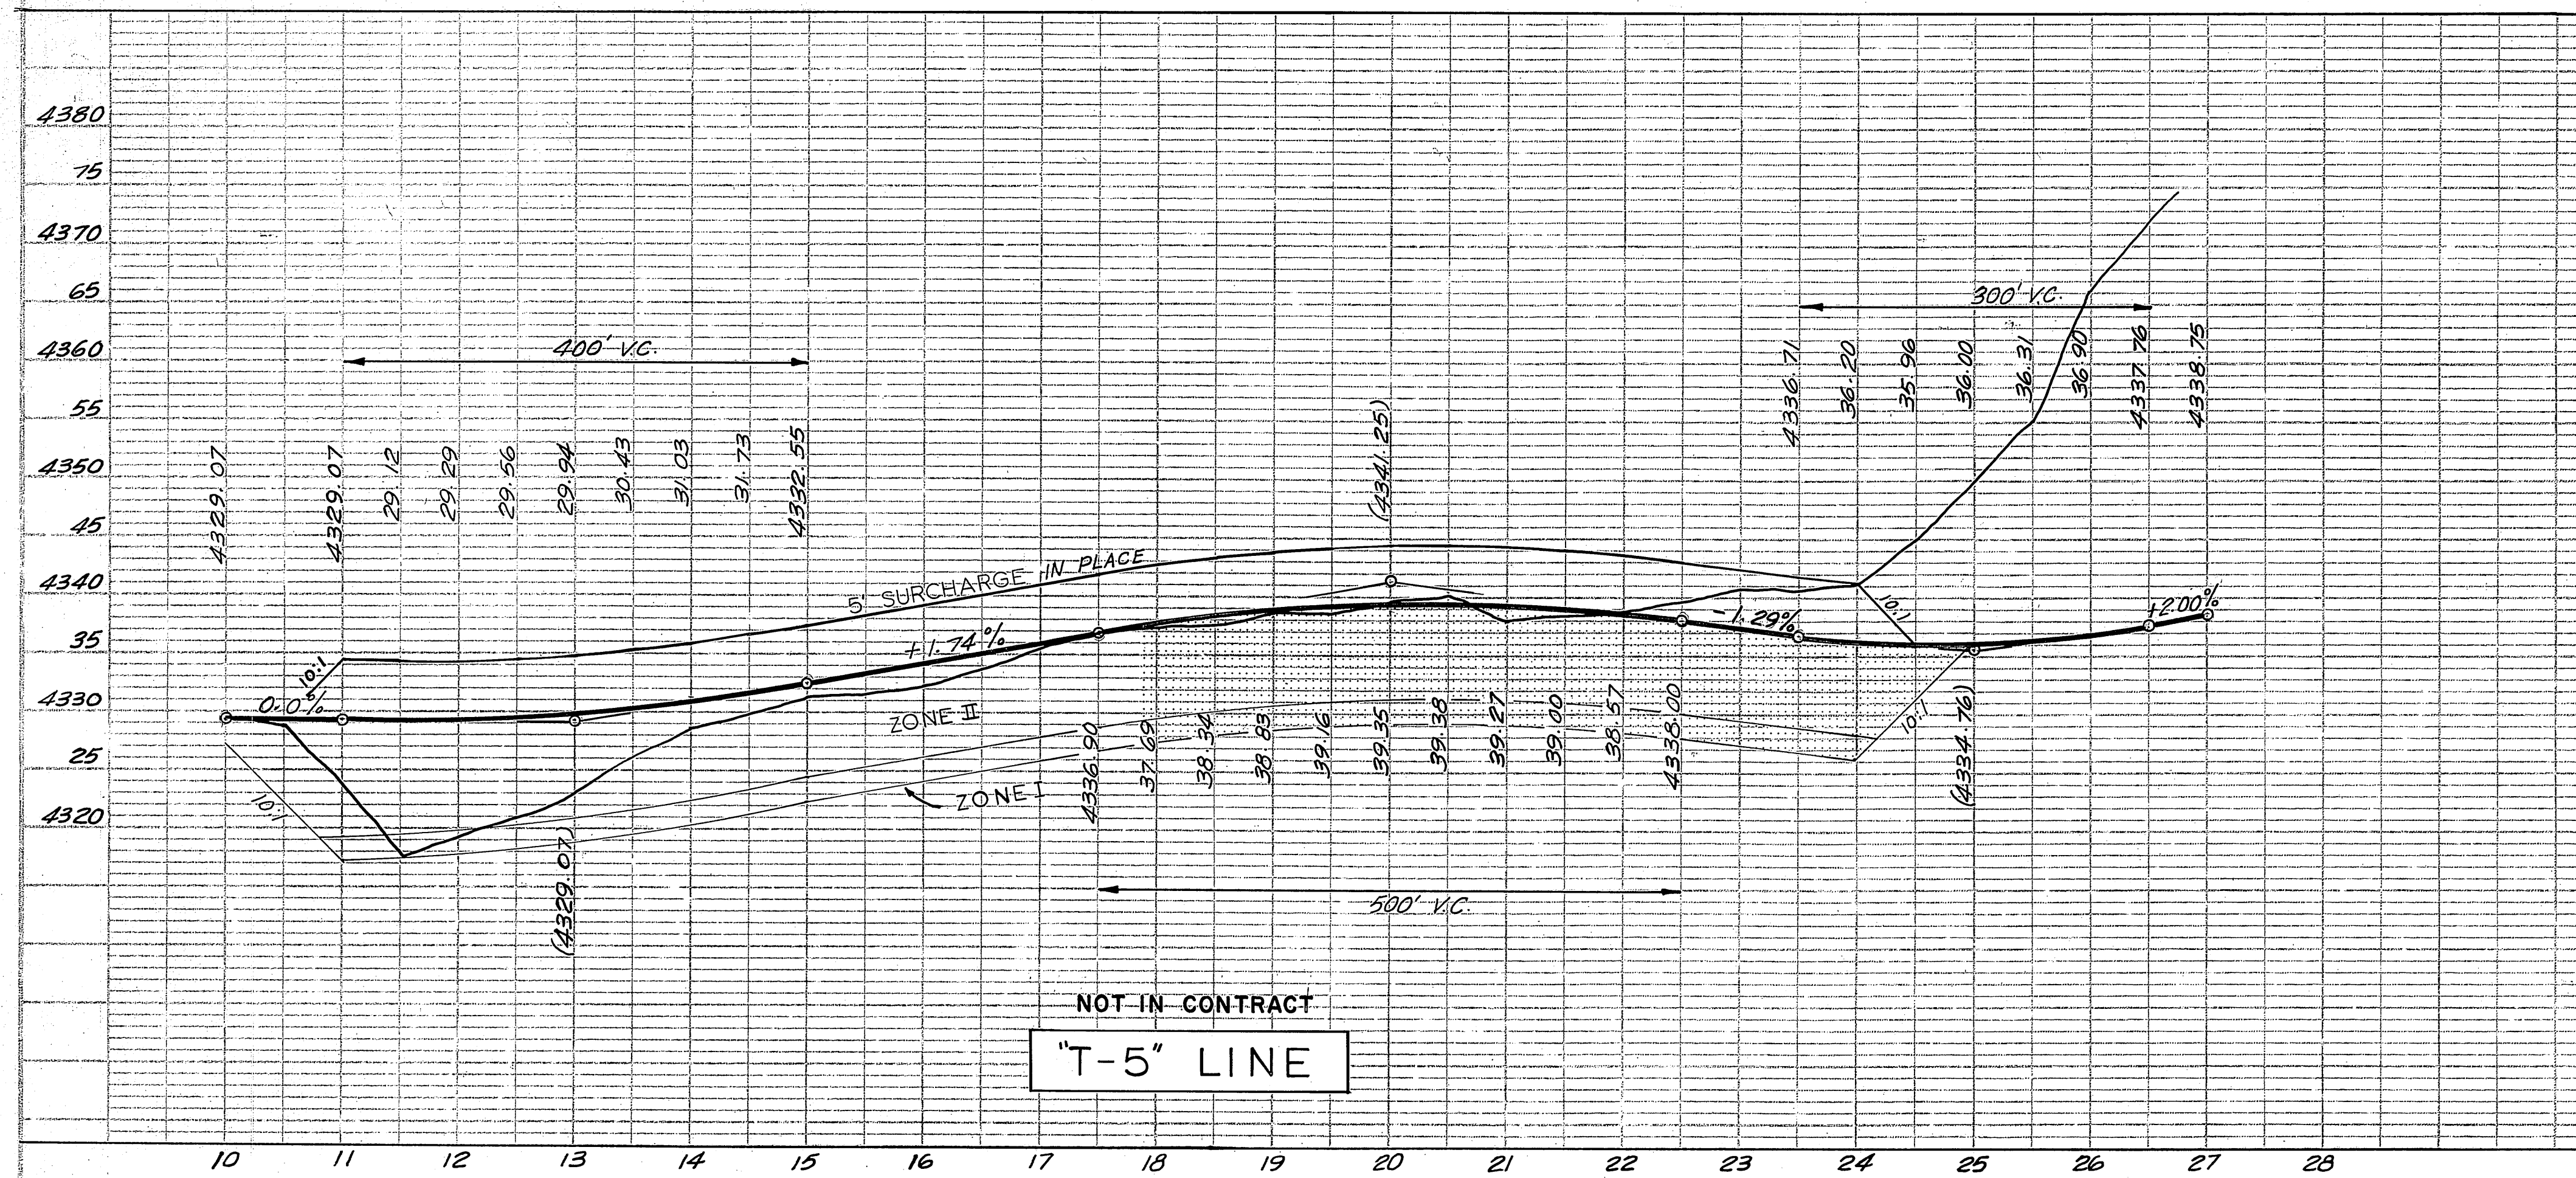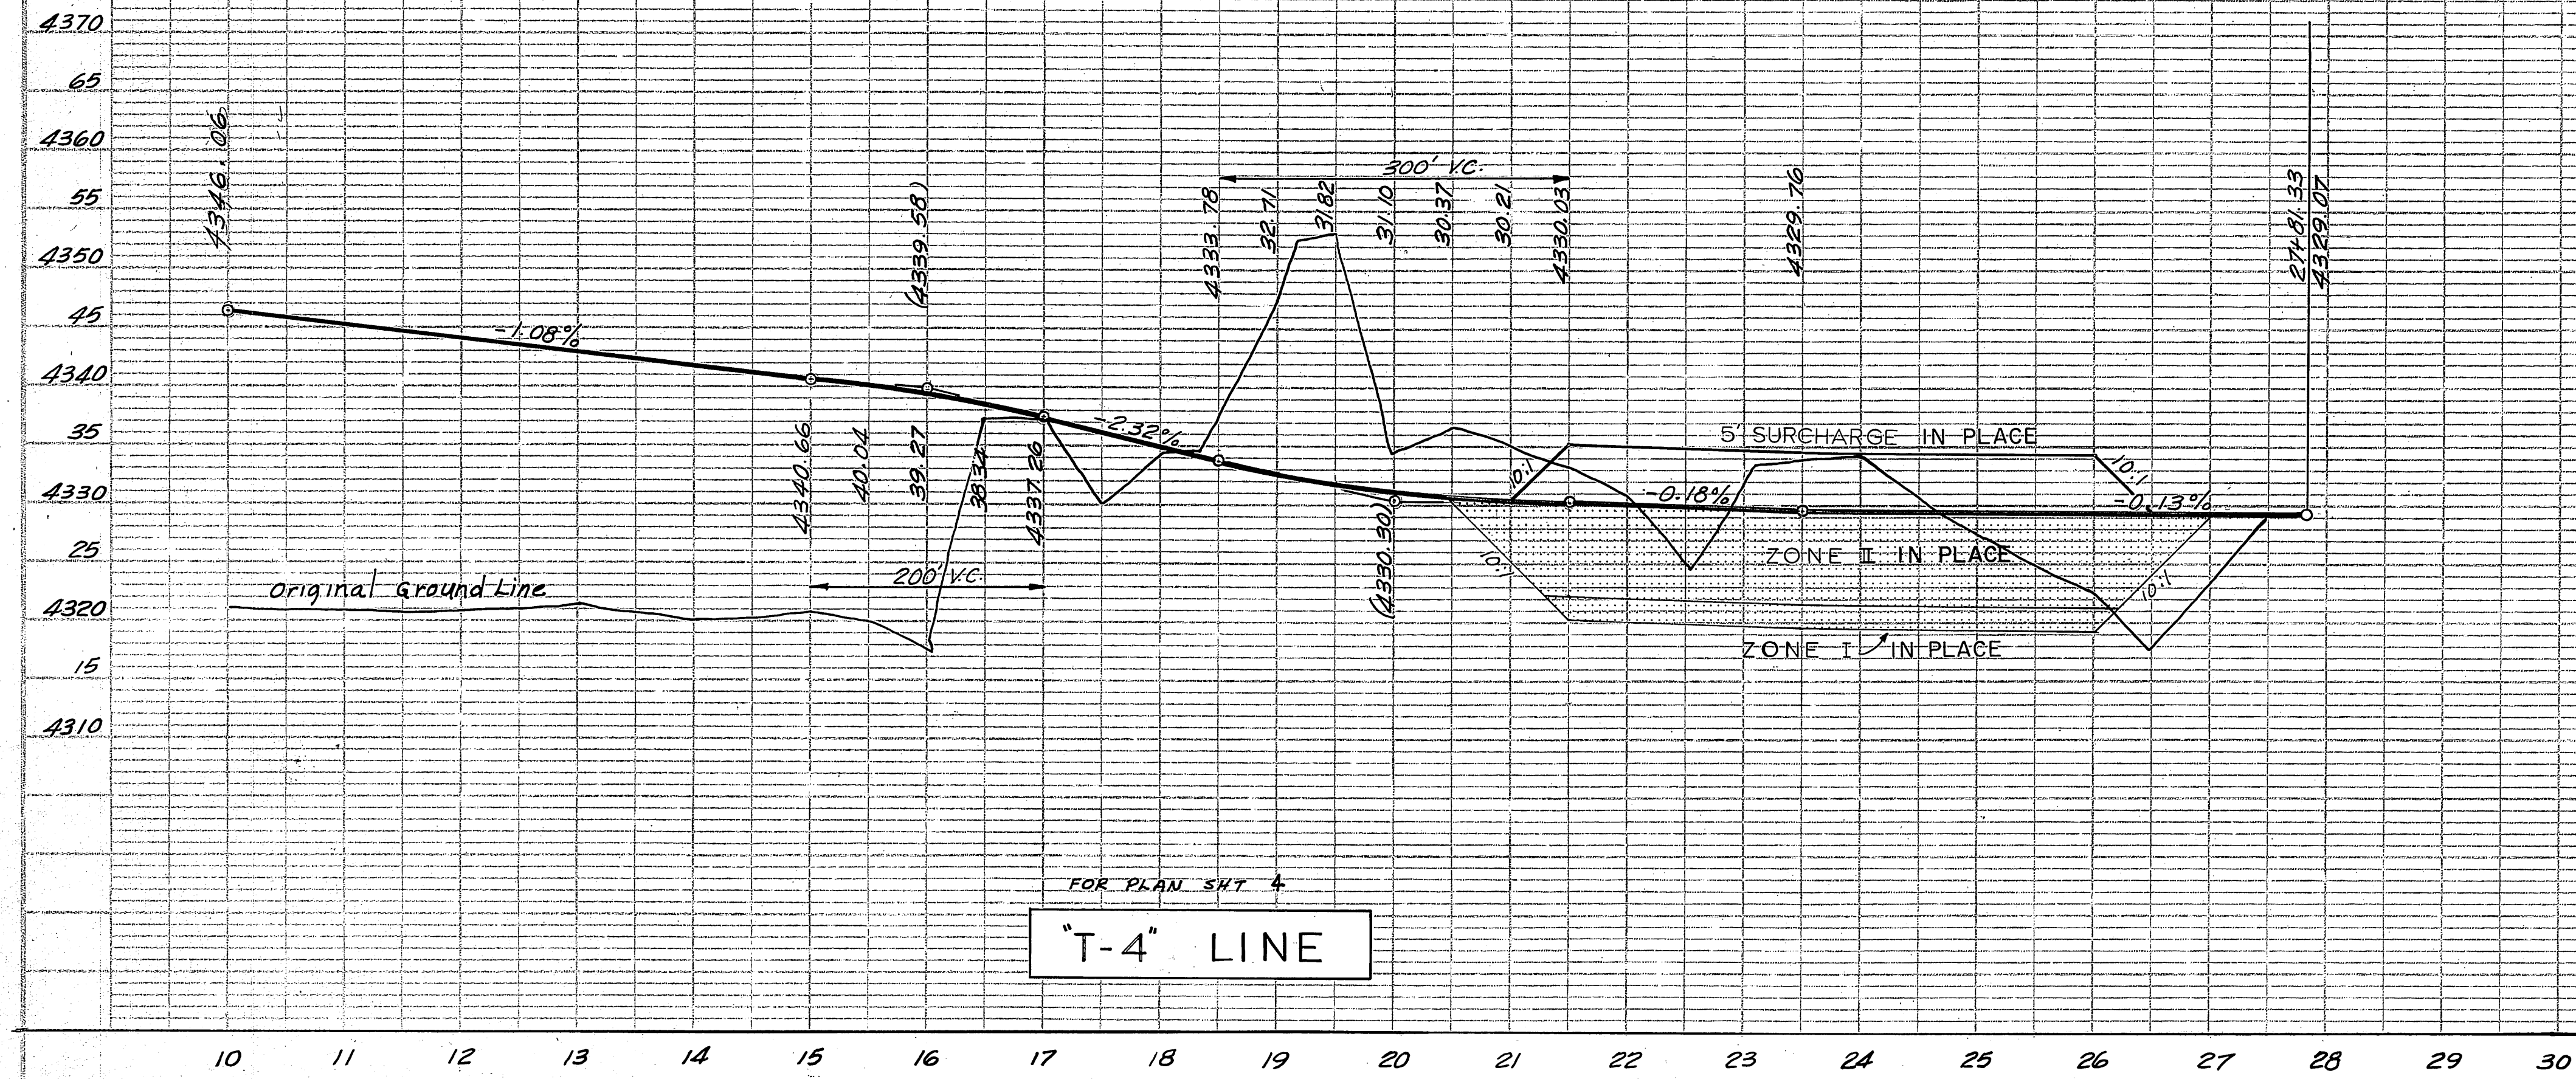


4THC

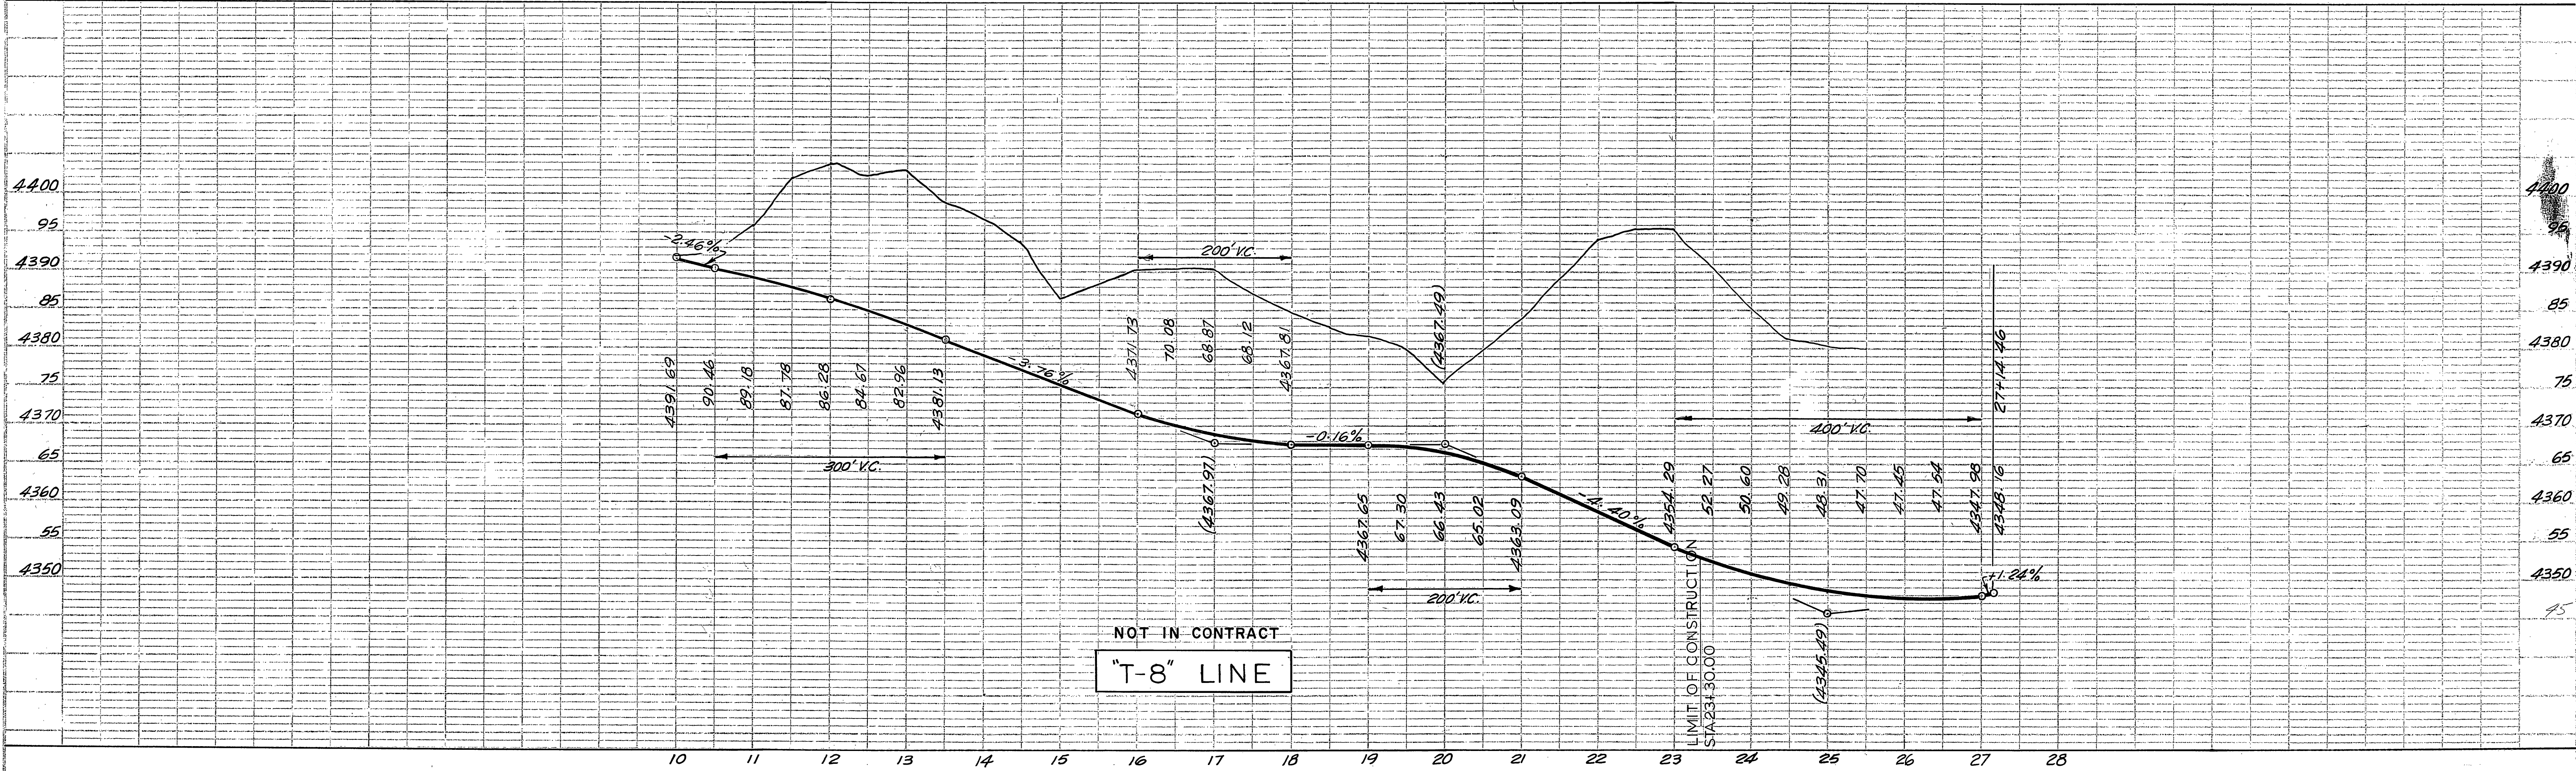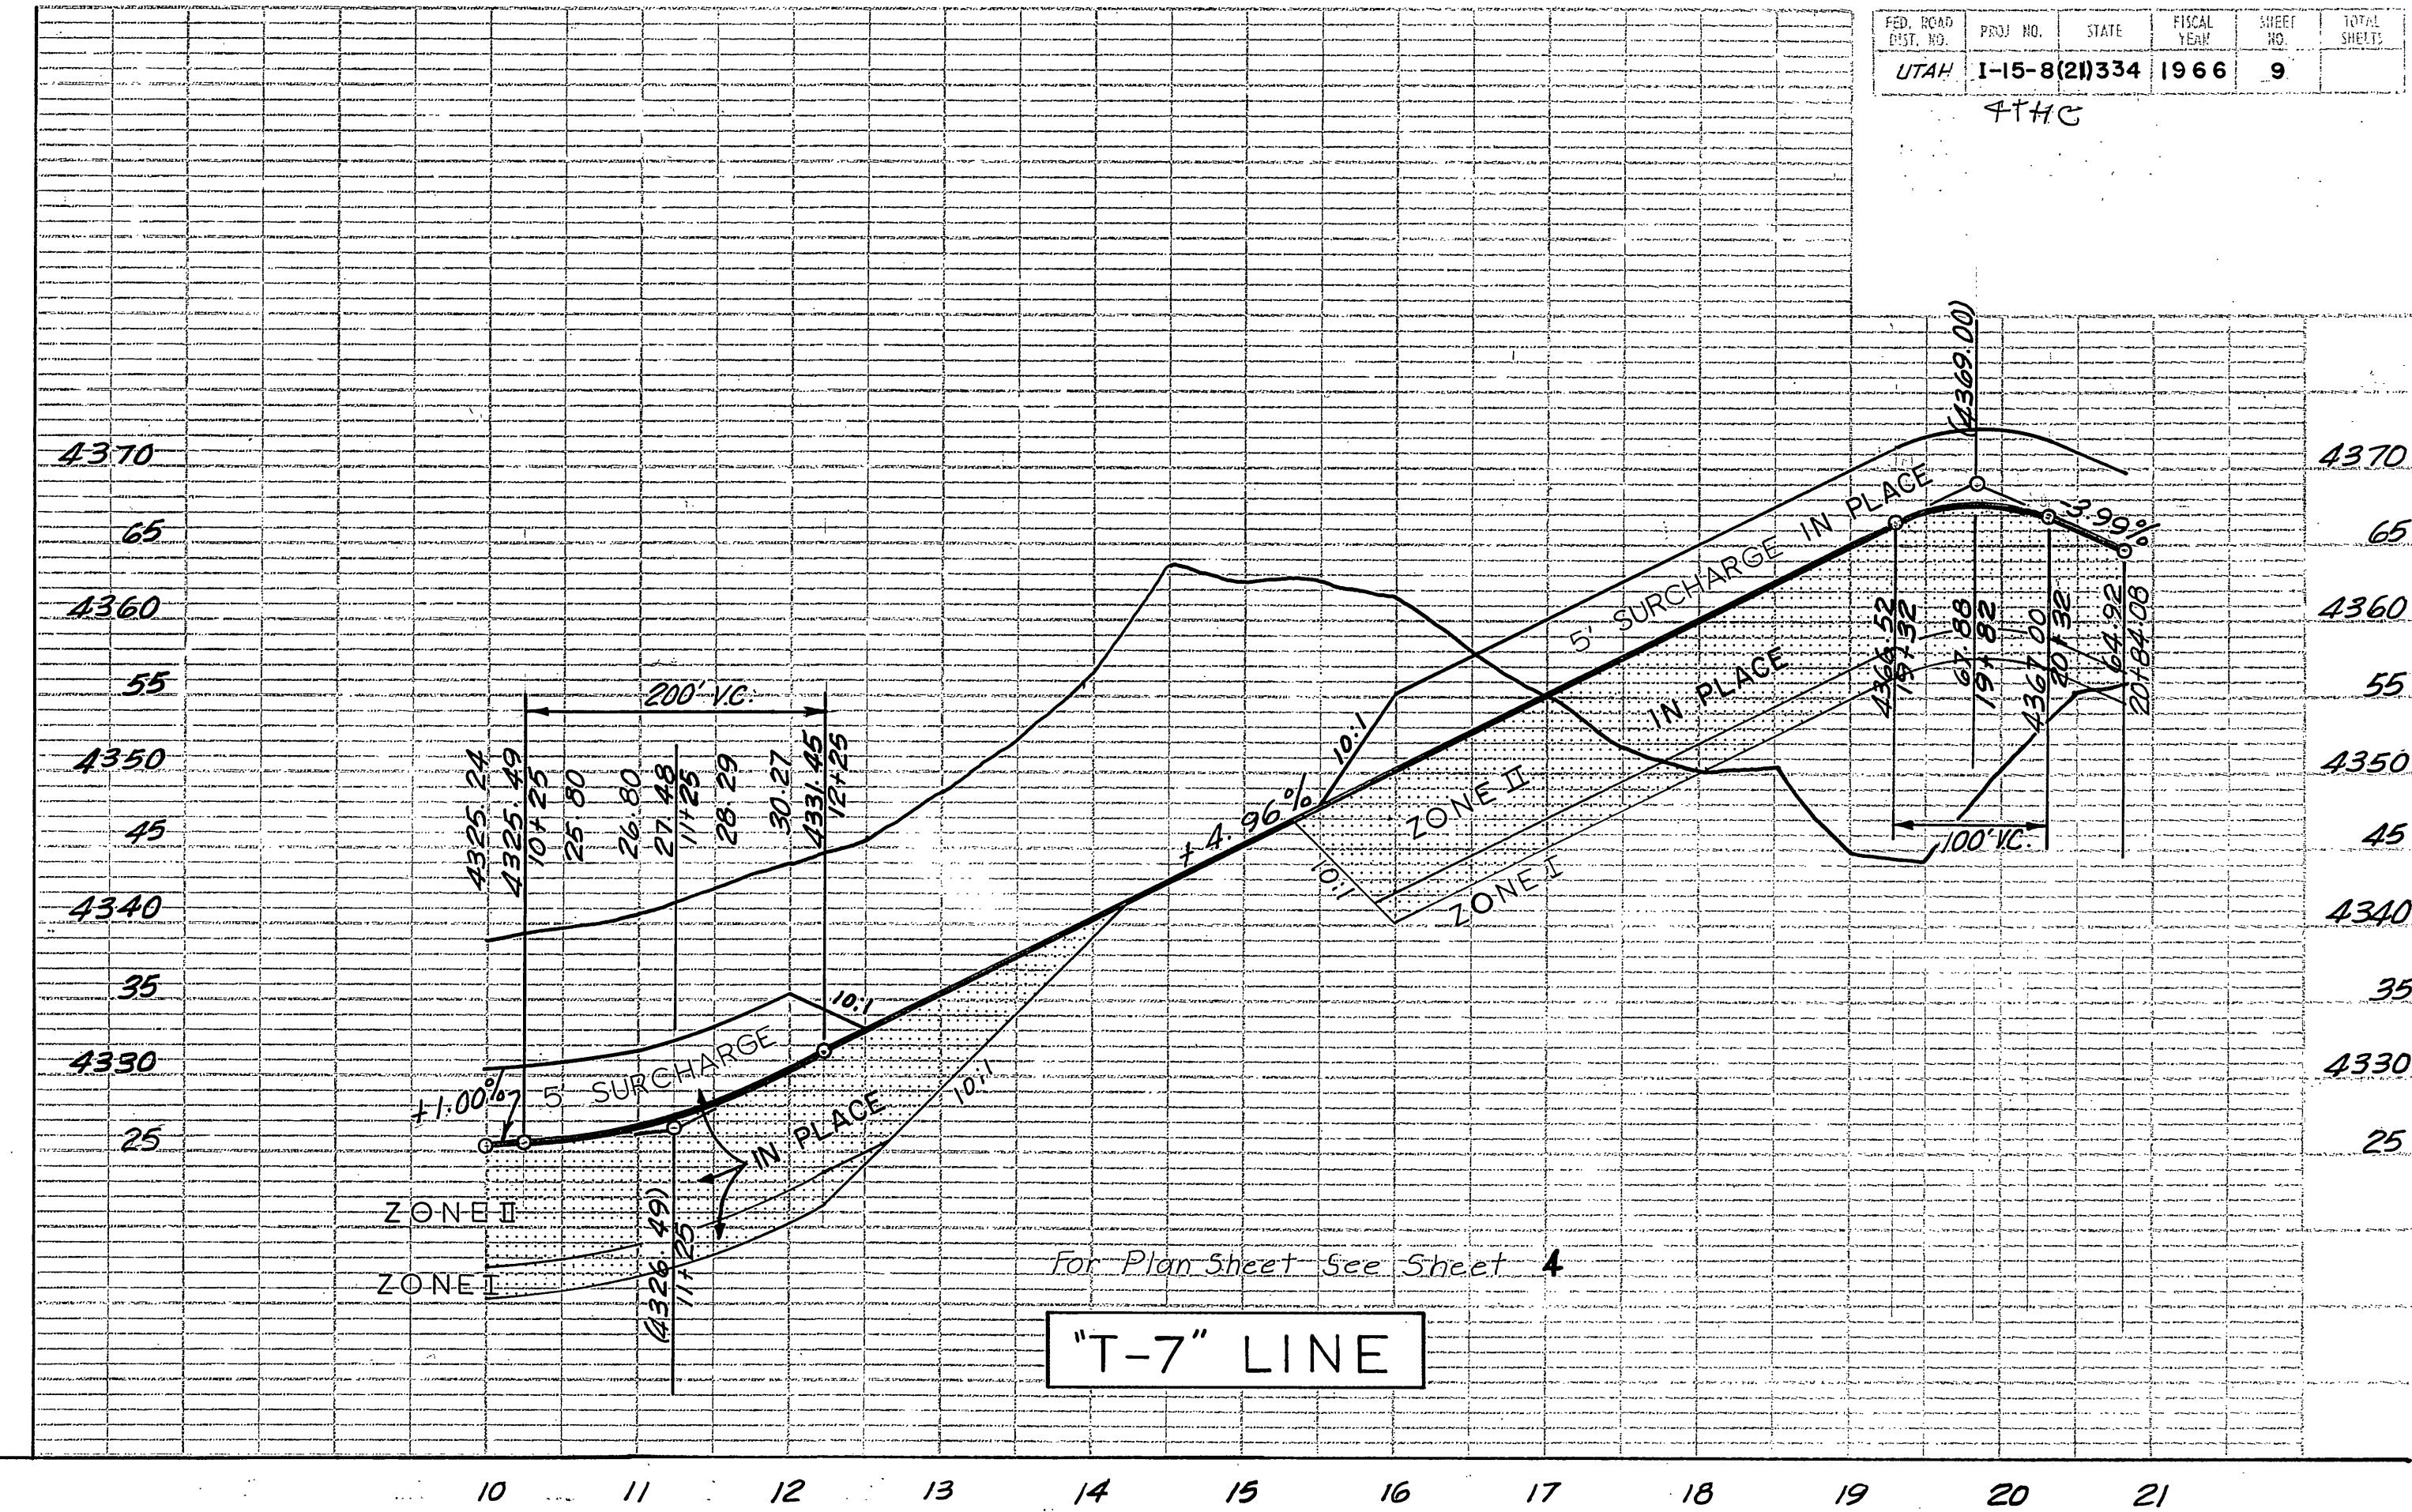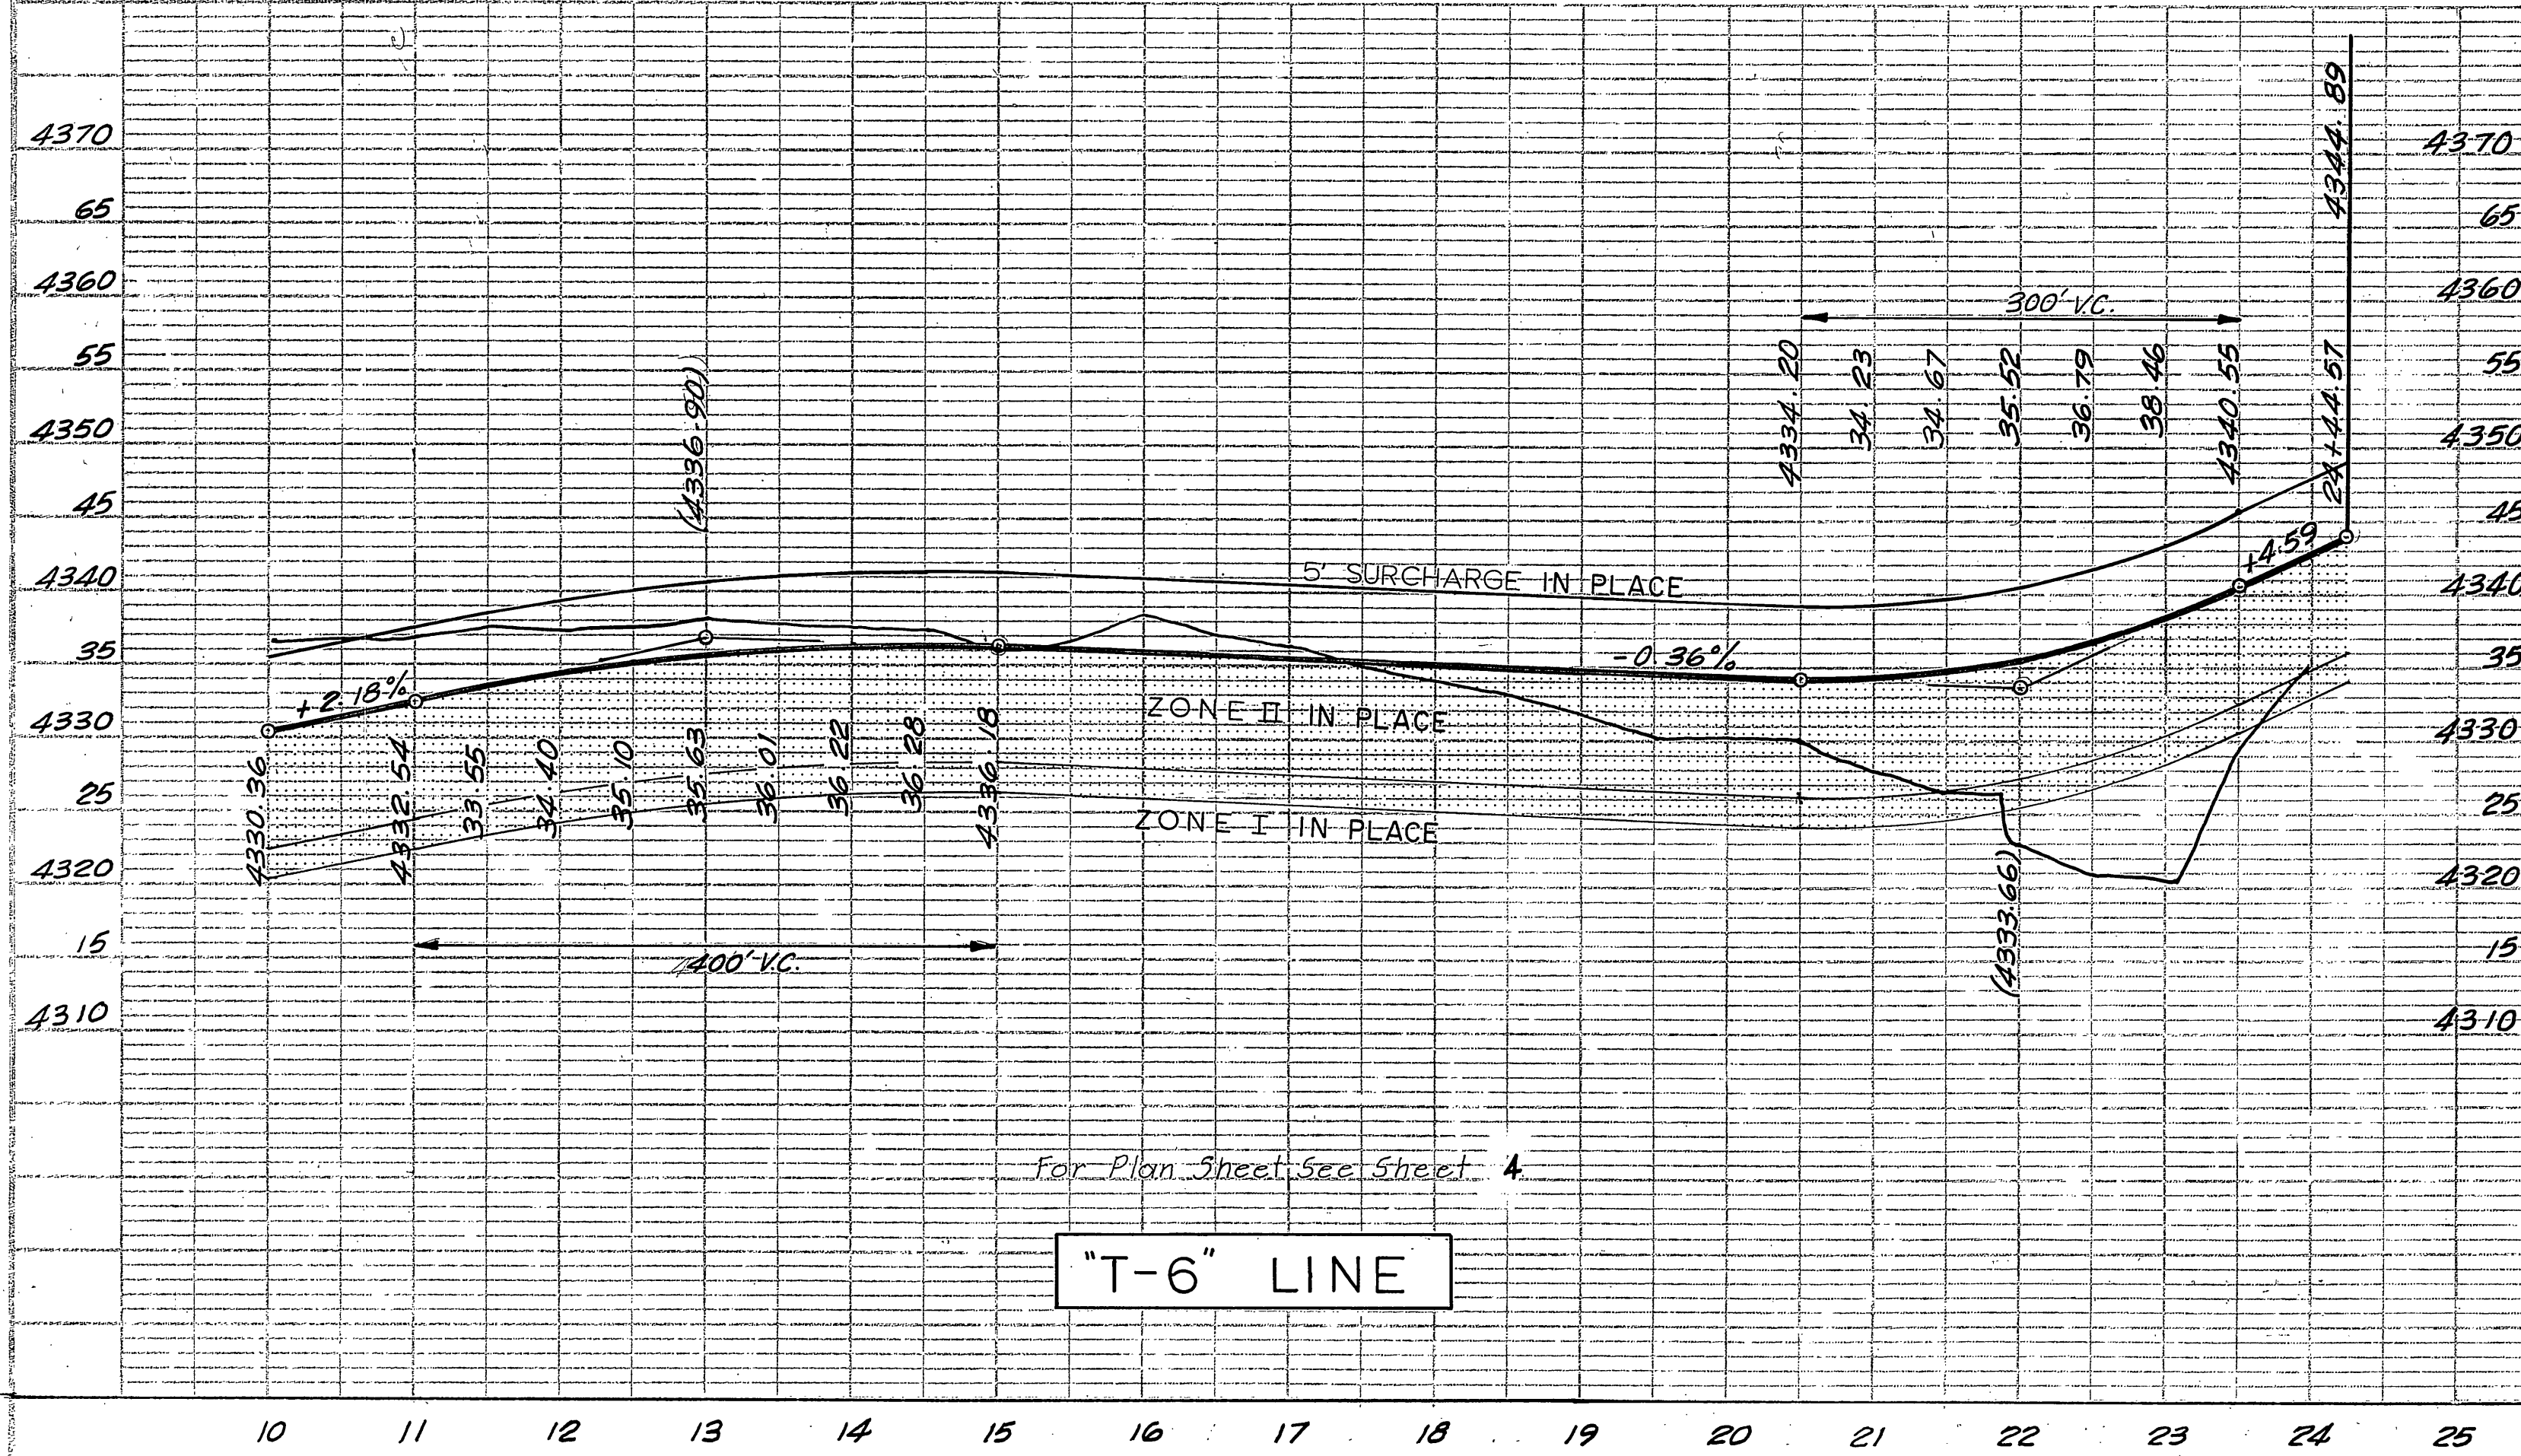


4TH

31ST STREET PROFILE

FOR PLAN SHEET NO. 4


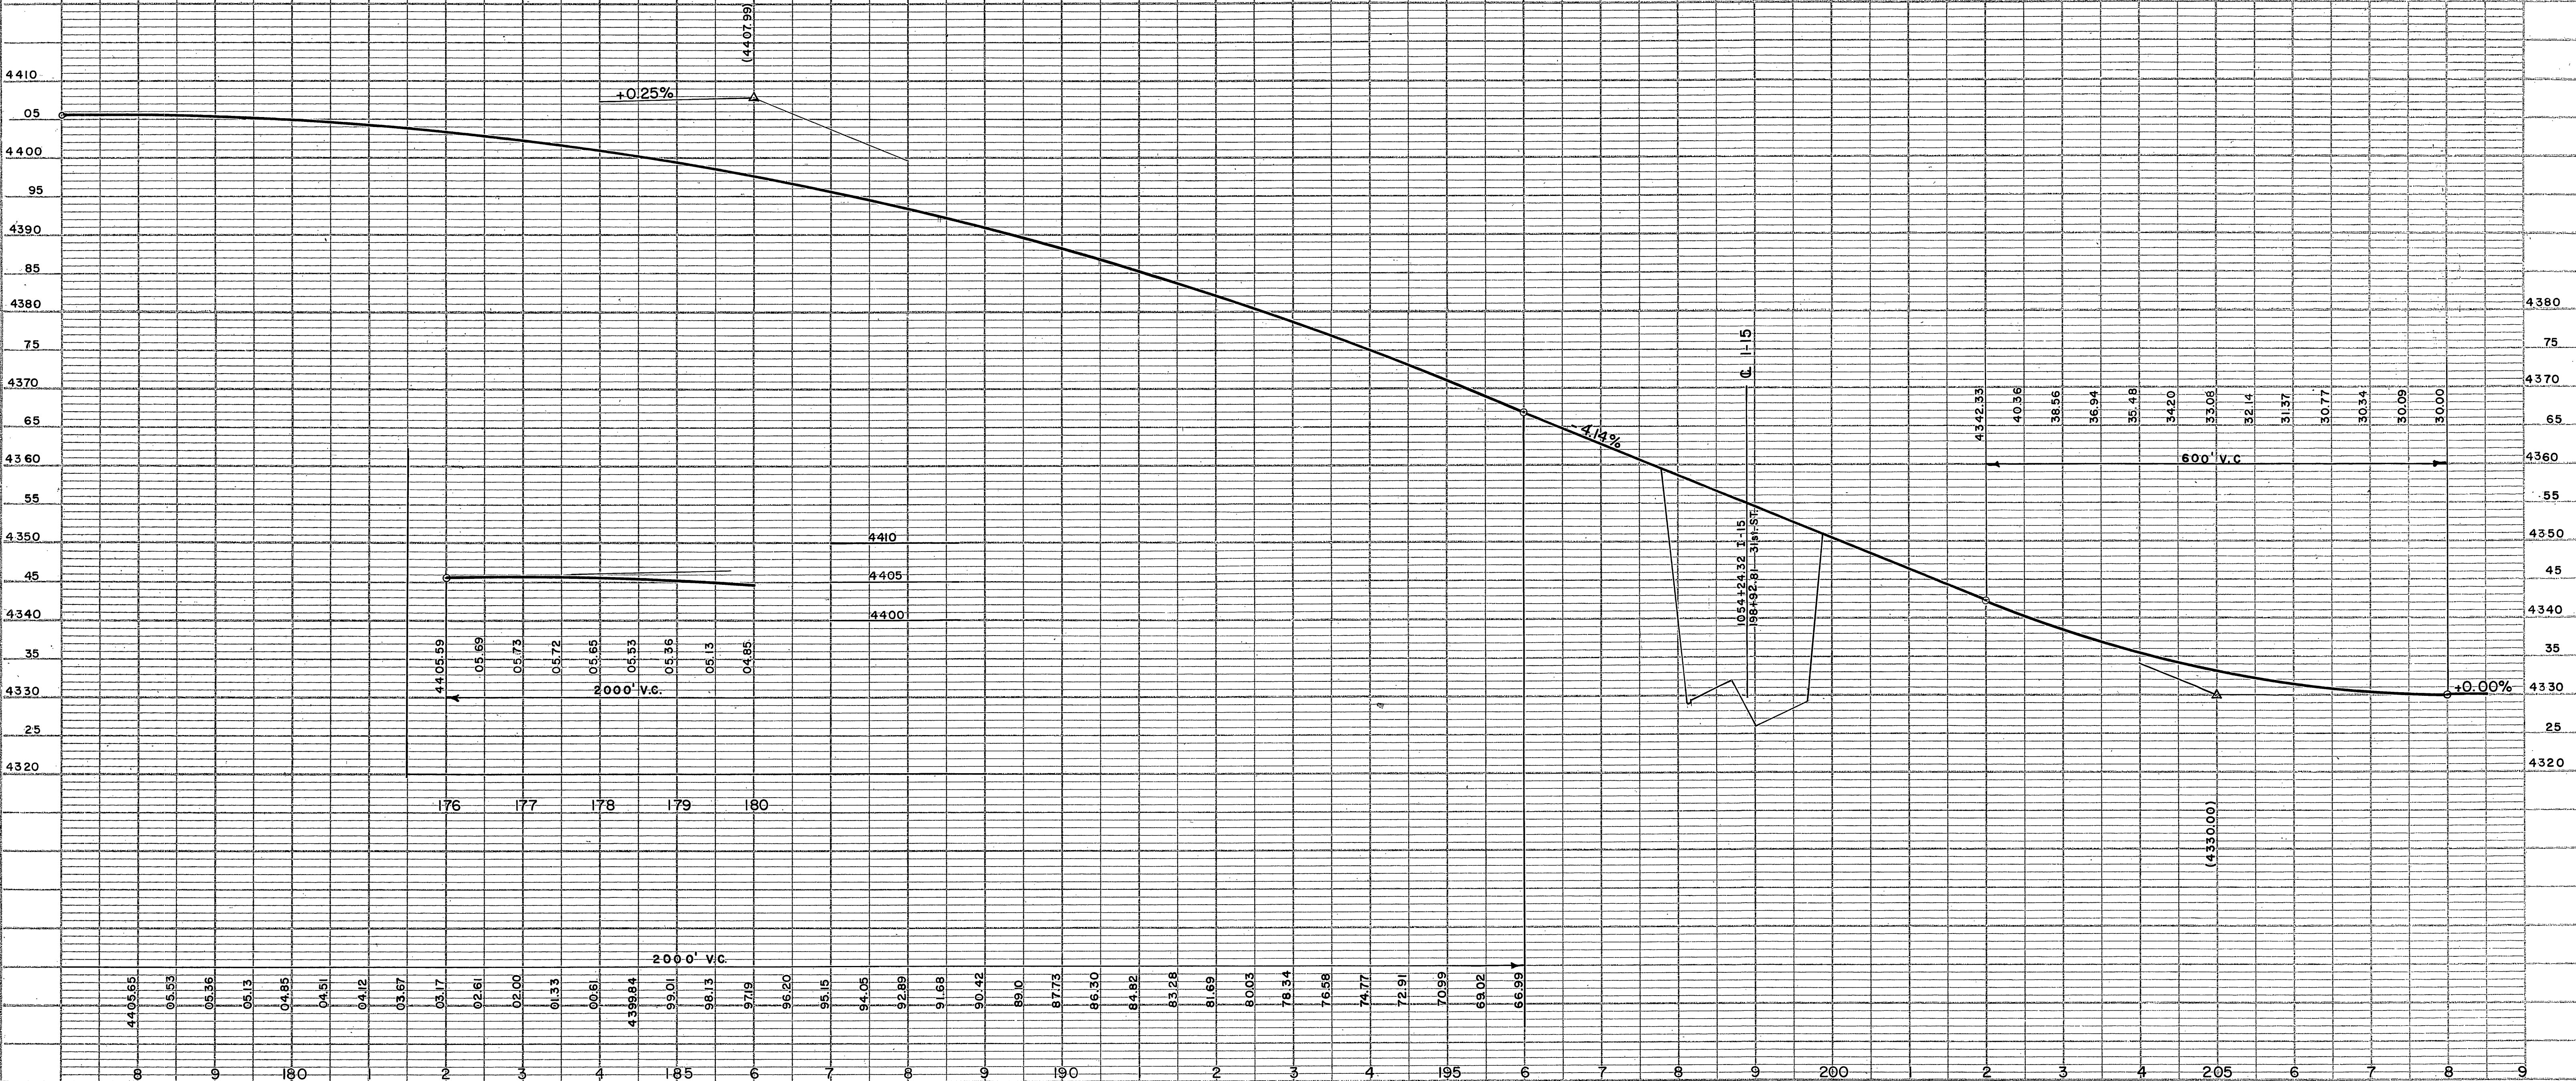


STORM SEWER PROFILE FOR THE
SOUTHERN PART OF 31ST ST.
INTERCHANGE

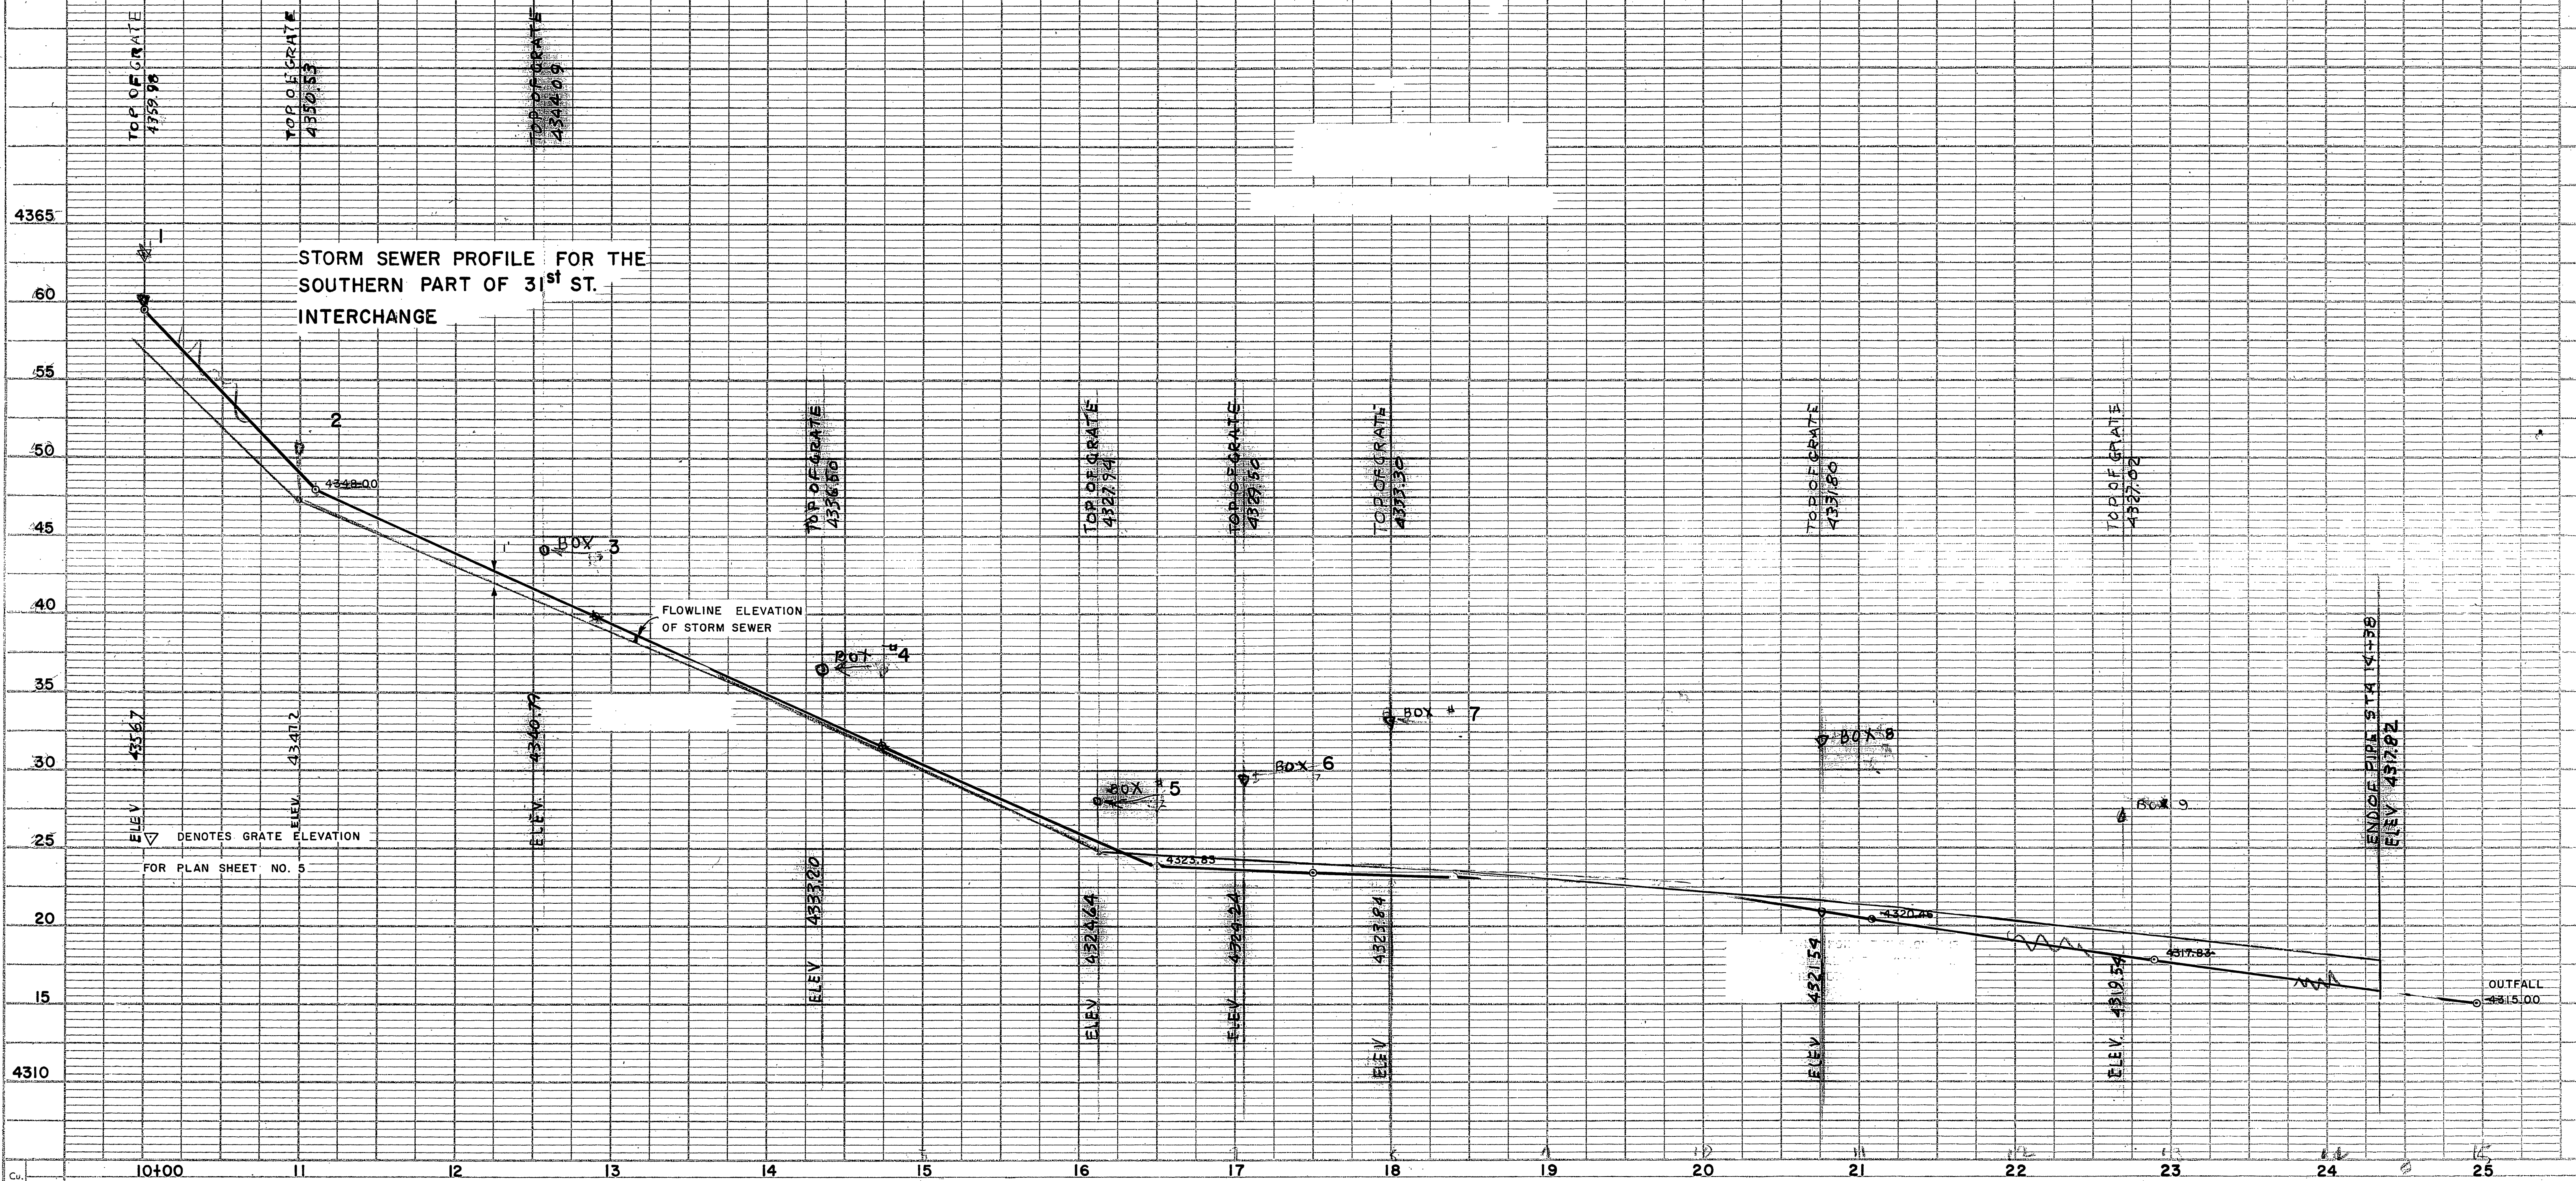



STATE	PROJ. NO.	SHEET NO.	TOTAL SHEETS
UTAH	I-15-B(2)334	13	13


4TH G. AC. REV. 10-7-68

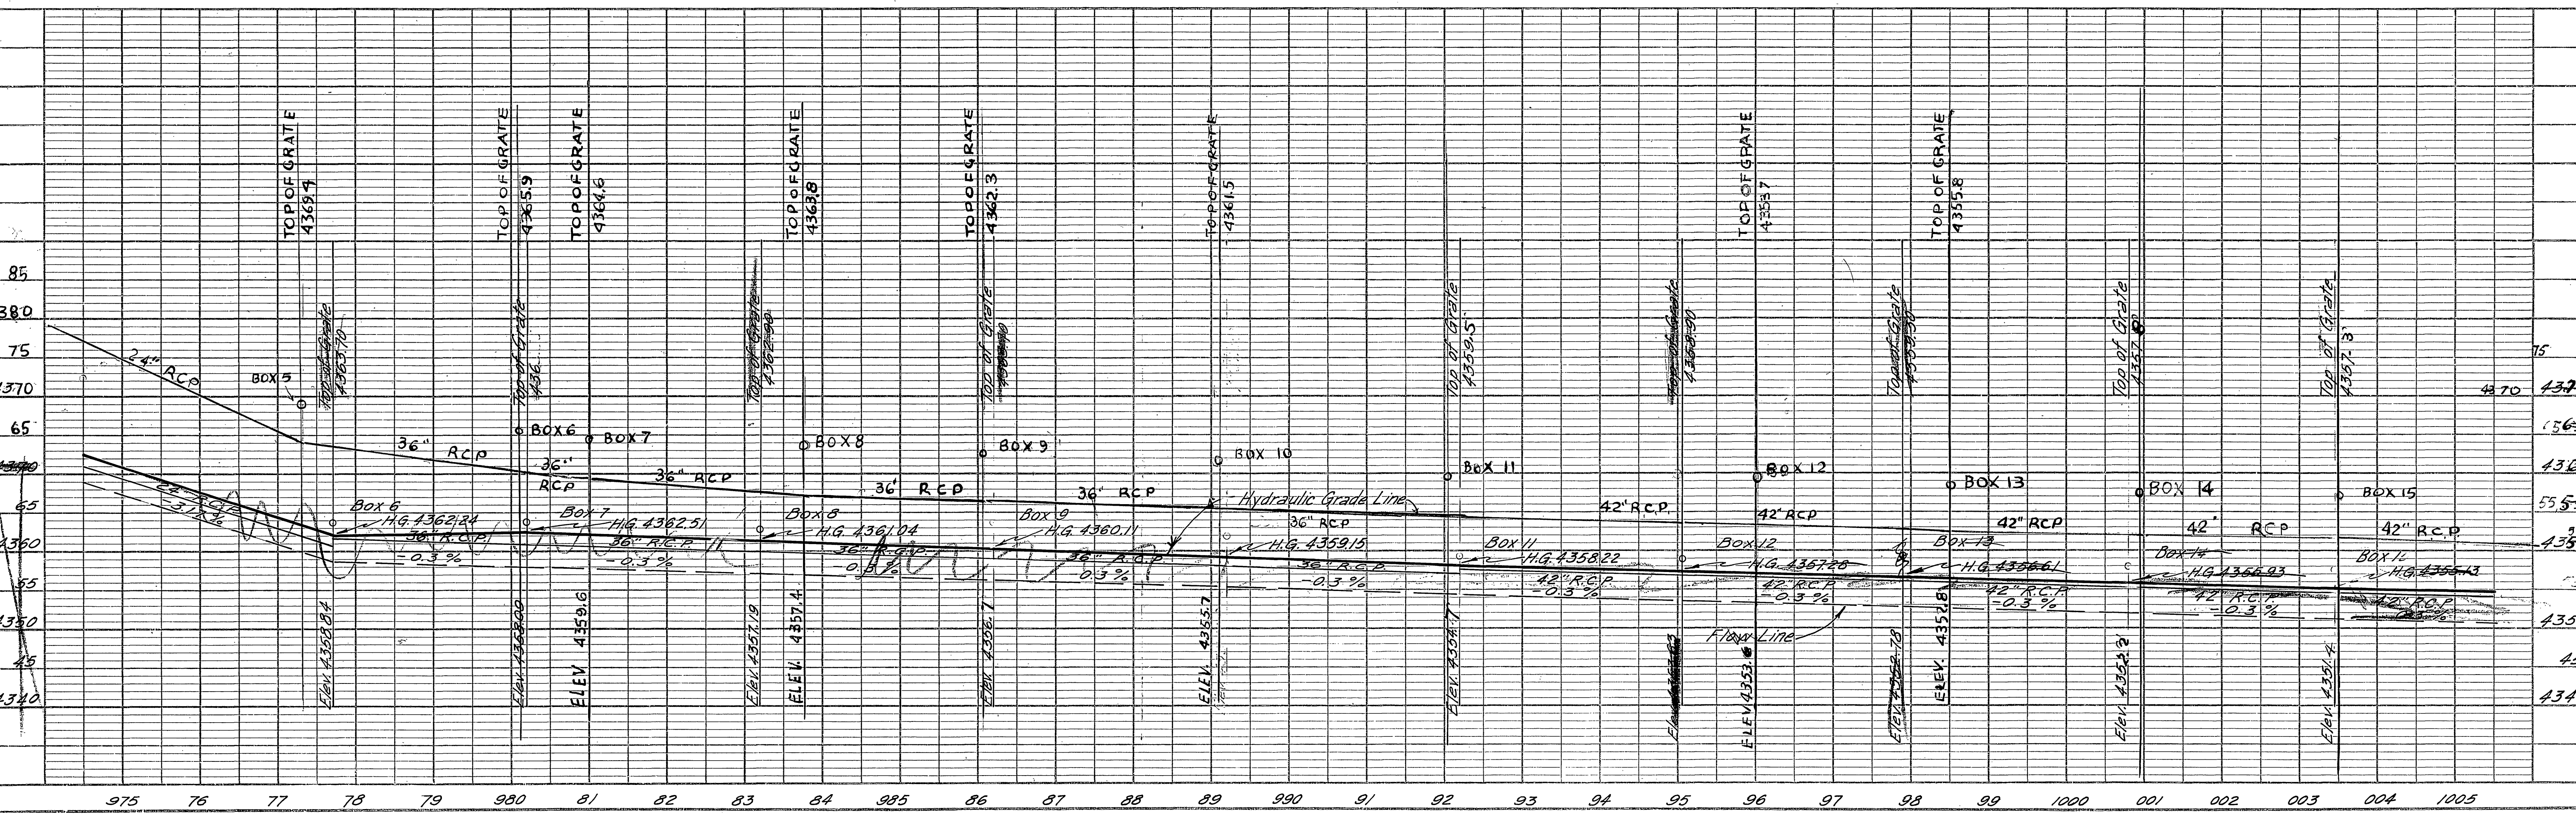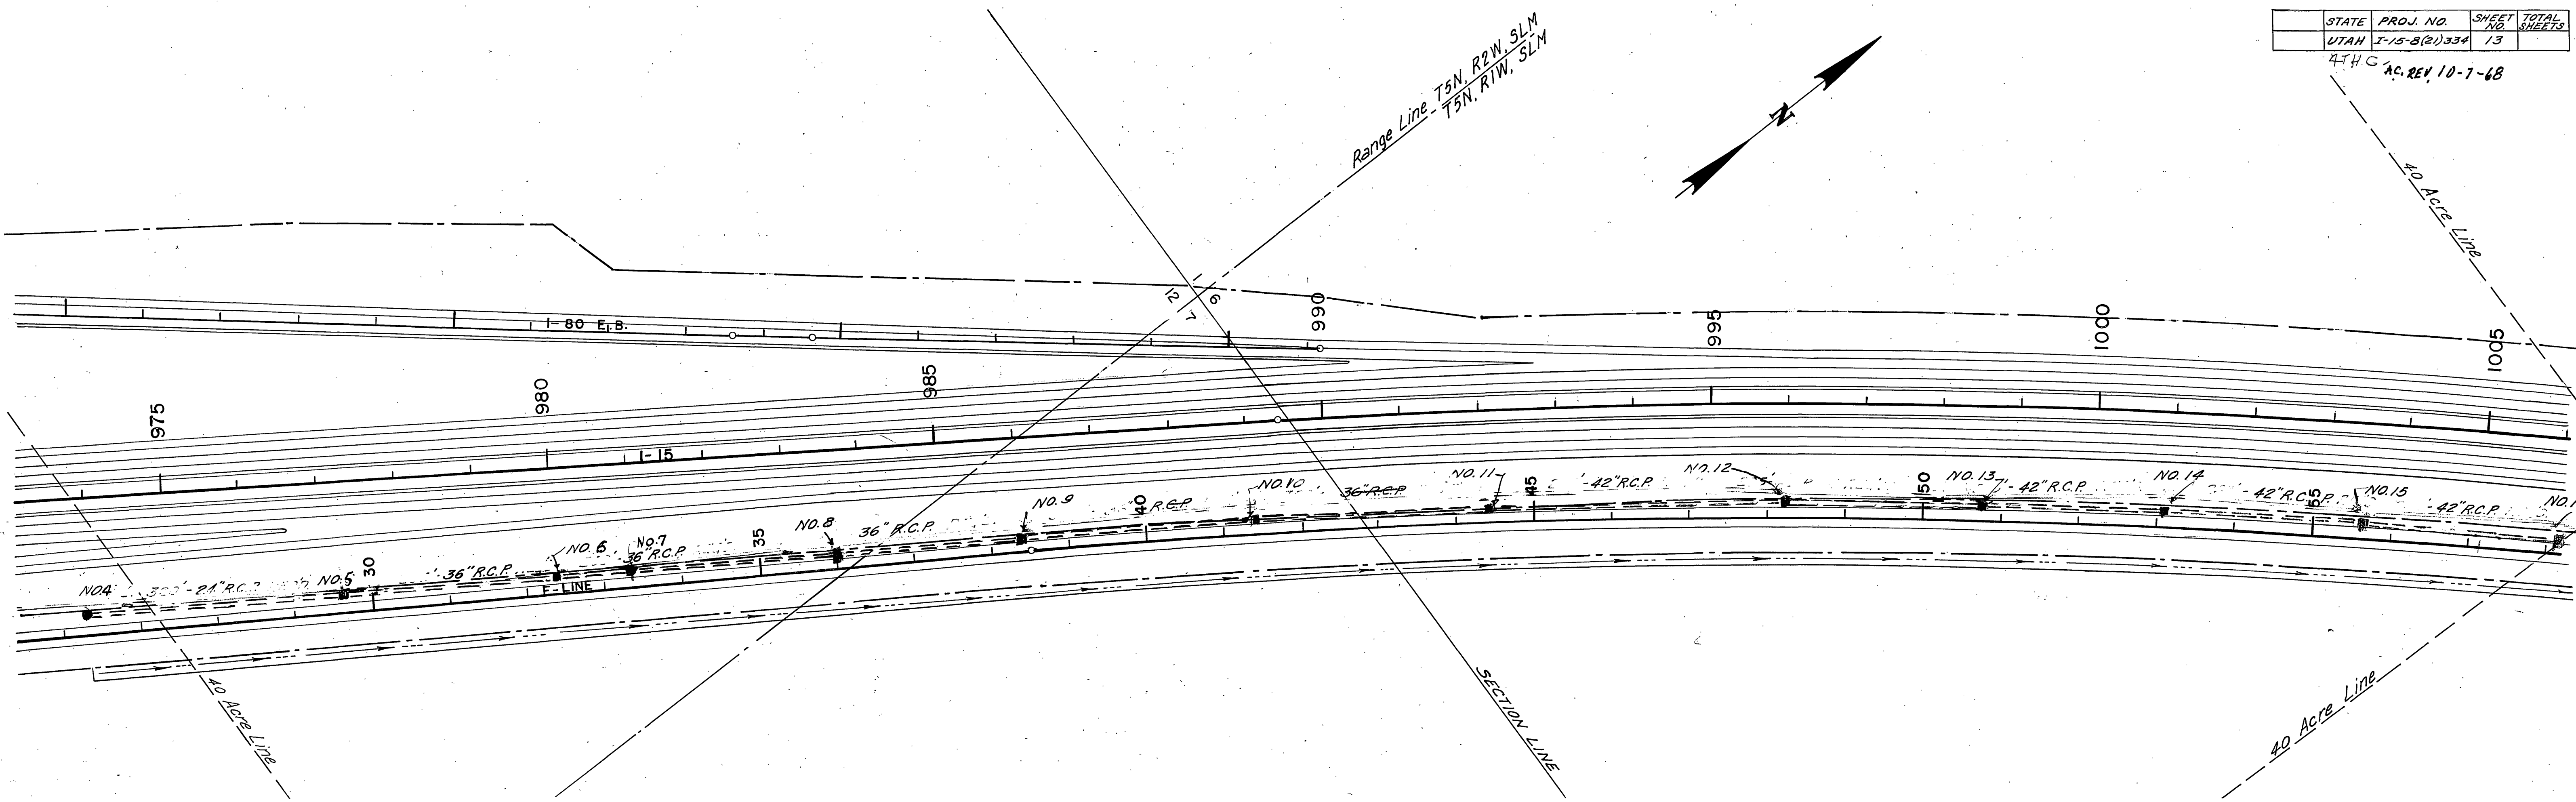

STATE	PROJ. NO.	SHEET NO.	TOTAL SHEETS
UTAH	E-15-8(21)334	14	

4THP. 10-9-68
A.C.P.

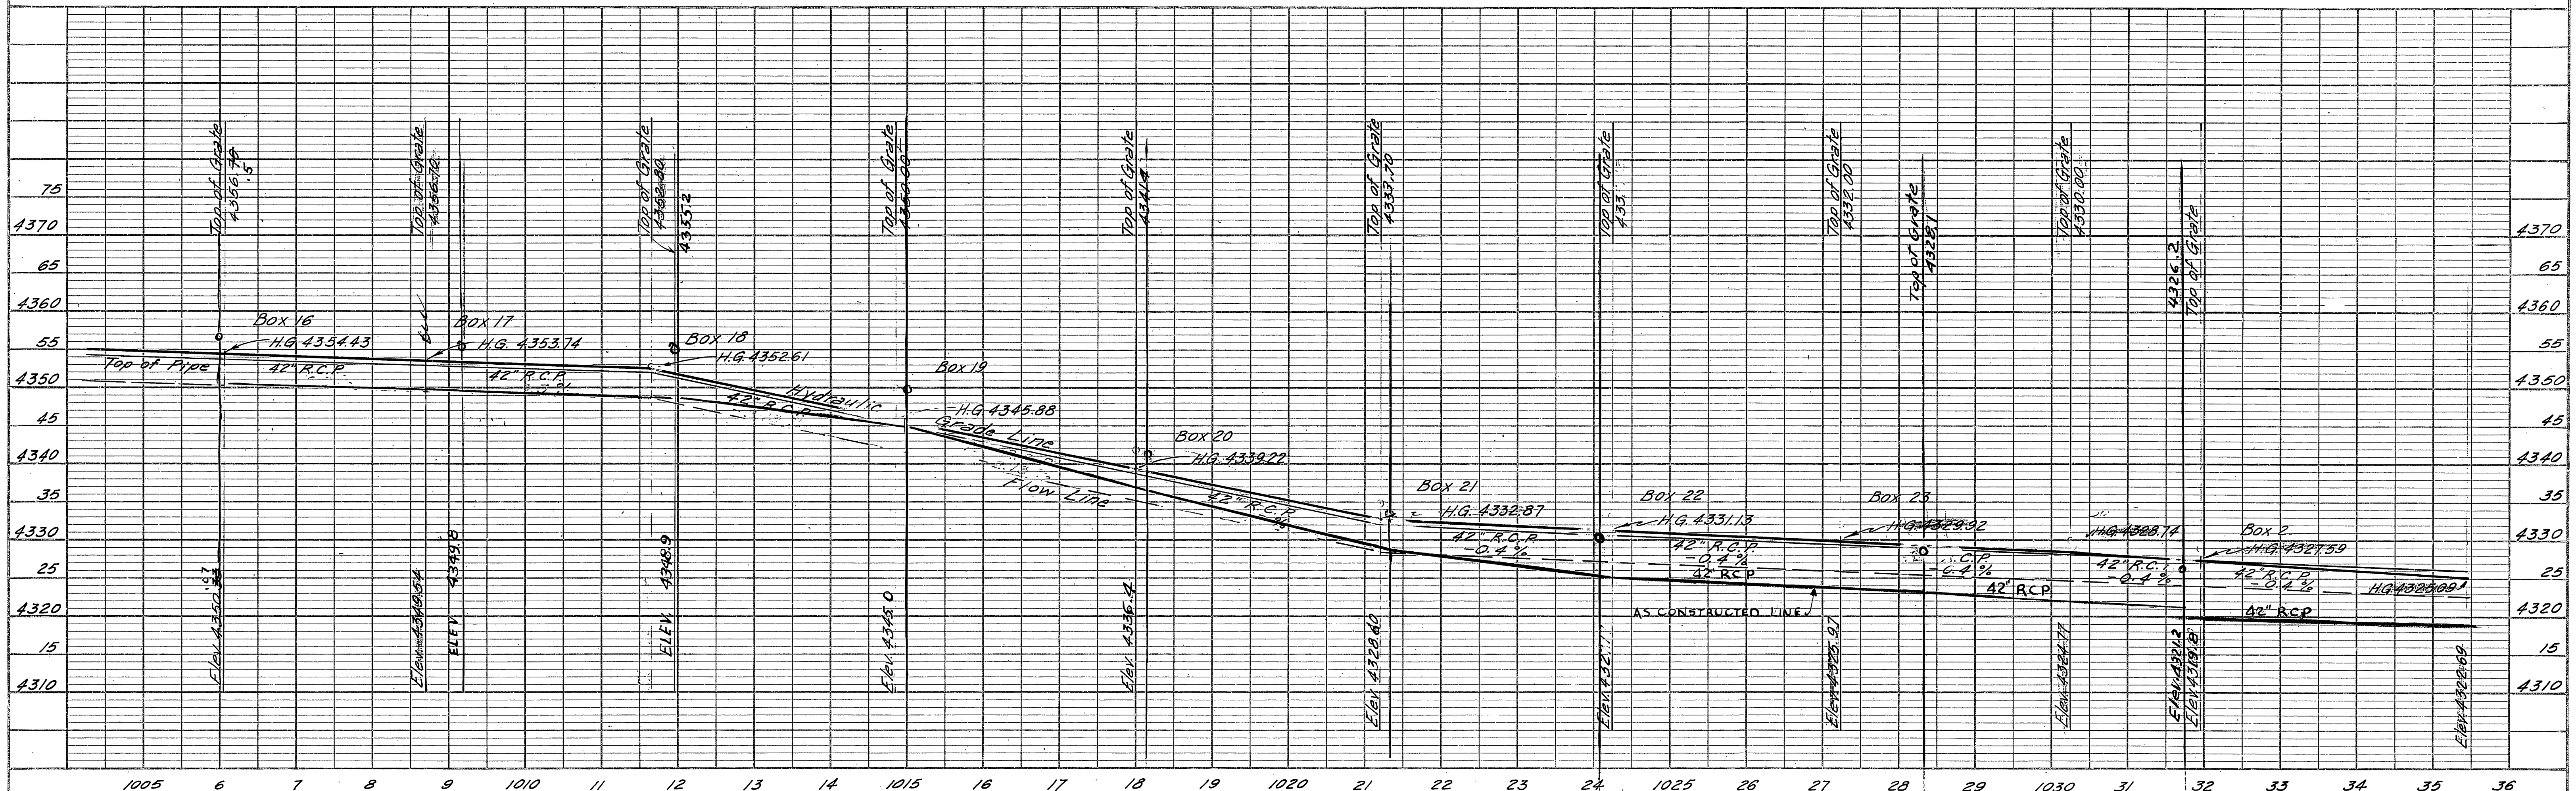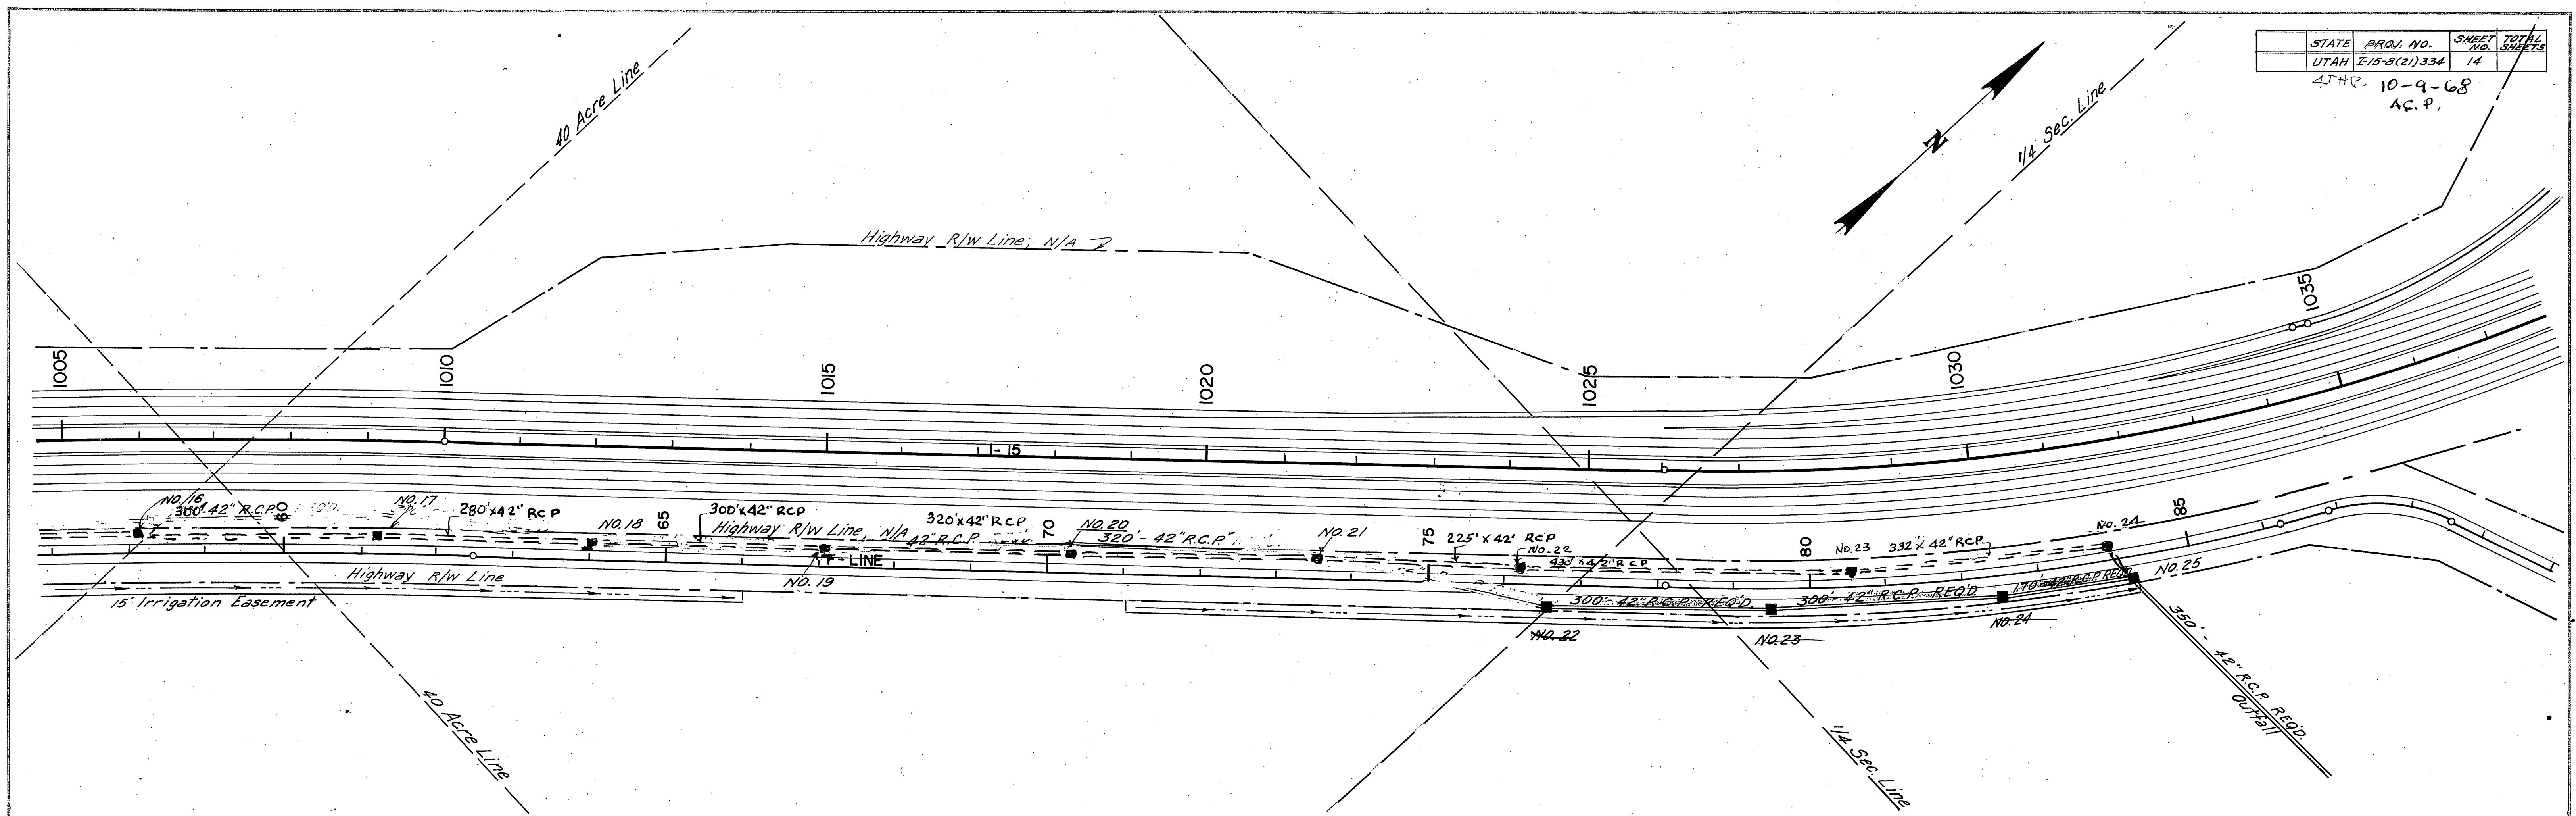

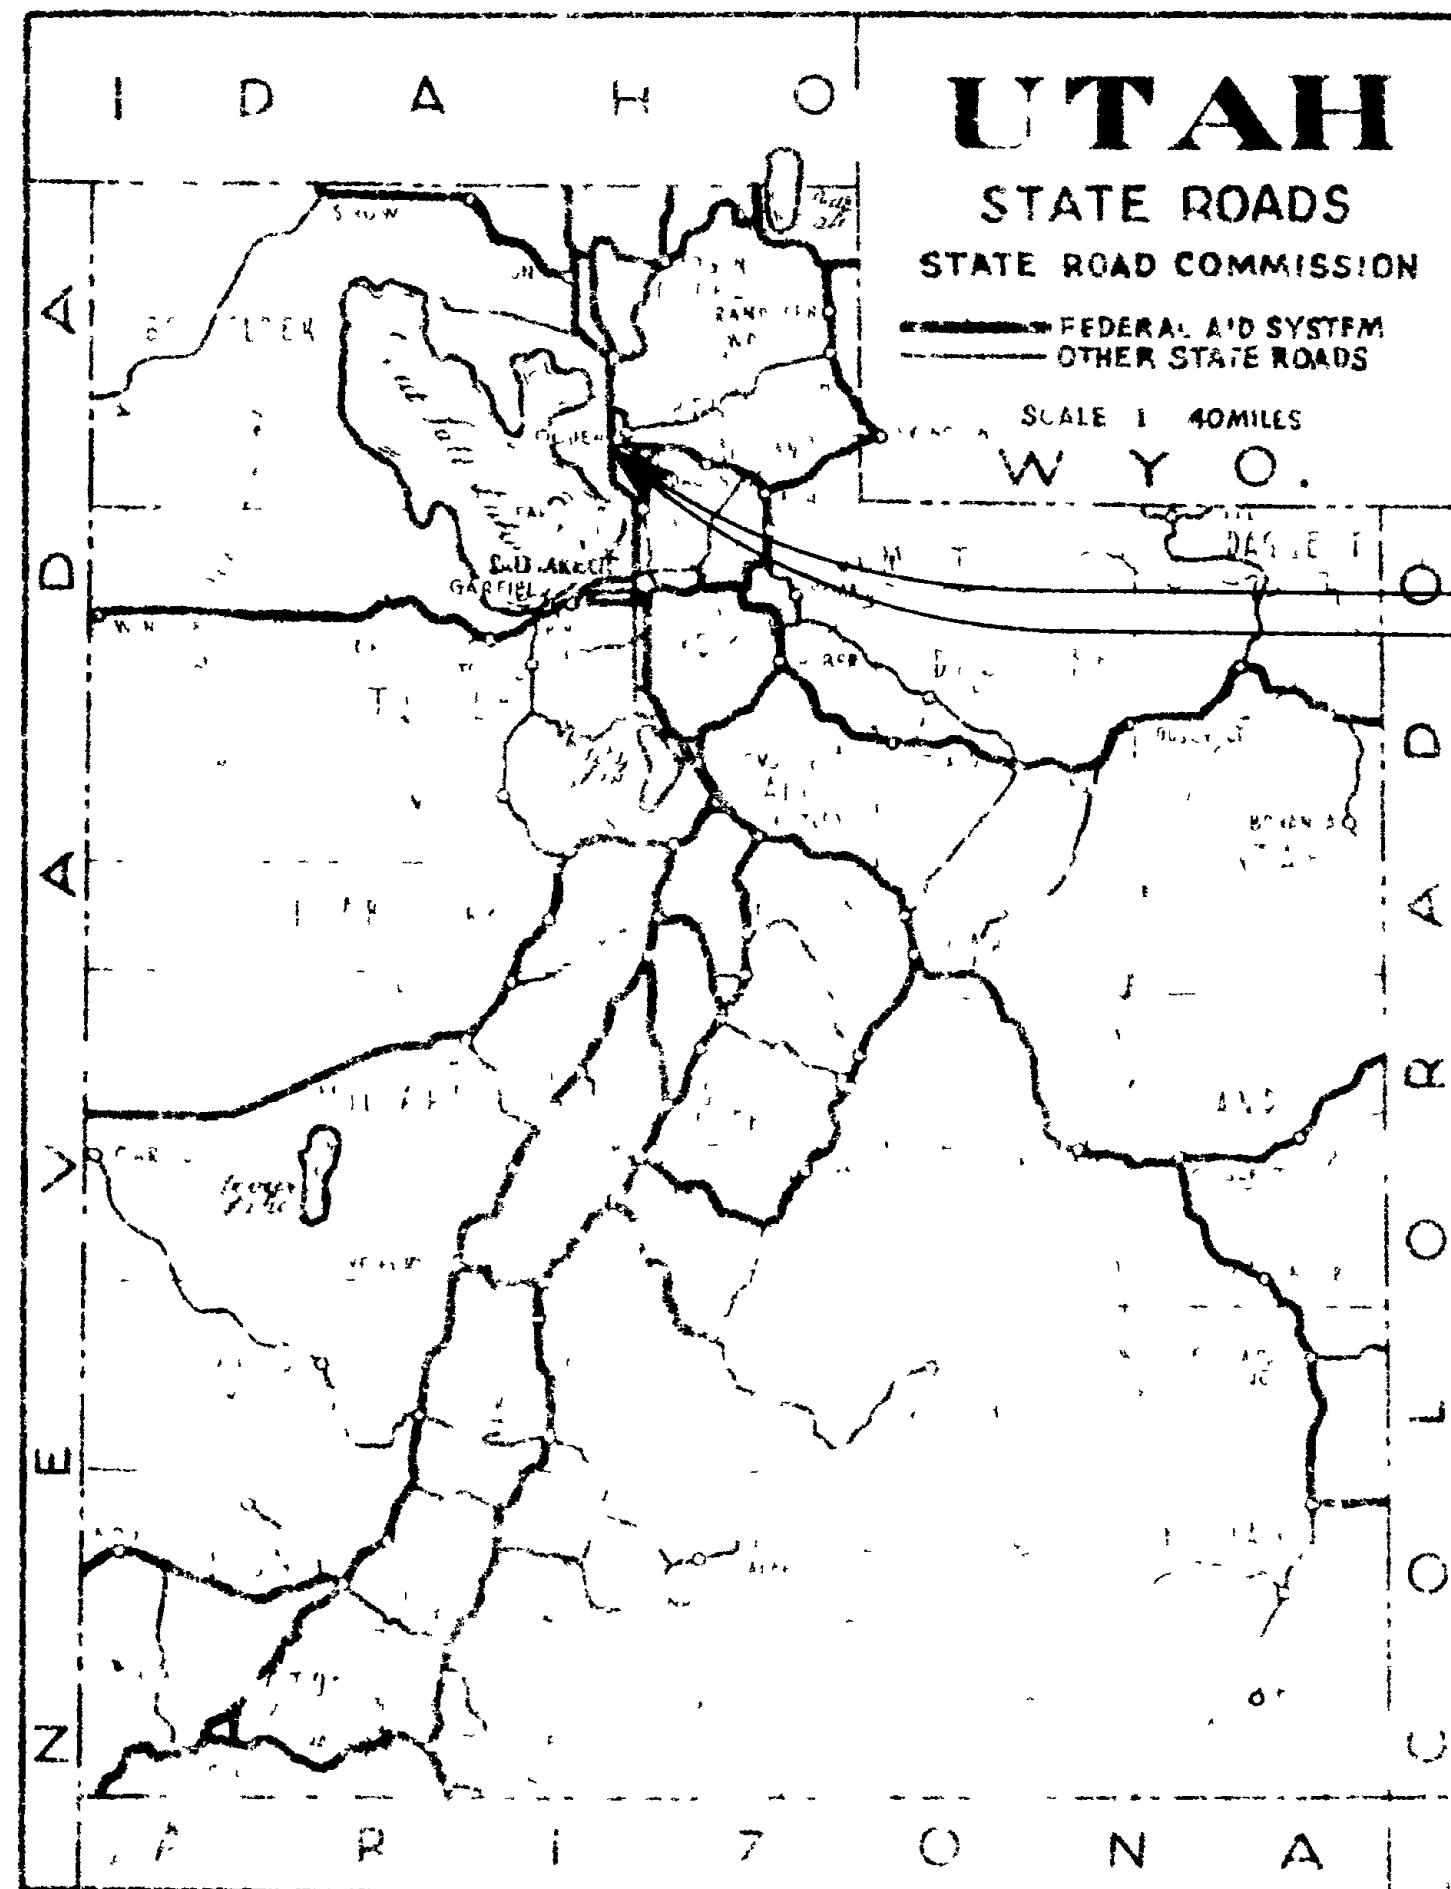

STATE OF UTAH STATE ROAD COMMISSION

PLANS OF PROPOSED STATE ROAD

FEDERAL AID PROJECTS


~~I-15-7(69)326 2nd CONTRACT~~
~~SO. LAYTON TO DAVIS-WEBER COUNTY LINE~~
~~DAVIS COUNTY~~
~~LENGTH 8.437 MILES~~

I-15-8(21)334 2nd CONTRACT
DAVIS-WEBER COUNTY LINE TO 31st STREET OGDEN
WEBER COUNTY
LENGTH 3.862 MILES

LANDSCAPING

AS CONSTRUCTED DRAWINGS

SCALE
FLA
PROFILE
HORIZ
VERT

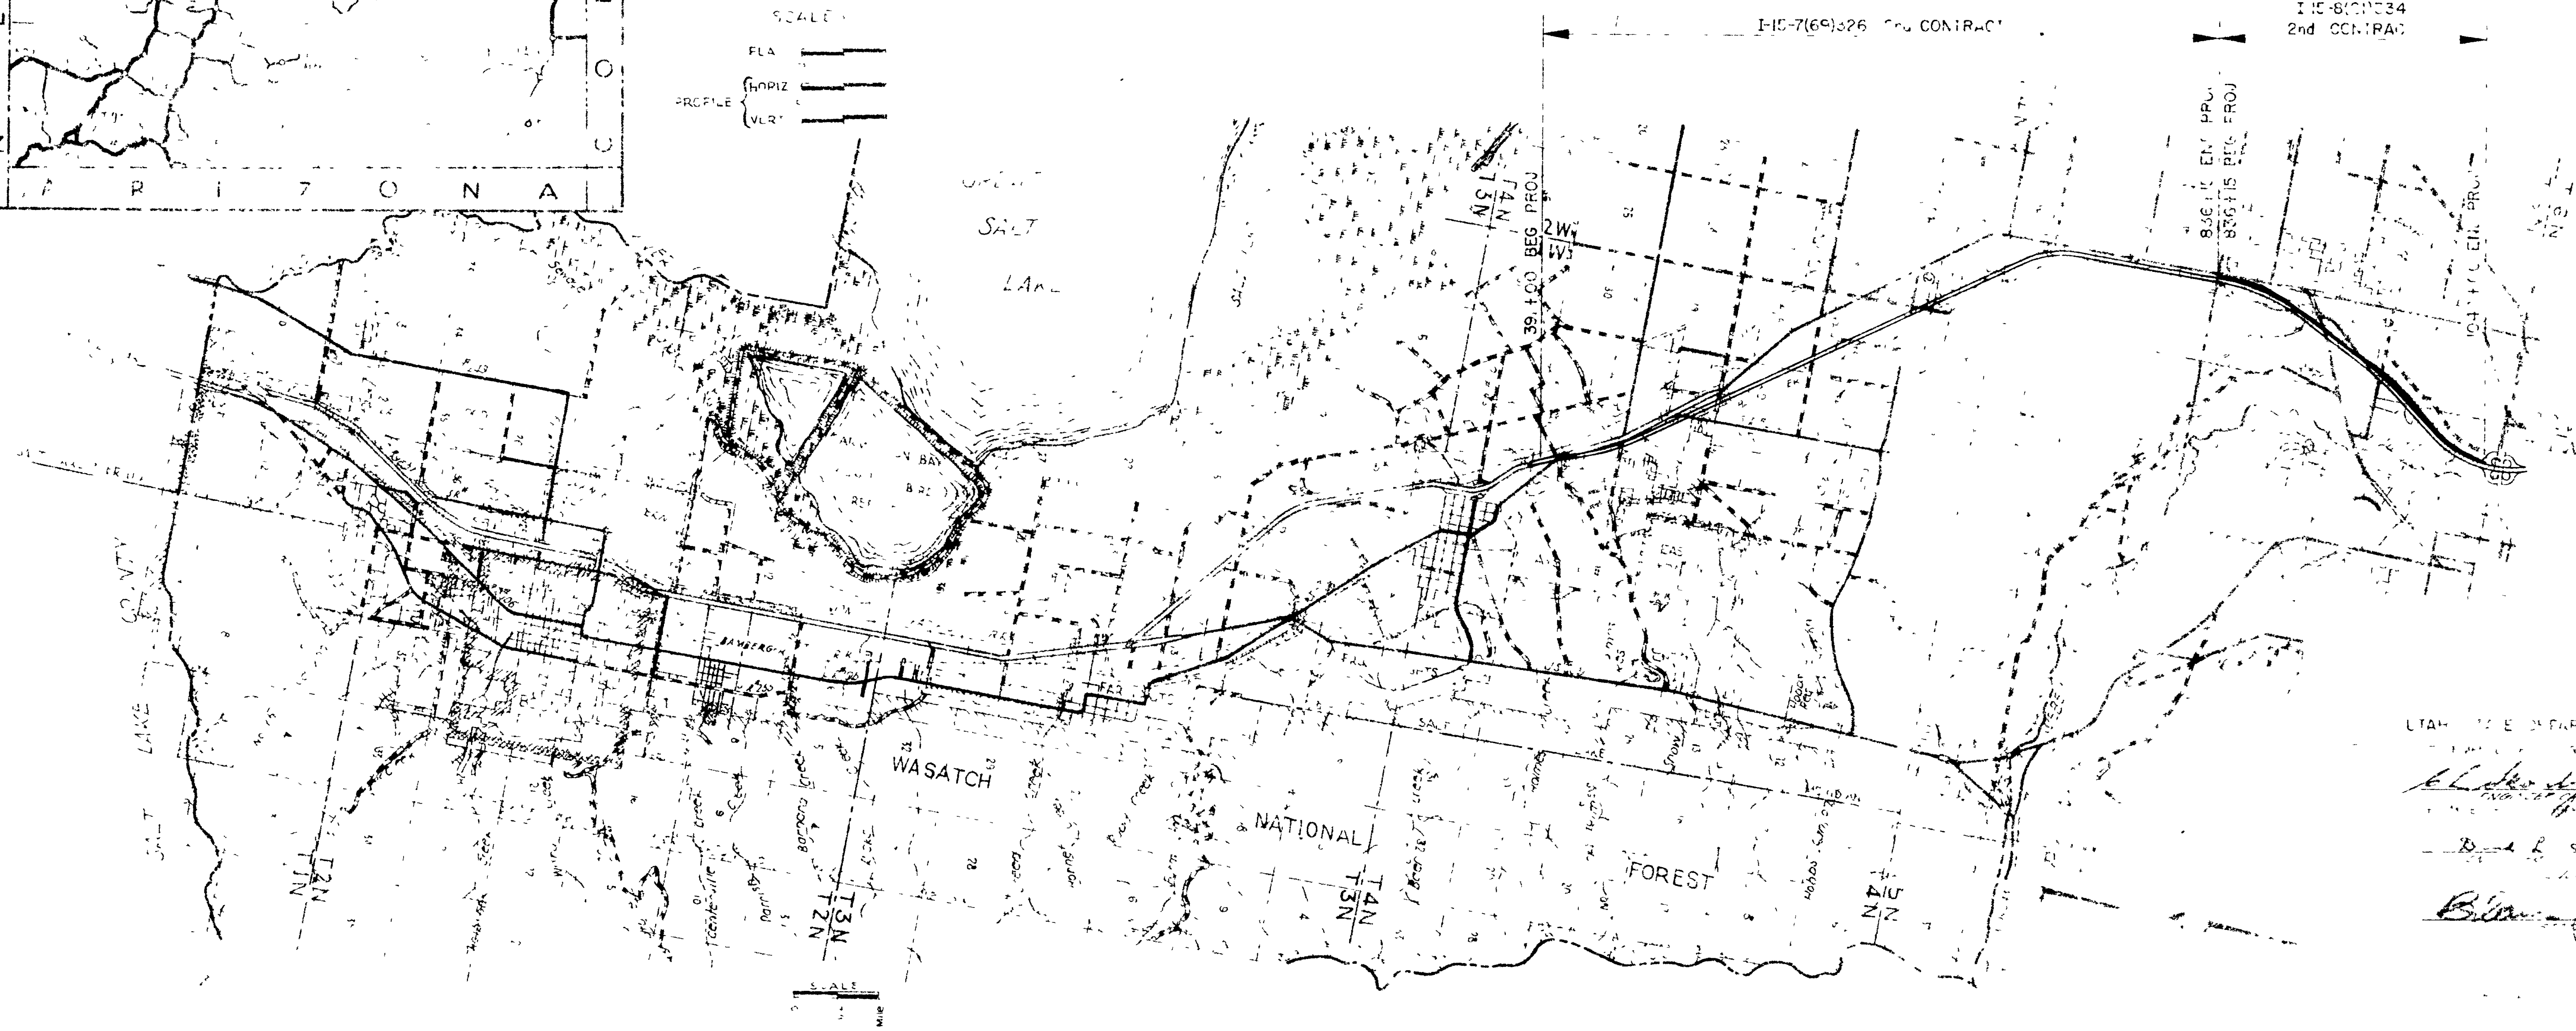

I-15-7(69)326
I-15-8(21)334
SECOND CONTRACT


INDEX
1. GENERAL NOTES
2. PLAN
3. PROFILE
4. CROSS SECTION
5. EARTHWORK
6. DRAINAGE
7. UTILITIES
8. LANDSCAPING
9. CONSTRUCTION DETAILS
10. MATERIALS
11. SPECIAL NOTES

I-15-8(21)334
2nd CONTRACT

UTAH STATE DEPARTMENT OF HIGHWAYS
DESIGNED BY
CHECKED BY
APPROVED BY

[Signature]
[Signature]
[Signature]

DETAIL SHEET

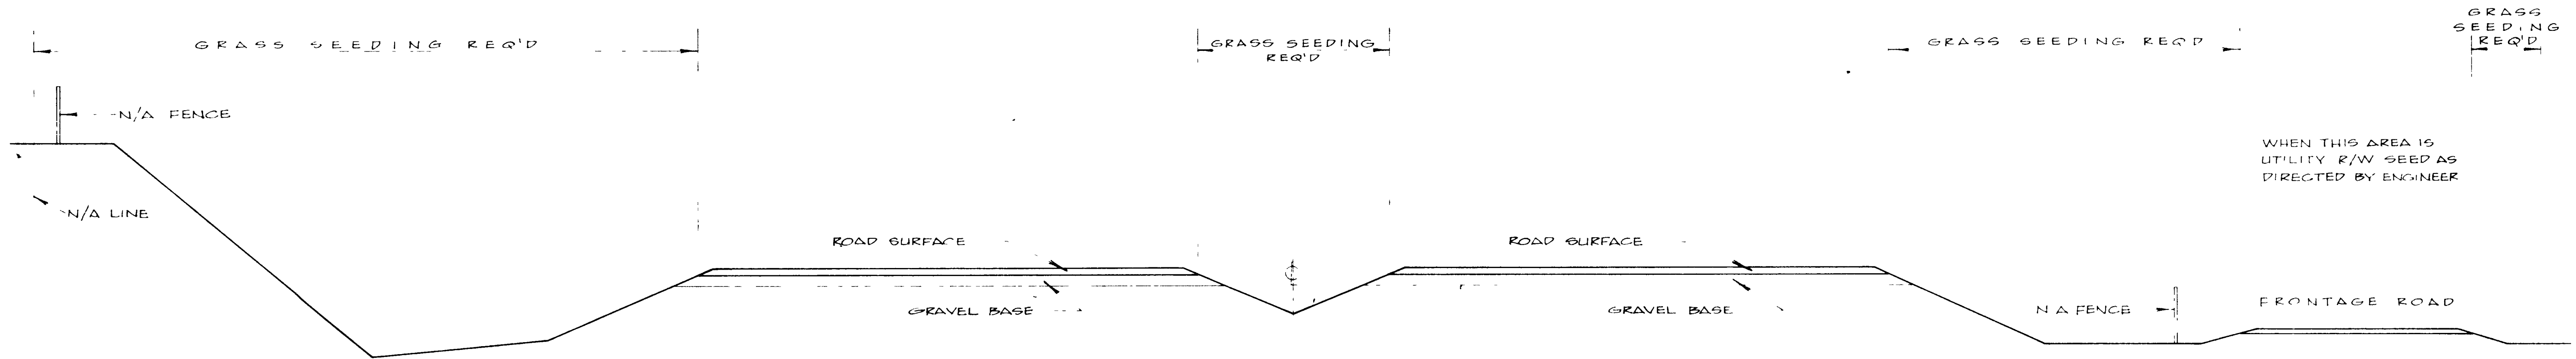

TYPICAL SECTION

LEGEND

- ⑤ AREA NUMBER
- ◄ ► LIMITS OF AREAS
- DECIDUOUS TREES
- EVERGREEN TREES
- EXISTING DECIDUOUS TREES
- EXISTING EVERGREEN TREES
- TREE LOCATION WITHOUT IRRIGATION
- TREE AND BUBBLER HEAD LOCATION
- SPRINKLER LINE
- ANGLE CONTROL VALVE
- METER AND STOP AND WASTE VALVE
- MAIN WATER LINE
- ② METER NUMBER
- 25-F- TREE IDENTIFICATION LETTER
- 5-X- SPRINKLER HEAD
- GLASS FIBER ROVING
- GLASS FIBER MAT
- JUTE MESH

SEED SCHEDULE


N A M E		LBS LIVE SEED PER ACRE	
SCIENTIFIC	COMMON	METHOD A	METHOD B
AGROPYRON CRISTATUM	FAIRWAY CRESTED WHEAT	8	12
AGROPYRON RIPARIUM	SODAR WHEAT GRASS	8	12
ORYZOPSIS HYMENOIDES	INDIAN RICE GRASS	4	6
TOTAL POUNDS LIVE SEED PER ACRE		20	30

FERTILIZER SCHEDULE

F O R M	LBS AVAILABLE CHEMICAL PER ACRE	
	NITROGEN	PHOSPHORUS
PELLET OR GRANULAR	30	30

FORMULA FOR DETERMINING TOTAL POUNDS OF SEED

TOTAL POUNDS OF SEED PER ACRE = $\frac{\text{POUNDS LIVE SEED REQUIRED}}{\text{PERCENT PURITY} \times \text{PERCENT GERMINATION}}$

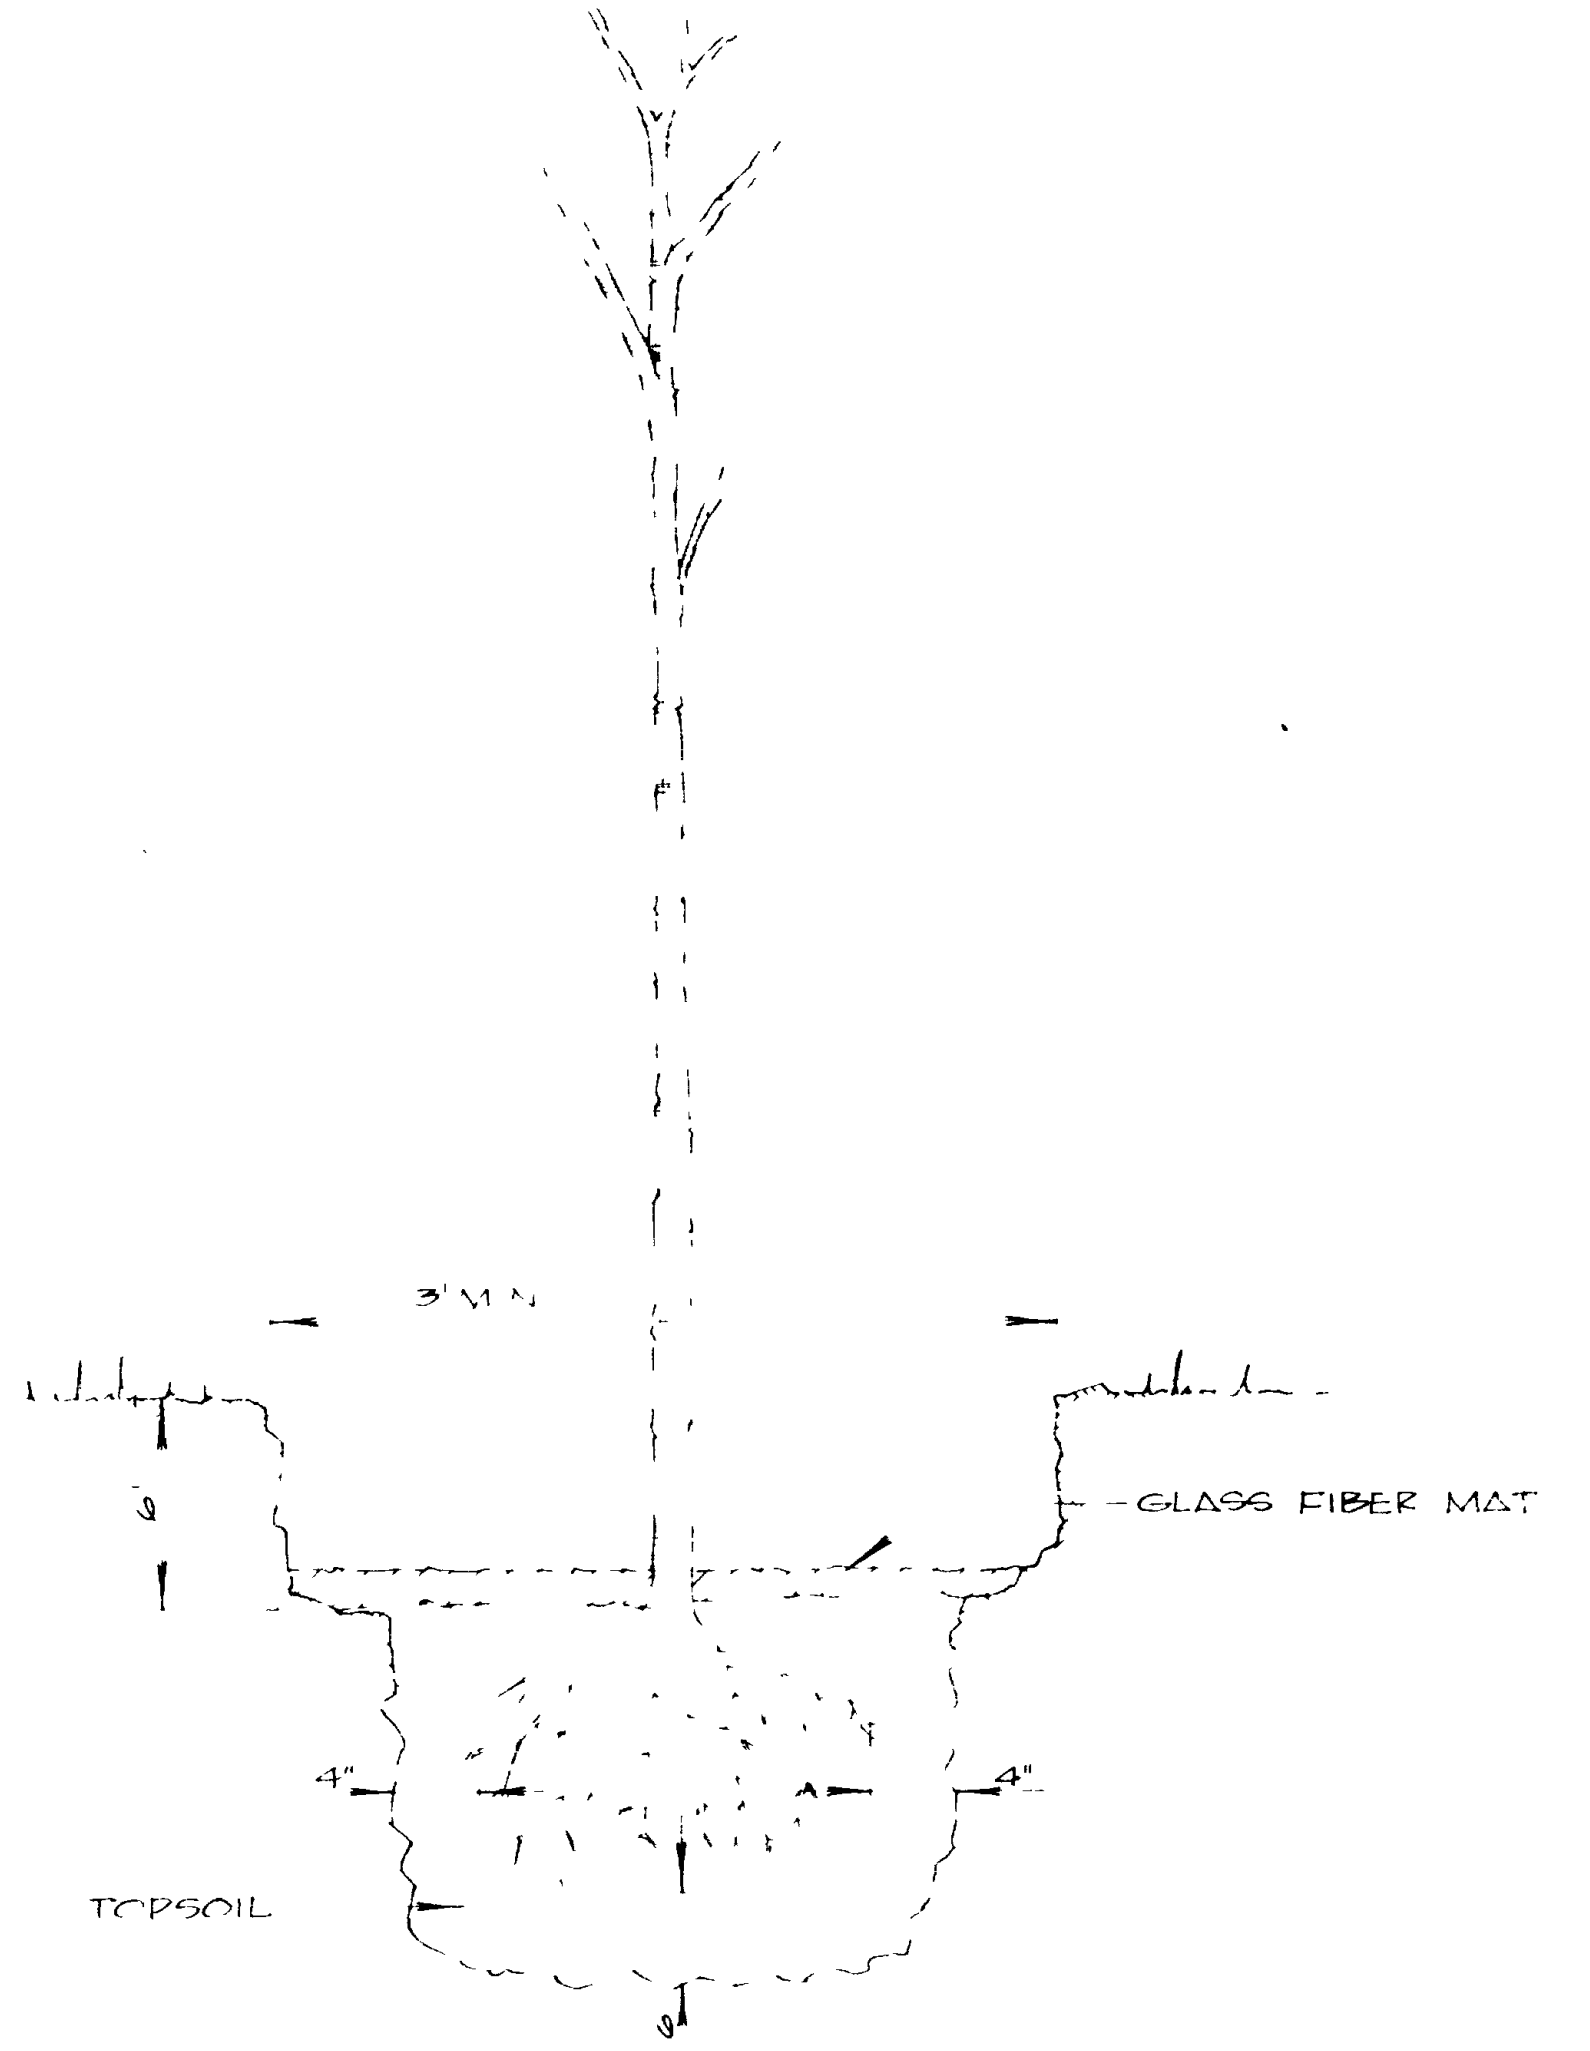

TREE PLANTING DETAIL

PLANT LIST

CODE NO	SCIENTIFIC NAME	COMMON NAME	MIN. CALIPER	MIN. HEIGHT	REMARKS
A	ELAEGNUS ANGUSTIFOLIA	RUSSIAN OLIVE	3/4"	5'	BAREROOT
B	FRAXINUS PENNSYLVANICA LANCEOLATA	MALE GREEN ASH	1"	7'	"
C	GLEDITSIA TRIACANTHOS INERMIS	THORNLESS HONEY LOCUST	1"	7'	CONTAINER
D	JUNIPERUS VIRGINIANA CANNARTI	CANNART JUNIPER		3'	"
E	KOELREUTERIA PANICULATA	GOLDENRAIN	3/4"	6'	BAREROOT
F	PINUS NIGRA	AUSTRIAN PINE		3'	CONT. OR B+B
G	PLATANUS ACERFOLIA	LONDON PLANE TREE	1"	5'	BAREROOT
H	POPULUS CANADENSIS	CAROLINA POPLAR	1"	5'	"
I	POPULUS NIGRA ITALICA	LOMBARDY POPLAR	1"	5'	"
J	ULMUS AMERICANA MOLINI	MOLINE ELM	1"	7'	"
R	JUNIPERUS CHINENSIS PFITZERIANA	PFITZER JUNIPER	3-GAL	15' SPRD	CONTAINER
S	RHUS GLABRA	SMOOTH SUMAC		2'	BAREROOT

NOTE

THE CONTRACTOR SHALL EXCAVATE AND BACKFILL ALL TRENCHES NECESSARY FOR WATER CONNECTIONS


ALL THREADED JOINTS ON CONTROL ASSEMBLIES SHALL BE COATED WITH MICRO CRYSTALLINE WAX



TOP VIEW

SECTION

ELEVATION

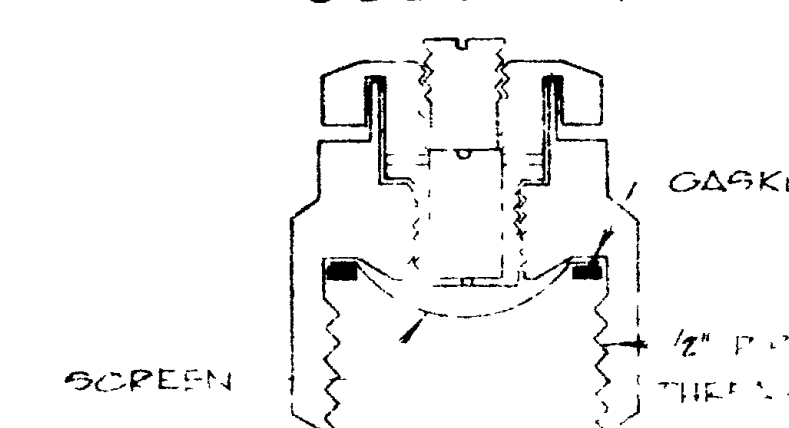

BUBBLER SHALL BE ALL BRASS
CONNECTIONS SHALL BE FREE FLOW
PRESSURE SHALL BE 30 PSI TO CONTROL
FLOW RATE 3 - 5 GPM

WATERING OUTLET BUBBLER

WATERING SYSTEM SUMMARY

I-15-7(60) 326

METER	LIN FEET PIPE				CONTROL VALVES		STOP & WASTE VALVES		OUTLETS		METER	
	2"	1 1/2"	1 1/4"	1"	1 1/2"	1 1/4"	1 1/2"	1 1/4"	BUBBLER	SPRINKLER	1 1/2"	1"
A			1400	3800		2		1	140			
B			2350	2000		2		1	59	29		
C			250	2050		2		1		70		
D			1400	2150		2		1	139			
E			1450	1900		1		1	61			
F			1000	1850		1		1	42			
G			3050	5000		3		1	179			1
H			1750	680		2		1	120			1
I		1050	2550	2500	1	3	1		187		1	
J	450	1200	4900	3350	2	2	1		307		1	
K		1700	5100	3650	1	1	1		147	18		
L			2200	2800		2		1	80			
M			450	1800					44			
SUB TOT	450	3950	27,850	54,530	4	23	3	9	1535	117	2	2
M			1300	2050		2		1	69			
N			1300	5850		2		1	116			
O			2050	4100		2		1	146	17		1
P			2350	1850		2		1	99			1
Q			1800	3600		1		1	87			1
R			300	3300		1		1	45			1
SUB TOT			9,100	20,750		10		6	562	17		4
TOTAL	450	3950	36,950	55,280	4	33	3	15	2,097	134	2	6

I-15-B(21) 334

KEEP STOP AND WASTE VALVE A MINIMUM OF 10' INSIDE N/A FENCE

10' METER OUTSIDE N/A LINE



WATERING SYSTEM CONTROL ASSEMBLY

CONCRETE COVER




WATERING OUTLETS

EDGE - ROAD



DETAIL OF WATERING OUTLET LOCATION

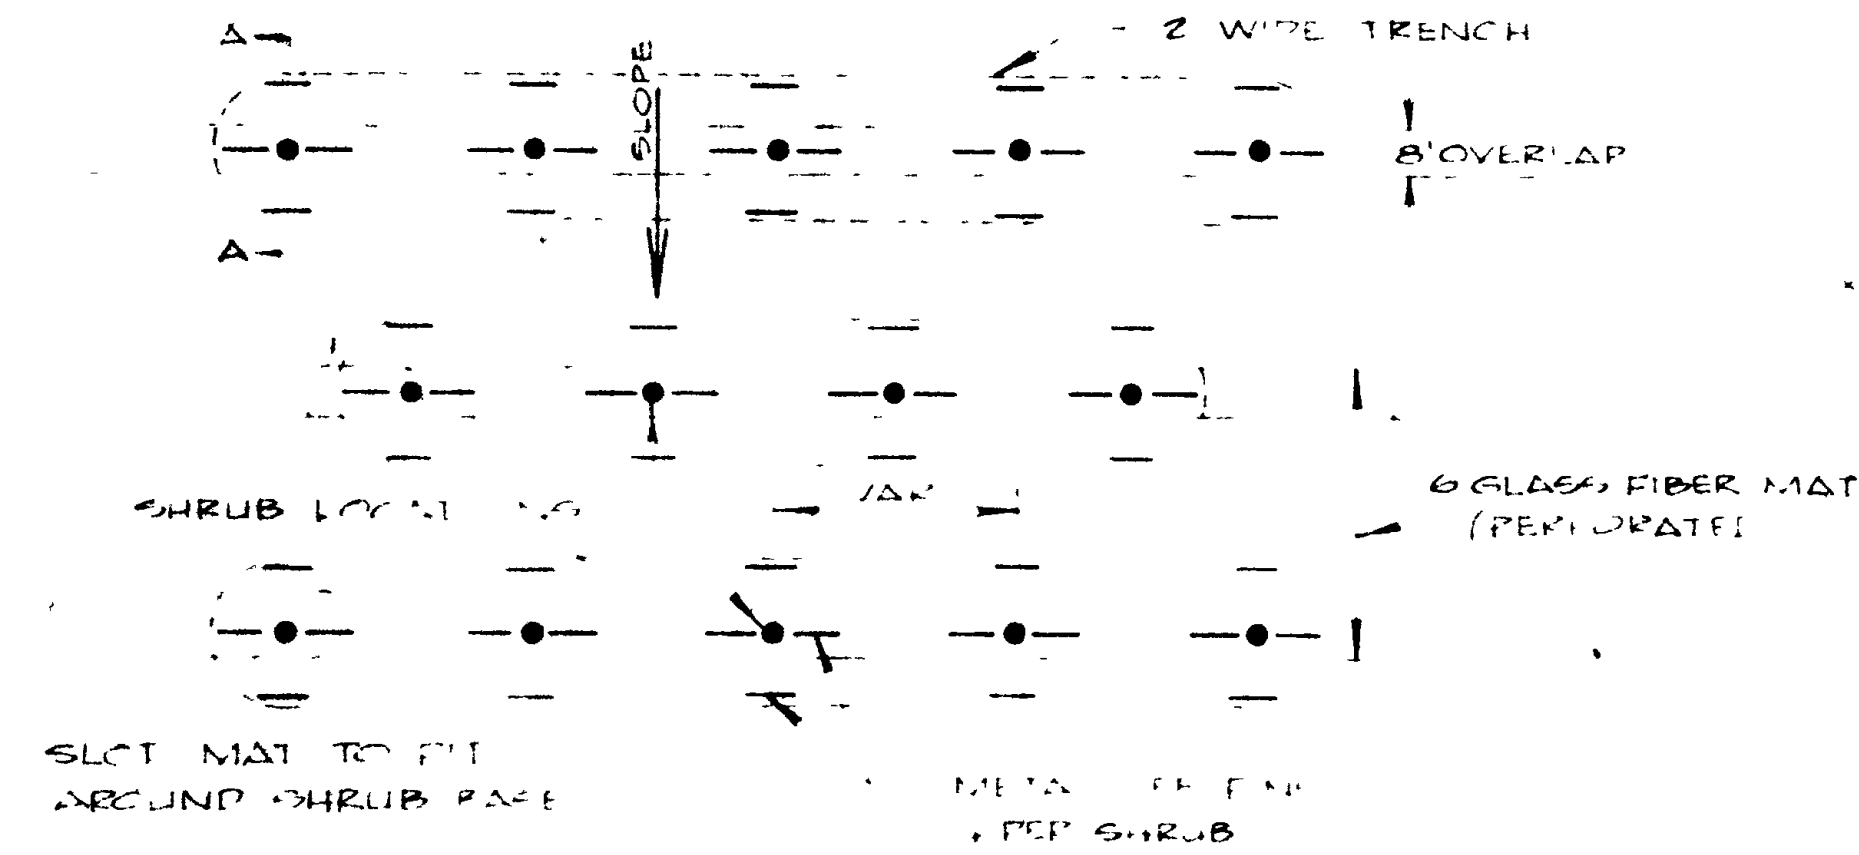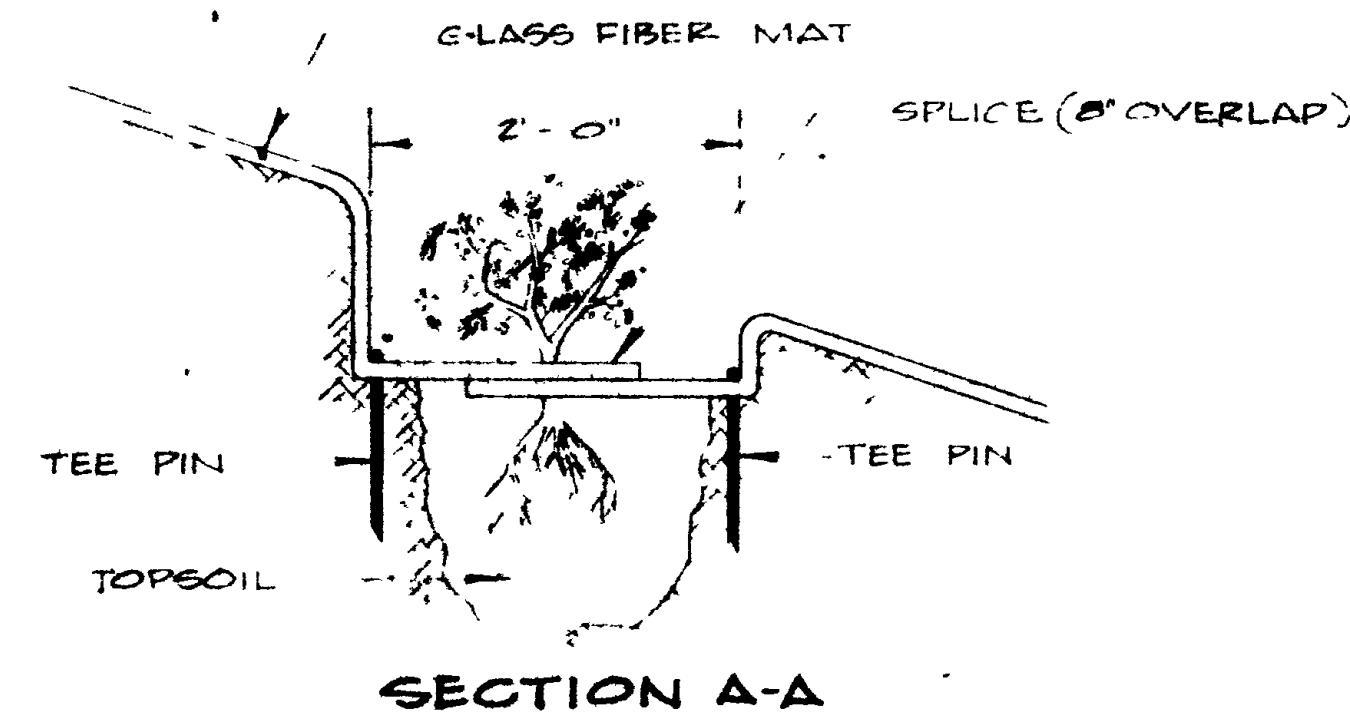

GLASS FIBER MAT SLOPE PROTECTION
 UNDER SHRUB PLANTING

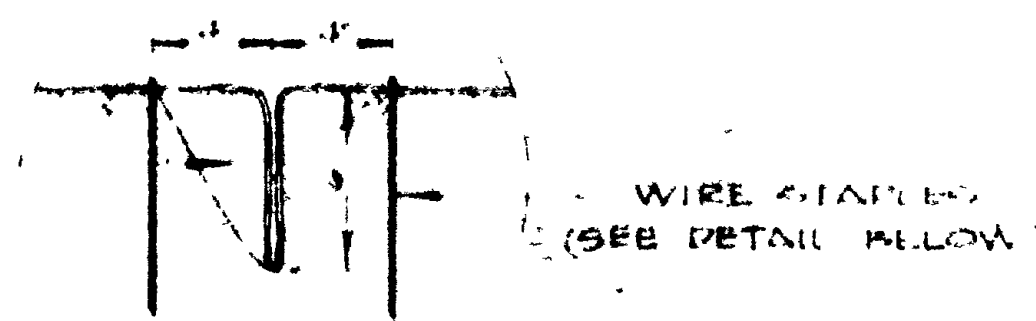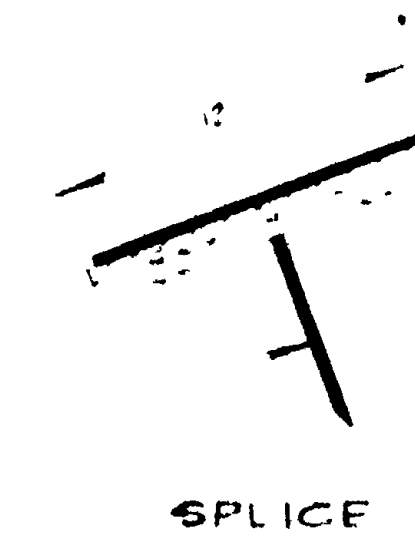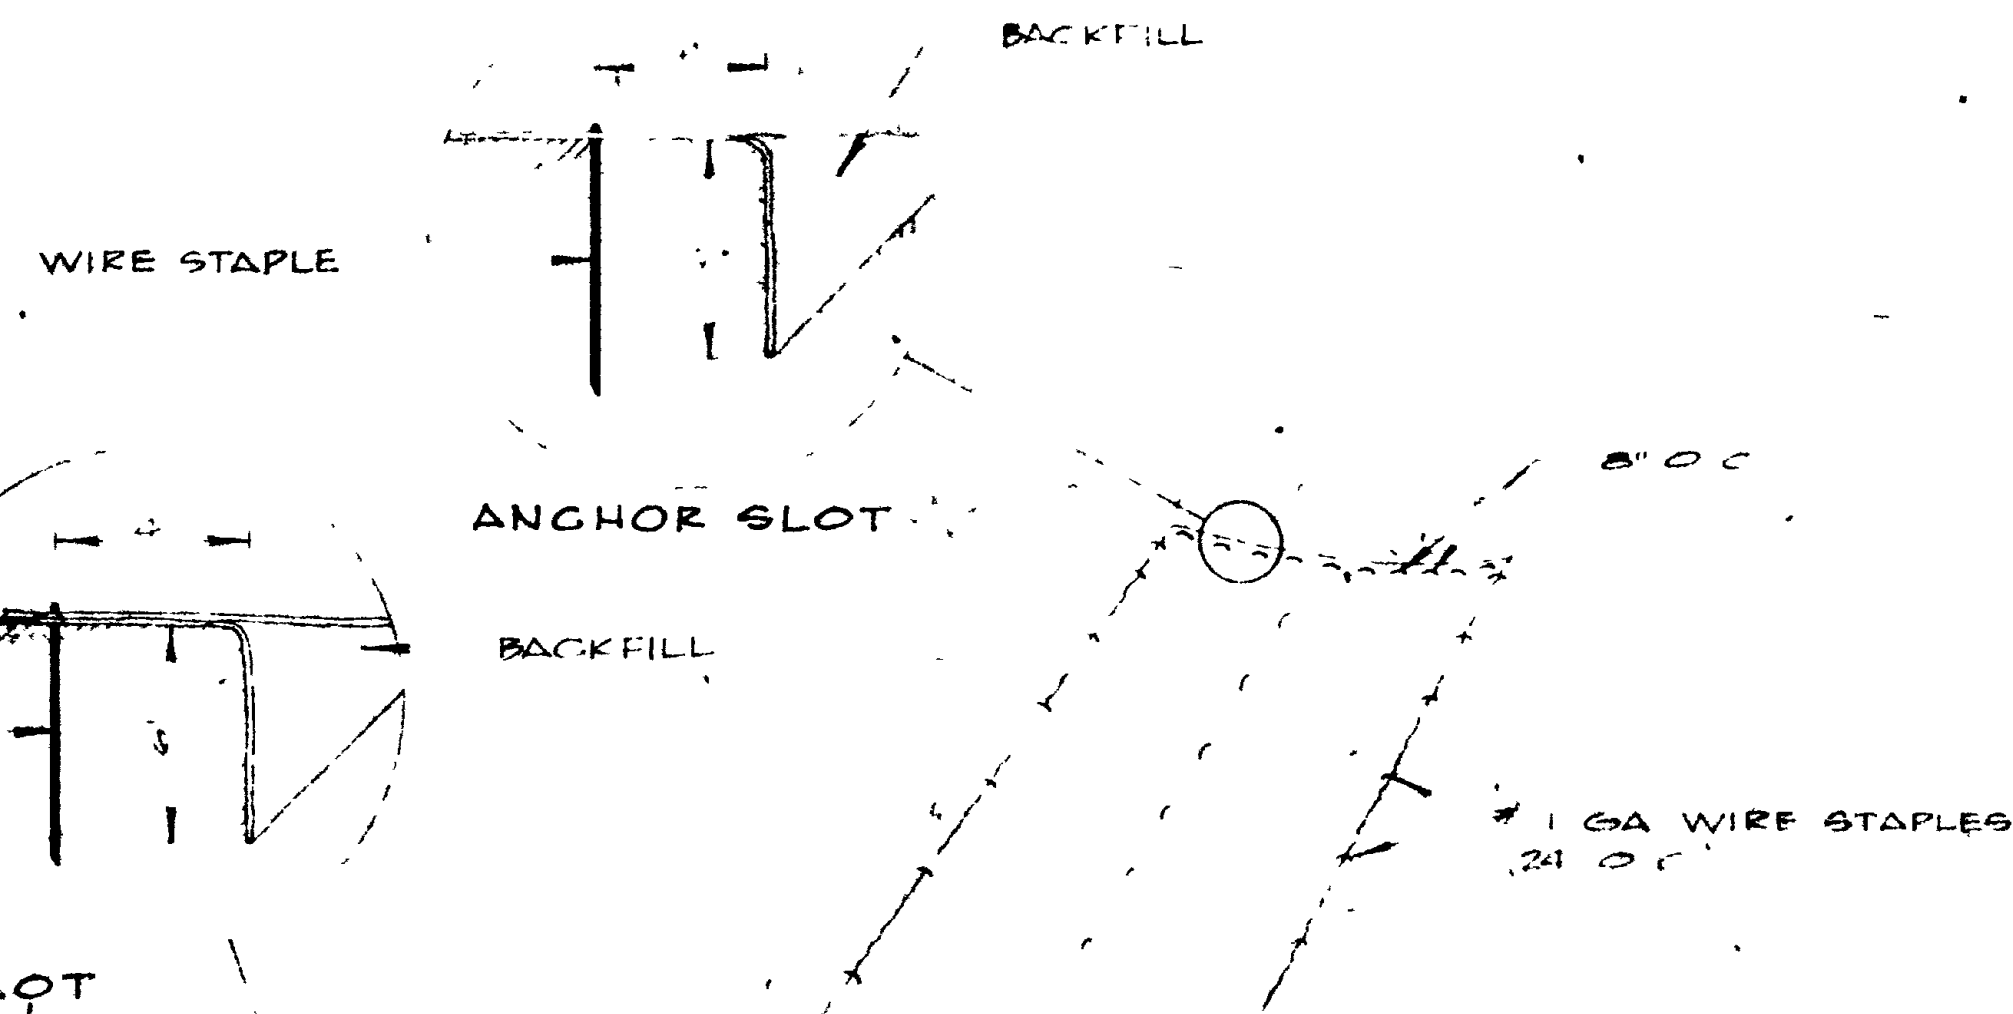


CHECK SLOT
 PLACED EVERY 15 FT

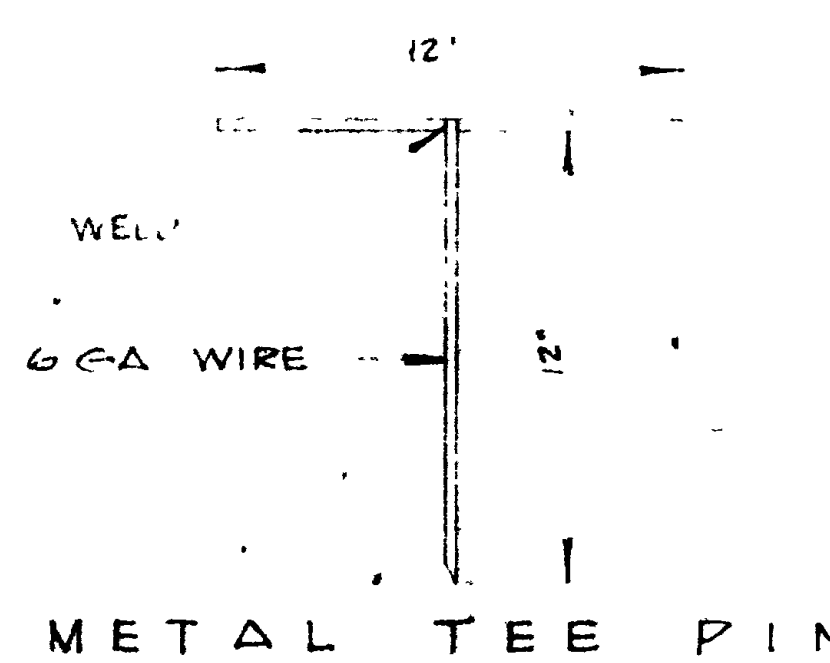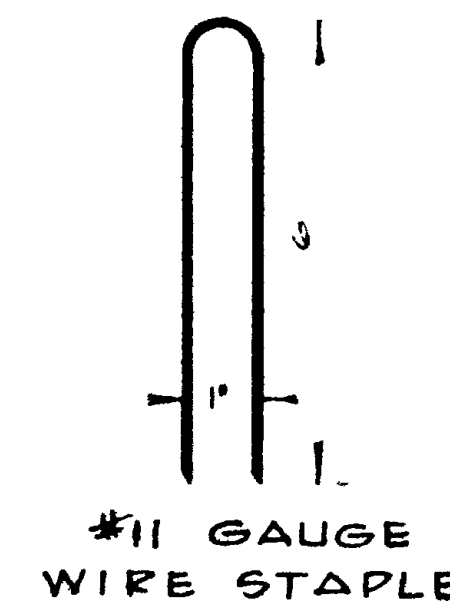


JUTE MESH IN DRAINAGE CHANNELS

GLASS FIBER MAT IN DRAINAGE CHANNELS

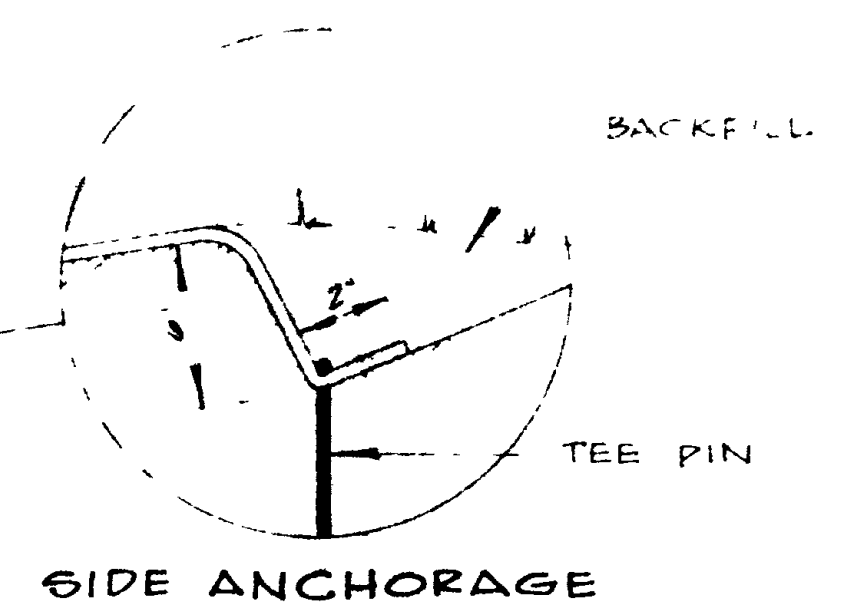


7-15-3(21)334 2nd Cont	5	
------------------------	---	--

AREA NO	STA TO STA	ACRES FLAT	ACRES SLOPE	ACRES WEED CONTROL	GRASS SEEDING				ACRES MULCH	MOWING		SQ YDS CUT MECH	SQ YDS BLANK FIBER MAT	SQ YDS GLASS FIBER ROVING METHOD "A"	SQ YDS GLASS FIBER ROVING METHOD "B"	TREES PLANTED															
					ACRES METHOD "A"	ACRES METHOD "B"	ACRES METHOD "A" MODIFIED	ACRES METHOD "B" MODIFIED		ACRES FLAT	ACRES SLOPE					RUSSIAN OLIVE "A"	MALE GREEN ASH "B"	THORN-HORNED LARIX "C"	AMERICAN JUNIPER "D"	SCOTT'S PINE "E"	AMERICAN PINE "F"	LARCH "G"	RED CEDAR "H"	DOUGLASS PINE "I"	WHITE PINE "J"	PITZER JUNIPER "R"	SMOOTH SUMAC "S"				
56	836+00	855+00	99	1.70	2.69	.99	1.70			2.69	297	510						12	7				6					20			
57	836+00	854+00	.73	.65	1.38	.73	.65			1.38	219	1.95																			
58	836+00	853+00	.90	.88	1.78	.90	.88			1.78	270	2.64						14					10					15			
59	857+00	869+00		2.06	2.58		2.58			2.06		6.18																			
60	856+00	869+00	.87		.87	.87				.87	2.61															10	6				
61	833+00	870+00	95	.37	1.73	95	.76			1.32	2.85	1.11										3									
62	856+00	864+00	47	1.54	2.01	47	1.54			2.01	1.41	4.62					3					6						3			
63	860+00	869+50		.93	.93		.93			.93		2.79												3							
64	863+00	870+00	2.68	1.10	3.78	2.68	1.10			3.78	8.04	3.30										9	3								
65	870+00								NO TREATMENT REQUIRED																						
66	870+00	881+00	.70	.97	1.60		.70	.90	1.60													6	4					24	5	10	
67	870+00	903+00	.25	2.36	2.61		.25	2.36	2.61				10								4		12								
68	871+00	904+00	3.39		2.20		2.20		2.20																						
69	870+50	912+00	1.94	.97	2.91		1.94	.97	2.91									18													
70	870+50	910+00	18.03	2.76	4.75		18.03	2.76	20.79				40					10				4	8							40	
71	900+00	908+00	31	.15	.46		.31	.15	.46				15							2								5	10		
72	901+00	912+00	3.86	.15	4.01		3.86	.15	4.01											6		2									
73	903+50	911+00	5.18	.40	5.58		5.18	.40	5.58				21							4	5	8	3					7	15		
74	903+00	954+50	6.38	1.47	7.85		6.38	1.47	7.85									22	16	50		11									
75	905+50	955+00	3.39		3.39		3.39		3.39																						
76	906+00	956+00	10.57	5.06	15.63		10.57	5.06	15.63				406.67				25			49		1									
77	947+00	959+00	.94		.94		.94		.94																						
78	955+00	965+00	10.45	5.15	16.21		10.45	5.76	15.60								34							28	7						
79	955+50	964+00	.60		.60		.60		.60																						
80	956+00	963+00	3.11	.72	3.83		3.11	.72	3.11																						
81	959+00	972+00	1.49	.79	2.28		1.49	.79	2.28								8					6									
82	965+00	990+00	3.14	1.75	4.89		3.14	1.75	4.89				80.00							13		3									
83	965+00	1040+00	5.22		5.22		5.22		5.22																						
84	959+00	1040+00		8.14	8.14		8.14		8.14								2			38								16			
85	960+00	1039+00	6.14	1.14	.57		6.14	1.14	7.28																						
TOTALS																	72	76	90	99	5	88	49	7	10	84	17	75			
										SUPPLEMENTAL AGREEMENT #3																					
										METER NUMBER	2" GALV STEEL PIPE	1 1/2" GALV STEEL PIPE	1 1/2" CONTROL VALVES	1 1/2" STOP & WASTE VALVE	SEASONAL STORAGE OF TREES SA #2																
										O	1500	1241	3	1	INVOICE	RUSSIAN OLIVE	MALE GREEN ASH	GOLDEN RAIN TREE	LONDON PLANE TREE	CAROLINA POPLAR	SMOOTH SUMAC										
										P		441	1	1	NUMBER																
										Q	630	1162	1	1	82675	10						10									
										N	1938.5	5349.5			82671	42	2														
										O	1700.0	3160.0			82667	12	27	4	12	7	5										
										P	399.0	483.0			31212	26			1		3										
										Q	1285.0	2637.0			30961		8	3	20												
										R	882.0	2360.0			62664		28	5	31												
										TOTALS	7482.5	15648.5			82670			10			40										
														FURNISHING CONSTRUCTION SIGNS	FLAGGING	GRAND TOTAL															
														STA TO STA	LUMP SUM	MAN HOUR	SUPPLEMENTAL AGREEMENT #4														
														836+15	1040+00	100%	1" GALV STEEL PIPE 1302 LINE FT														
																		836+15	1040+00		51	114 GALV STEEL PIPE 81 LINE FT									

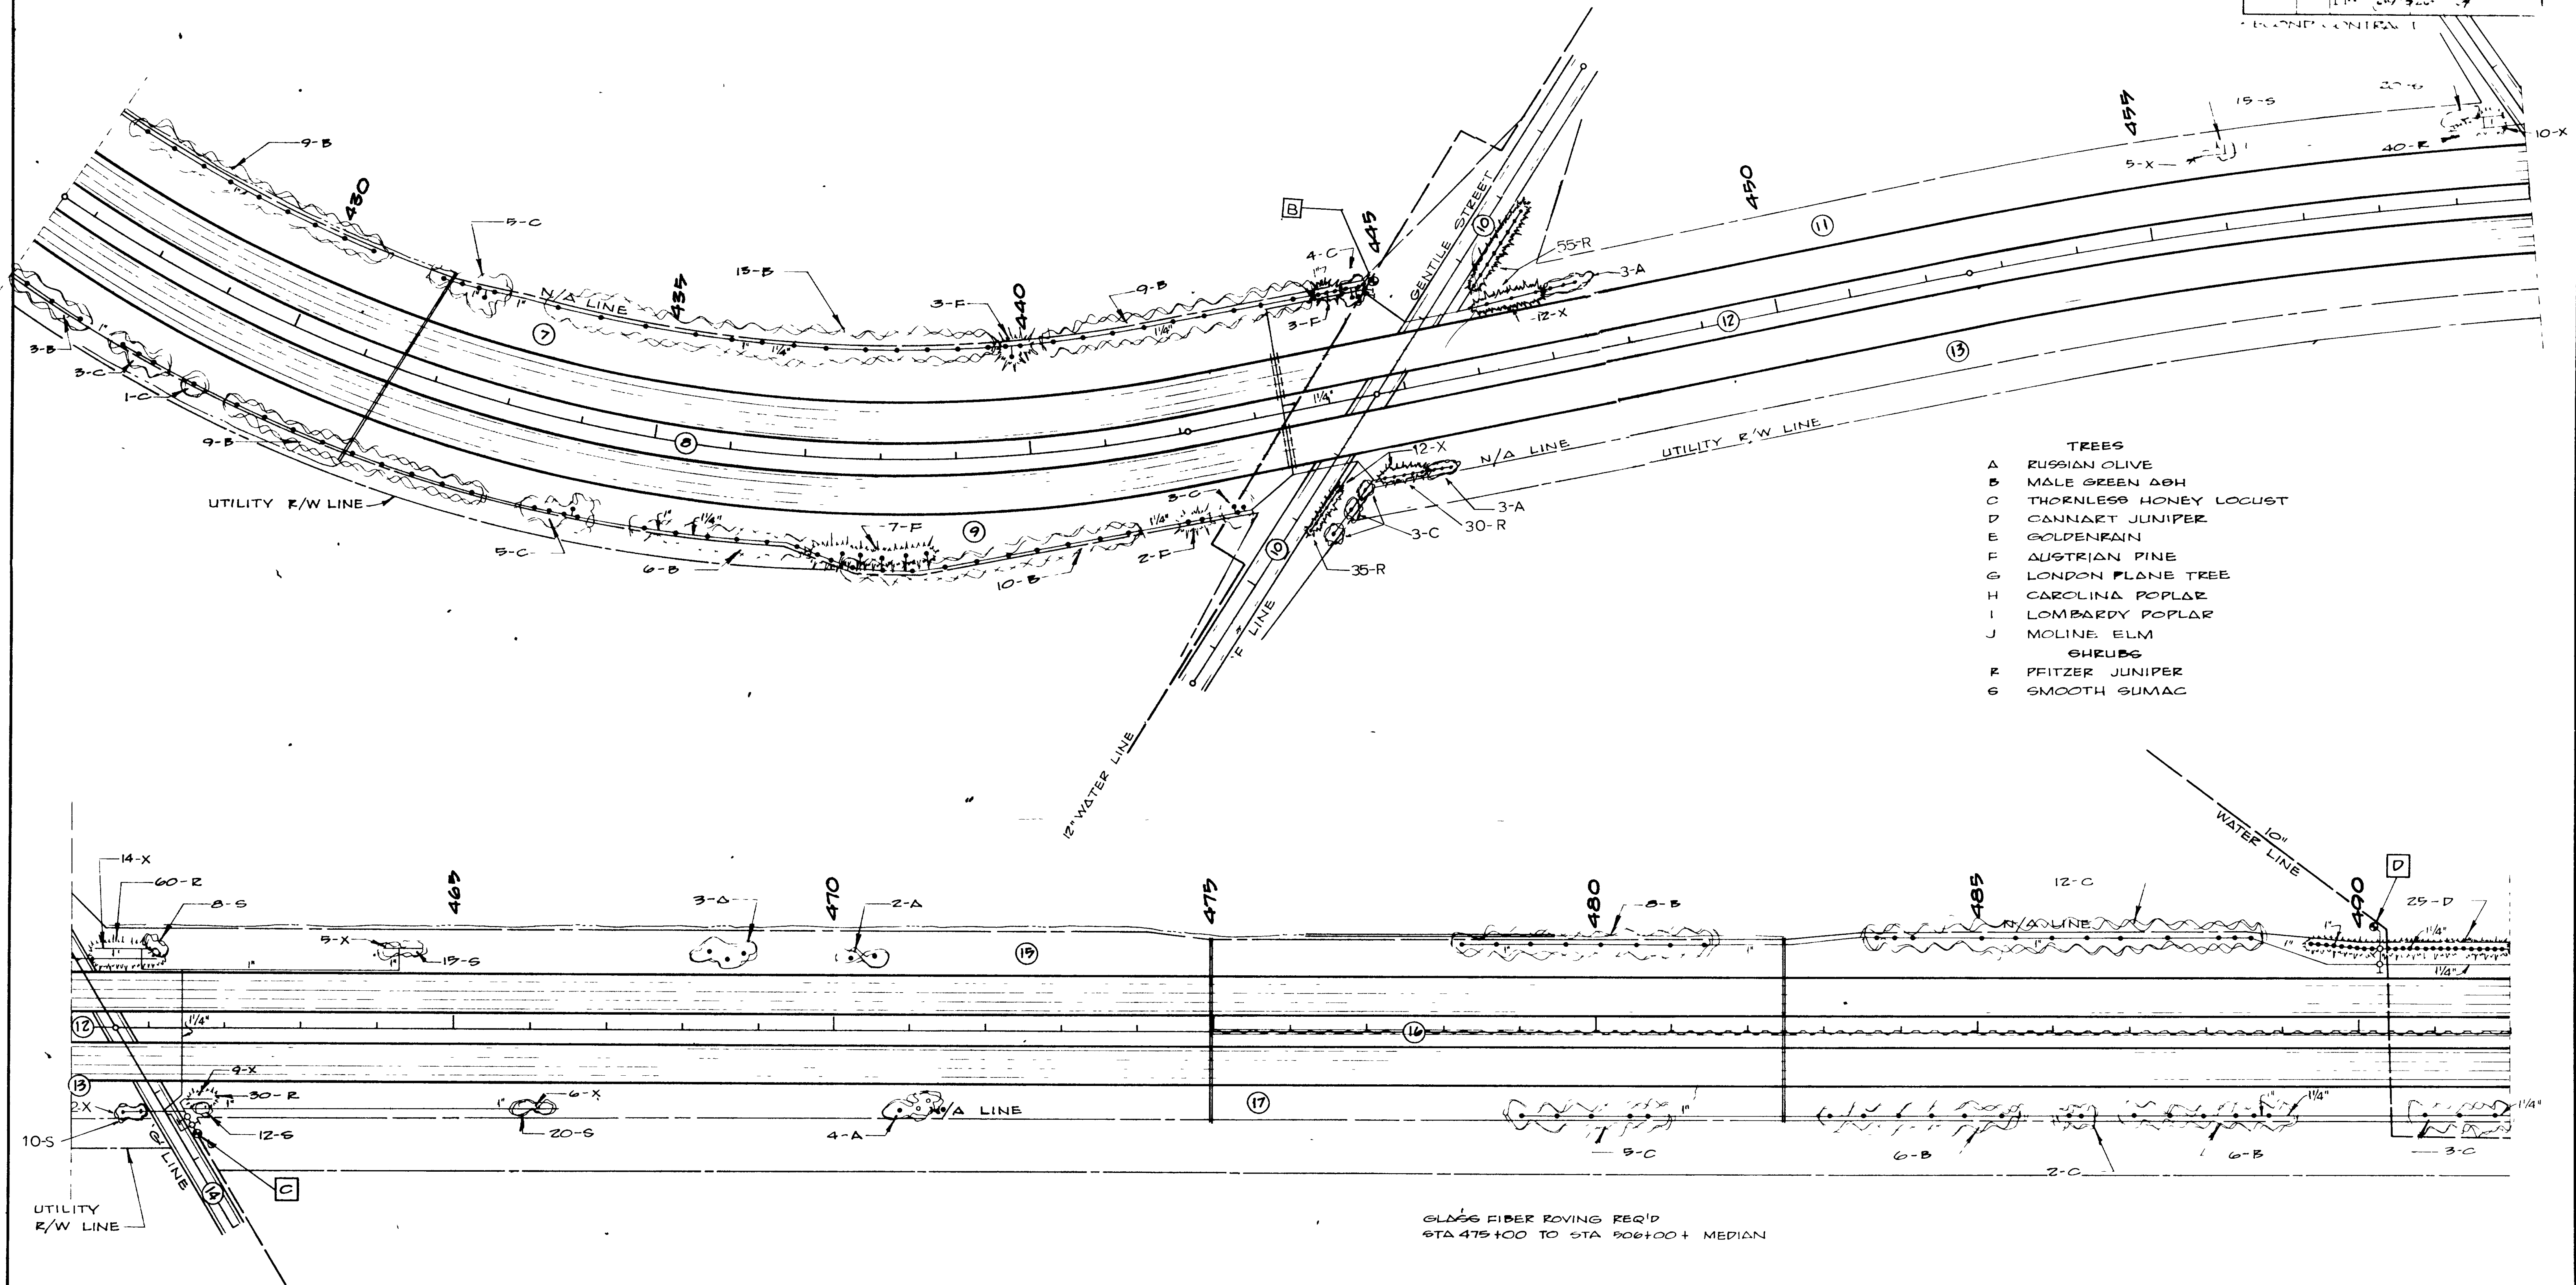


REVISIONS	DATE	BY

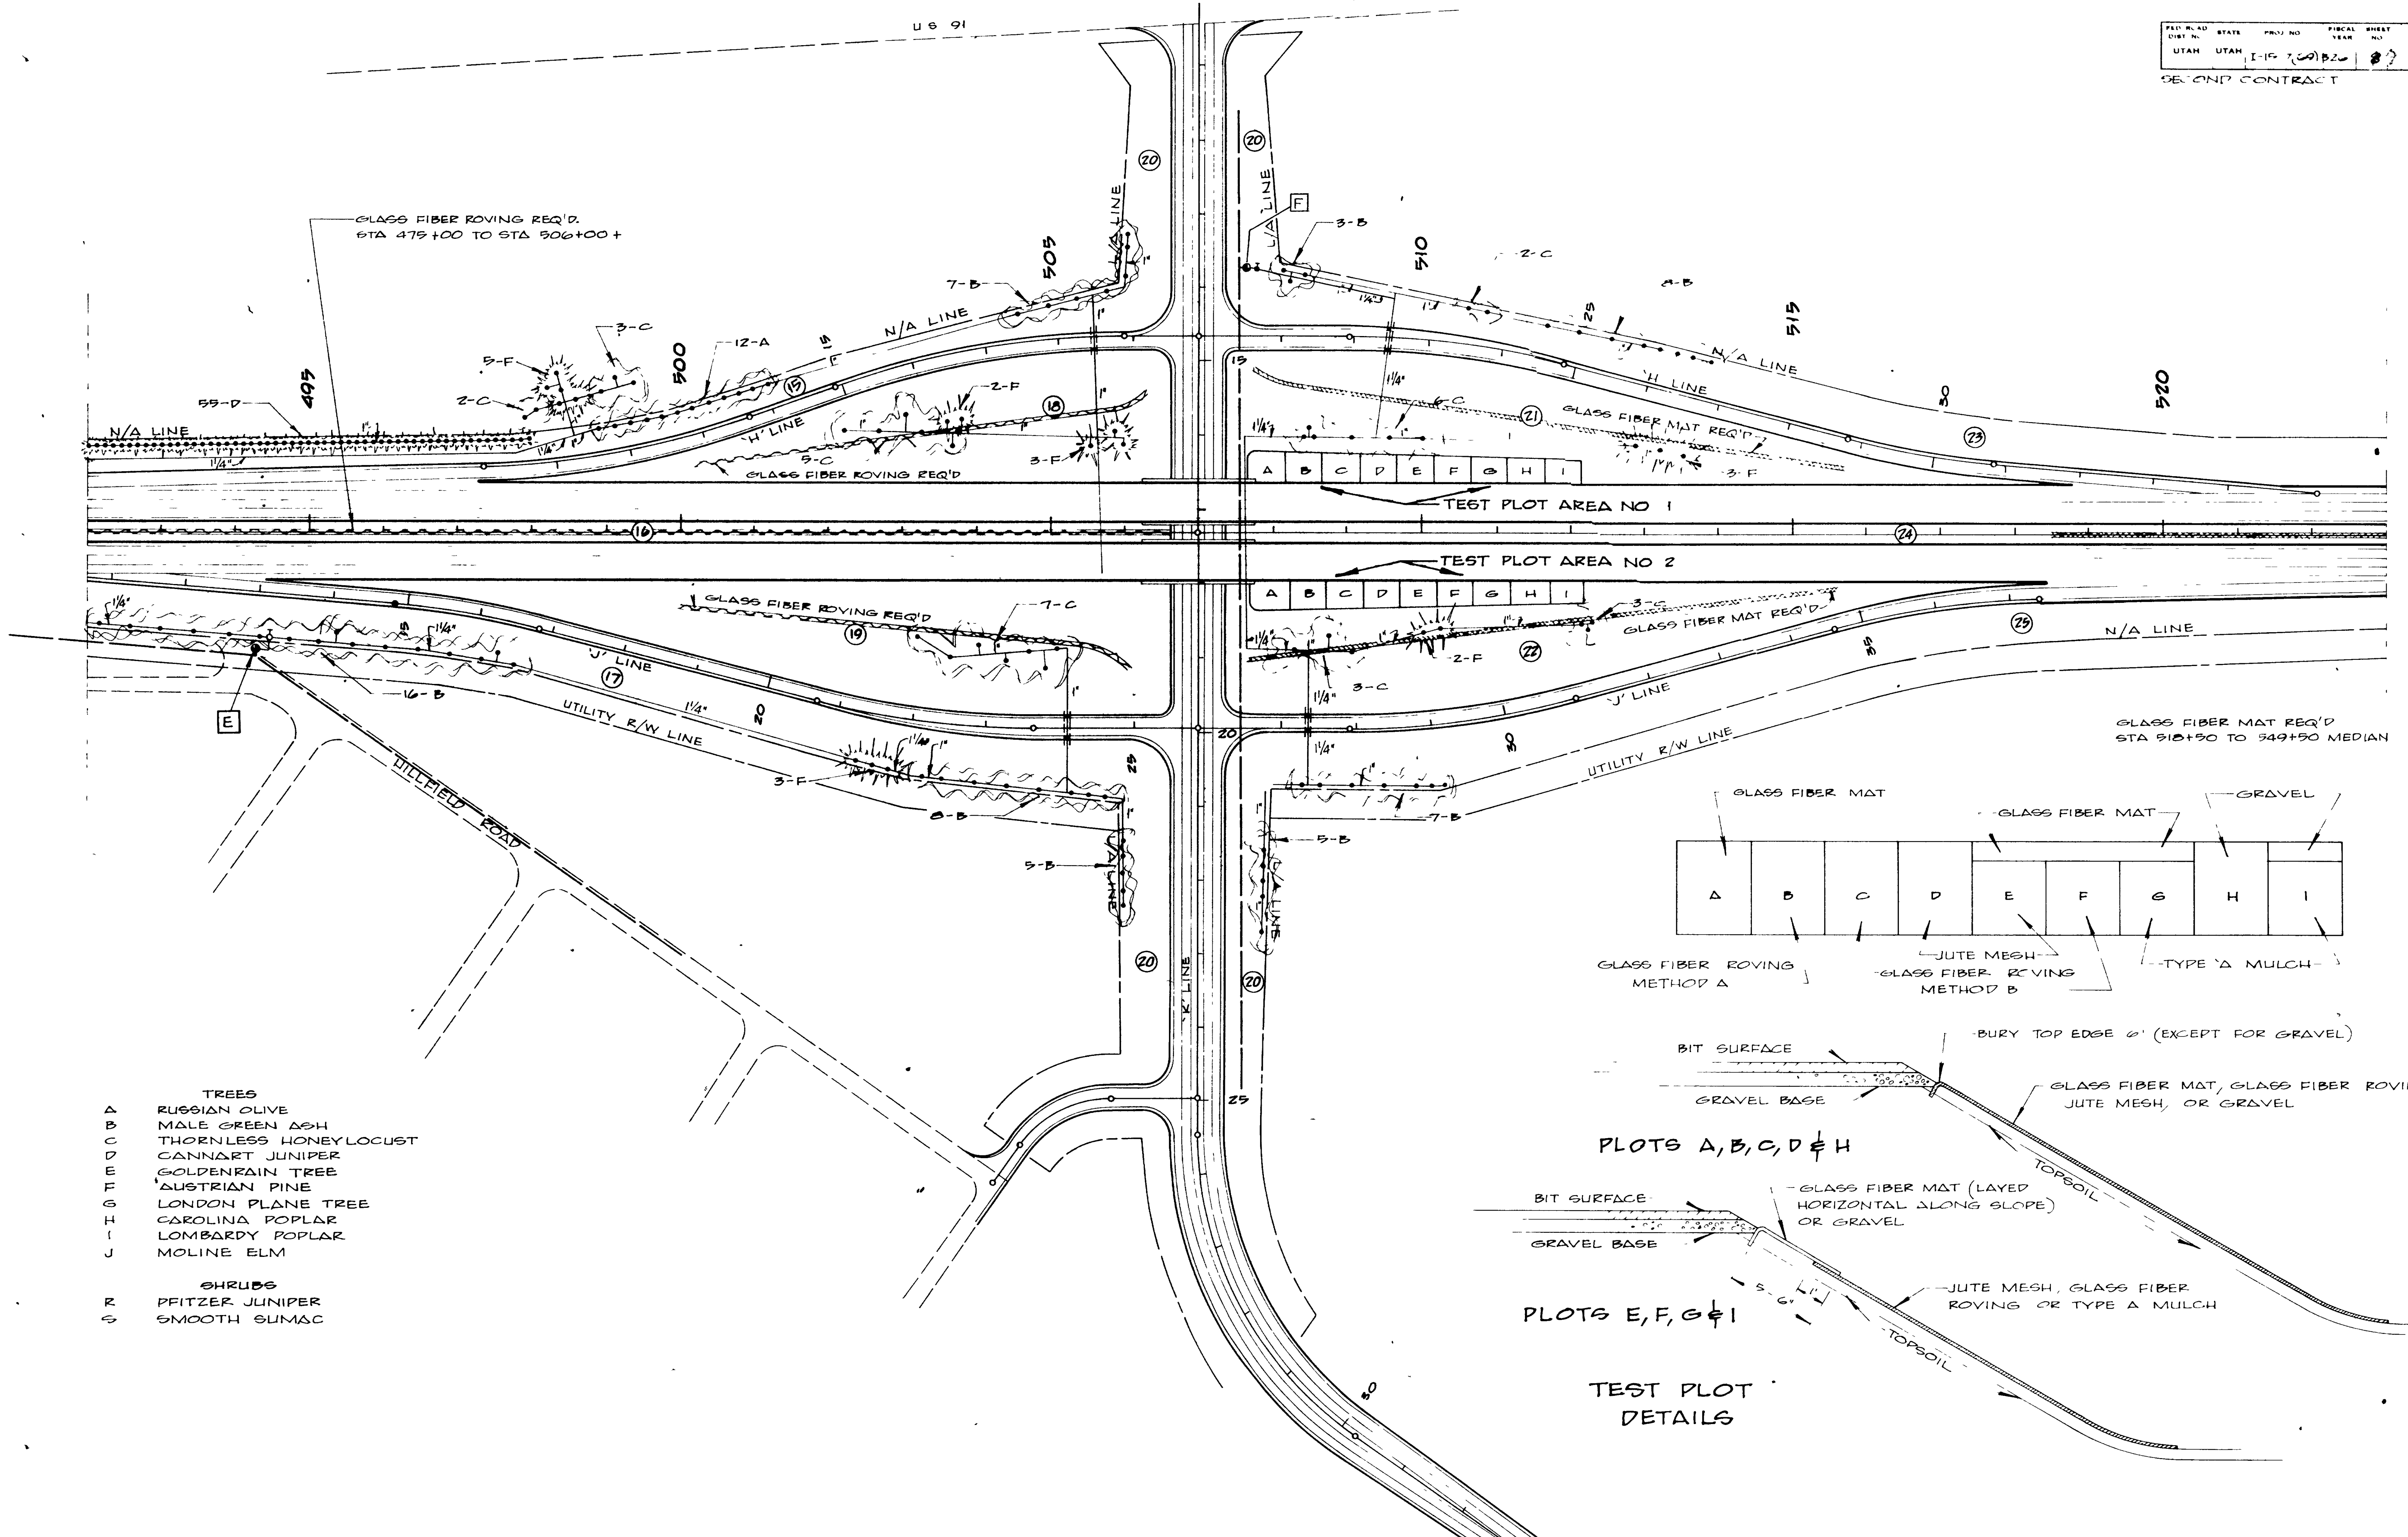

- TREES**
- A RUSSIAN OLIVE
 - B MALE GREEN ASH
 - C THORNLESS HONEYLOCUST
 - D CANNART JUNIPER
 - E GOLDENRAIN TREE
 - F AUSTRIAN PINE
 - G LONDON PLANE TREE
 - H CAROLINA POPLAR
 - I LOMBARDY POPLAR
 - J MOLINE ELM
- SHRUBS**
- R PFITZER JUNIPER
 - S SMOOTH SUMAC

FED. ROAD DIST. NO.	STATE	PROJ. NO.	FISCAL YEAR	SHEET NO.	TOTAL SHEETS
UTAH	UTAH	I-15-8(21)34		16	


SECOND CONTRACT 16

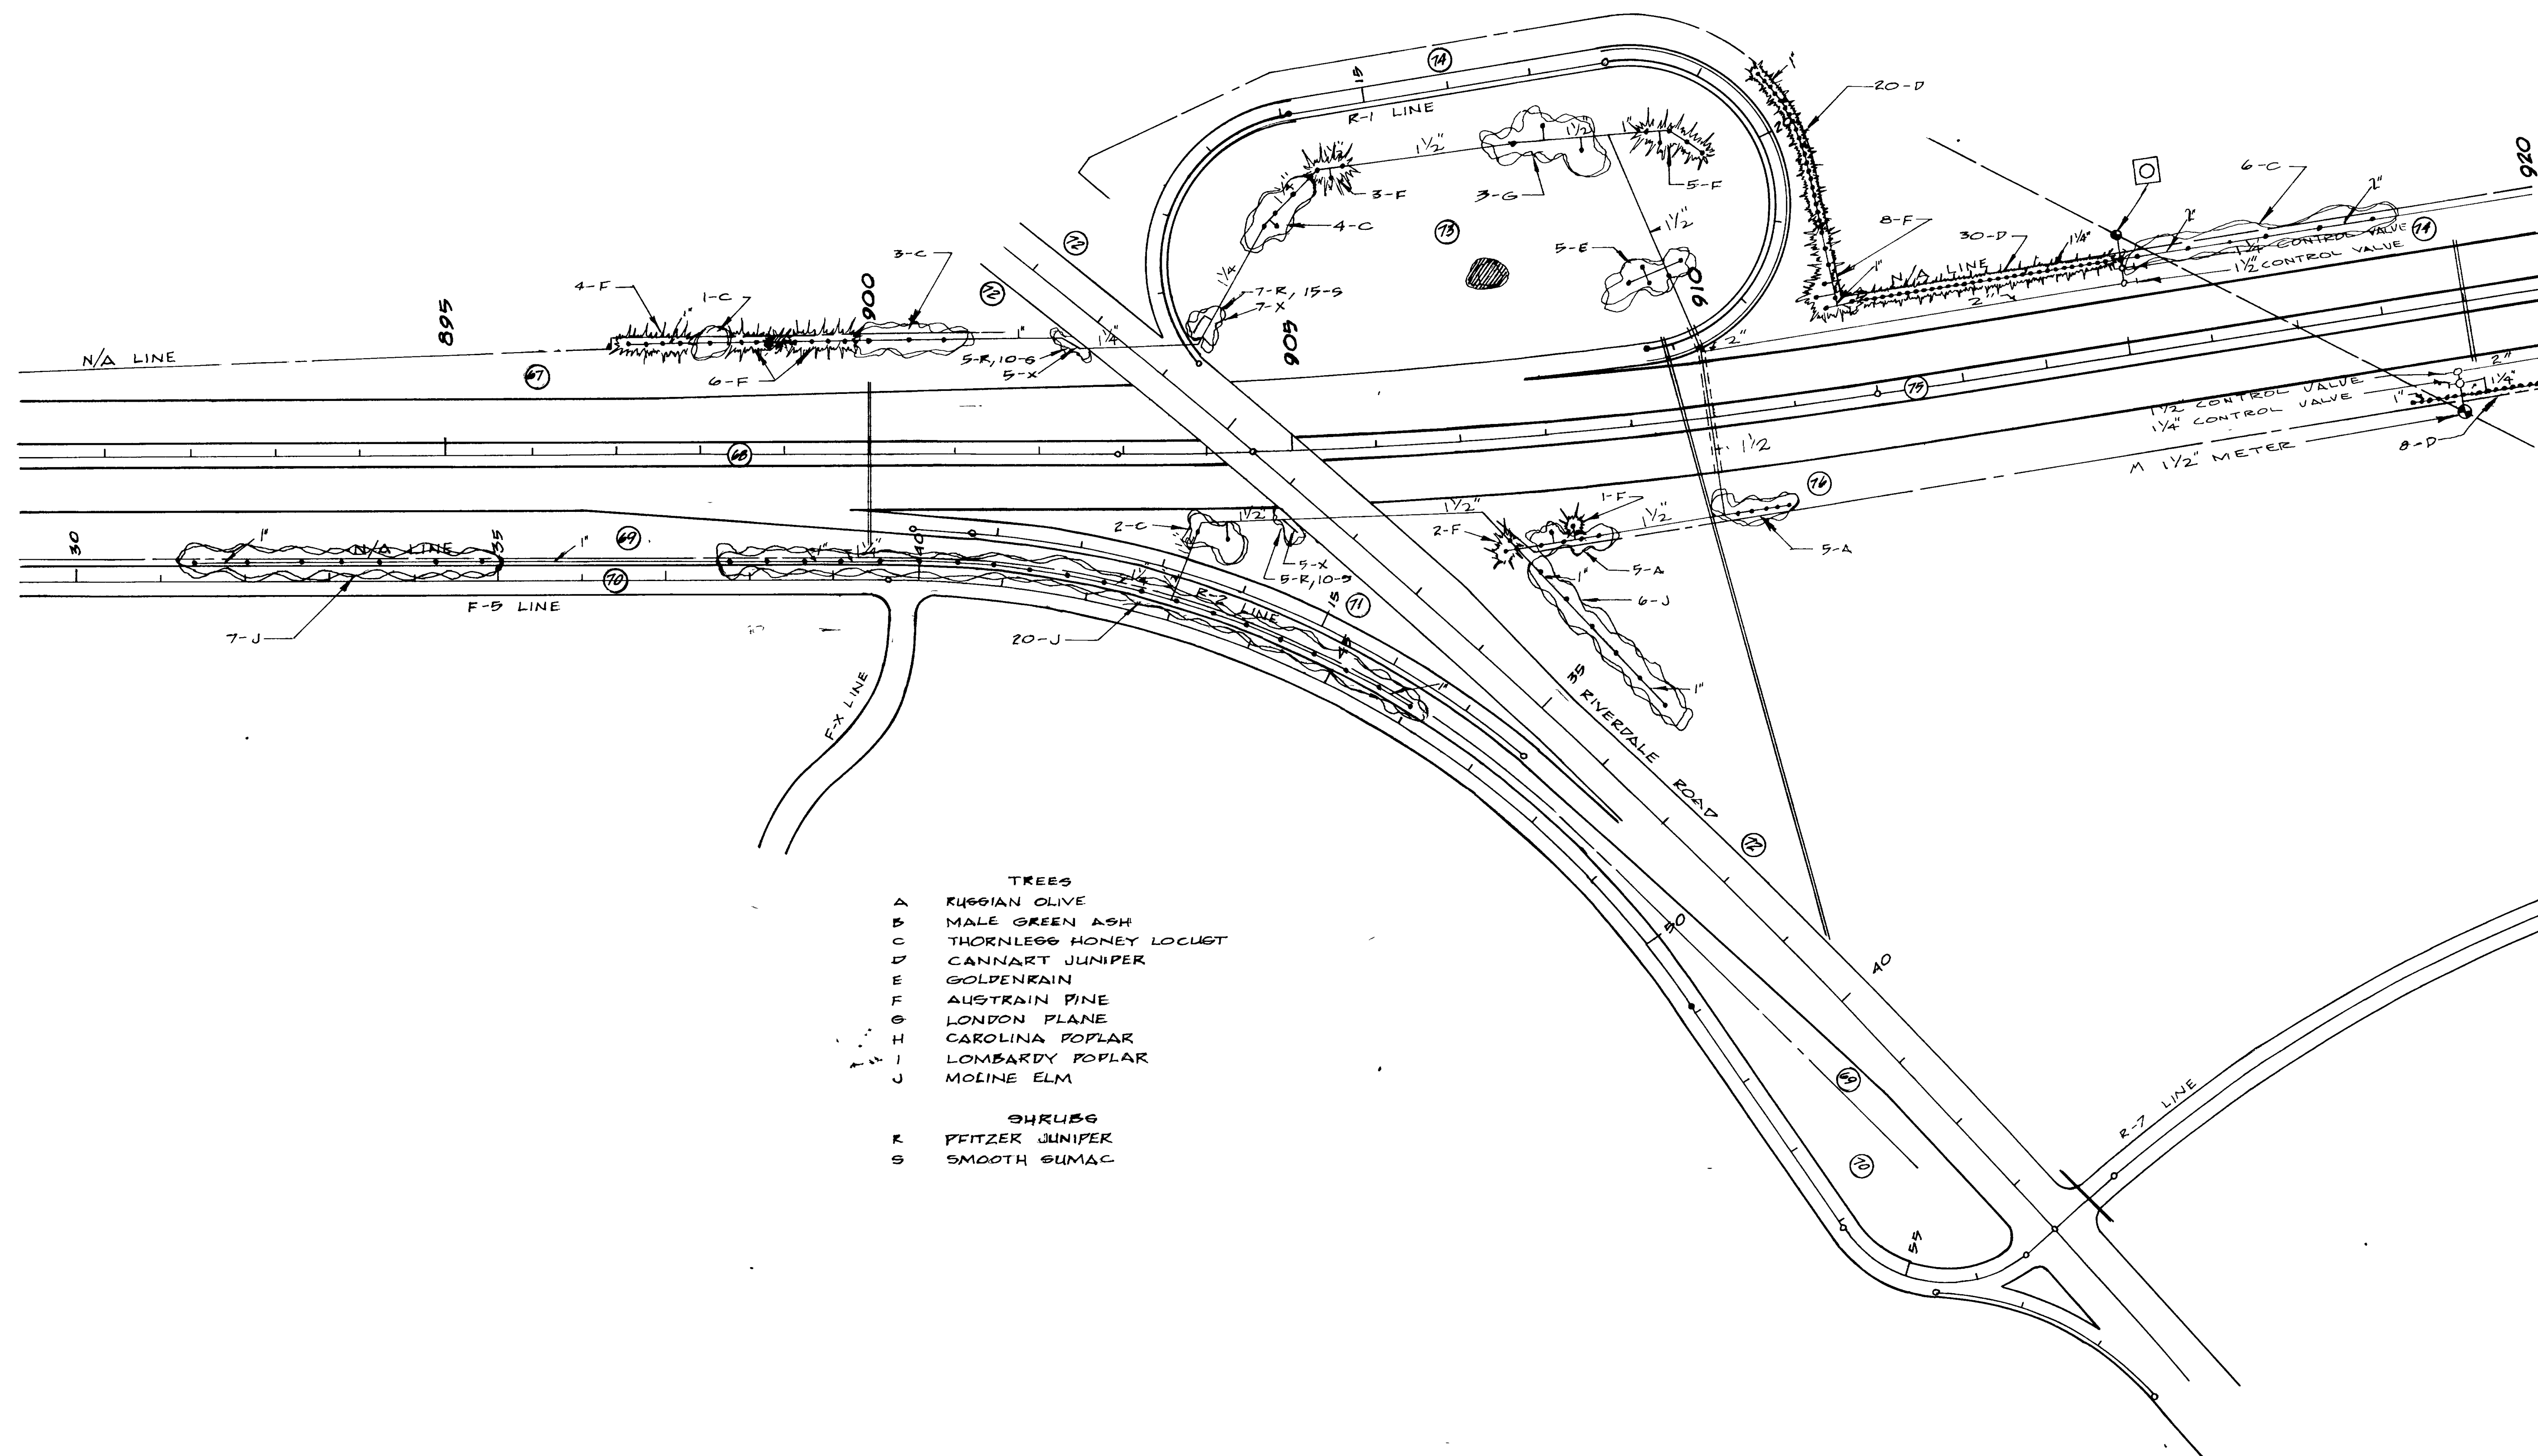

- TREES
- A RUSSIAN OLIVE
 - B MALE GREEN ASH
 - C THORNLESS HONEY LOCUST
 - D CANNART JUNIPER
 - E GOLDENRAIN
 - F AUSTRALIAN PINE
 - G LONDON PLANE
 - H CAROLINA POPLAR
 - I LOMBARDY POPLAR
 - J MOLINE ELM


- SHRUBS
- K PEITZER JUNIPER
 - S SMOOTH SUMAC

SECOND CONTRACT 17

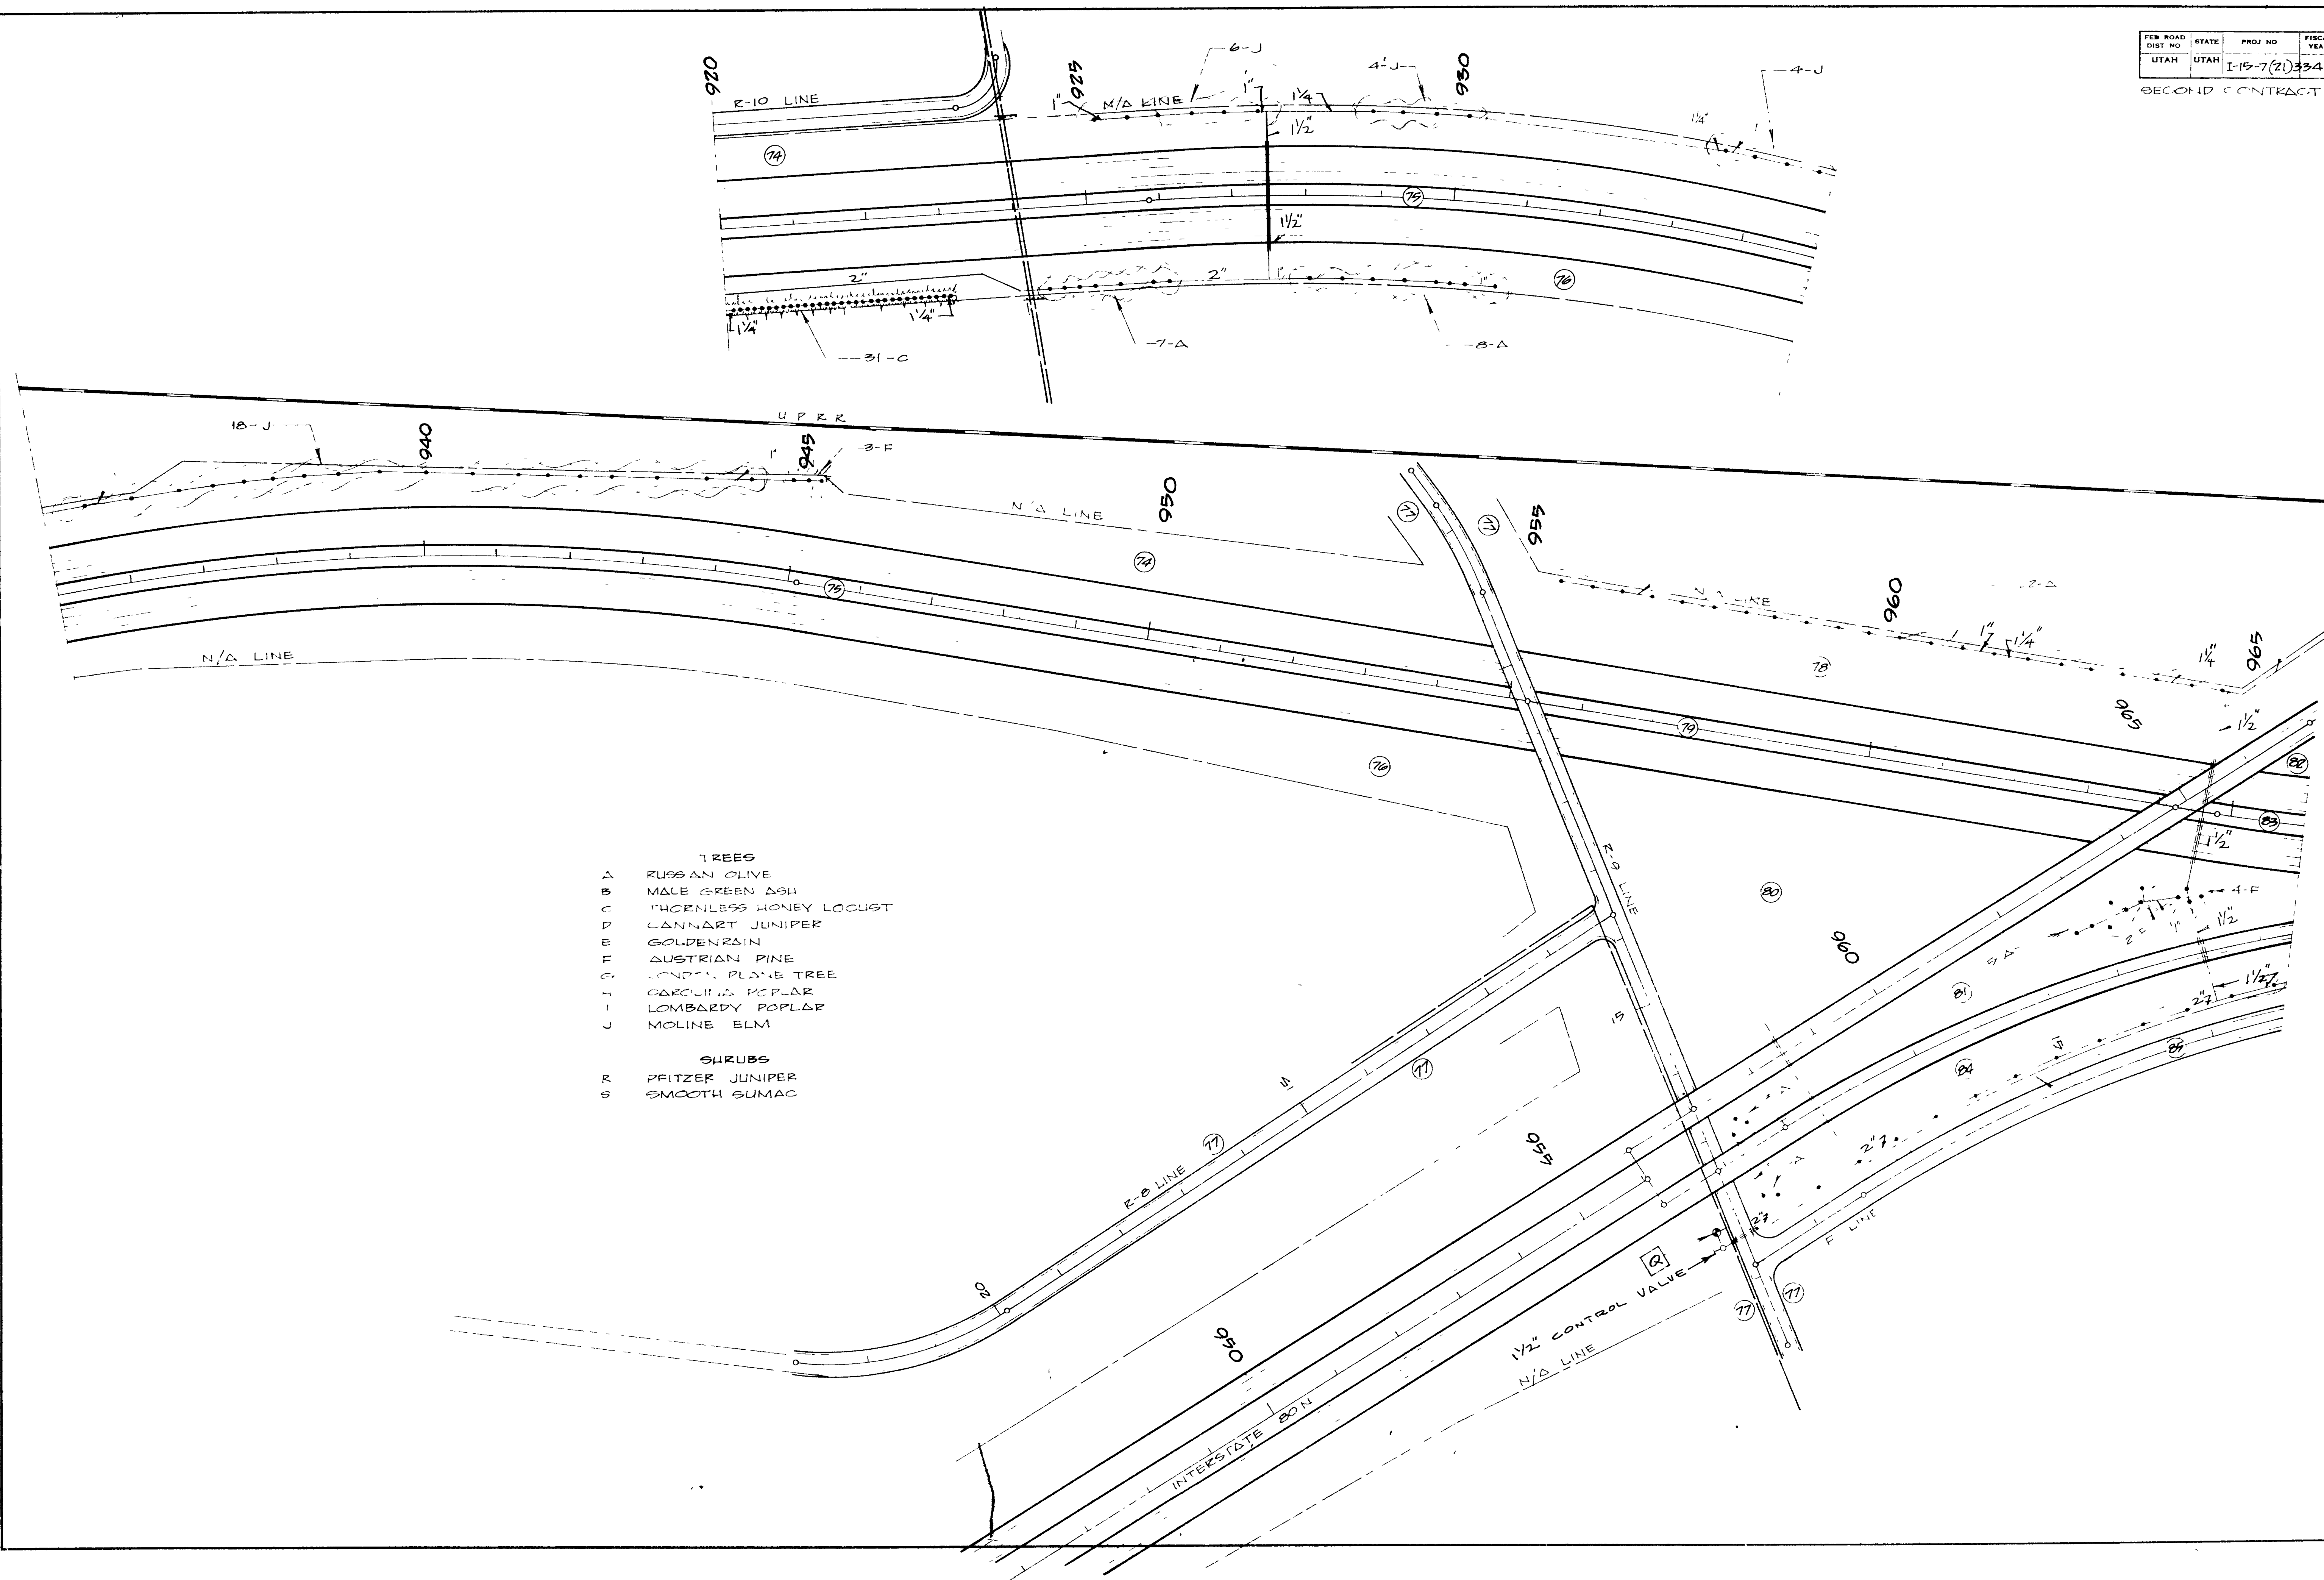

FED. ROAD DIST. NO.	STATE	PROJ. NO.	FISCAL YEAR	SHEET NO.	TOTAL SHEETS
UTAH	UTAH	I-15-2(21)	334	18	

SECOND CONTRACT 18

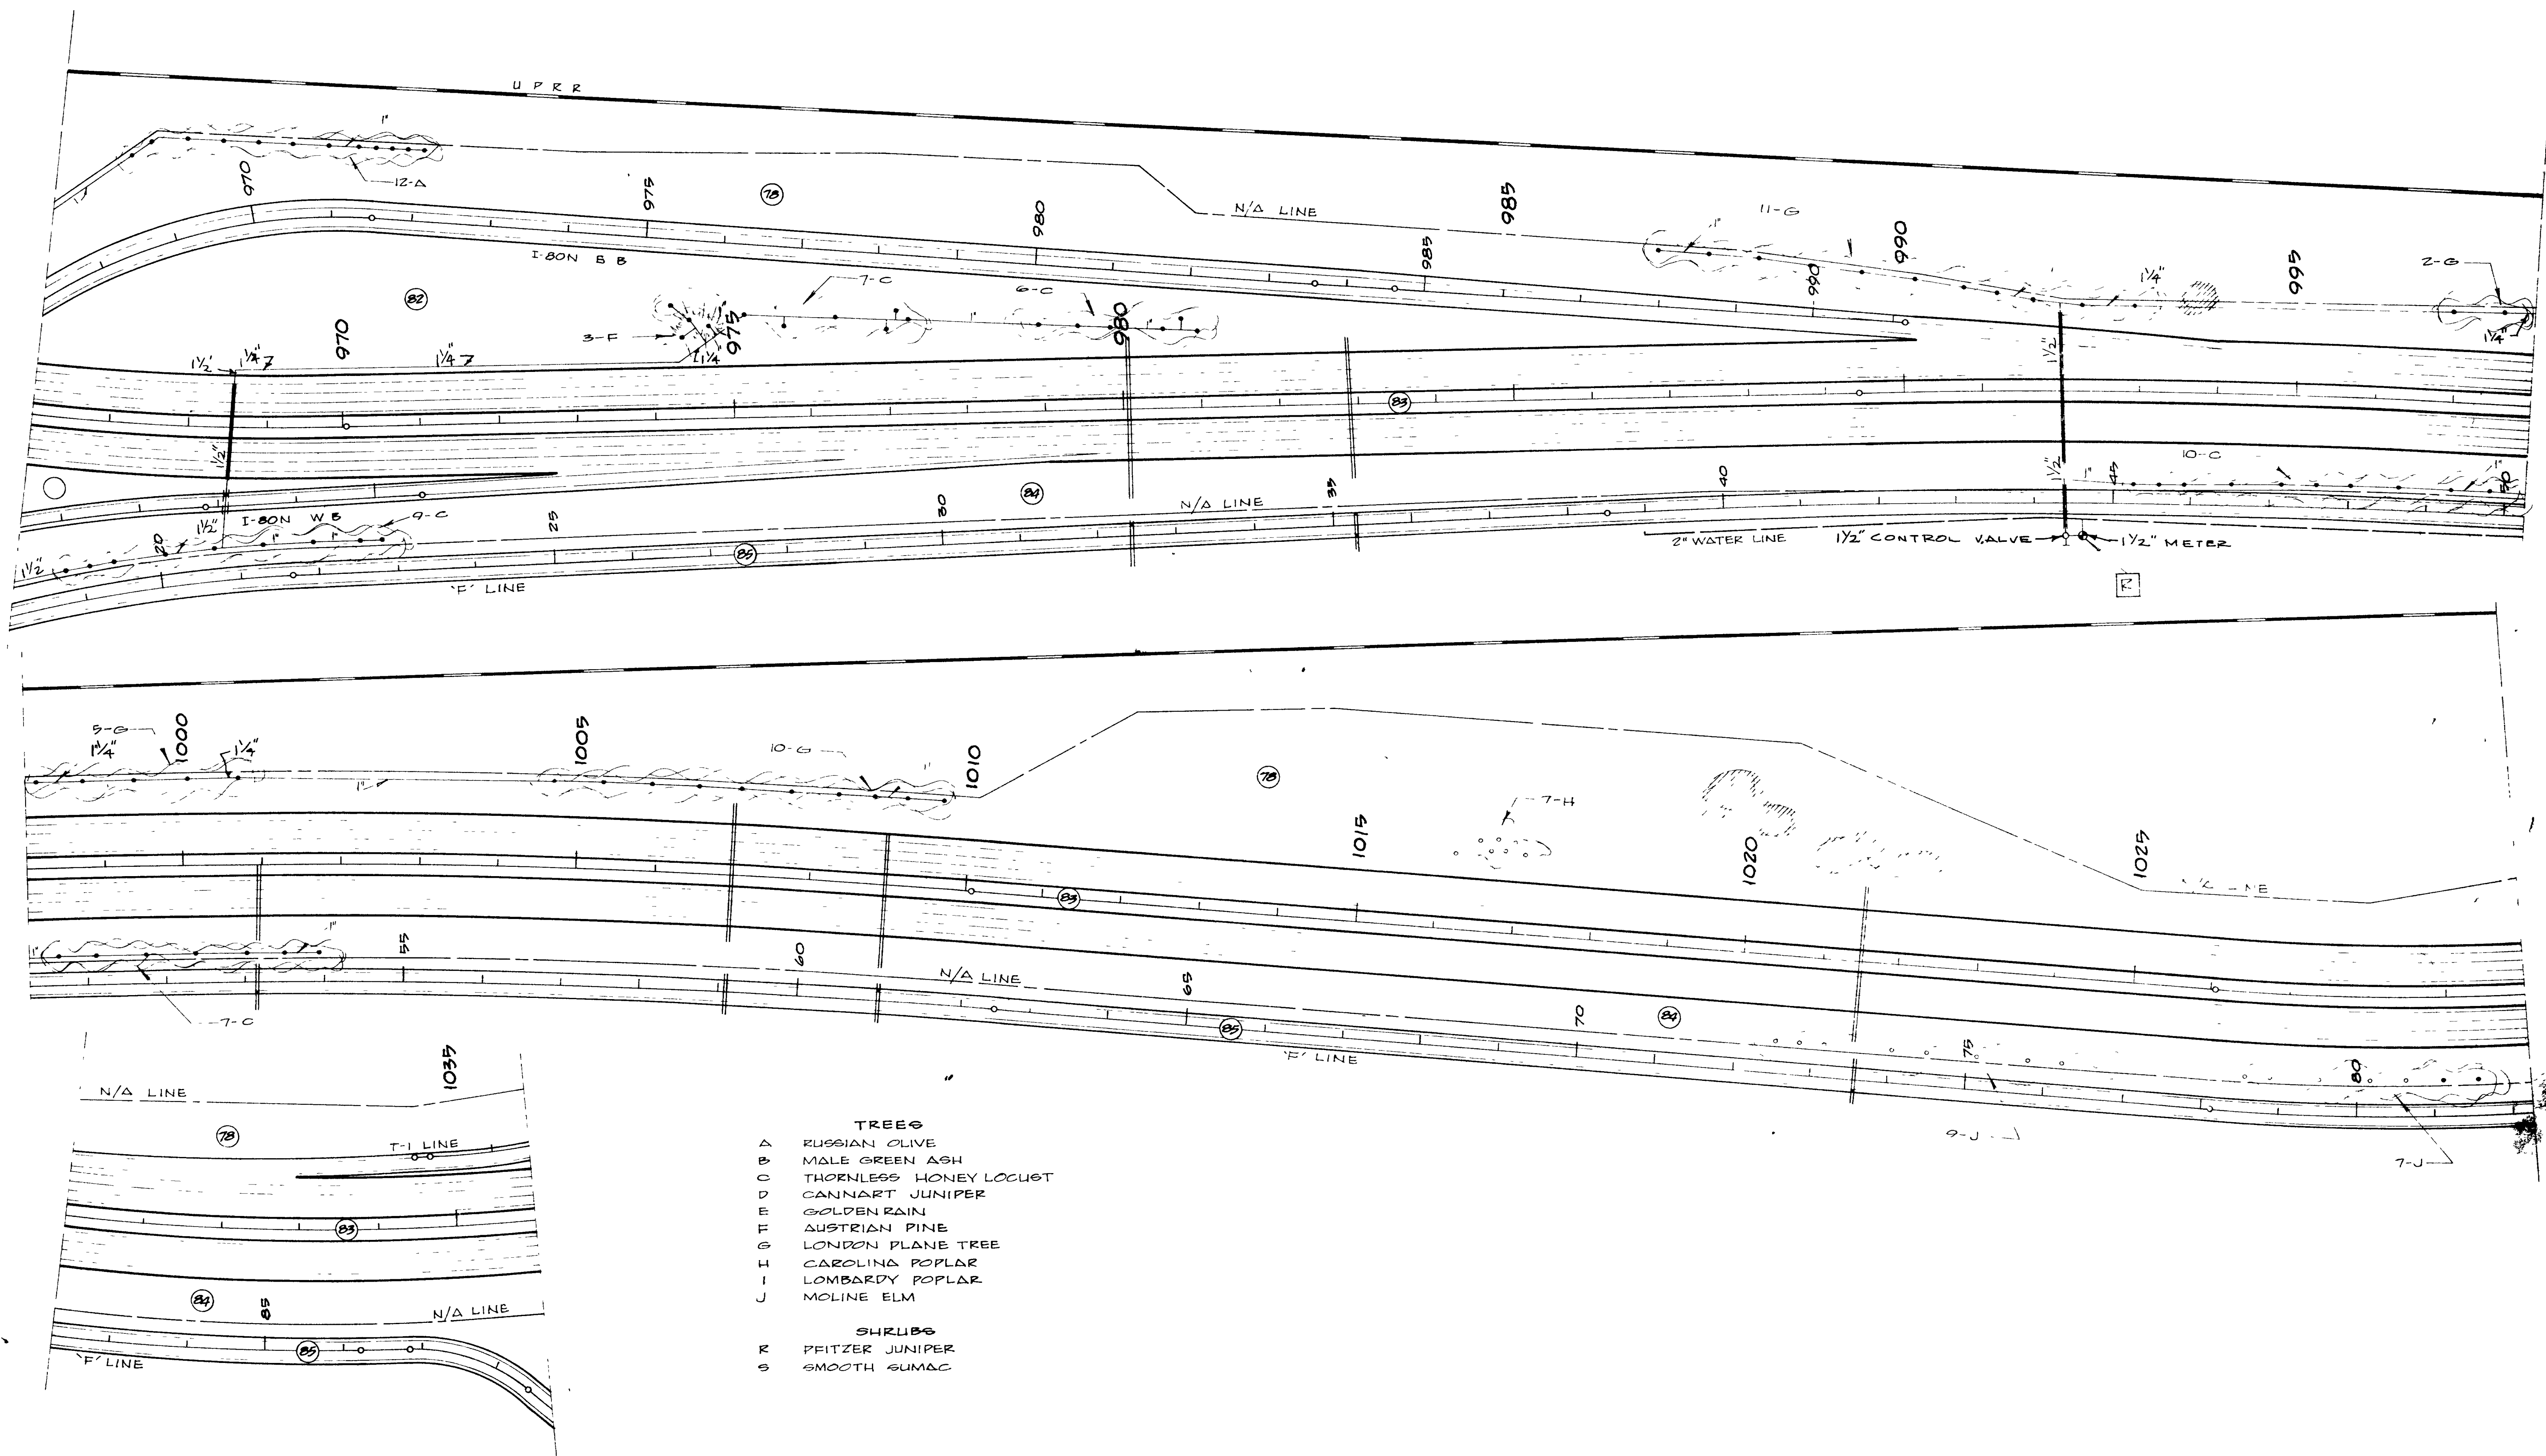


- TREES**
- A RUSSIAN OLIVE
 - B MALE GREEN ASH
 - C THORNLESS HONEY LOCUST
 - D CANNABART JUNIPER
 - E GOLDEN RAIN
 - F AUSTRIAN PINE
 - G LONDON PLANE TREE
 - H CAROLINA POPLAR
 - I LOMBARDY POPLAR
 - J MOLINE ELM
- SHRUBS**
- K PEITZER JUNIPER
 - S SMOOTH SUMAC

REVISIONS	DATE	BY

FED. ROAD DIST. NO.	STATE	PROJ. NO.	TOTAL SHEETS
UTAH	UTAH	I-15-A-21-534	19



SECOND CONTRACT

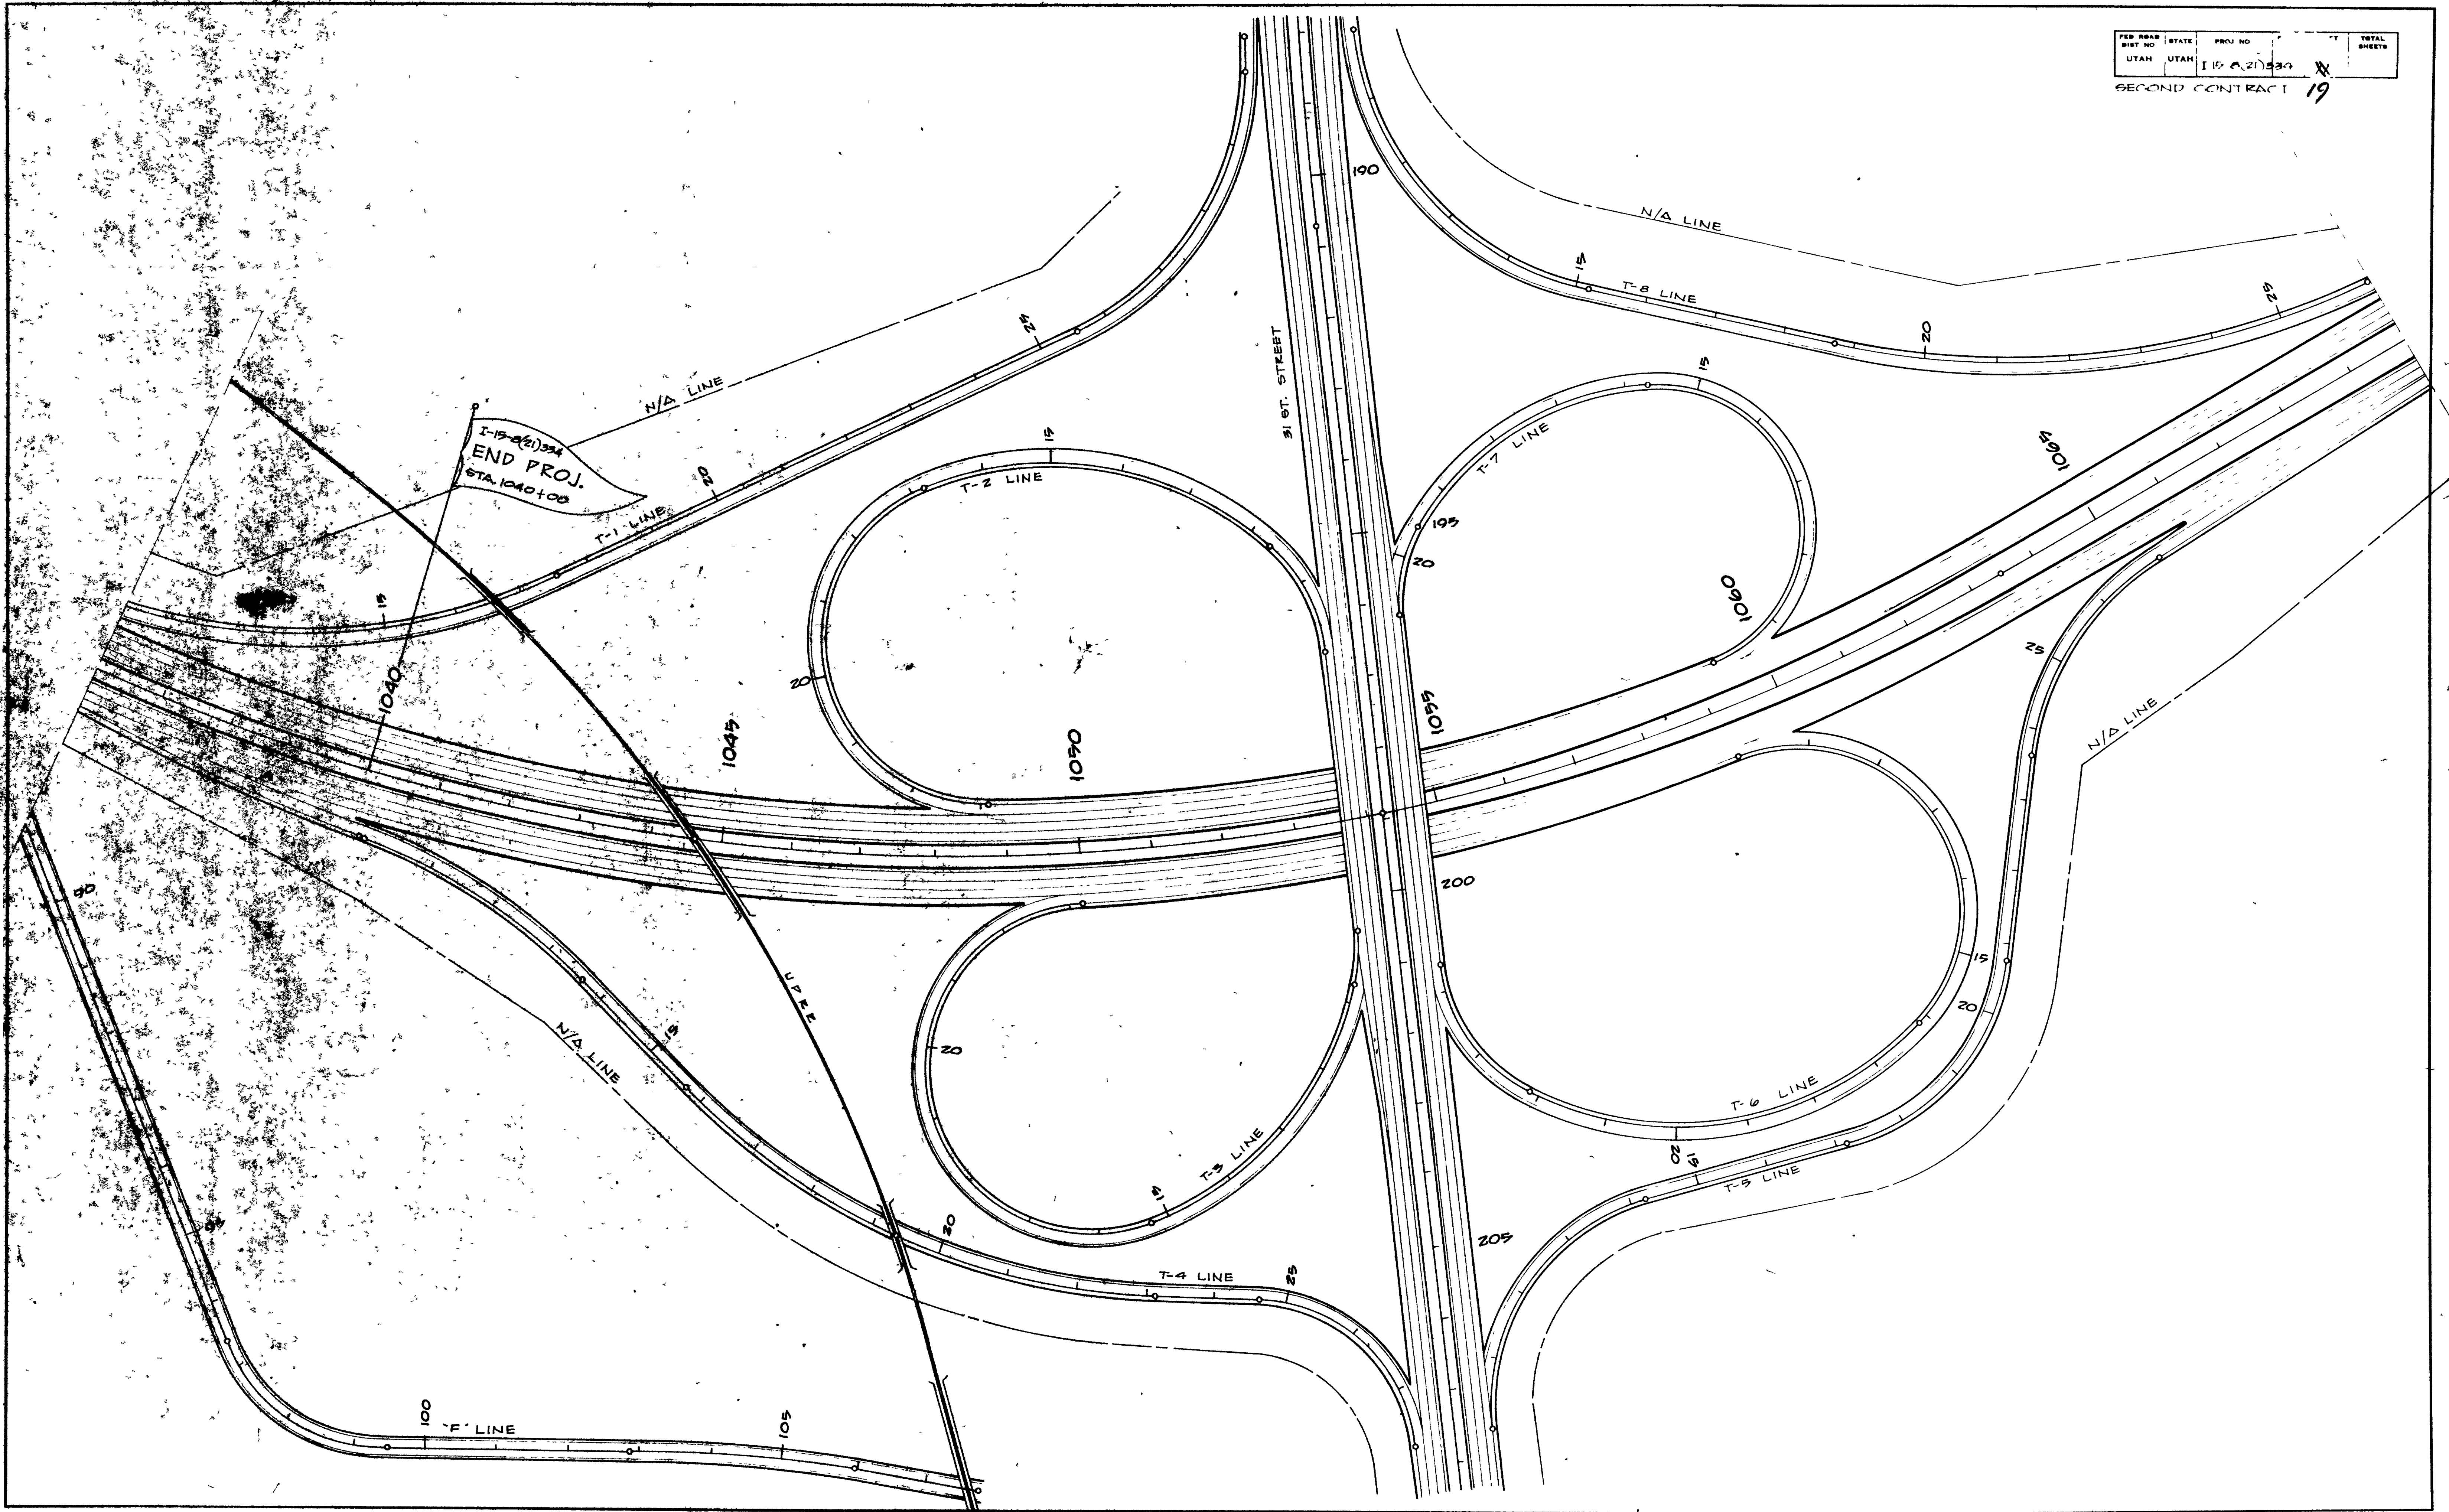

FED. ROAD DIST. NO.	STATE	PROJ. NO.	FISCAL YEAR	SHEET NO.	TOTAL SHEETS
UTAH	UTAH	I-15-7(2)326	1992	326	326

SECOND CONTRACT
I-15-8(21)334 SECOND CONTRACT


- TREES**
- A RUSSIAN OLIVE
 - B MALE GREEN ASH
 - C THORNLESS HONEYLOCUST
 - D CANNABT JUNIPER
 - E GOLDENRAIN
 - F AUSTRIAN PINE
 - G LONDON PLANE TREE
 - H CAROLINA POPLAR
 - I LOMBARDY POPLAR
 - J MOLINE ELM
- SHRUBS**
- K PFITZER JUNIPER
 - L SMOOTH SUMAC

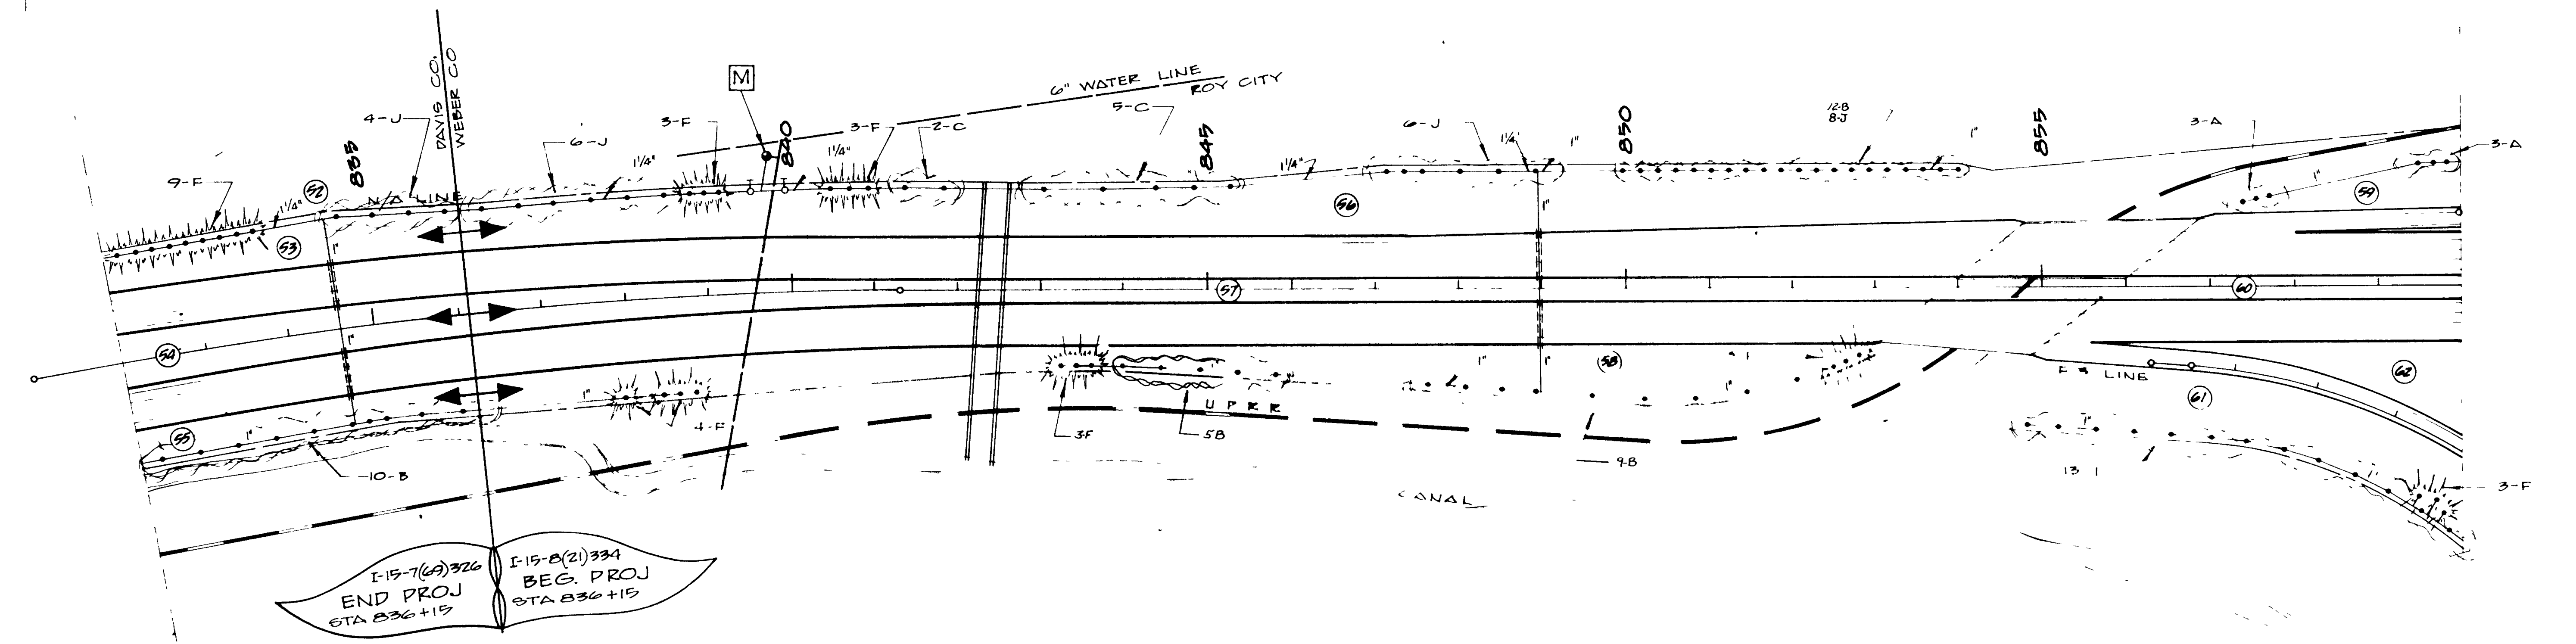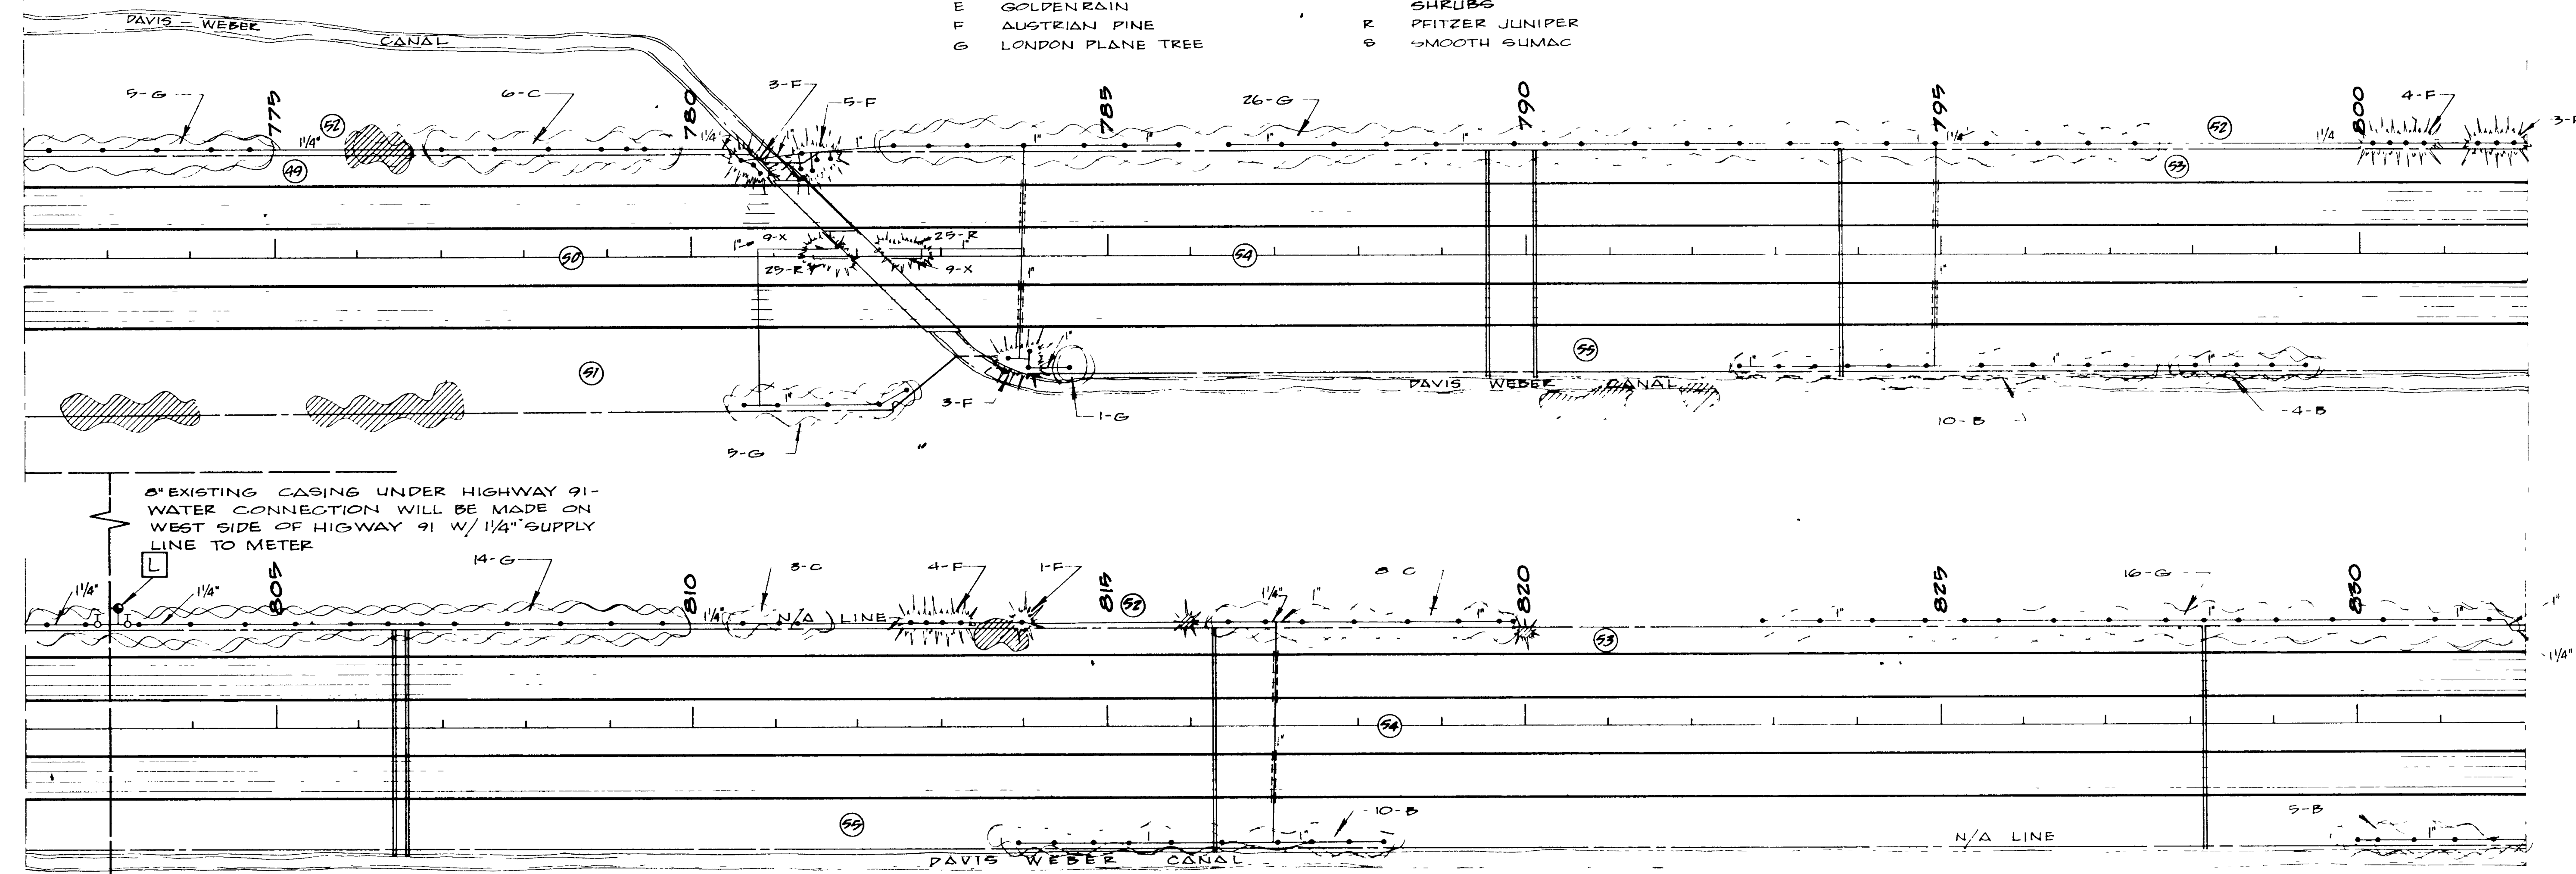

REVISIONS	DATE	BY





- TREES**
- A RUSSIAN OLIVE
 - B MALE GREEN ASH
 - C THORNLESS HONEYLOCUST
 - D CANNART JUNIPER
 - E GOLDENRAIN
 - F AUSTRIAN PINE
 - G LONDON PLANE
 - H CAROLINA POPLAR
 - I LOMBARDY POPLAR
 - J MOLINE ELM

- SHRUBS**
- K PFITZER JUNIPER
 - S SMOOTH SUMAC



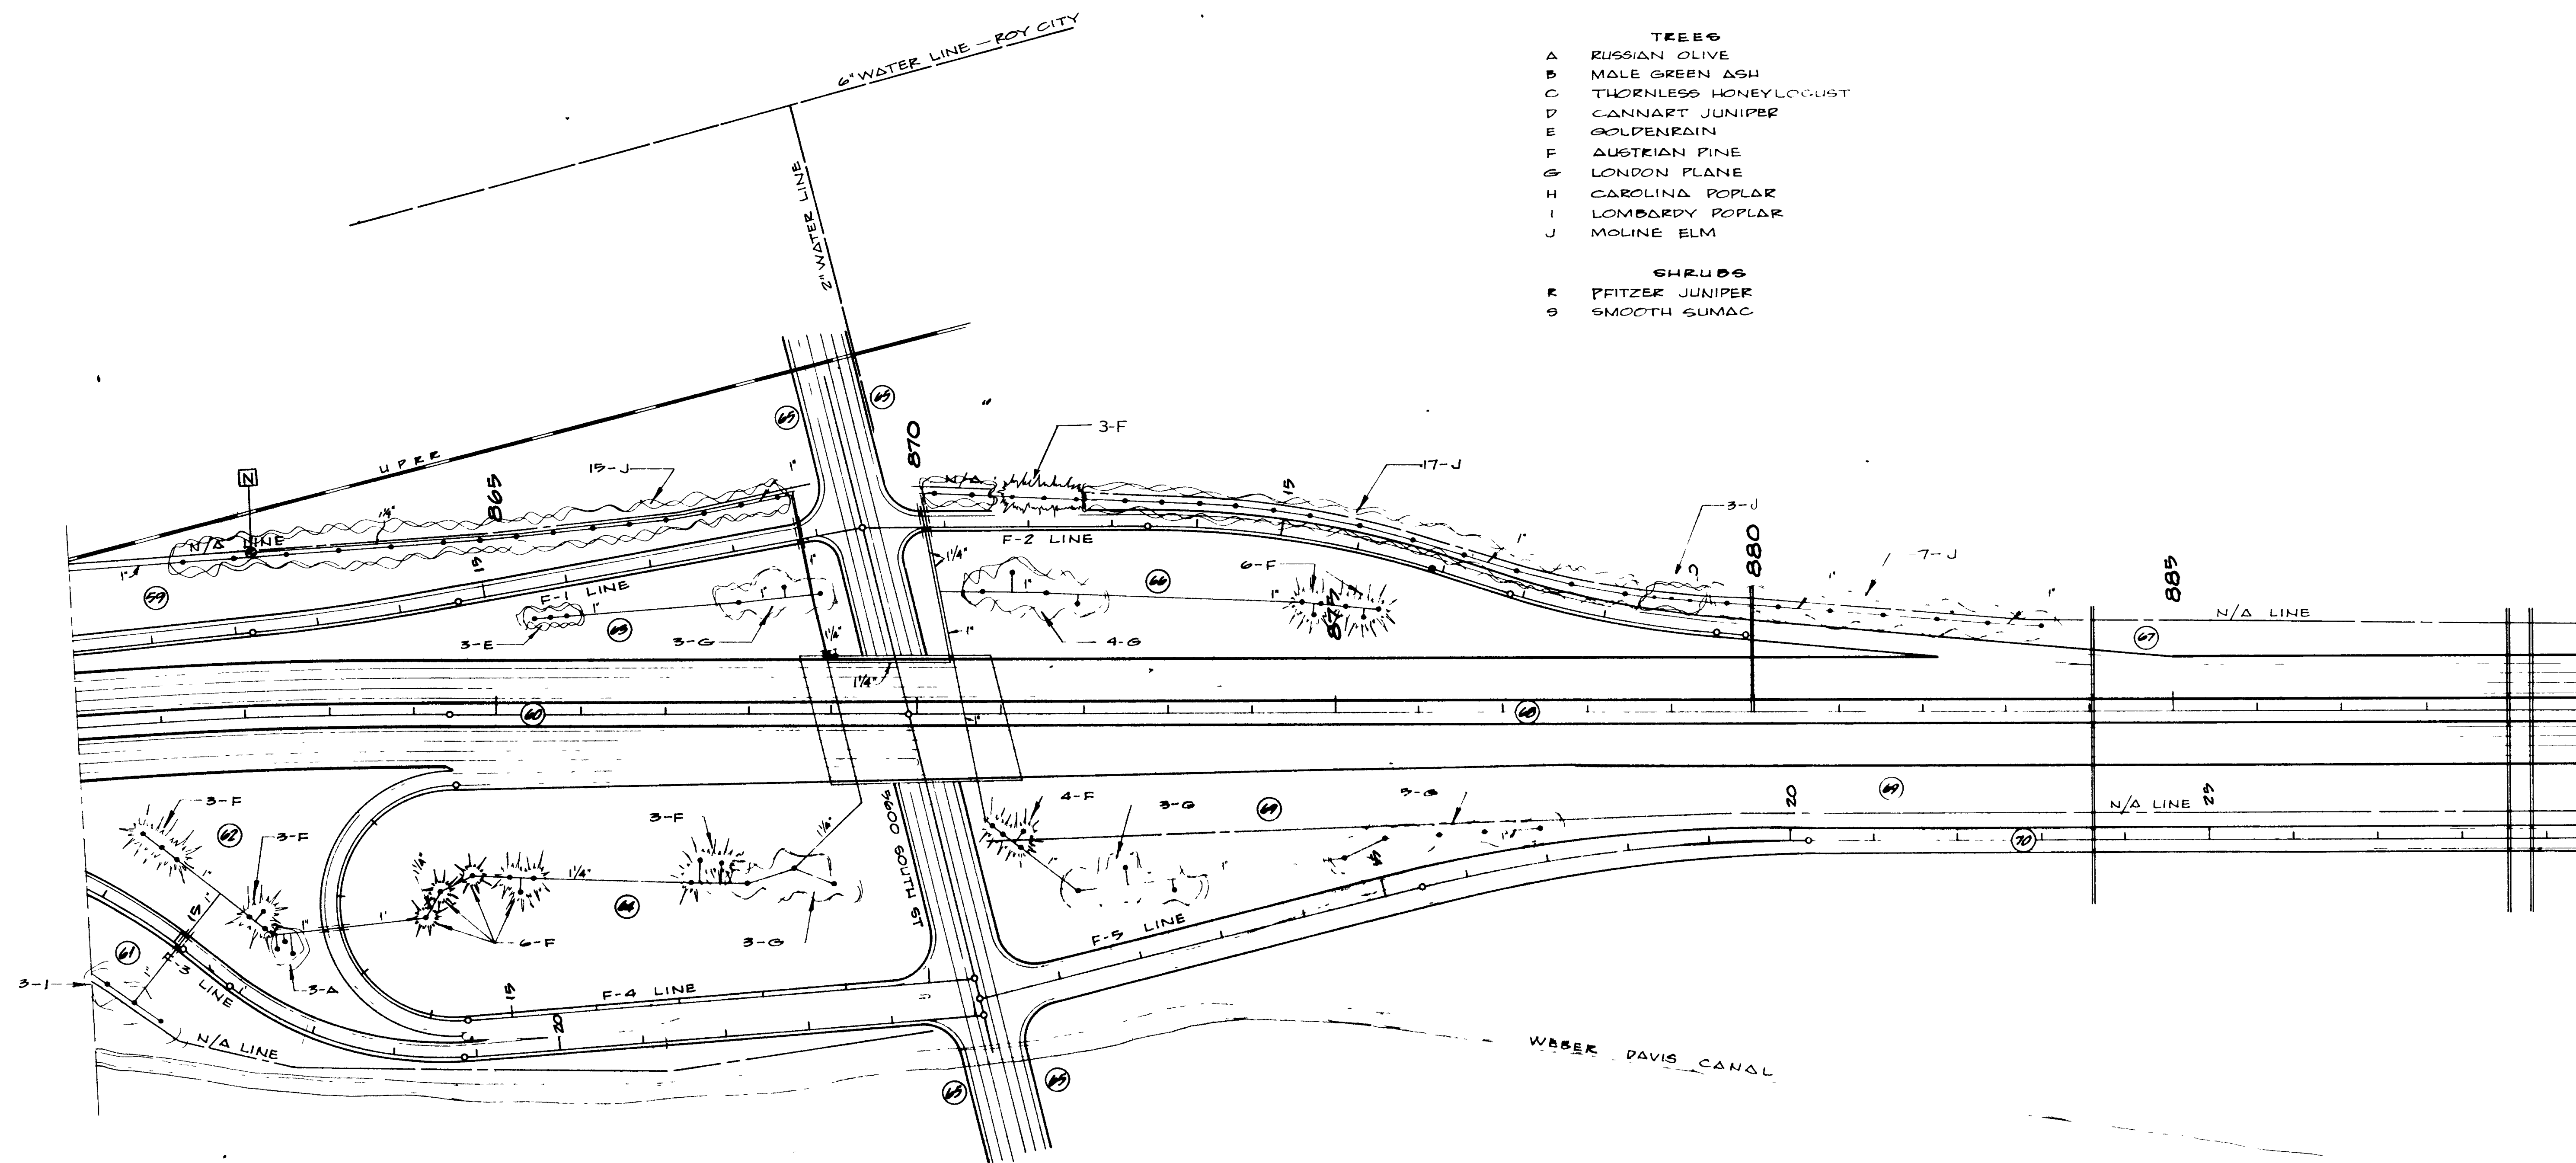



REVISION	DATE	BY

REV DATE 3/10/65

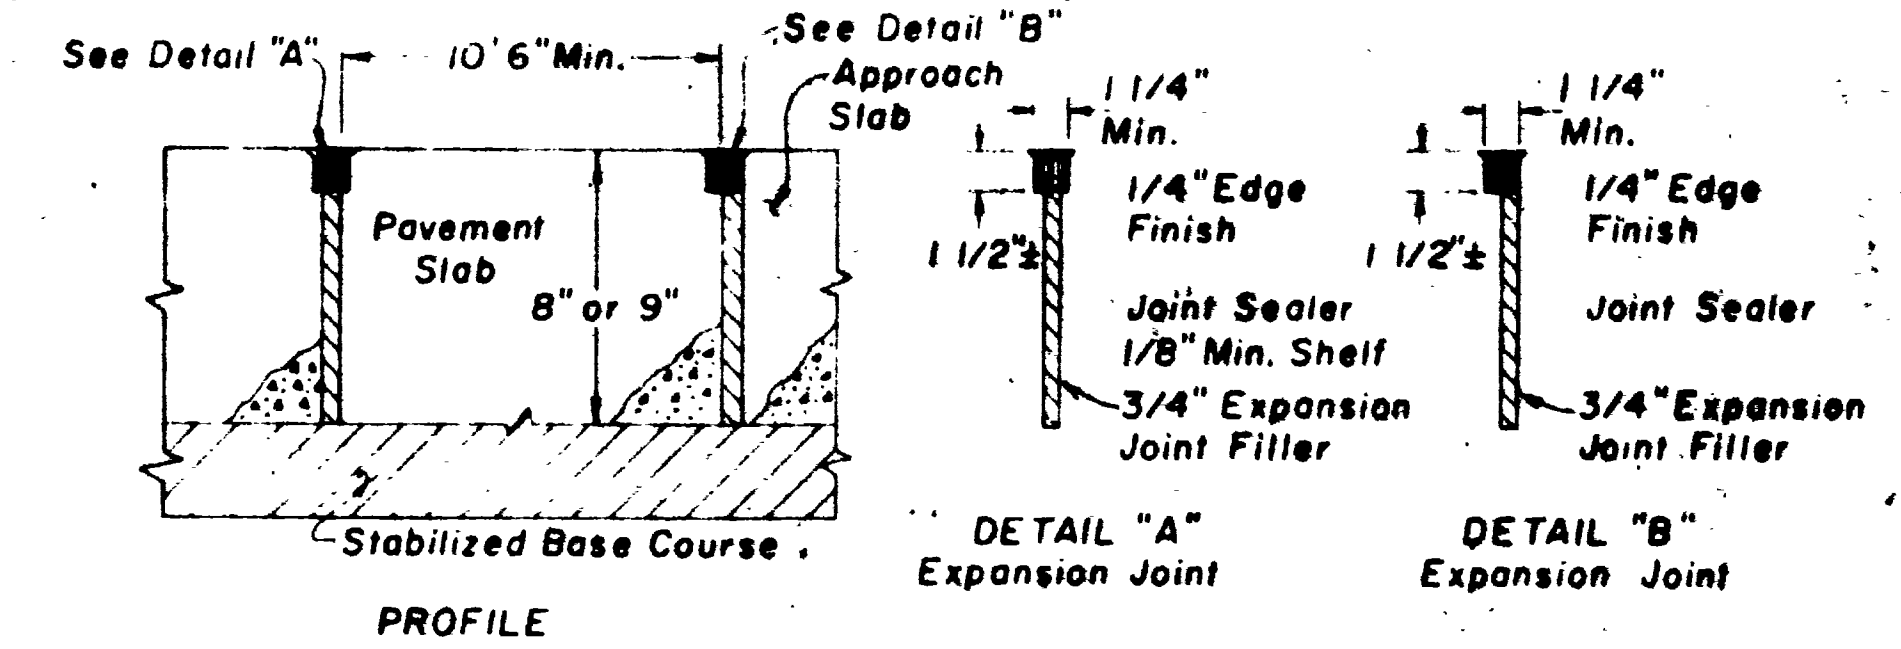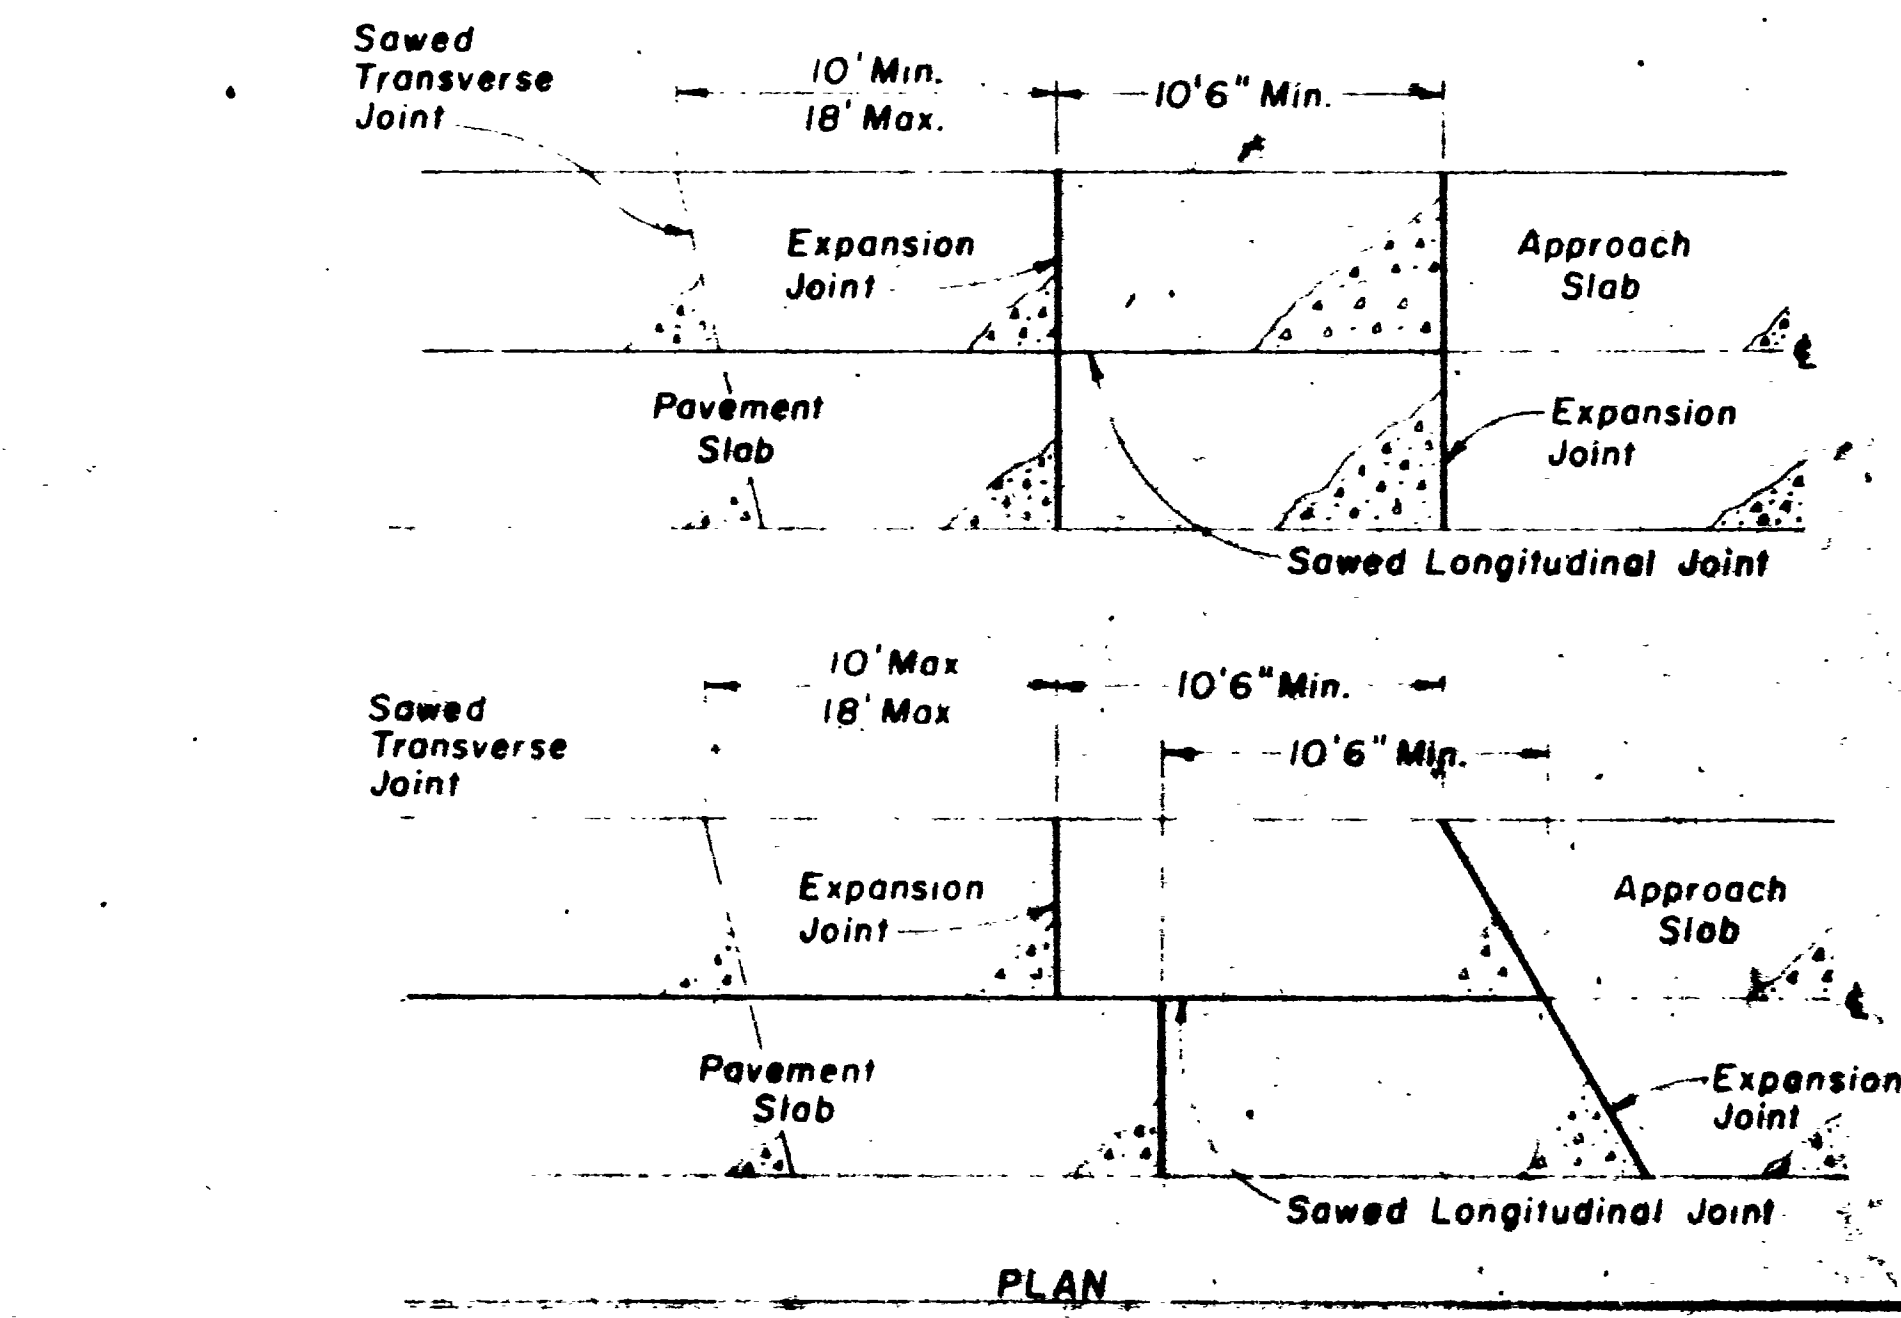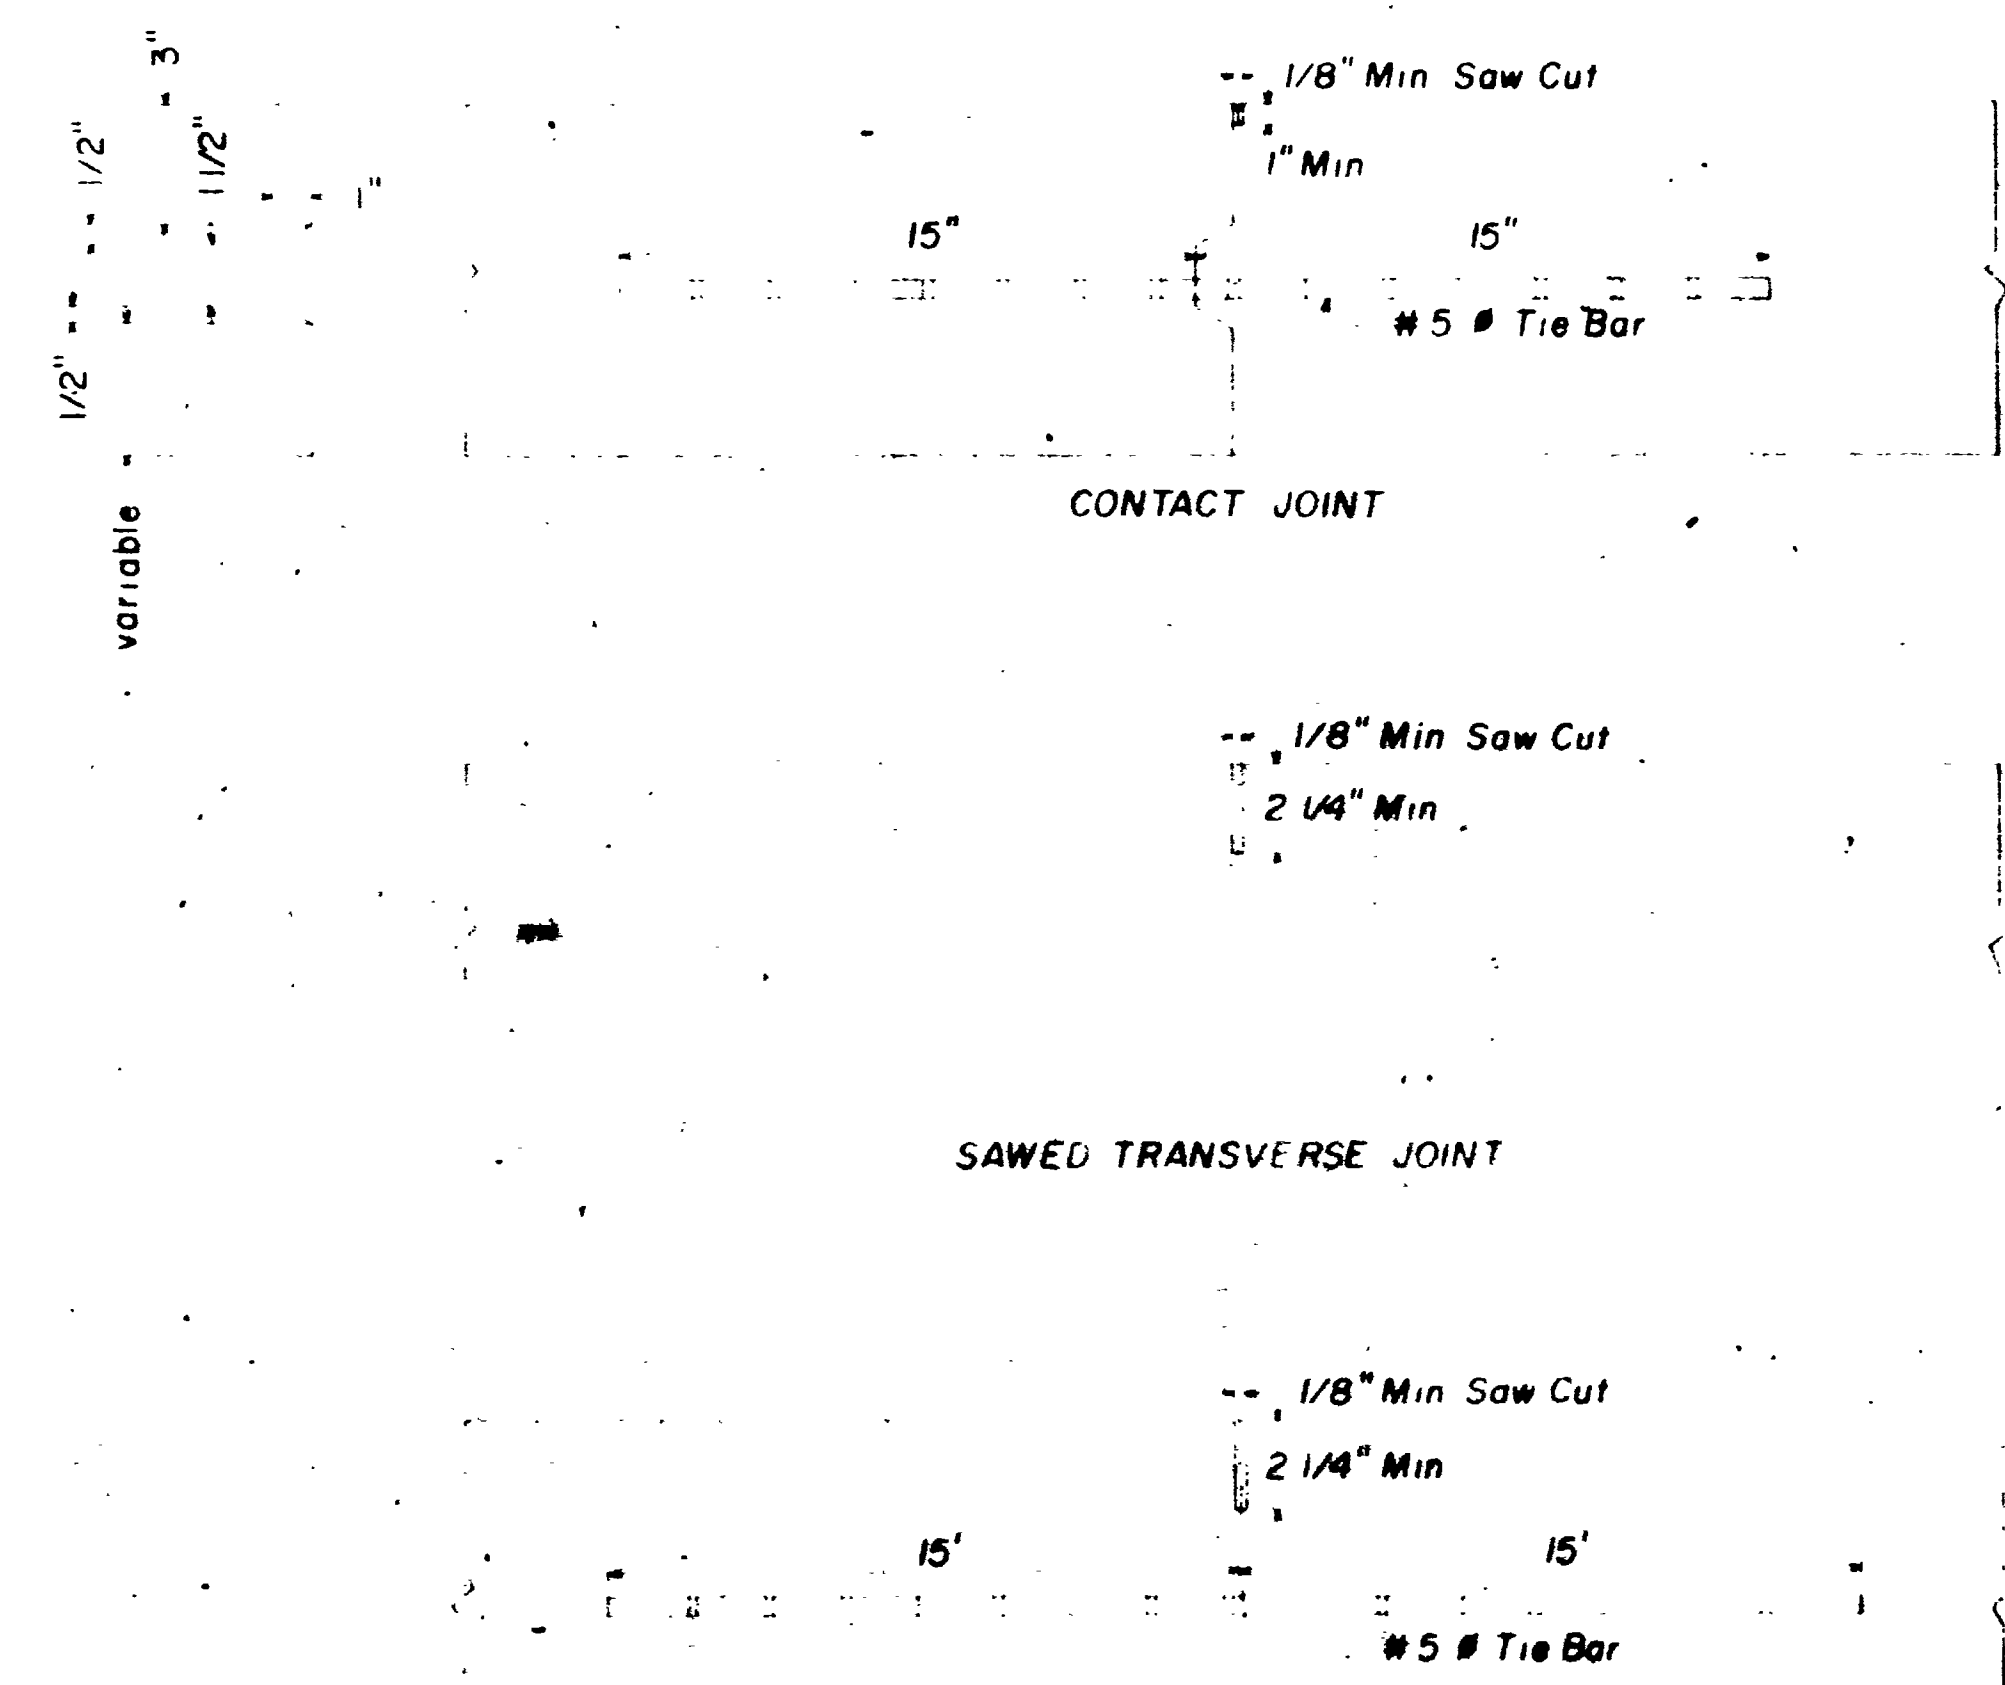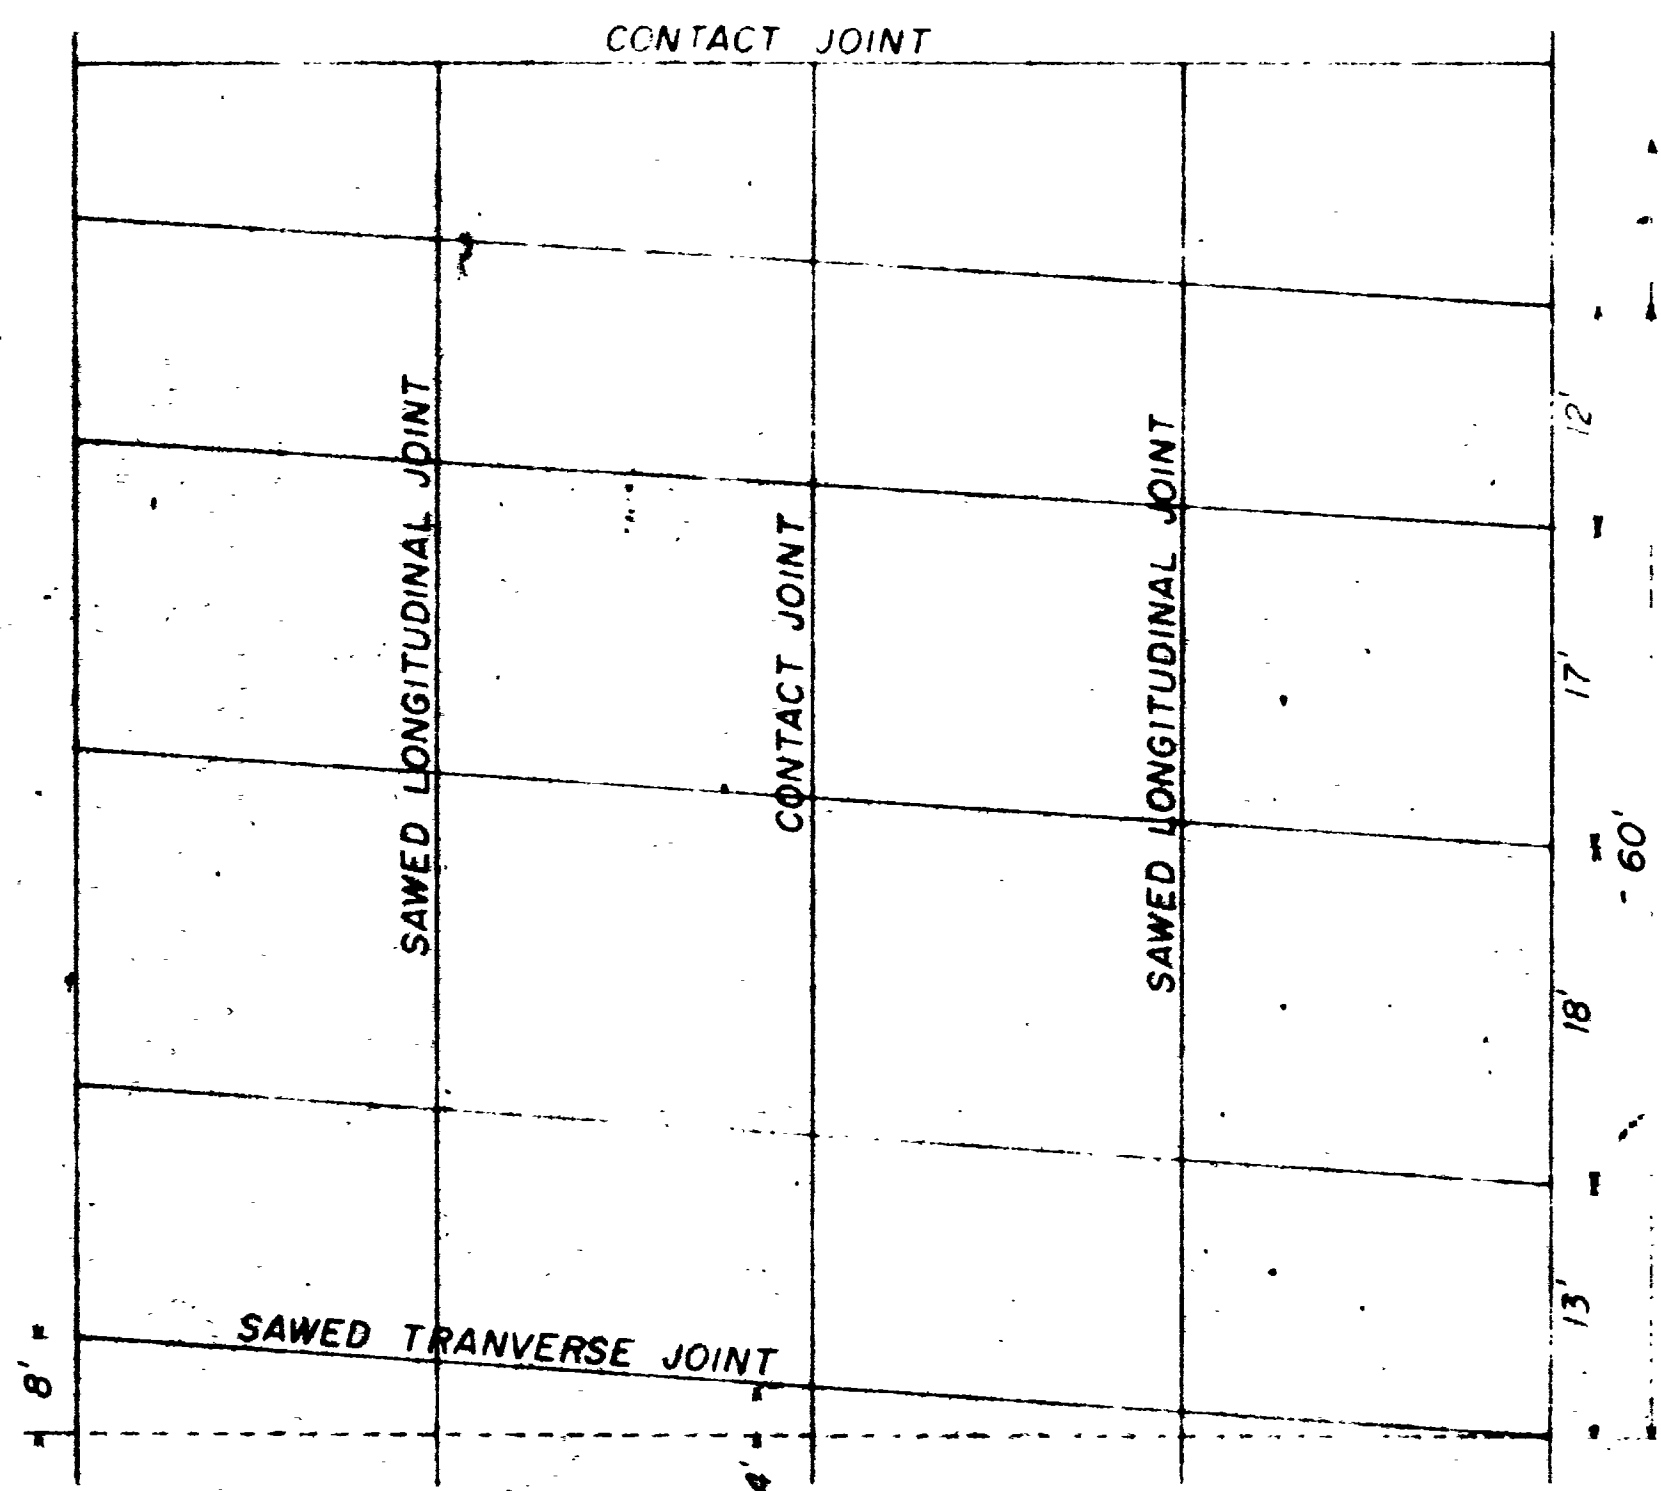

SAWED LONGITUDINAL JOINT
Tie bars shall be No 5 reinforcing steel 30" long with maximum spacing of 48" and shall be placed in the middle 1/3 of the slab

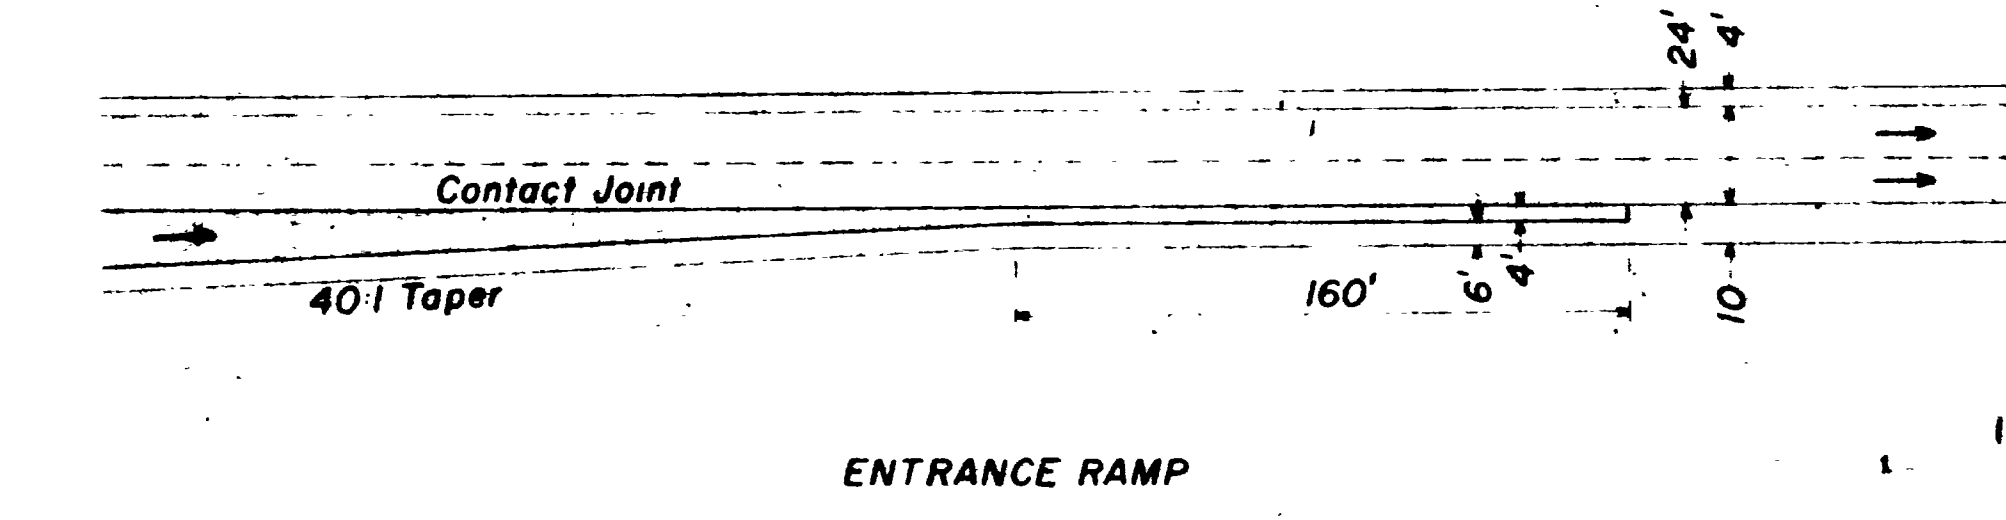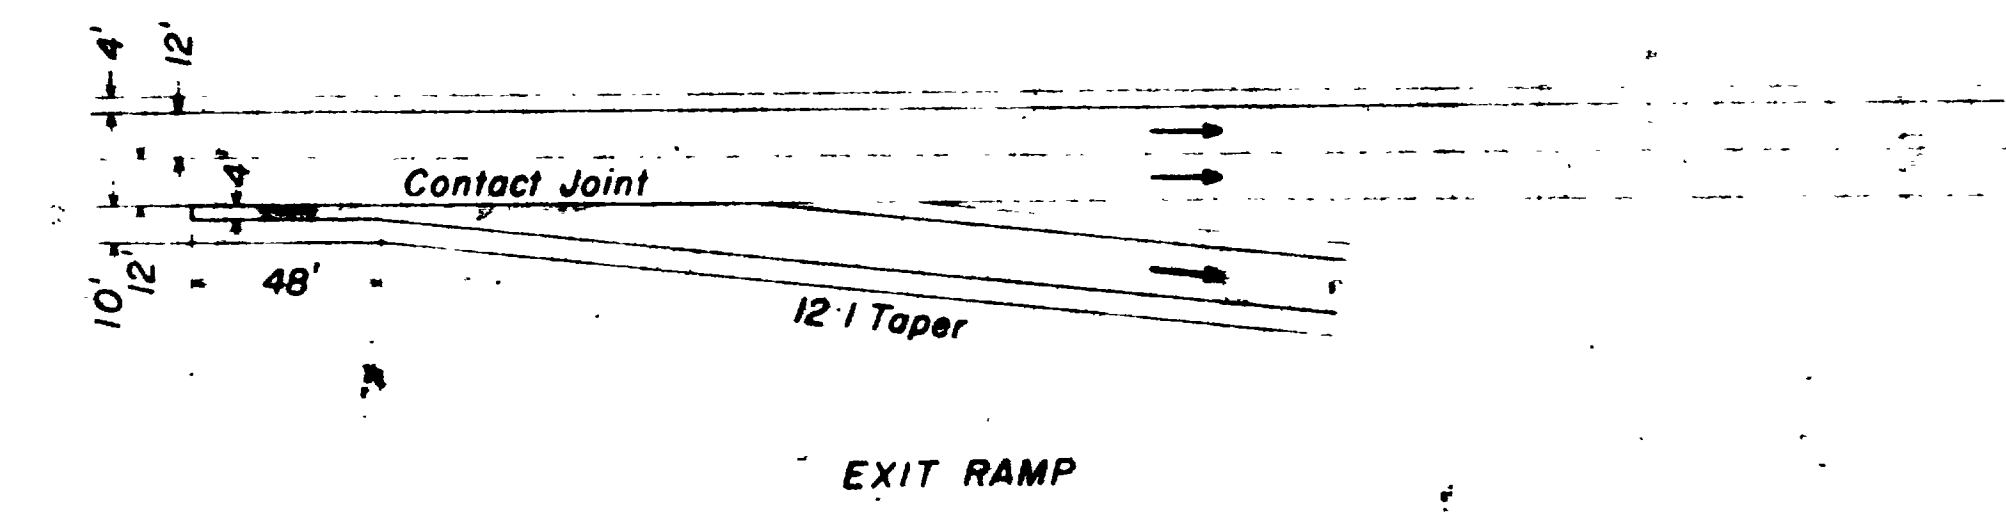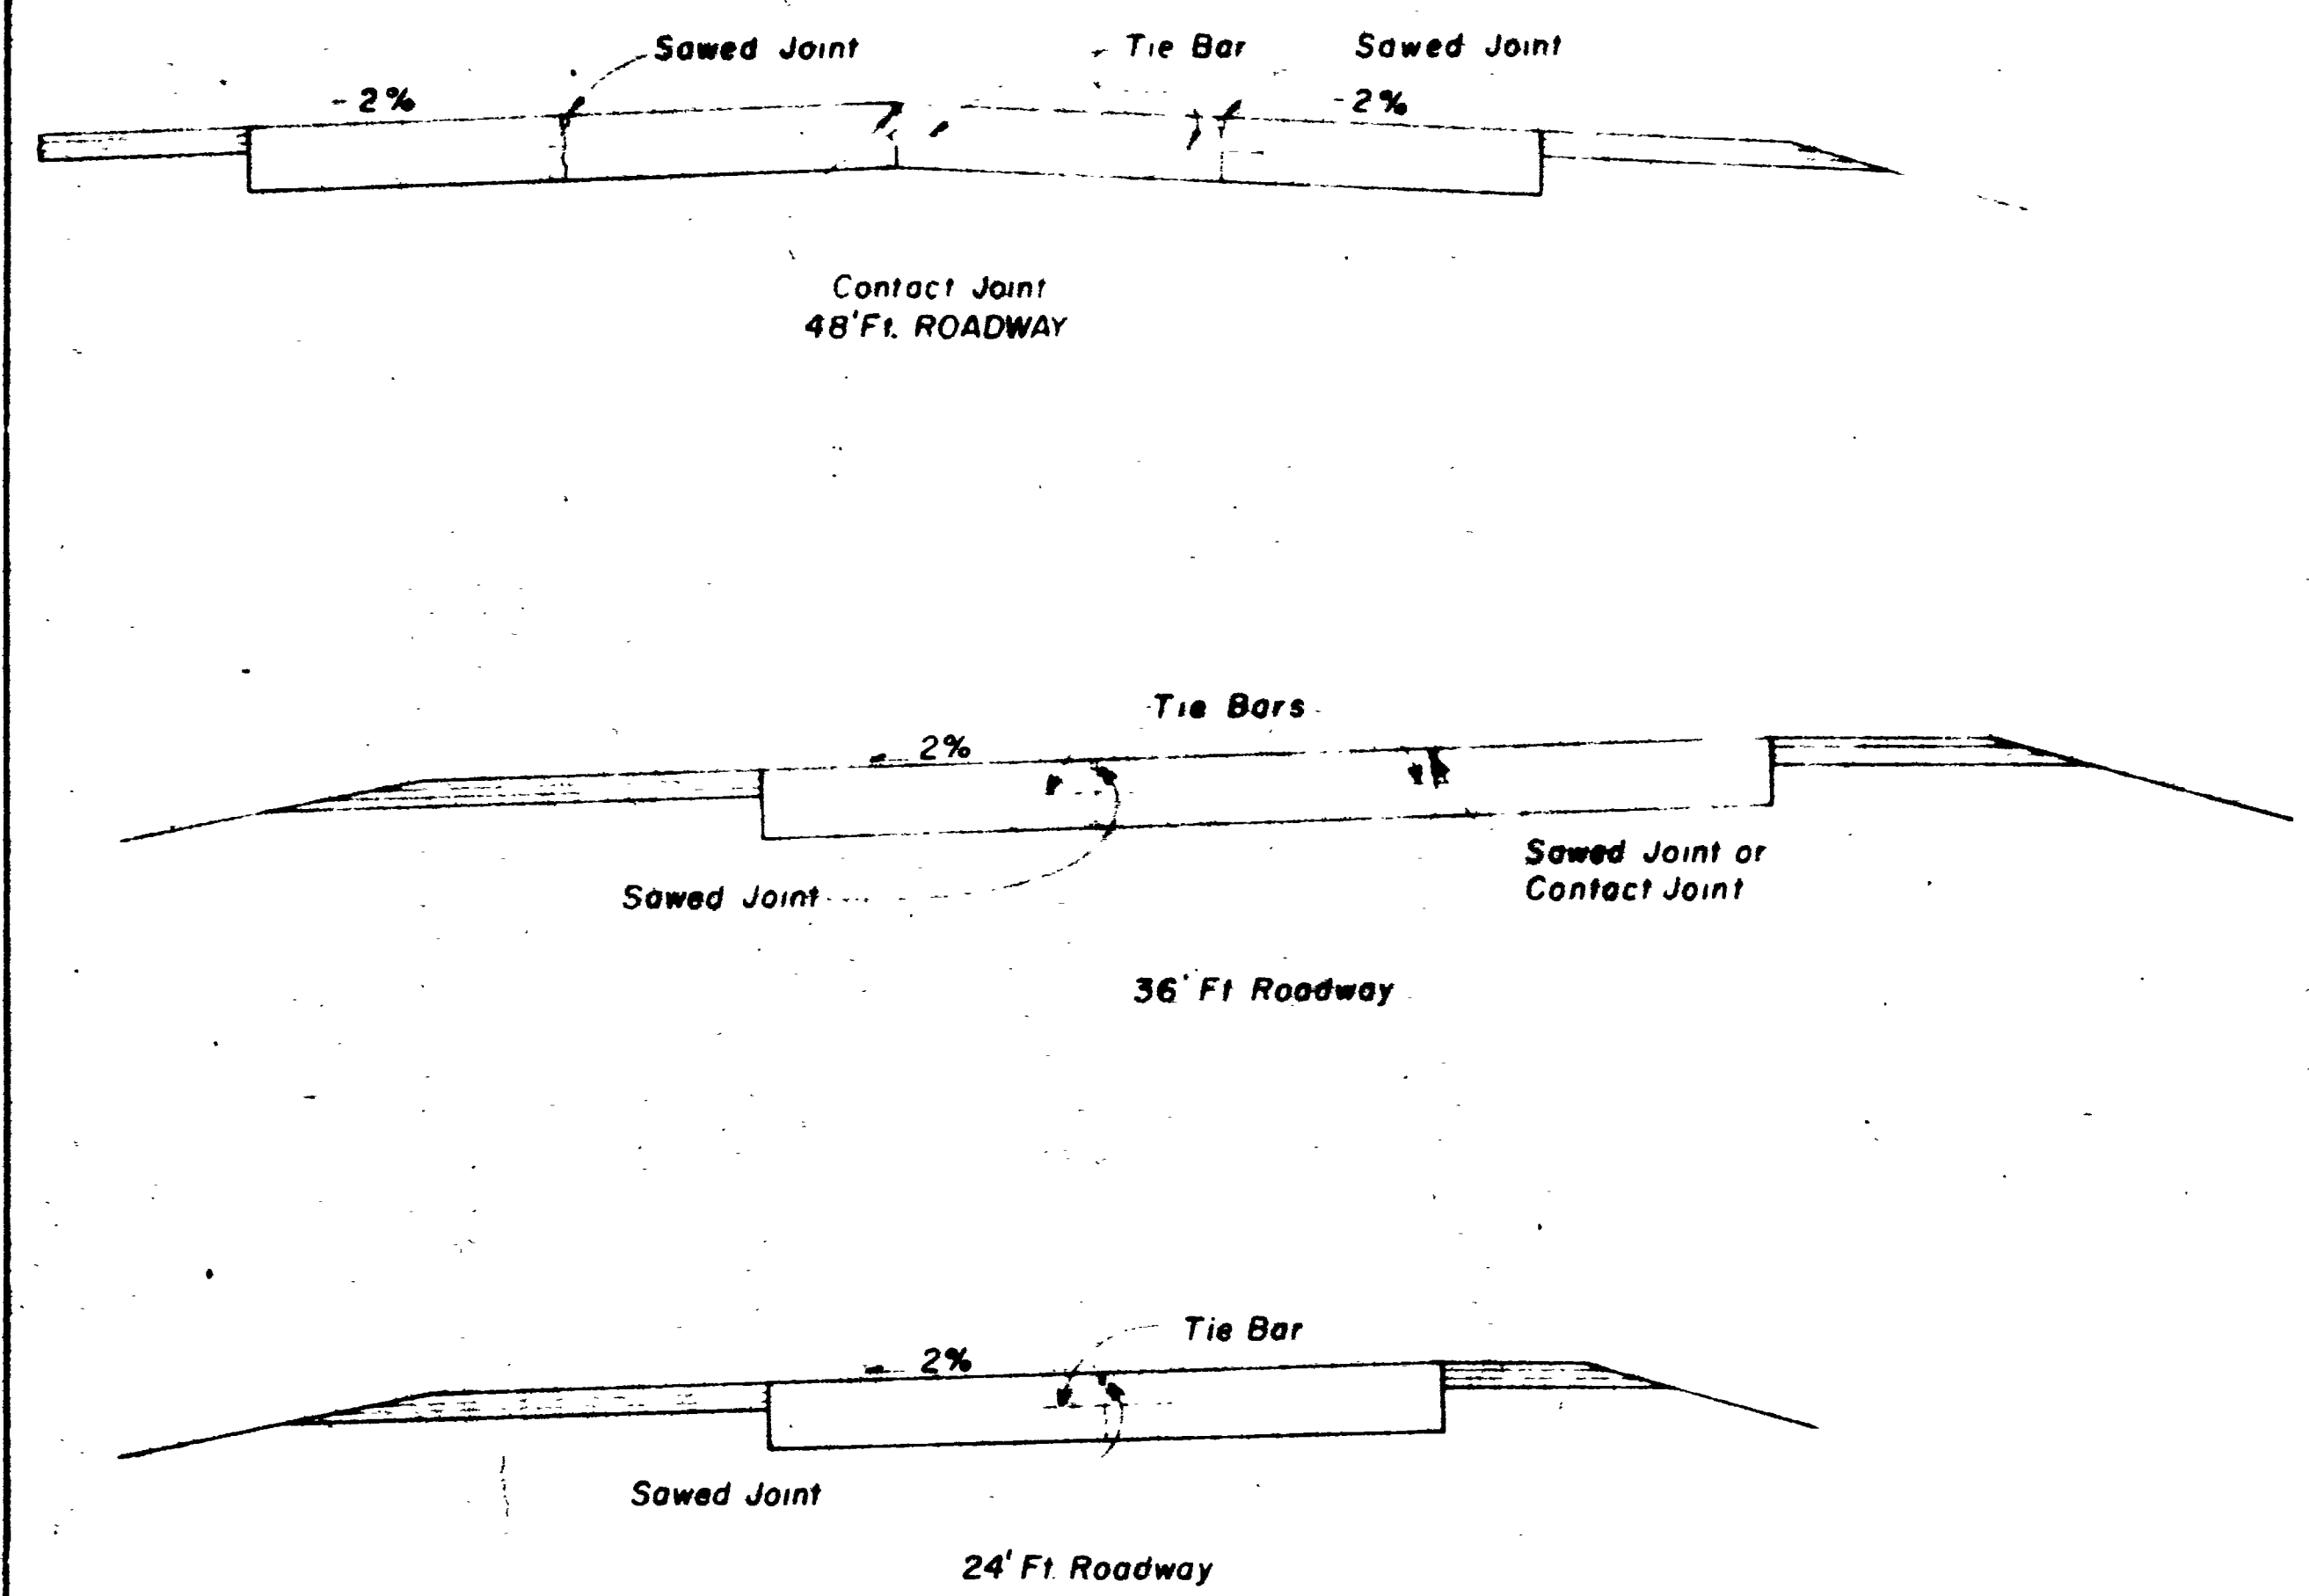

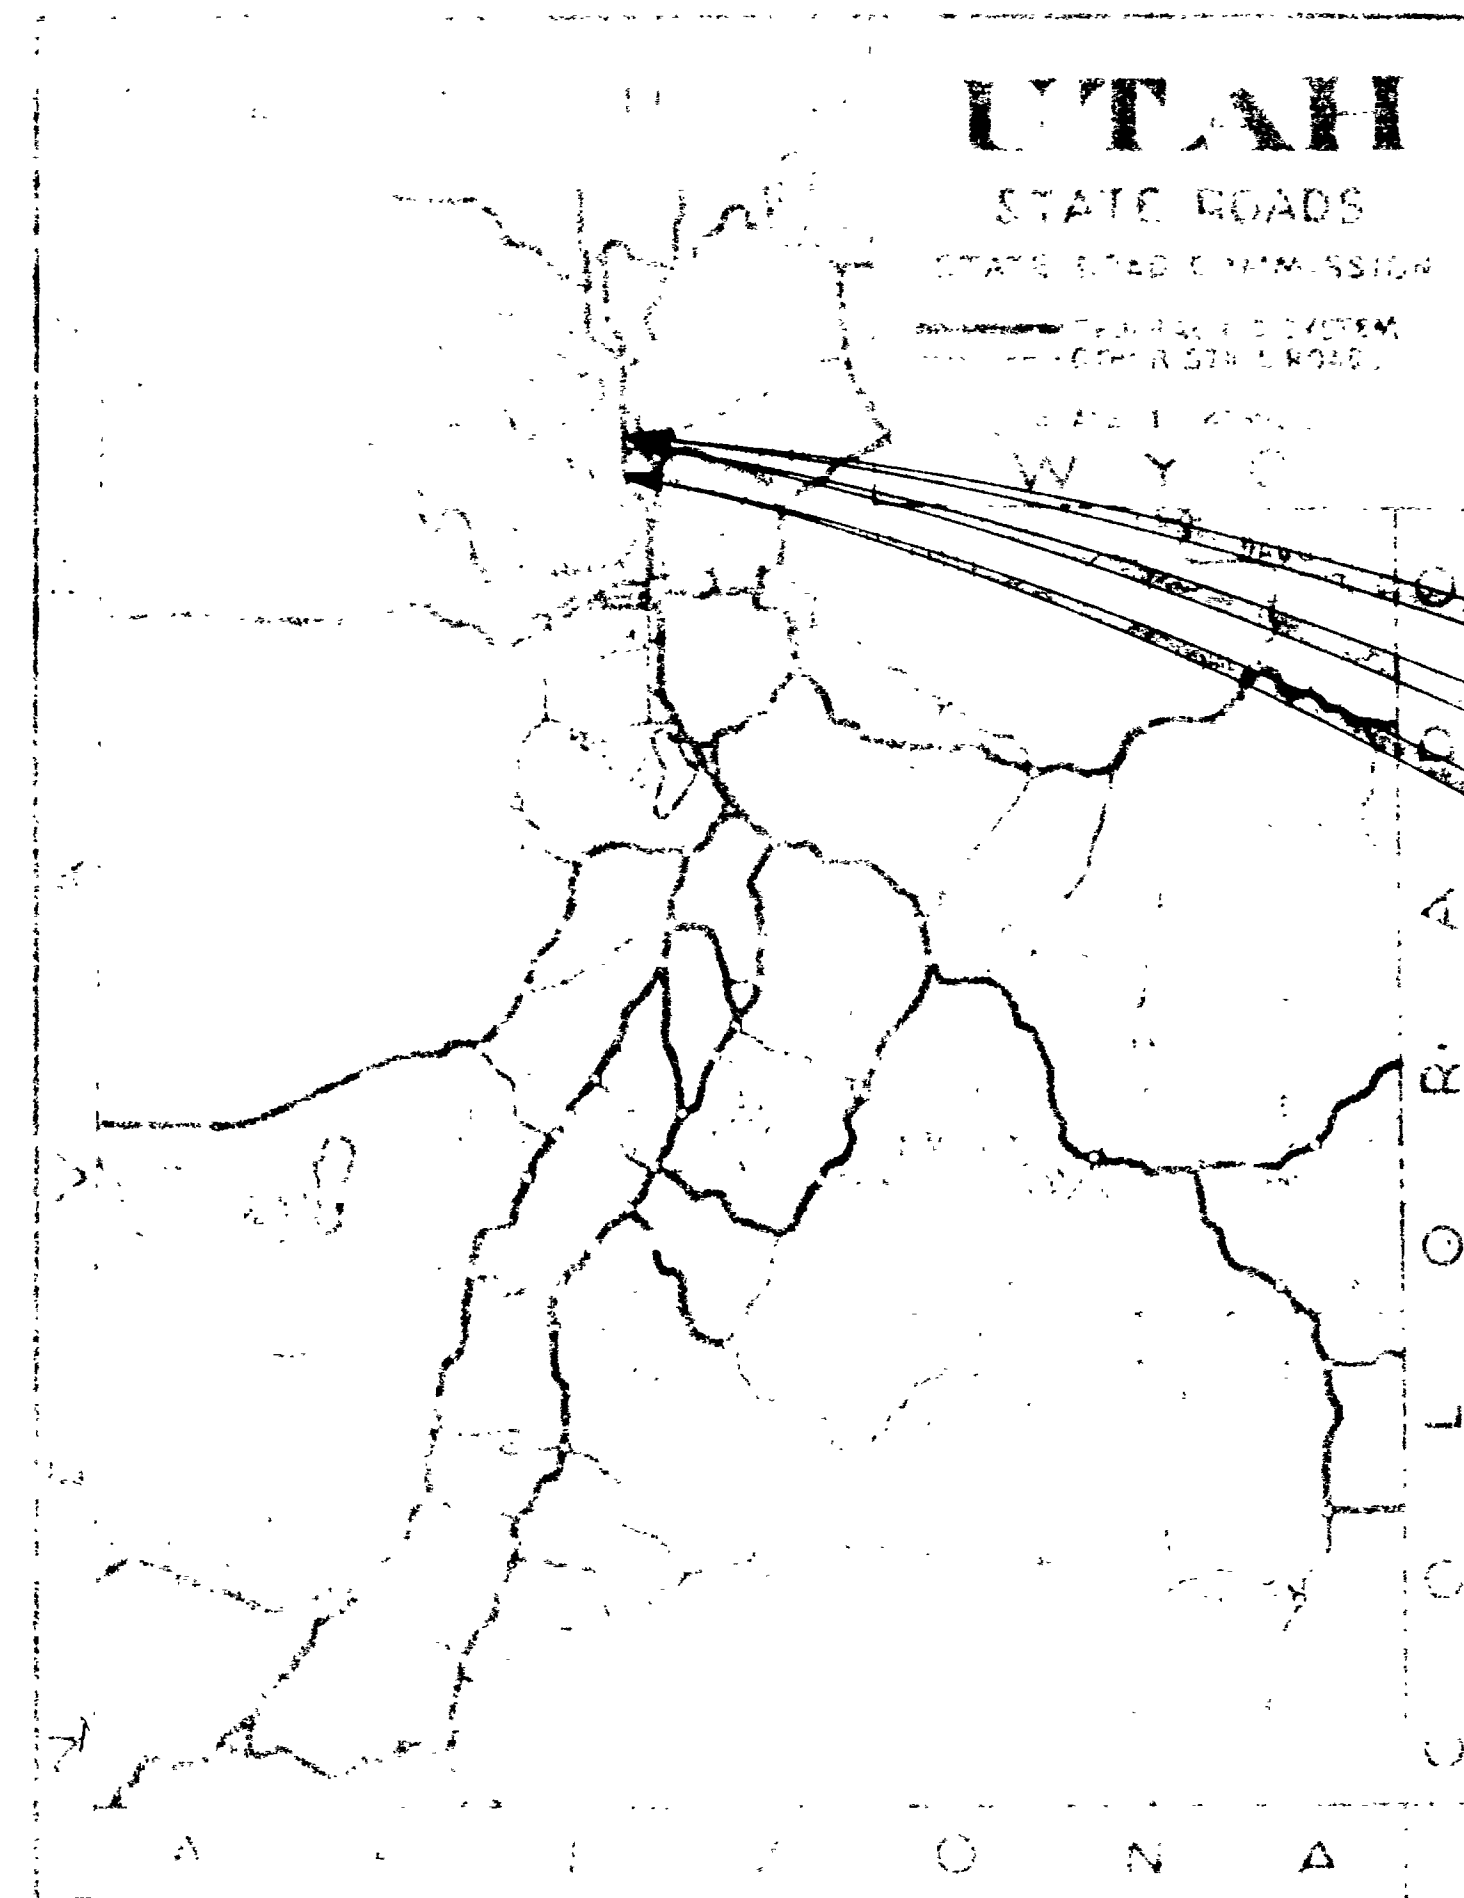

I-15-8(21)334 FOURTH CONTRACT
31ST ST. INTERCHANGE
I-80N-6(19)45
I-80N FROM RIVERDALE ROAD
TO I-15 CONNECTION
I-15-7(69)326 FIFTH CONTRACT
SYRACUSE ROAD ("M" LINE)

STATE OF UTAH STATE ROAD COMMISSION


PLANS OF PROPOSED STATE ROAD

FEDERAL AID PROJECT

I-15-8(21)334 FOURTH CONTRACT
31ST STREET INTERCHANGE
WEBER COUNTY
LENGTH 1.988 MILE

I-80N-6(19)45
I-80N FROM RIVERDALE ROAD
TO I-15 CONNECTION
WEBER COUNTY
LENGTH 0.814 MILE

I-15-7(69)326 FIFTH CONTRACT
SYRACUSE ROAD ("M" LINE)
DAVIS COUNTY
LENGTH 0.303 MILE

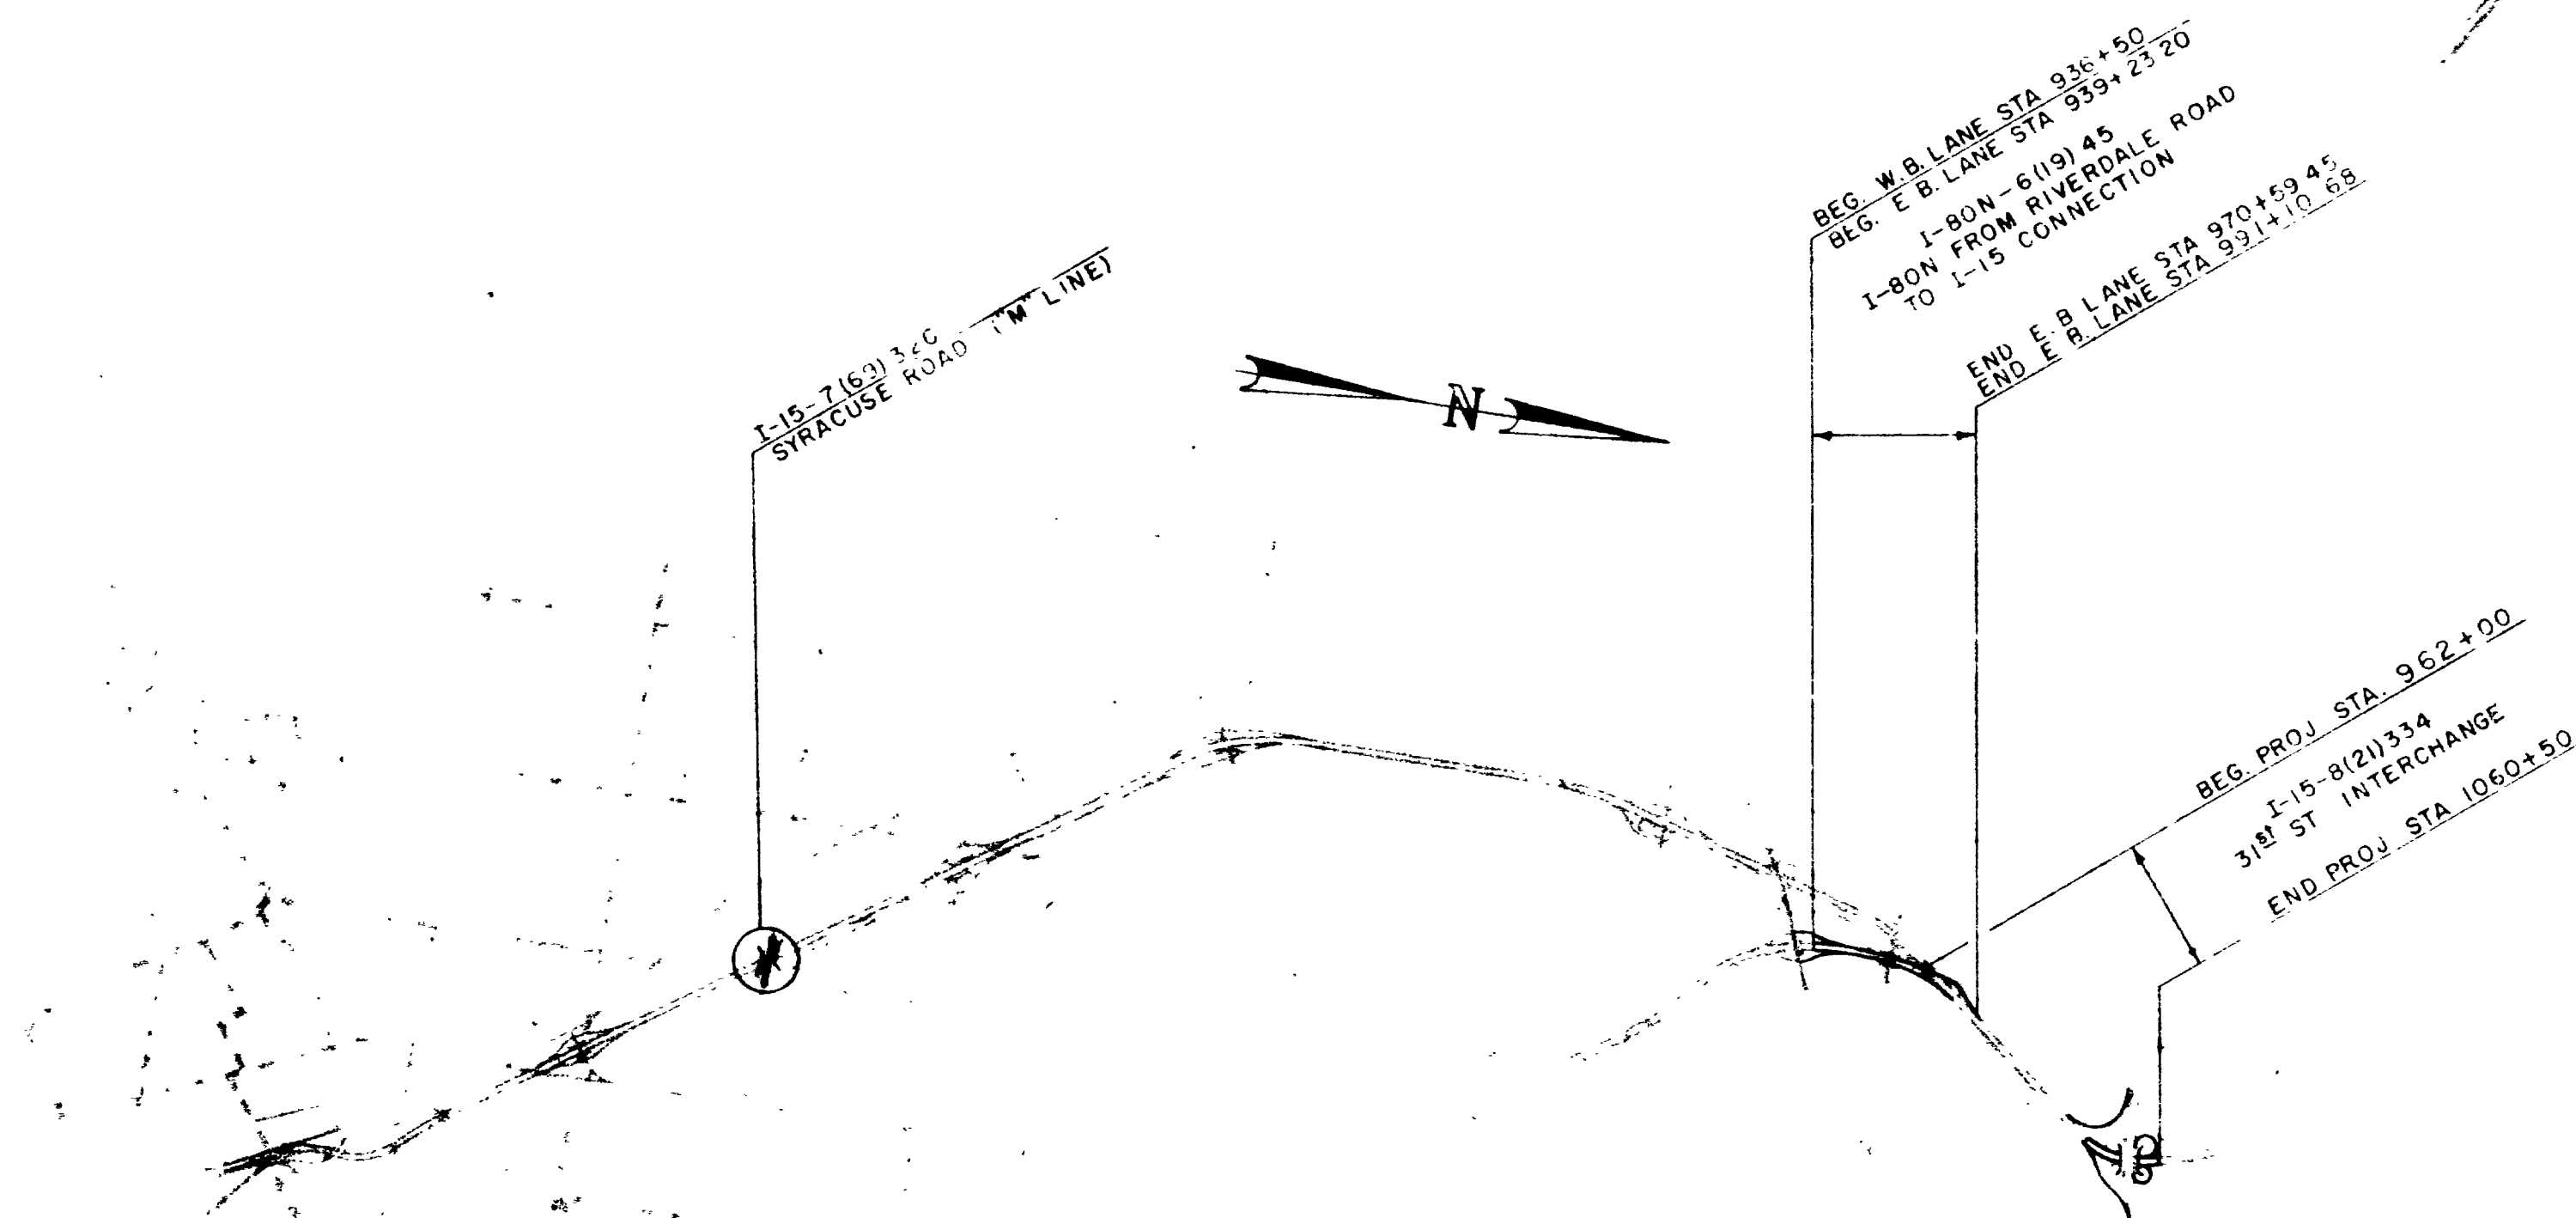

REVISION DATE 6/10/66
I-15-7(69)326
I-80N-6(19)45
I-15-8(21)334

INDEX TO SHEETS NO. I-15-8(21)334 CONT

SHEET NO.	DESCRIPTION	STATION
1	TITLE SHEET	
2-2C	TYPICAL SECTIONS - MAT'L'S SHT	
3-3B	SUMMARY SHEET	
4-14	PLAN AND PROFILE	
15	STANDARD CATCH BASIN	V-750
16	STANDARD CATCH BASIN	V-753
17	STD. C.O.B. & CATCH BASIN - 48" PIPE	V-755
18	STD. C.O.B. & CATCH BASIN - 42" PIPE	V-813
19-20	SUPERELEVATION AND WIDENING	203(1-2)
21	Entrance & Exit Ramp Geometrics	207
22	CONCRETE CURB & GUTTER	220
23	GUARD RAIL INSTALL. & LOCATION	231
24	CORRUGATED METAL PIPE CULVERT	300
25	METAL CULVERT END SECTIONS	302
26	REINFORCED CONCRETE CULVERTS	320
27	REINFORCED CONC. CULV. END SECT	322
28	DIPSTONE INLET AND OUTLET	351
29-34	CONSTRUCTION SIGNING	500(1-5)
35	CONSTRUCTION IDENT. SIGNS	504
36	TYPICAL PAVEMENT MARKINGS	507
37	STD. CATCH BASIN 36" PIPE	V-754
38	DEEP BM HWY. GUARD RAIL	230-1
39	GUARD RAIL APP. ELEMENT INSTALL.	230-2


INDEX TO SHEETS NO. I-80N-6(19)45

SHEET NO.	DESCRIPTION	STATION
1	TITLE SHEET	
2-2C	TYPICAL SECTIONS - MAT'L'S SHT	
3	SUMMARY SHEET	
4-11	PLAN AND PROFILE	
12-13	SUPERELEVATION AND WIDENING	203(1-2)
14	Entrance & Exit Ramp Geometrics	207
15	CONCRETE CURB AND GUTTER	220
16	GUARD RAIL INSTALL. & LOCATION	231
17	CORRUGATED METAL PIPE CULVERT	300
18	METAL CULVERT END SECTION	302
19	DIPSTONE INLET AND OUTLET	351
20-24	CONSTRUCTION SIGNING	500(1-5)
25	CONSTRUCTION IDENT. SIGNS	504
26	TYPICAL PAVEMENT MARKINGS	507
27	DEEP BEAM HWY. GUARD RAIL	230-1
28	GUARD RAIL APP. ELEMENT INSTALL.	230-2

INDEX TO SHEETS NO. I-15-7(69)326 CONT

SHEET NO.	DESCRIPTION	STATION
1	TITLE SHEET	
2-2B	TYPICAL SECTIONS - MAT'L'S SHT	
3	SUMMARY SHEET	
4-5	PLAN AND PROFILE	
6	CONCRETE CURB AND GUTTER	220
7	GUARD RAIL INSTALL. & LOCATION	231
8	CORRUGATED METAL PIPE CULV.	300
9	METAL CULVERT END SECTIONS	302
10	DIPSTONE INLET AND OUTLET	351
11-14	CONSTRUCTION SIGNING	500(1-5)
15	CONSTRUCTION IDENT. SIGNS	504
16	TYPICAL PAVEMENT MARKINGS	507
17	DEEP BEAM HWY. GUARD RAIL	230-1
18	GUARD RAIL APP. ELEMENT INSTALL.	230-2

MAY 1966
MAY 1966
MAY 1966
STATE HIGHWAY ENGINEER

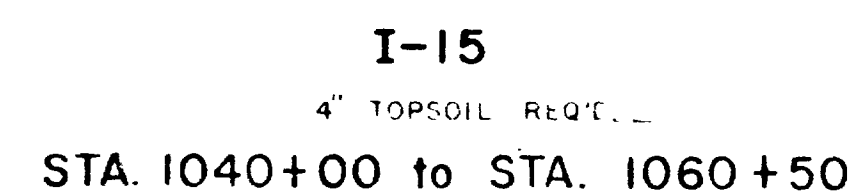

A hand-drawn cross-section diagram of a road with a central ditch. The road has a 4:1 cut slope on the left and a 10:1 slope on the right. The ditch has a 2:1 slope on both sides. Horizontal dimensions are marked as 6 and 4. Vertical dimensions are marked as 1 and 2.

24' DESIGN SPEED 30 MPH

6' SHLDR 14' TRAFFIC LANE 4' SHLDR

GRADE SHOWN ON PROFILE

2% SLOPE

5:1 SLOPE

2:1 SLOPE IN CUTS OVER 10'

4' TOPSOIL REQ'D

2:1 SLOPE IN CUTS UP TO 10'

10' MIN

10:1 SLOPE

T-18 & T-7 LINES

- 2 3/4" FUTURE SURFACING
- 3/4" PLANT MIX SEAL COAT REQ'D
- 2" BITUMINOUS SURFACE COURSE (3/4" MAX) REQ'D
- 2" BITUMINOUS SURFACE COURSE REQ'D
- 5" GRAVEL BASE COURSE REQ'D
- 4 1/2" GRANULAR MATERIAL REQ'D

5:1 SLOPE ON FILLS UP TO 10'

2:1 SLOPE ON FILLS OVER 10'

4' TOPSOIL REQ'D

24' DESIGN SPEED 30 MPH

4' SHLDR 14' TRAFFIC LANE 6' SHLDR

GRADE SHOWN ON PROFILE

2% SLOPE

5:1 SLOPE

2:1 SLOPE IN CUTS OVER 10'

4' TOPSOIL REQ'D

2:1 SLOPE IN CUTS UP TO 10'

10' MIN

10:1 SLOPE


T-4 & T-6 LINES

- 2 3/4" FUTURE SURFACING
- 3/4" PLANT MIX SEAL COAT REQ'D
- 2" BITUMINOUS SURFACE COURSE (3/4" MAX) REQ'D
- 2" BITUMINOUS SURFACE COURSE REQ'D
- 5" GRAVEL BASE COURSE REQ'D
- 4 1/2" GRANULAR MATERIAL REQ'D

5:1 SLOPE ON FILLS UP TO 10'

2:1 SLOPE ON FILLS OVER 10'

4' TOPSOIL REQ'D

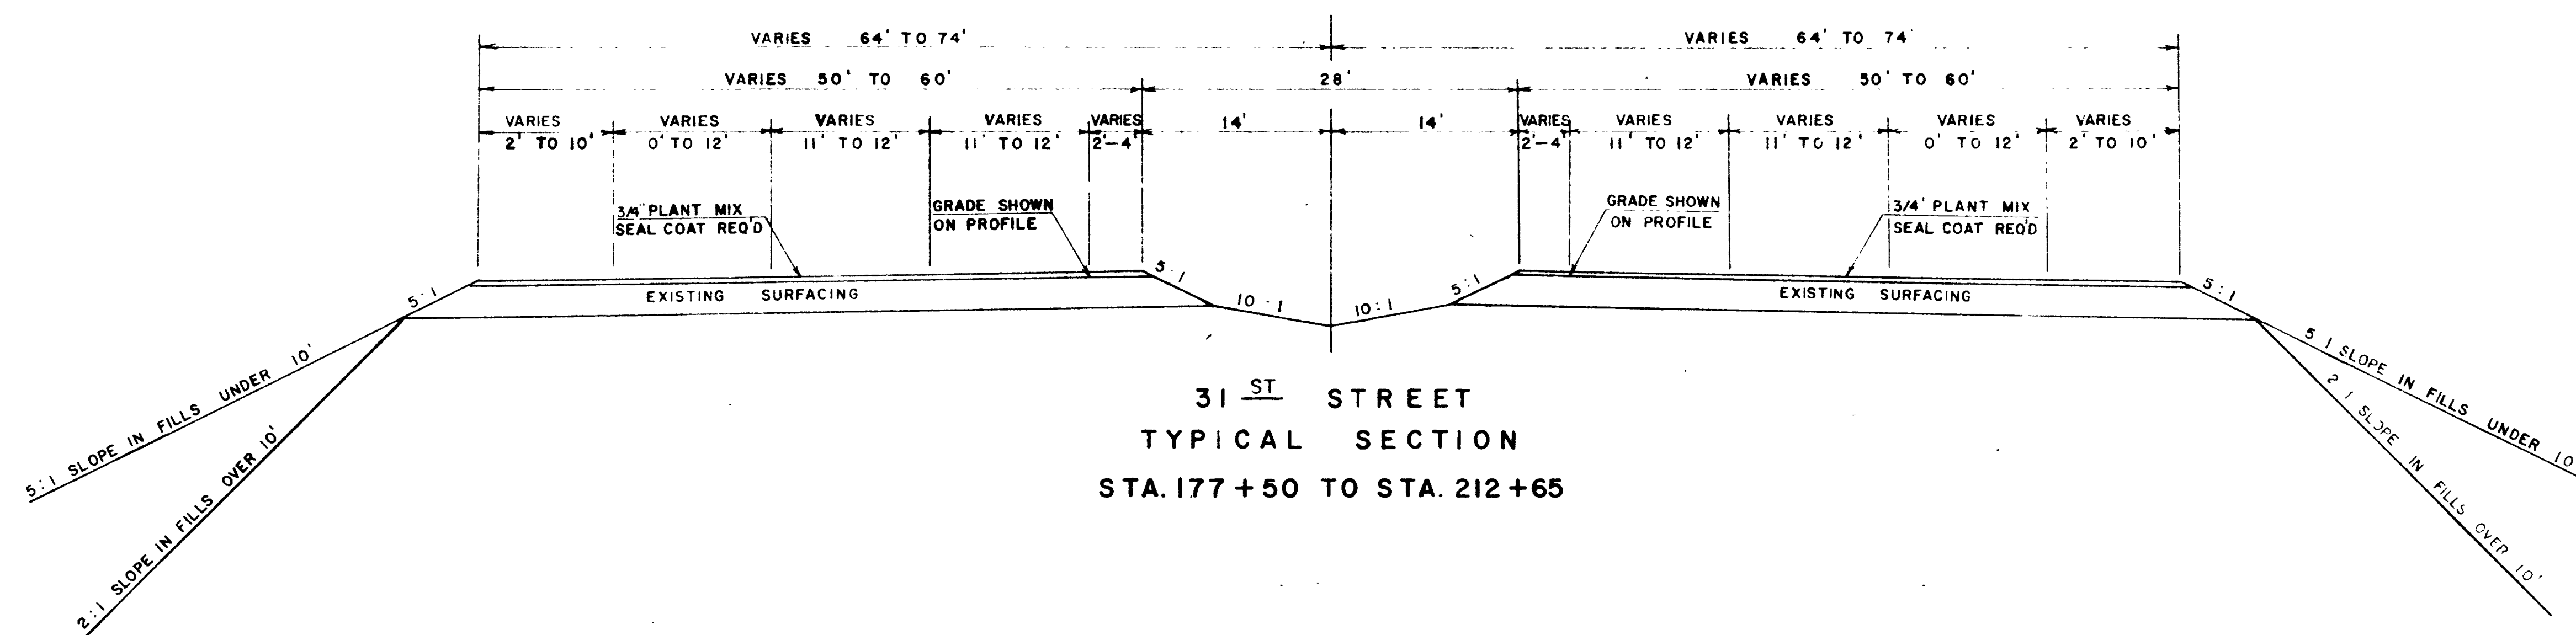


31ST STREET
TYPICAL SECTION
STA. 177+50 TO STA. 212+65

REVISIONS
DATE BY


STRUCTURE END DRAIN

SEE PLAN SHEET NO. 4

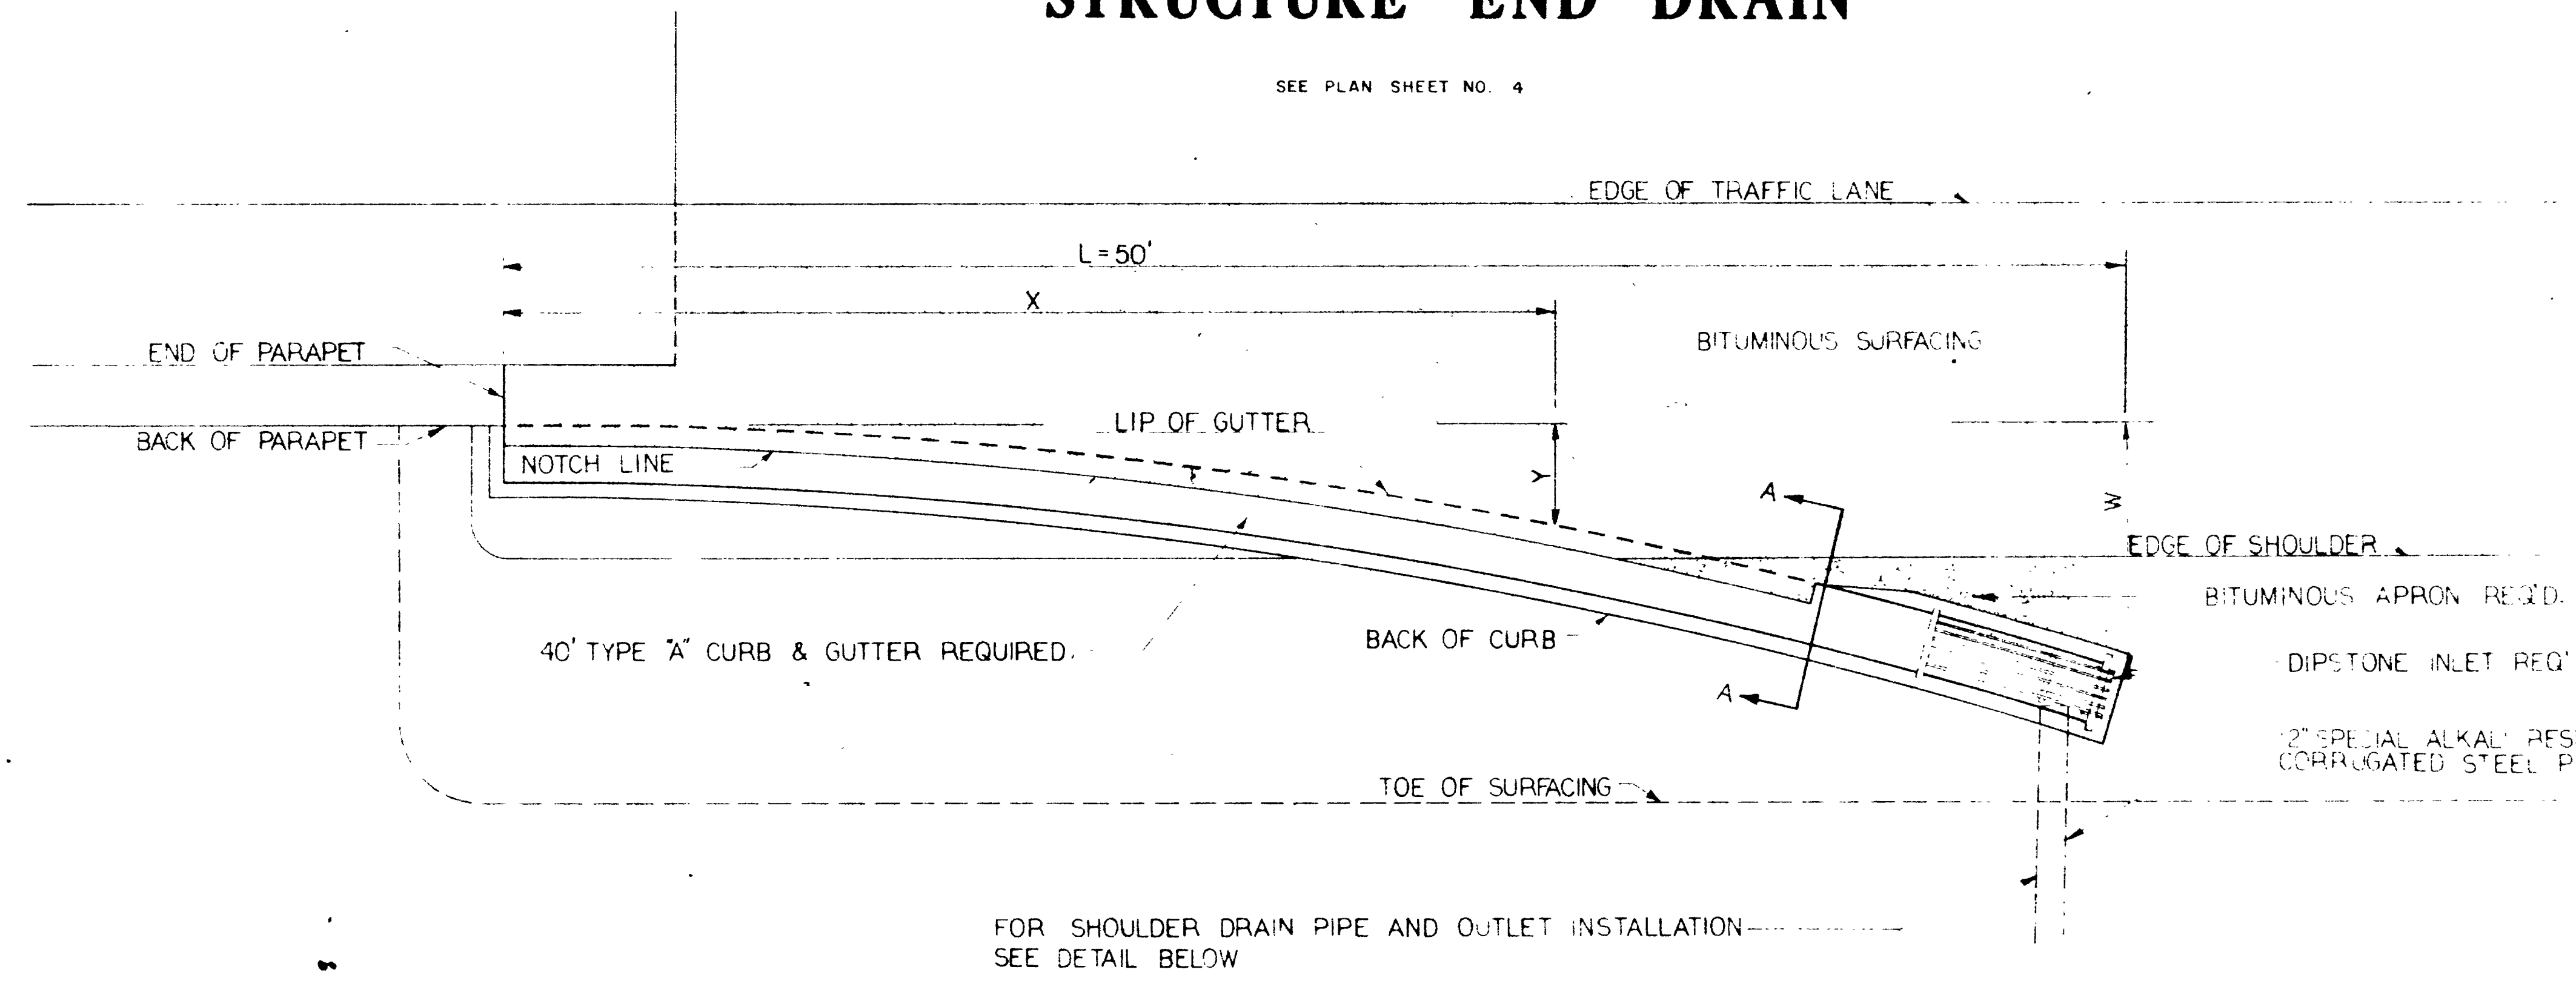


$y = w \frac{x^2}{L^2}$
Y = OFFSET AT ANY POINT
X = LENGTH TO Y FROM END OF PARAPET
W = TOTAL OFFSET FROM BACK OF PARAPET TO LIP OF GUTTER
L = TOTAL LENGTH OF END DRAIN

FOR SHOULDER DRAIN PIPE AND OUTLET INSTALLATION
SEE DETAIL BELOW

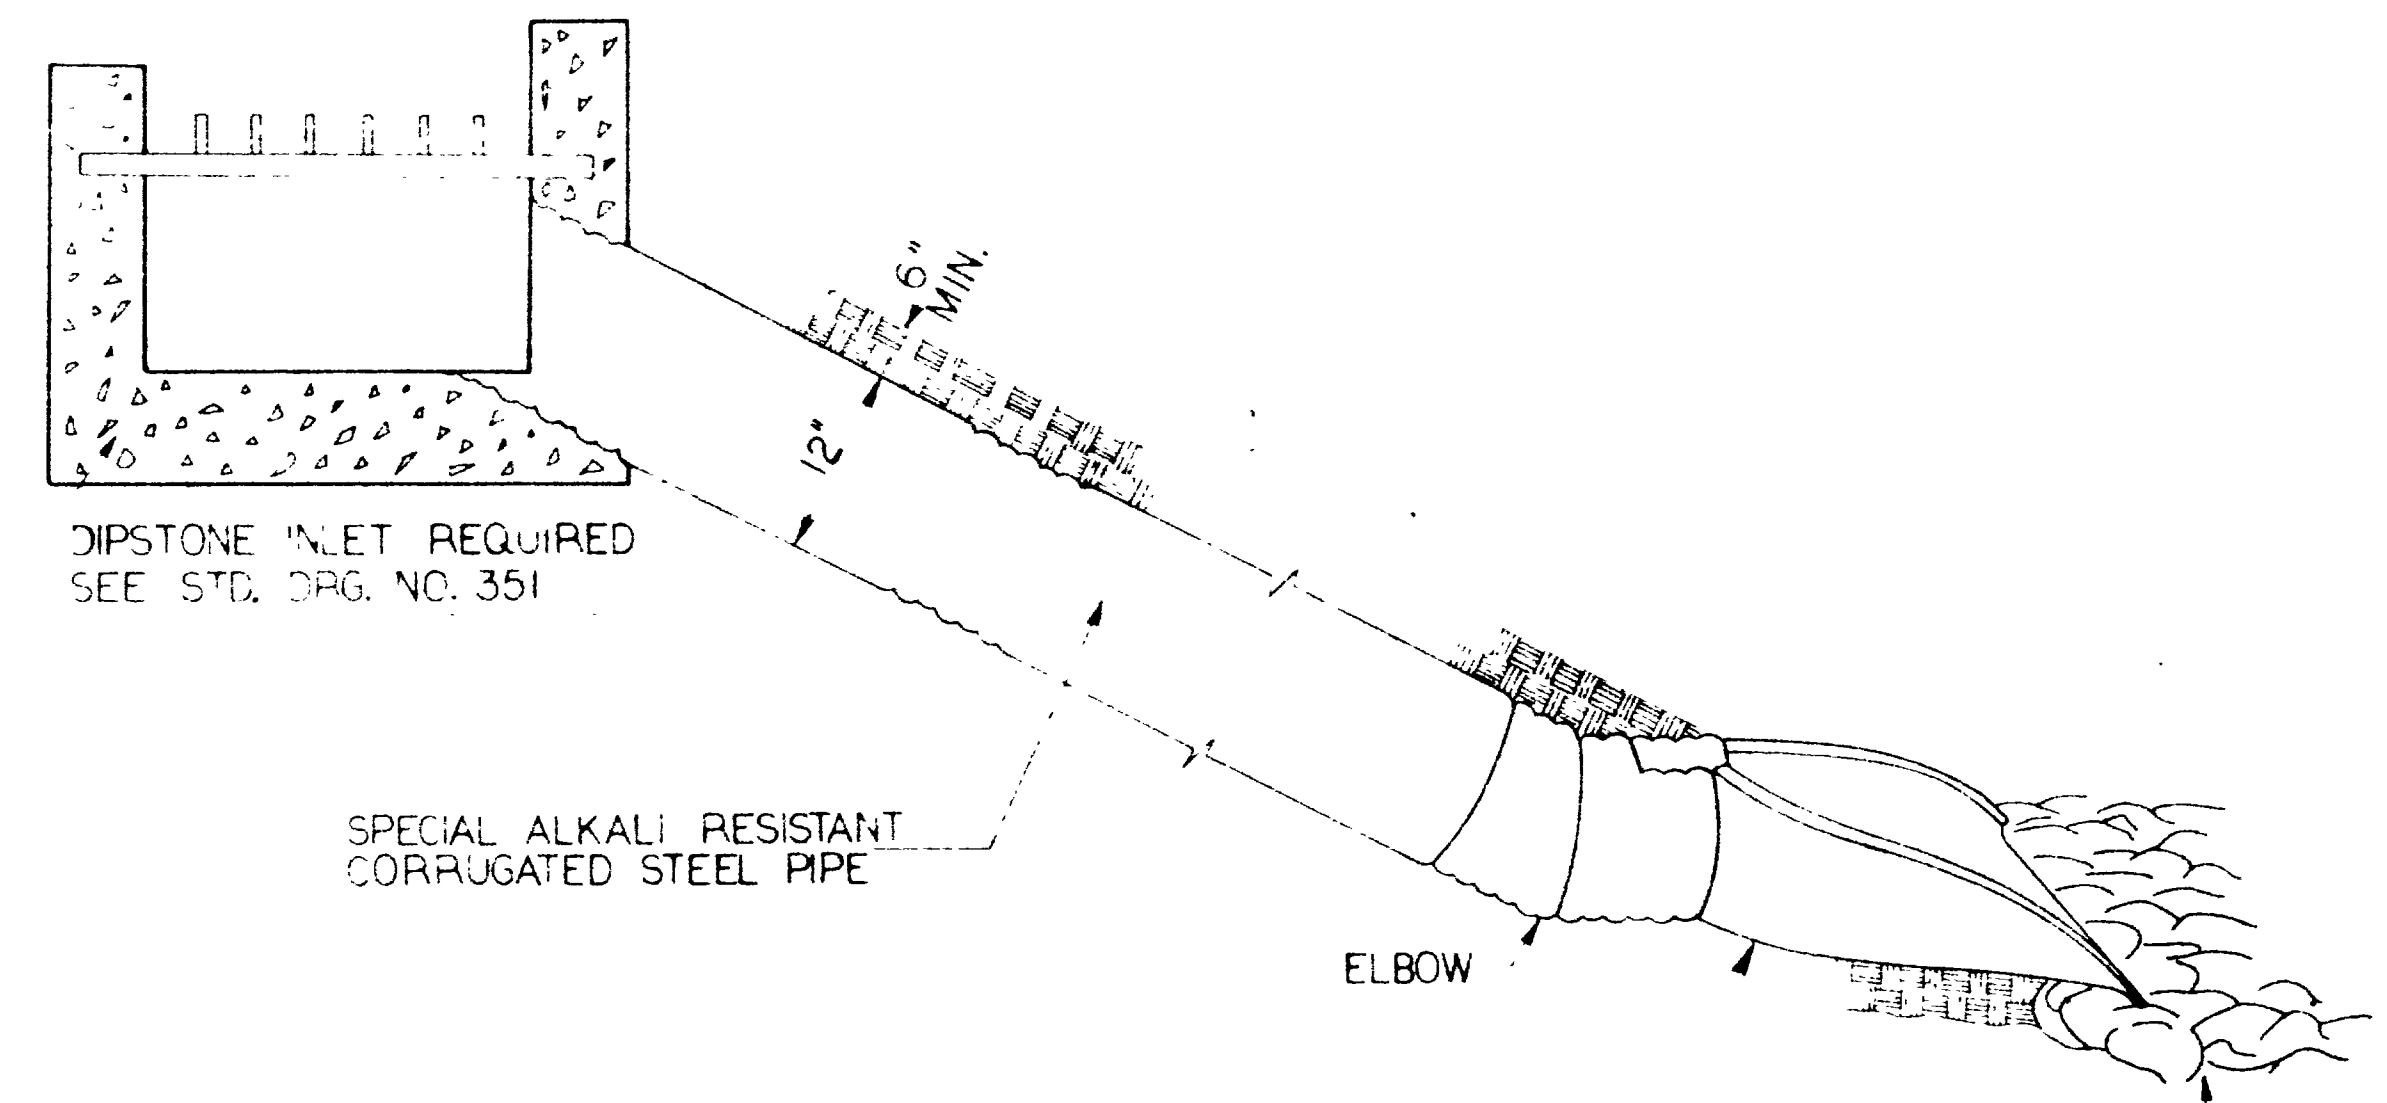




STEEL END SECTION
PAINT & ASPHALT COATED
SEE STD. DRG. NO. 302

RIPRAP SHALL BE PLACED
IN FANSHAPED HOLE ONE
FOOT DEEP.

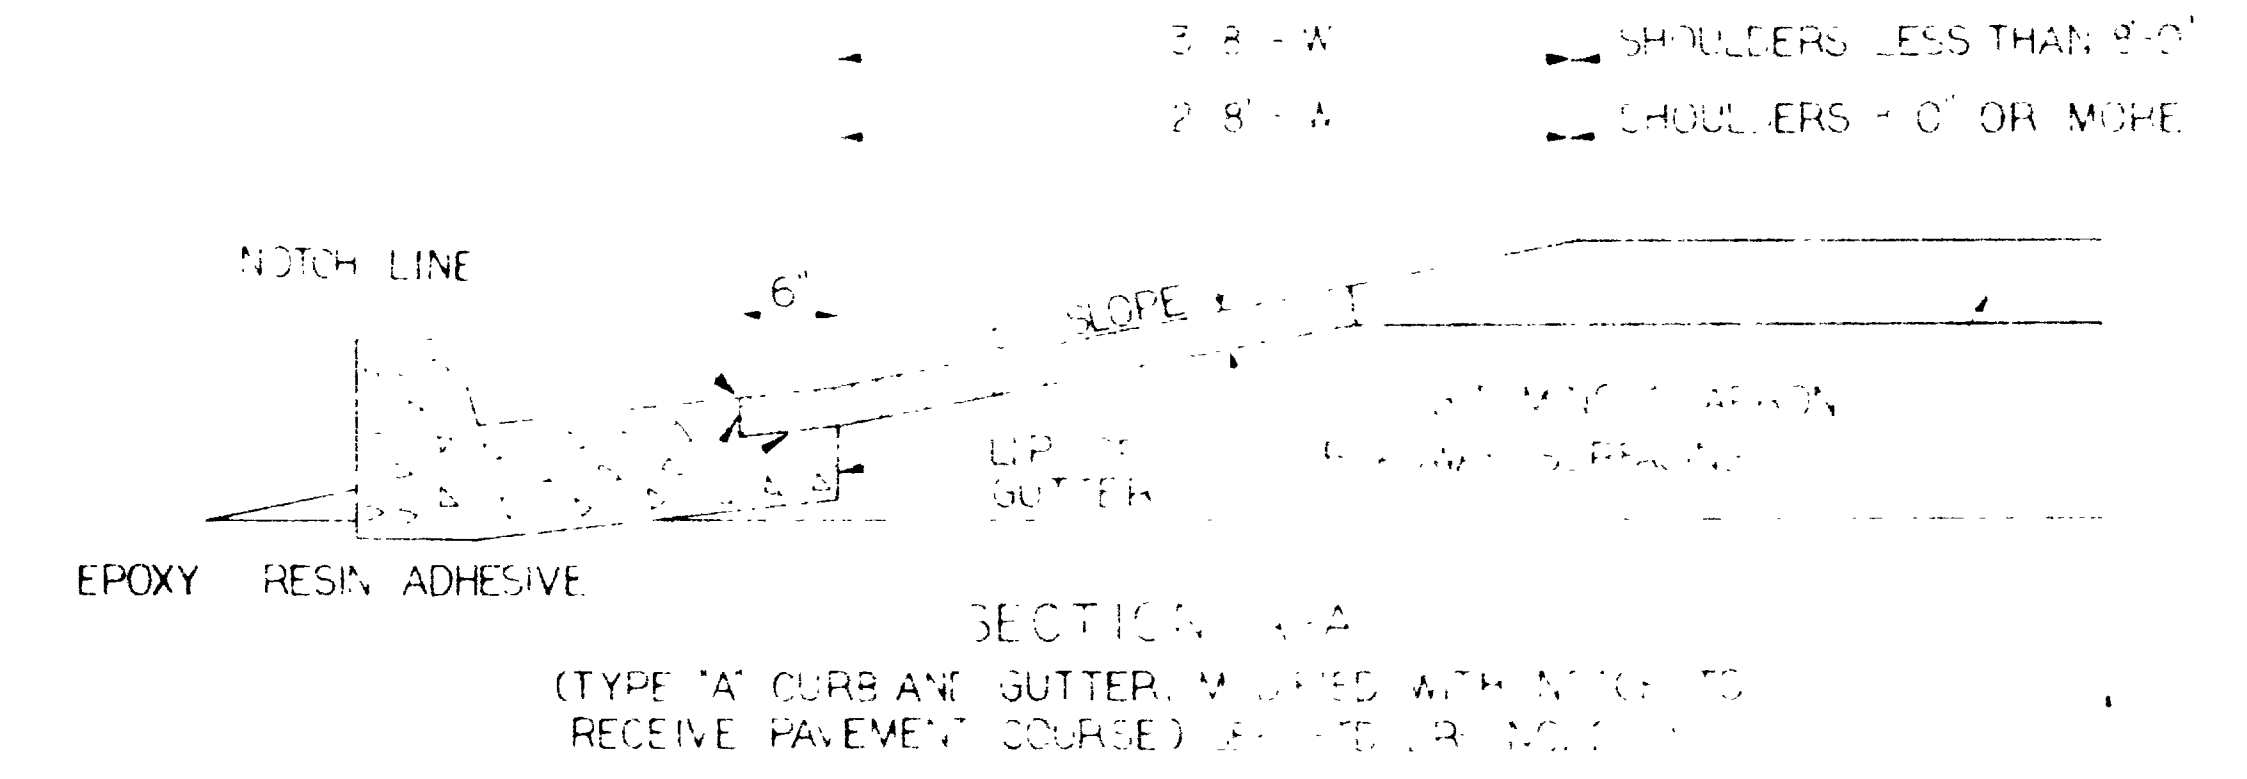


SHOULDER DRAIN PIPE & OUTLET INSTALLATION DETAIL




REV DATE 3/10/65

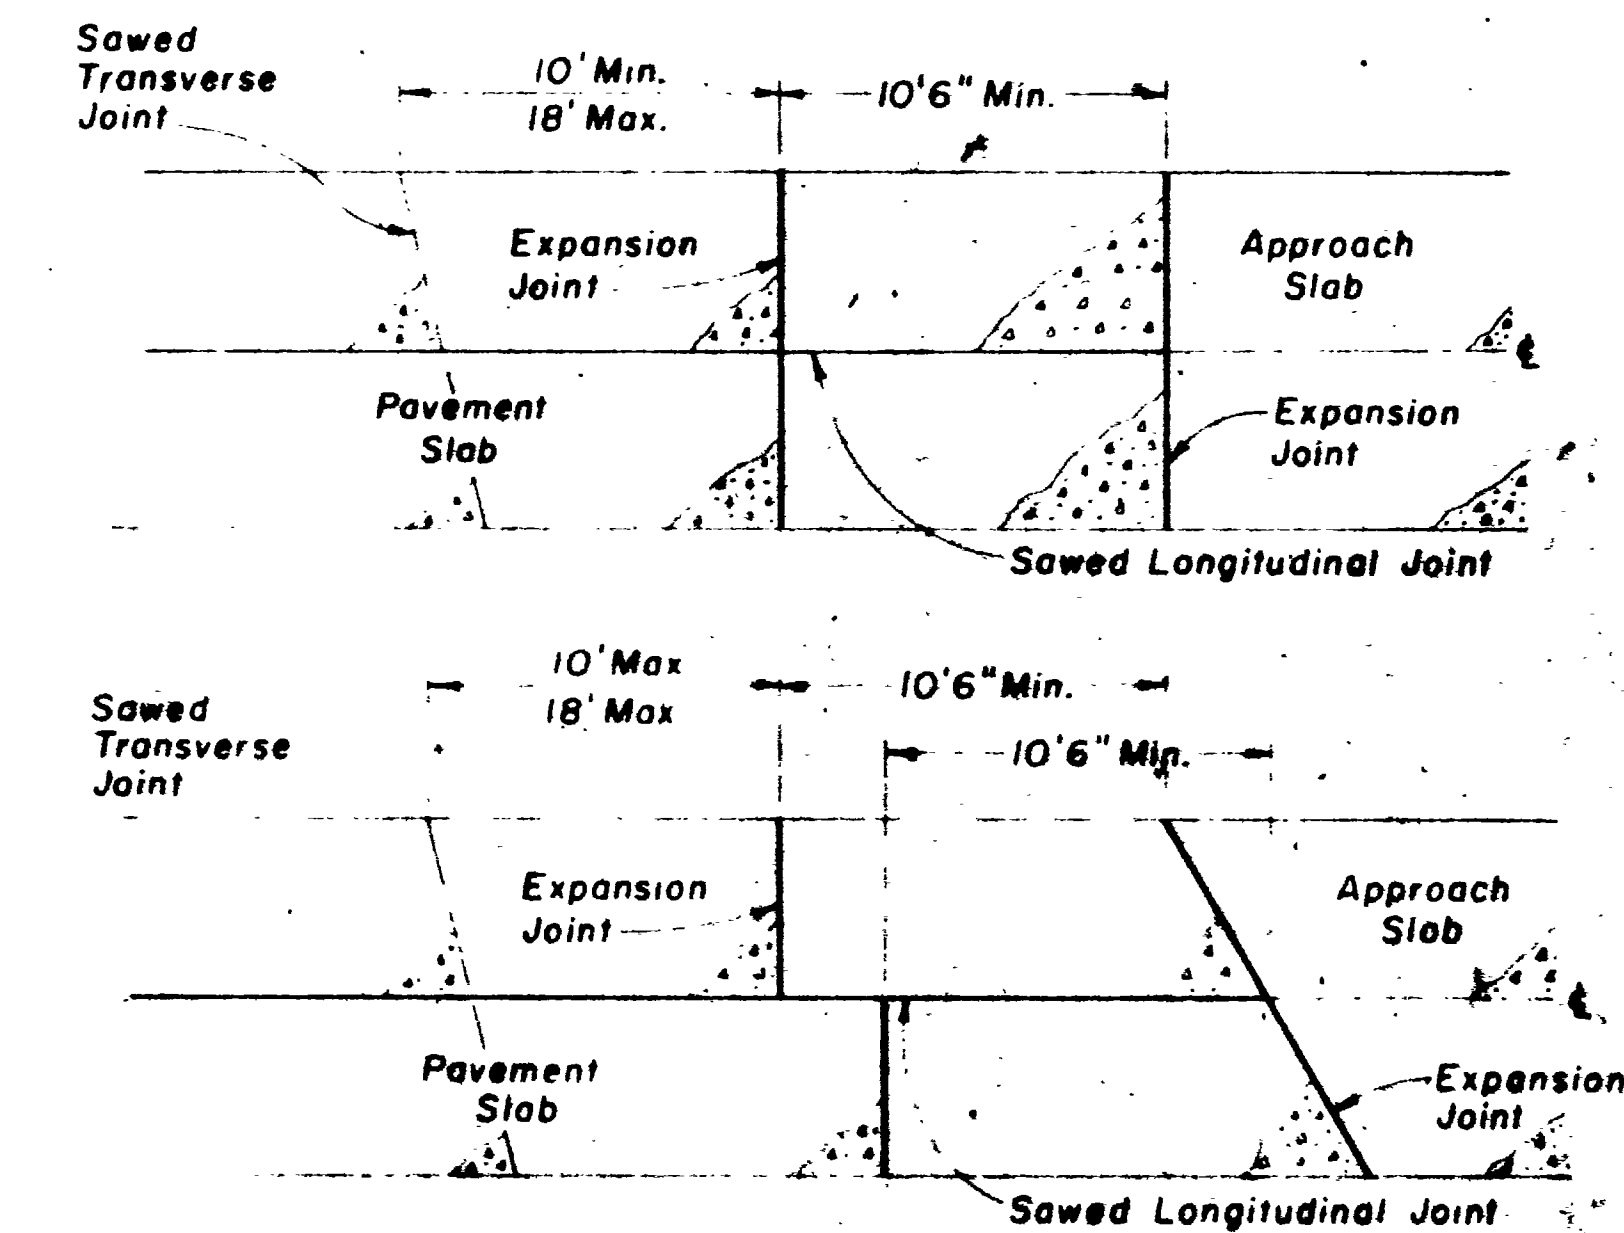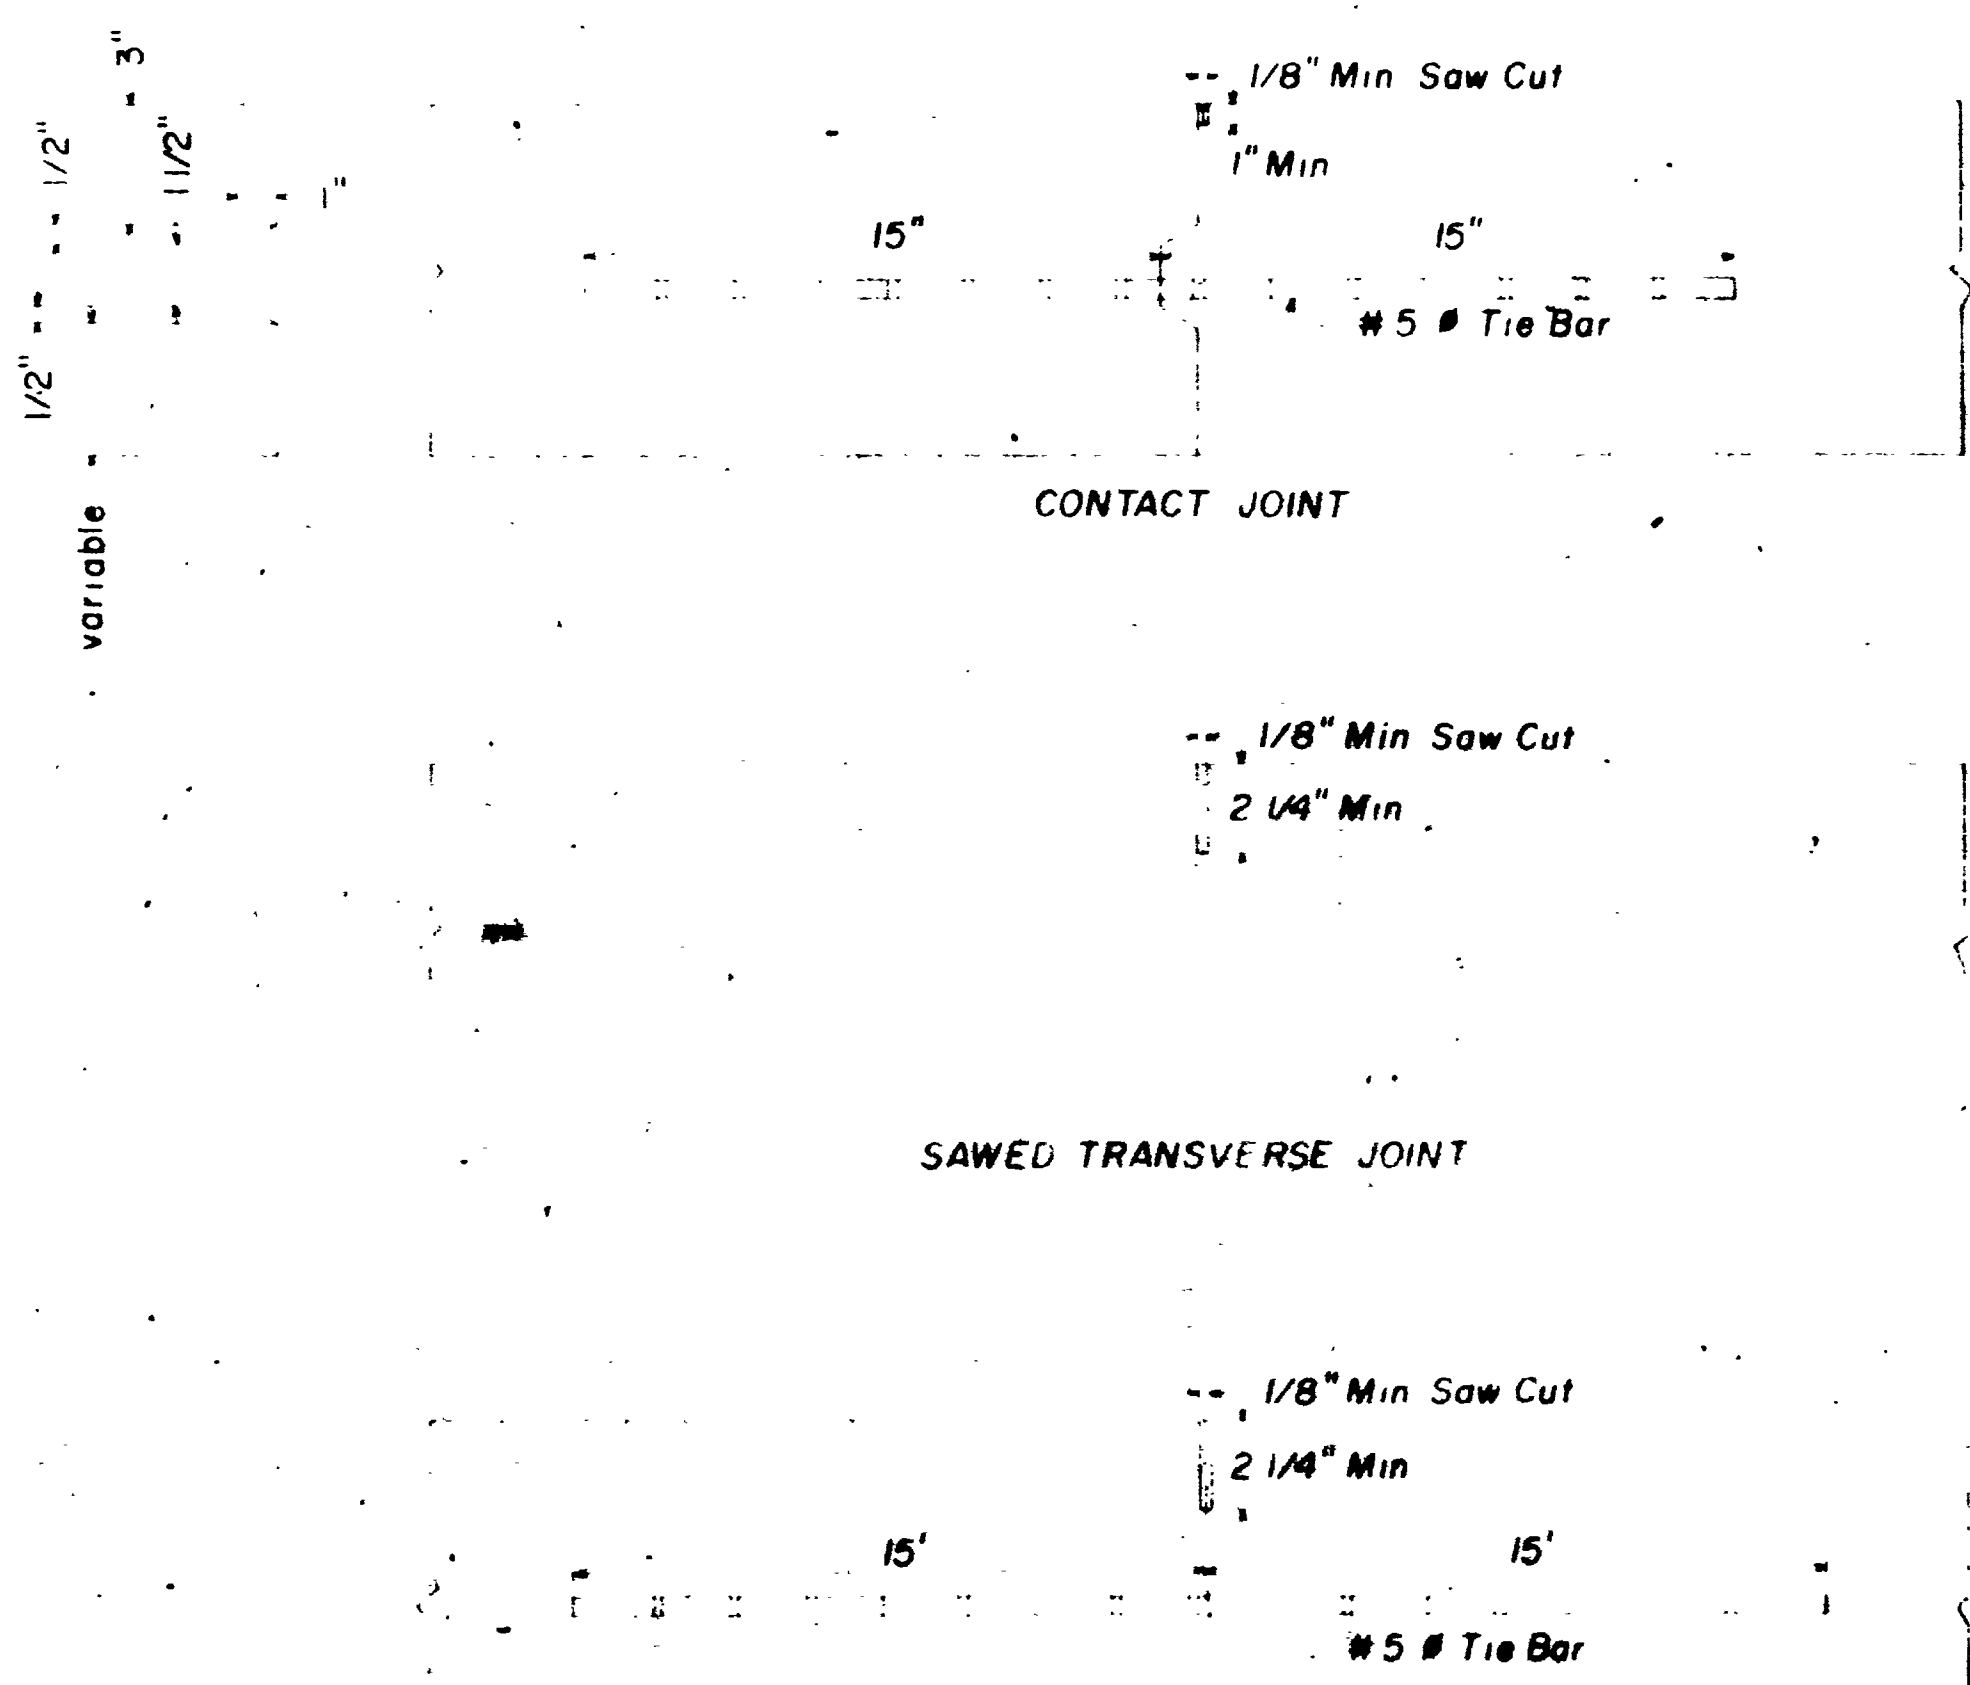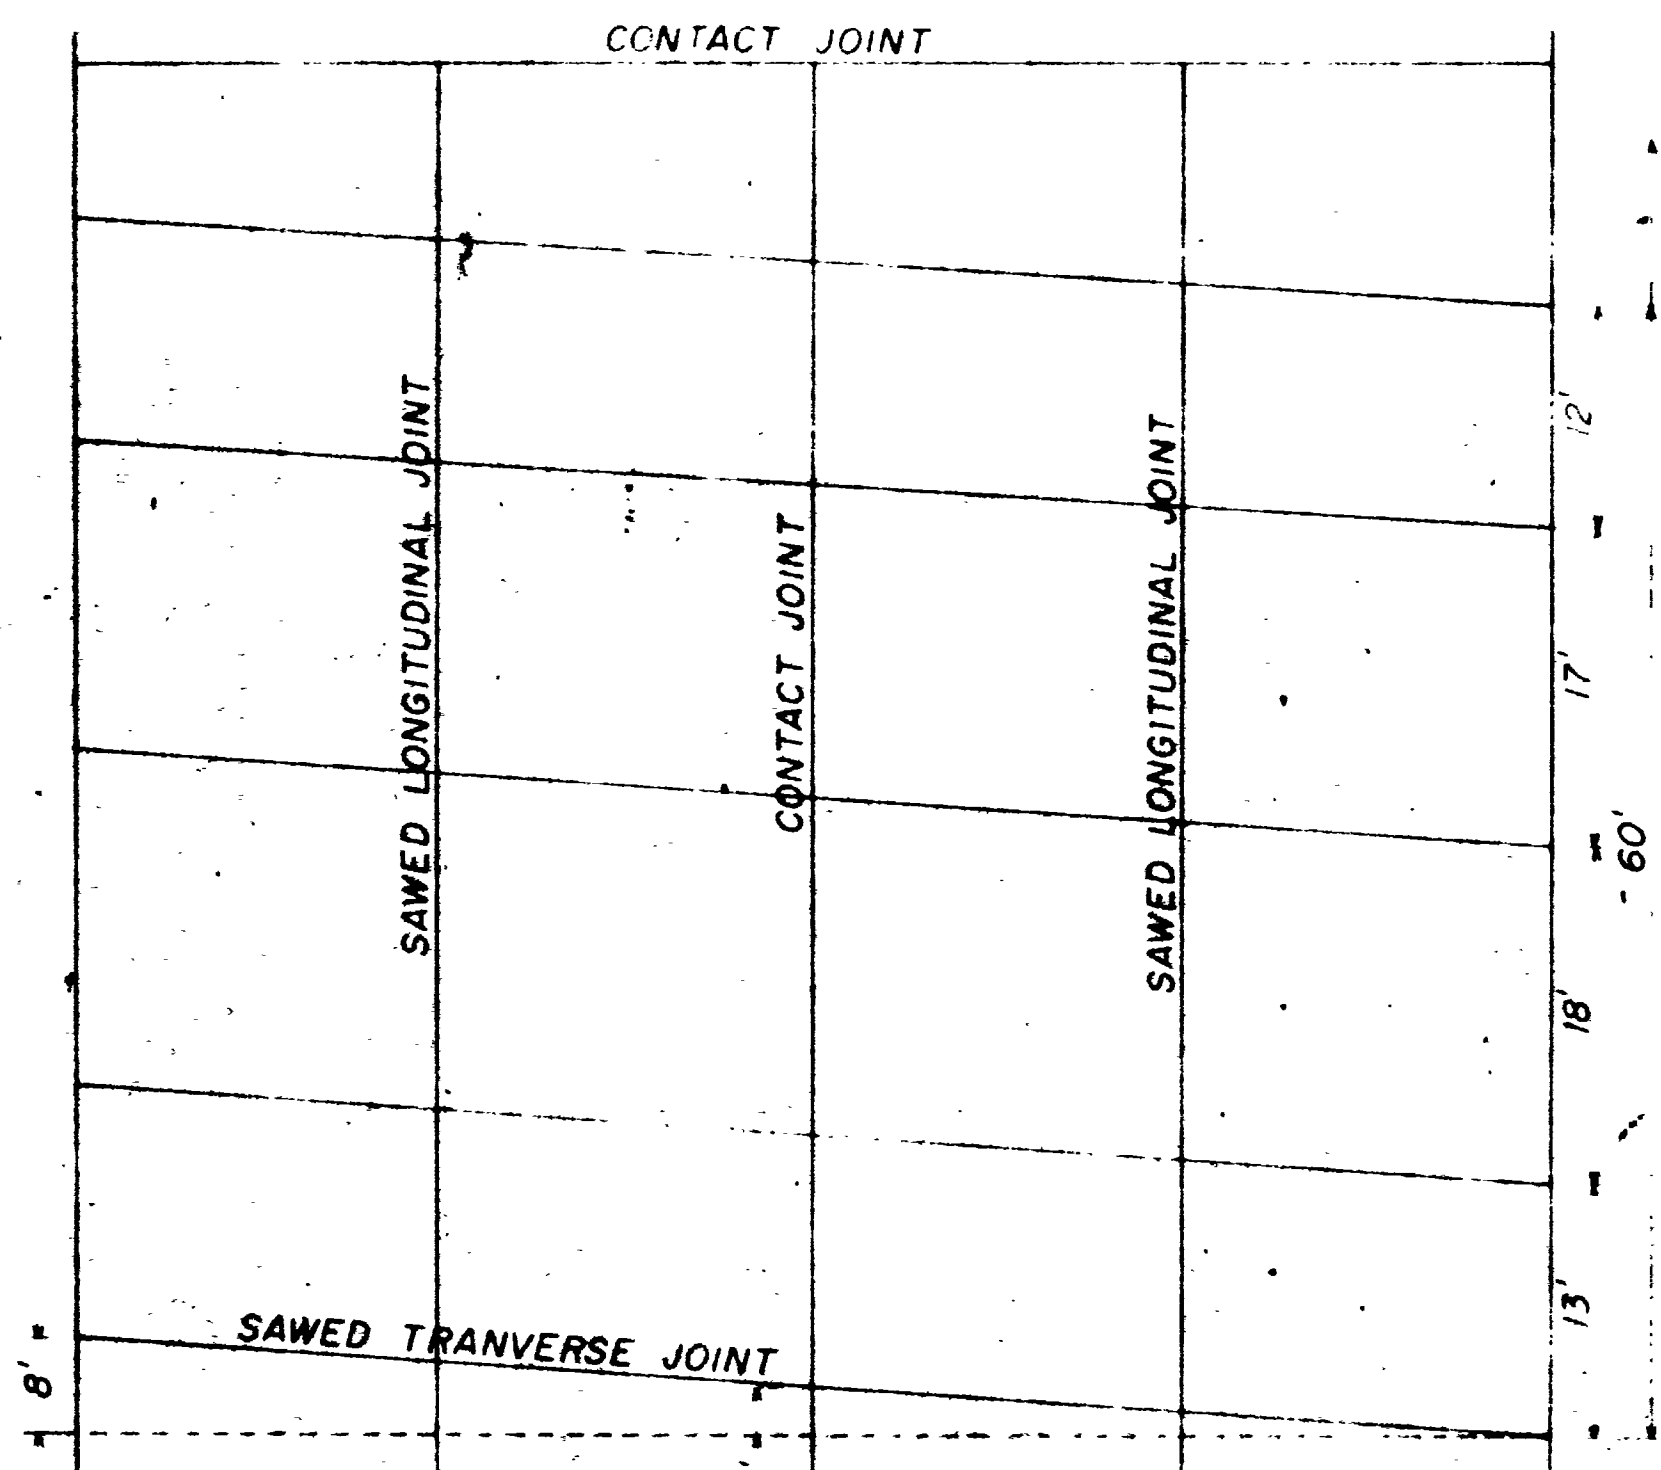

PLAN

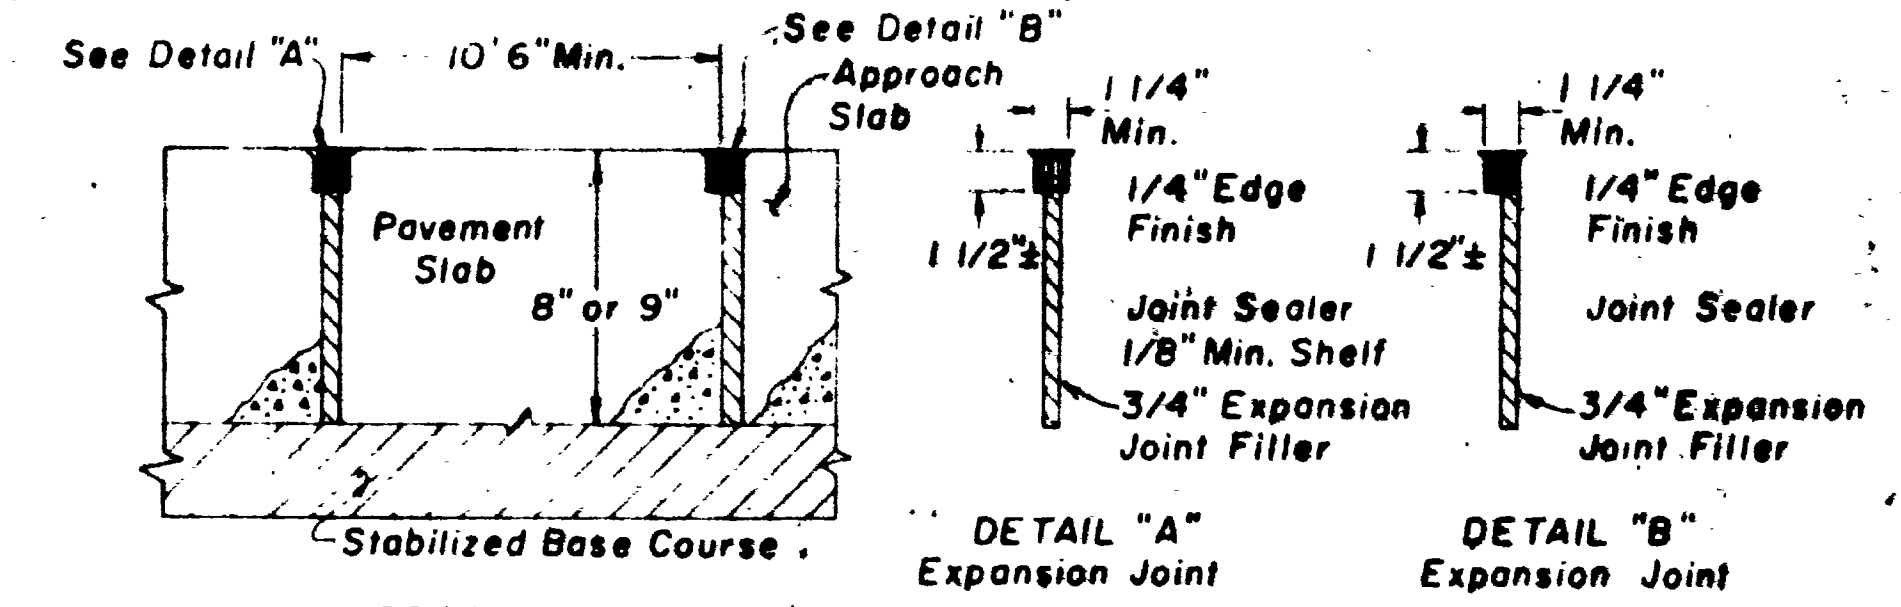

PROFILE

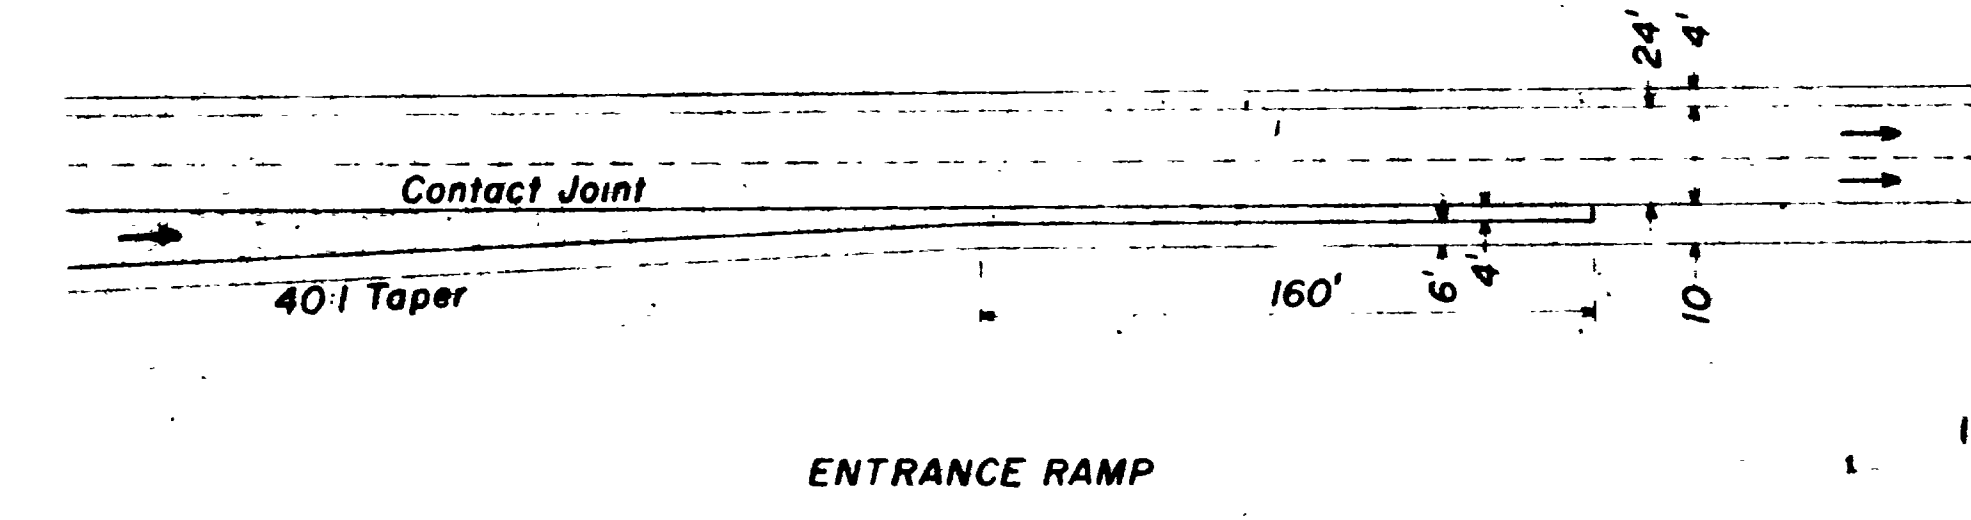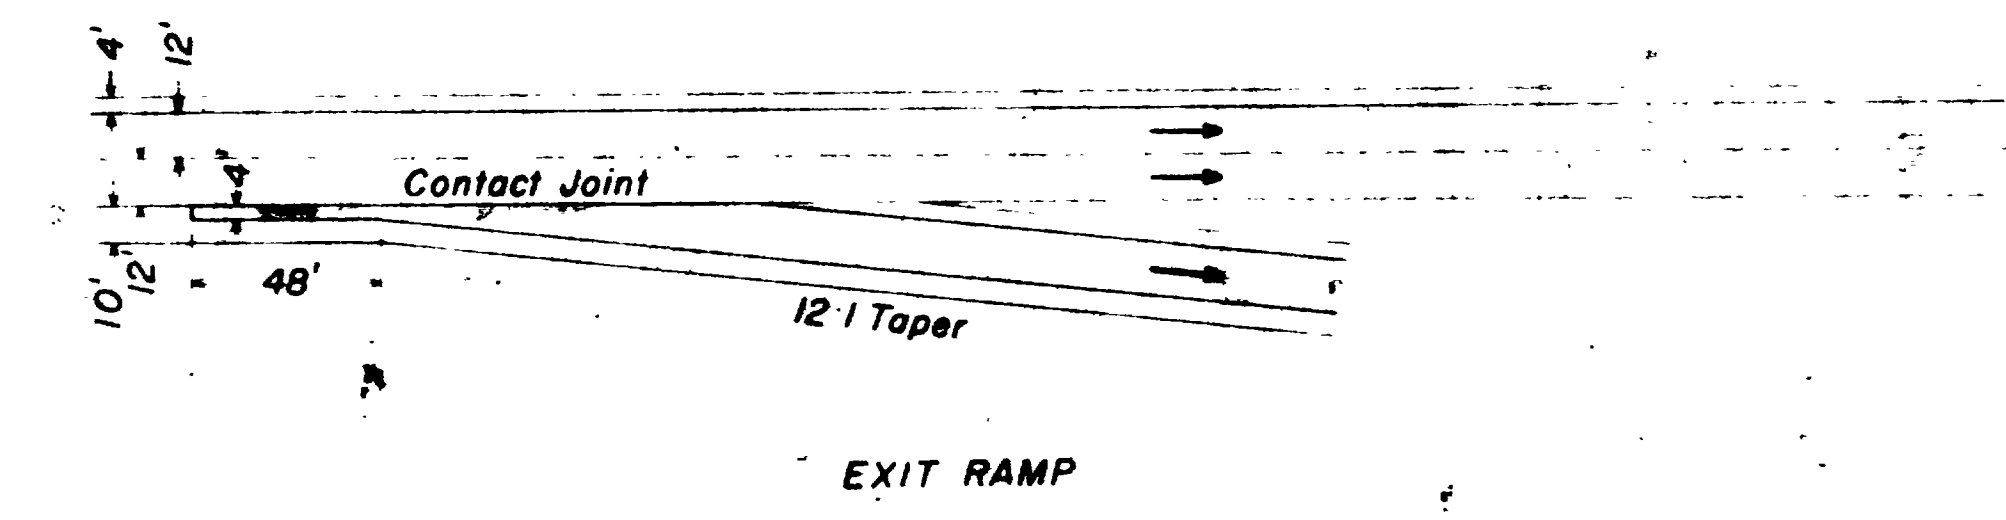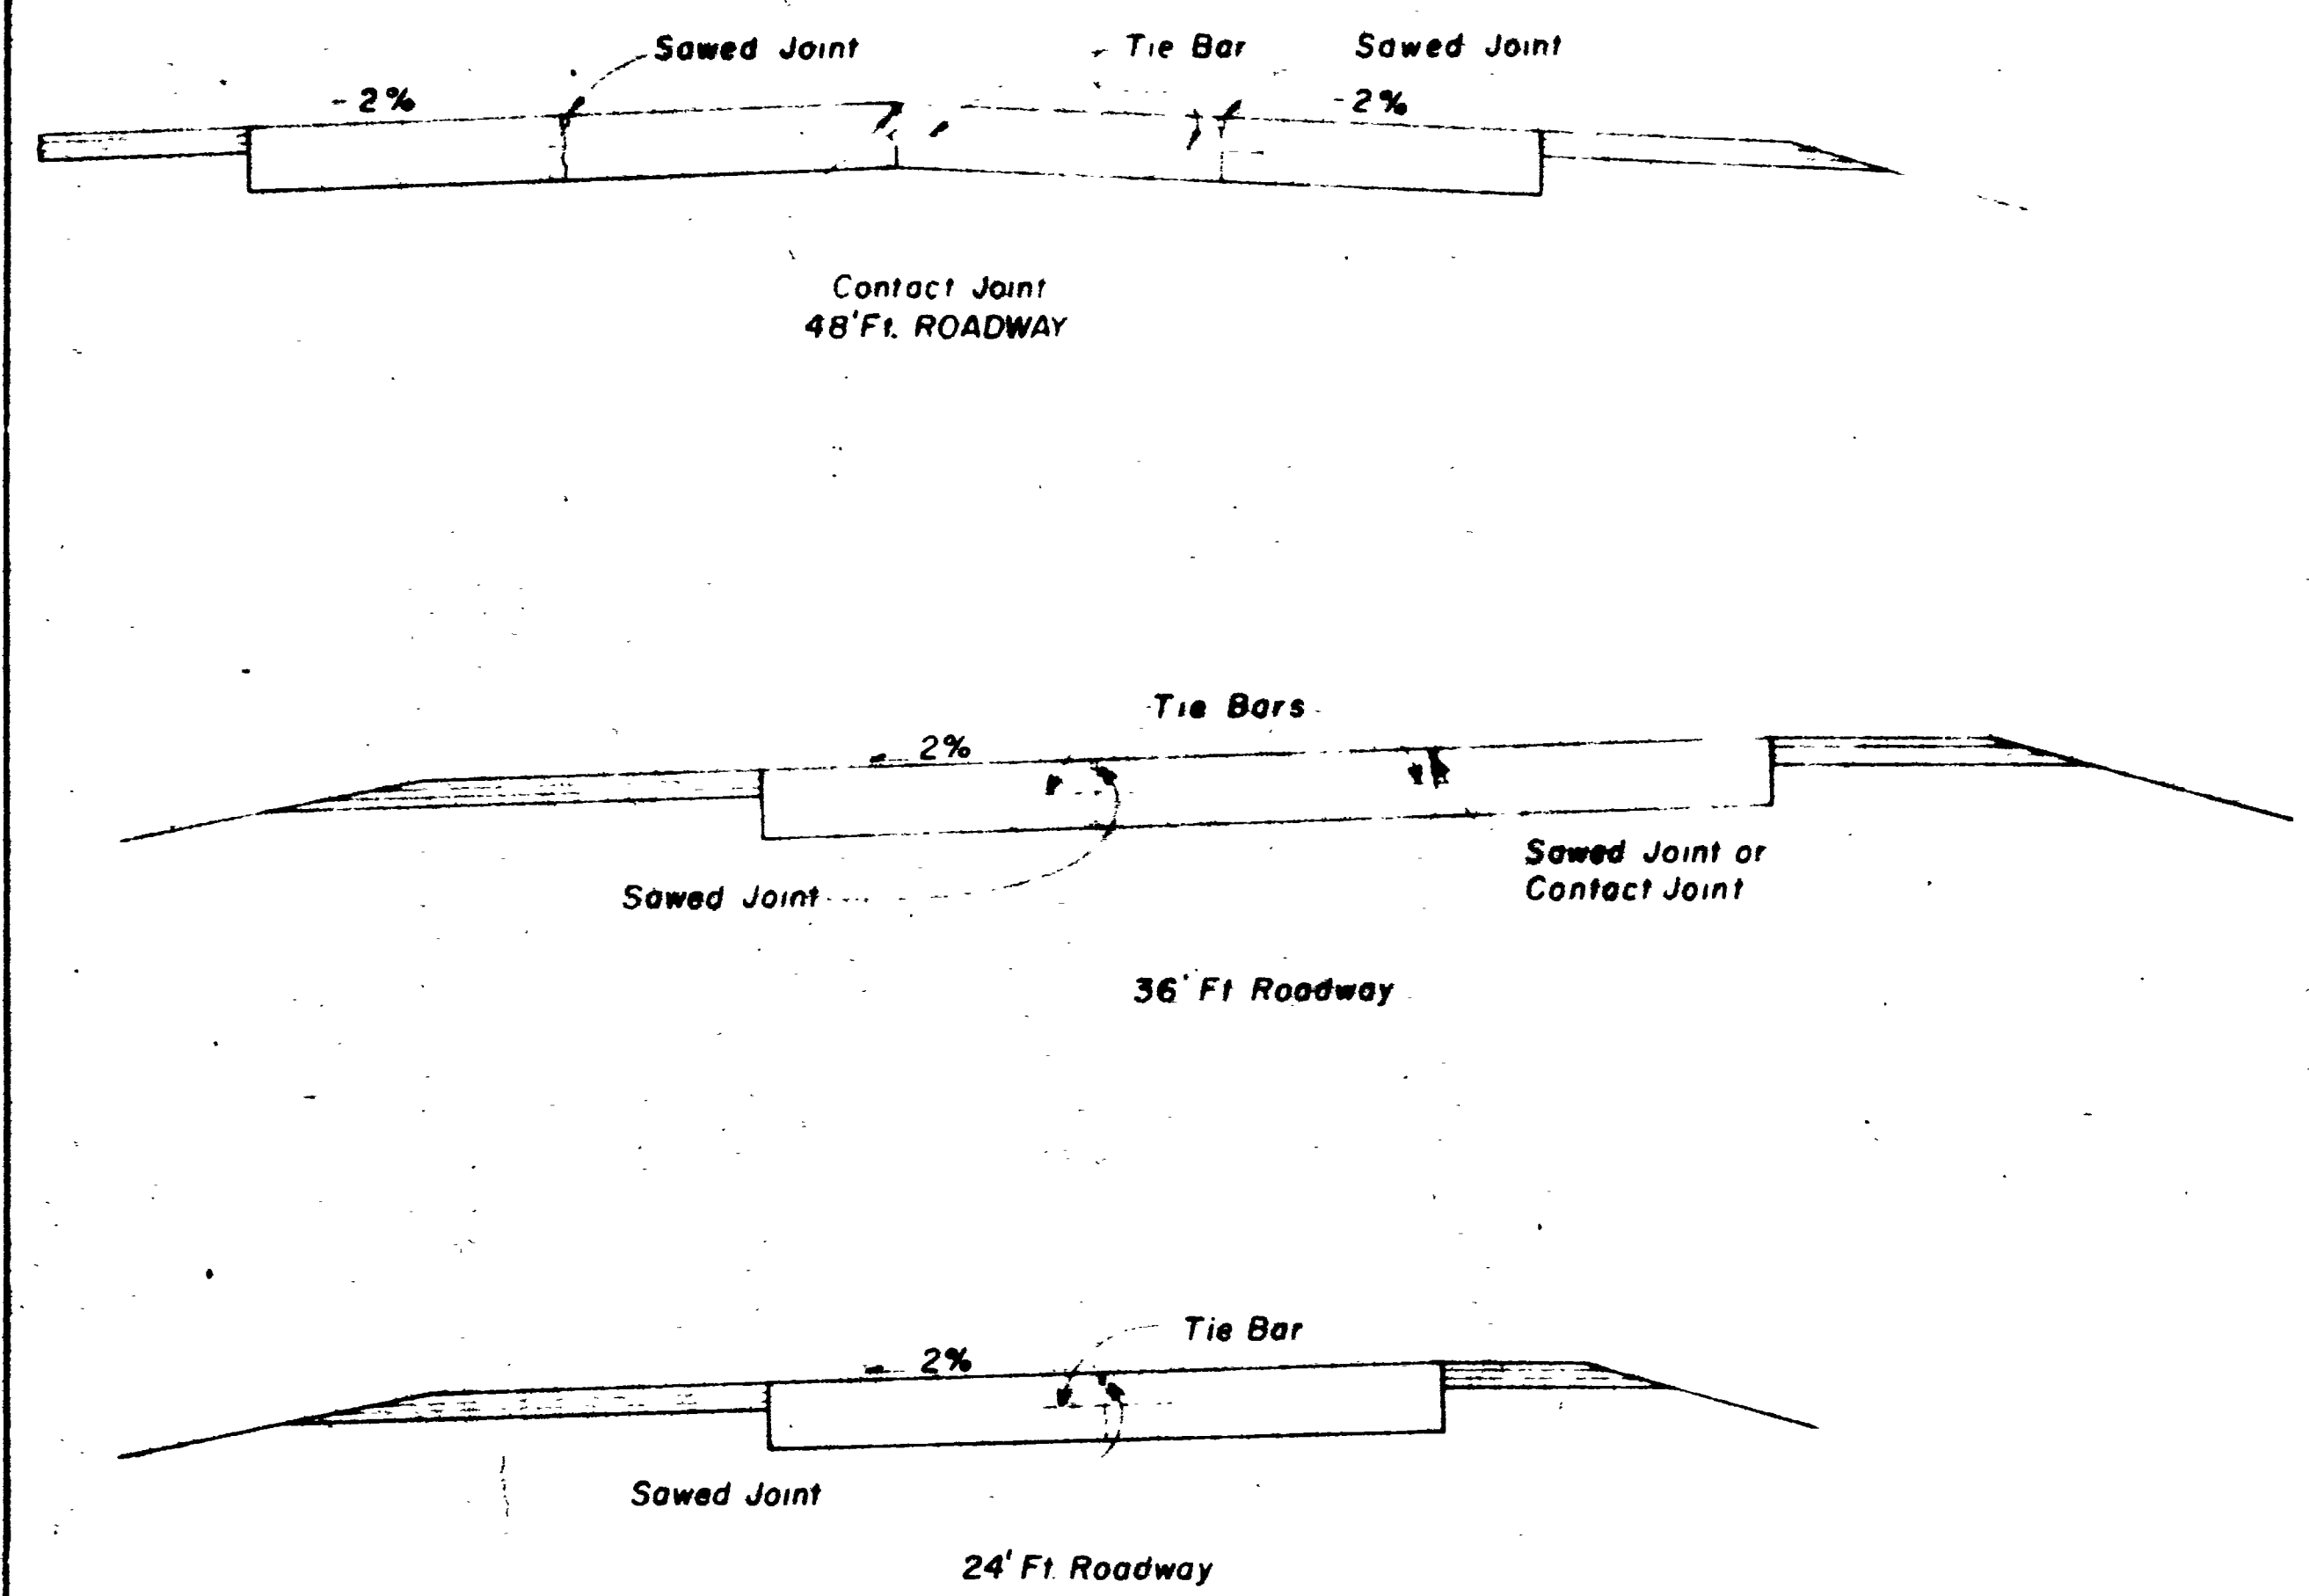

REVISIONS
DATE BY

SURFACING SUMMARY

				BASE MATERIAL		SURFACING MATERIAL										BITUMINOUS MATERIAL									
ROADWAY LANES or LINES	FROM STATION	TO STATION	LENGTH FEET	GRAVEL BASE		Plantmix Seal Coat	BITUMINOUS SURFACE						Plantmix Seal Coat	BITUMINOUS SURFACE		TACK COAT		TACK COAT		PRIME COAT					
				Course #			TYPE							TYPE		TYPE		TYPE		TYPE					
				Type	Maximum	Traffic Lane	Width	Depth	Ton	Width	Depth	Ton	Width	Depth	Ton	Width	Depth	Ton	Width	Depth	Ton	Width	Depth	Ton	
T-1	10+00	30+58.59	2058.59	32.33	5"	1,941	26.65	253	29.42	2"	747	27.75	2"	7.5	17.1	37.4	35.3	28.58	3.9	26.92	2.4	30.25	9.7		
T-4	10+00	27+81.33	1781.33	32.33	5"	1,680	26.65	22	29.42	2"	646	27.75	2"	6.0	5.3	32.3	30.5	28.58	3.4	26.92	2.1	30.25	8.4		
T-6	10+50	24+00	1350.00	32.33	5"	273	26.65	166	29.42	2"	450	27.75	2"	4.62	6	24.5	23.1	28.58	2.5	26.92	1.6	30.25	6.4		
T-7	10+50	20+35	985.00	32.33	5"	929	26.65	12	29.42	2"	357	27.75	2"	3.7	8.5	17.9	16.9	28.58	1.9	26.92	1.2	30.25	4.7		
T-1 DECELERATION LANE			408.00	12.00	5"	143	26.65	23	29.42	2"	60	27.75	2"	6.0	1.6	3.0	3.0	12.00	0.3	12.00	0.2	12.00	0.8		
I-15 N.B.	1040+00	1049+07.84	907.84	59.58	5"	1,578	53.85	226	56.67	2"	635	57.00	2"	6.6	5.8	31.8	30.8	55.83	3.3	54.17	2.2	57.50	8.2		
	1049+07.84	1050+00.00	92.16	59.58	5"	187	53.85	27	56.67	2"	76	57.00	2"	7.4	1.9	3.8	3.7	65.83	0.4	64.7	0.3	67.50	1.0		
	1050+00.00	1053+50.00	350.00	59.58	5"	710	53.85	03	56.67	2"	248	57.00	2"	2.4	7.2	14.4	14.1	65.83	1.5	64.17	1.0	67.50	3.7		
	1053+50.00	1059+16.24	566.24	59.58	5"	1,083	53.85	57	56.67	2"	438	57.00	2"	4.6	0	21.9	21.3	61.83	2.3	60.17	1.5	63.50	5.6		
I-15 N.B.	1059+16.24	1060+50.00	133.76	59.58	5"	249	53.85	35	56.67	2"	97	57.00	2"	9.4	2.4	4.9	4.7	57.83	0.5	56.7	0.3	59.50	1.2		
I-15 S.B.	1040+00	1045+00	500.00	59.58	5"	869	53.85	24	56.67	2"	349	57.00	2"	3.39	8.7	17.5	17.0	55.83	1.8	54.17	1.2	57.50	4.5		
	1045+00	1048+74.57	374.57	59.58	5"	706	53.85	02	56.67	2"	285	57.00	2"	2.77	7.1	14.3	13.9	60.83	1.5	59.17	1.0	62.50	3.7		
	1048+74.57	1053+50.00	475.43	59.58	5"	965	53.85	140	56.67	2"	39	57.00	2"	3.81	9.8	19.6	19.1	65.83	2.1	64.17	1.4	67.50	5.0		
	1053+50.00	1059+29.57	579.57	59.58	5"	1,109	53.85	60	56.67	2"	448	57.00	2"	4.36	11.2	22.4	21.8	61.83	2.4	60.17	1.5	63.50	5.8		
I-15 S.B.	1059+29.57	1060+50.00	120.43	59.58	5"	195	53.85	28	56.67	2"	78	57.00	2"	7.6	2.0	3.9	3.8	55.83	0.4	50.17	0.3	53.50	1.0		
31st STREET	177+70	183+92	622.00				83.3	240						16.8						83.30	2.3				
	183+92	188+00	408.00				96.7	183						12.8						96.70	1.7				
	188+00	193+00	500.00				68.0	157						11.0						68.00	1.5				
	193+00	197+70	460.00				76.0	162						11.3						76.00	1.5				
	200+10	201+90	180.00				80.0	66						4.6						80.00	0.6				
	201+90	207+70	580.00				76.0	204						14.3						76.00	2.0				
	209+10	212+65	355.00				68.0	111						7.8						68.00	1.1				
TOTAL						13,608		3007		5385		5174	210.4		269.6	259.0		28.2	28.5			69.7			
USE						14,300		3160		5700		5500	220		560		60					75			

* OR GRAVEL BASE COURSE STOCKPILED MATERIAL

MISCELLANEOUS SUMMARY

QUANTITY	UNIT	ITEM	USED
100	MAN HOUR	FURNISHING CONSTRUCTION SIGNS	LUMP
		FLAGGING	481.5
100	LUMP	FURNISHING WATER EQUIPMENT	LUMP
		CONCRETE CURB & GUTTER TYPE "A" *	50.0
18,000	CU YD	FURNISHING & SPREADING TOPSOIL	0
		FOR USE WITH STRUCTURE END DRAINS	
		SEE SMALL STRUCTURES SUMMARY SHEET 3-A	

LINEAR SUMMARY

LANES OF LINE	FROM STATION	TO STATION	EQUATIONS and STRUCTURES over 20 ft span	PROJECT LIN. FT.	LANES ROAD MILES	RAMP ROAD LIN. FT.	CROSSING ROAD LIN. FT.
I-15	962+00	1066+95		10495.00	1.988		
T-1	10+00	30+58.59				2058.59	
T-4	10+00	27+81.33				1781.33	
T-6	10+00	24+00				1084.08	
T-7	10+00	20+35				1444.57	
31 st ST	177+70	197+63.38					1997.38
31 st ST	200+02.24	207+83.06	STRUCTURE 0 to 0 234.84'				780.82
31 st ST	208+96.96	212+65	STRUCTURE 0 to 0 113.88'				368.06
ROADWAY LENGTH				10495.00	1.988	6368.57	3146.26
PROJECT LENGTH				10495.00	1.988		

SUMMARY OF ITEMS

QUANTITY	UNIT	ITEM	QUANTITY USED
	LUMP	FURNISHING CONSTRUCTION SIGNS	LUMP
100	MAN HOUR	FLAGGING	481.5
16,500	CU YD	EXCAVATION FOR STRUCTURES UNCLASSIFIED	25339.6
61,000	CU YD	UNCLASSIFIED ROADWAY EXCAVATION	37870.3
2,300	HOUR	MECHANICAL TAMPING	869
	LUMP	FURNISHING WATER EQUIPMENT	LUMP
200	M GAL	WATERING	750
4710	LIN. FT.	24" REINFORCED CONCRETE PIPE	4982
716	LIN. FT.	30" REINFORCED CONCRETE PIPE	372
4720	LIN. FT.	42" REINFORCED CONCRETE PIPE	4638
850	LIN. FT.	48" REINFORCED CONCRETE PIPE	814
2	EACH	24" REINFORCED CONCRETE PIPE END SECTION	4
196	LIN. FT.	12" CORRUGATED STEEL PIPE (SPECIAL ALKALI RESISTANT)	162
2	EACH	12" CORRUGATED STEEL PIPE END SECTION (SPECIAL ALKALI RESISTANT)	3
936	LIN. FT.	12" CORRUGATED PERFORATED STEEL PIPE UNDERDRAIN	1190
2,000	CU YD	GRANULAR BACKFILL	716.0
30	HRS	ROLLING, PNEU TIRE OR POWER ROLLER	32
5,700	TON	BITUMINOUS SURFACE COURSE	665325
5,500	TON	BITUMINOUS SURFACE COURSE 3/4" MAX	6713.85
3160	TON	PLANTMIX SEAL COAT	2718.0
220	TON	BITUMINOUS MATERIAL TYPE 60-70 PENETRATION ASPHALT	187.542
560	TON	BITUMINOUS MATERIAL TYPE 85-100 PENETRATION ASPHALT	652592
60	TON	BITUMINOUS MATERIAL TYPE RC-70 OR RC-250	13.25
25.22	TON	BITUMINOUS MATERIAL TYPE MC-250 TO SA NO. 6	21.87
35	CU YD	LOOSE RIPRAP	30.3
2	EACH	DIPSTONE	2
5149.5	LIN. FT.	DEEP BEAM HIGHWAY GUARDRAIL TYPE "A"	5149.5
20,300	LB	REINFORCING STEEL	16370
17,000	LB	STRUCTURAL STEEL	17265
192	CU YD	CLASS "A" CONCRETE A.E.	146.3
966	CU YD	CLASS "B" CONCRETE A.E.	868.18
	GAL	HIGHWAY TRAFFIC STRIPING	84.35
100	LIN. FT.	CONCRETE CURB & GUTTER TYPE "A"	50.0
18,000	CU YD	FURNISHING & SPREADING TOPSOIL	
14,300	TONS	GRAVEL BASE COURSE, STOCKPILED MATERIAL	15427.55
1450	LIN. FT.	36" REINFORCED CONCRETE PIPE	1450
730	LIN. FT.	BITUMINOUS CURB SA#2	1220.0
12.13	TON	HYDRATED LIME SA#3 NON-PARTICIPATING	12.13
4170	LIN. FT.	CHANGE FROM 5' TO 6' GUARDRAIL POSTS SA NO. 1	5149.5
839.17	FORCE RCT	REMODEL, DECELERATION LANE OF I-15 & PART OF T-6 LINE SA NO. 4	840.34
2	EACH	SHOULDER DRAIN INLETS SA NO. 5	2

WATERING SUMMARY

LANE OR LINE	LENGTH LIN. FT.	GRAVEL BASE COURSE TONS	CUBIC YARD	WATER 25 GAL. PER YD M GAL
I-15 NB	907.84	1578	834.9	20.9
" "	92.16	187	98.9	2.5
" "	350.00	710	375.7	9.4
" "	566.24	1083	573.0	14.3
I-15 NB	133.76	240	127.0	3.2
I-15 SB	500.00	869	459.8	11.5
" "	374.6	706	373.5	9.3
" "	475.43	965	510.6	12.8
" "	579.6	1109	586.8	14.7
" "	120.43	195	103.2	2.6
T-1	2058.59	1941	1028.0	25.7
T-4	1781.33	1680	888.9	22.2
T-6	1350.00	1273	673.5	16.8
T-7	985.00	929	491.5	12.3
T-7 GRANULAR MATERIAL		9883	522.9	13.1
TOTAL				191.3
USE				750

STRIPING SUMMARY

LANE OR LINE	4" SKIP WHITE LINE MILE	4" SOLID WHITE LINE GAL.	8" SOLID WHITE LINE MILE	8" SOLID WHITE LINE GAL.
31 st STREET	1.62	9.72	2.70	43.20
I-15	1.96	11.76	1.52	24.32
T-1			0.78	12.48
T-4			0.67	10.72
T-6			0.55	8.80
T-7			0.41	6.56
				134.60
				145

APPLICATION (FOR ESTIMATING PURPOSES ONLY)

TYPE OF STRIPING	GAL PER MILE
4" SKIP WHITE LINE	6
4" SOLID WHITE LINE	16
8" SOLID WHITE LINE	32

GUARD RAIL SUMMARY

LANE OR LINE	STATION FROM	STATION TO	LINEAR FEET LEFT	LINEAR FEET RIGHT
I-15	1040+28	1040+78		50
I-15	1060+20	1060+70		50
T-1	10+00	14+50	350	
T-1	12+00	14+50	450	
T-4	10+00	18+25		250
T-4	10+00	18+00		800
T-4	10+00	14+50	350	
T-4	25+25	27+75		250
T-6	11+00	23+50	1325	
T-6	22+50	24+50	325	
T-7	17+75	19+75		200
T-7	18+50	22+37.5	387.5	
T-1	30+00	30+50		50
T-1	29+00	30+00	100	
31 st ST.	188+10	189+85		175
31 st ST.	192+32	195+07	275	
31 st ST.	196+35	197+60		125
SUBTOTAL			2787.5	2300
+ 2 FT. FOR EACH END SECTION			44	62
TOTAL			3149.5	4169
USE			3149.5	4170

EARTHWORK

LINE LANE	STATION		ROADWAY EXCAVATION CUBIC YARD
	FROM	TO	
I - 15	1048+77	1062+00	38,885
T - 4	21+00	27+50	3,709
T - 6	10+00	19+50	7,292
T - 7	10+00	19+55	8,025
TOTAL			57,915
USE			61,000

SMALL STRUCTURES SUMMARY

SMALL STRUCTURES SUMMARY														
LANES OR LINE	STATION	LEFT OR RIGHT	BOX NO.	CONCRETE STRUCTURES			STRUCT. EXC.	MECH. TAMP	STRUCT. STEEL	REINFORC. STEEL	CONCRETE CLASS A		RIPRAP	DIPSTONE INLET
				DWG. NO.	LINE NO.	DISCRIPTION					CUBIC YARD	HOUR		
SOUTH STORM SEWER														
T-1	22+50 22+55	LT	1	V-750	4	CATCH BASIN	11.1 7.6	0.7	310	344 232	2.5 1.6			
T-2	17+00 16+88	RT	2	V-750	4	" "	7.4 7.5	0.7	310	232	1.4			
T-2	18+48 18+50	LT	3	V-750	5	" "	8.2 7.4	0.8	310	216 267	1.8 1.9			
T-2	20+00	LT	4	V-750	4	" "	9.7	0.9	310	232	1.8			
T-2	21+50	RT	5	V-750	5	" "	7.4	0.8	310	232	1.8			
T-2	21+50	LT	5-A	V-750	3	CATCH BASIN	7.4	0.6	310	232	1.8			
I-15	1047+50	MED	6	V-750	8	" "	10.4	1.0	310	344	2.4			
I-15	1047+70	RT	7	V-750	16	" "	18.5	1.6	310	471	2.5			
I-15	1048+50	RT	7-A	V-750	7	" "	9.7	0.9	310	305	2.2			
T-3	19+00 20+00	RT	8	V-750	20	" "	20.2 21.5	1.9	310	510 550	5.4 5.8			
T-4	20+74 18+20	LT	9	V-750	13	CATCH BASIN	16.1 20.7	1.8	310	424 543	4.3 5.6			
I-15	1048+70	LT	10	V-750	15	CATCH BASIN	17.4	1.5	310	232 464	1.8 4.7			
T-4	21+40	RT				OUTFALL NO. 1								10.7 8.5
NORTH STORM SEWER														
I-15	1067+00	MED	5	V-750	6	CATCH BASIN	6.7 8.9	0.8	310	225 272	1.6 1.6			
I-15	1068+50 1068+00	LT	6-A	V-750	6	" "	14.1 8.9	0.8	310	265 272	1.6 2.1			
I-15	1068+50	MED	6	V-750	7	" "	6.7	0.9	310	225	1.6			
T-3	23+23	RT	6-B	V-750	6	" "	9.7	0.9	310	305	2.2			
I-15	1068+00	RT	6-B	V-750	6	" "	6.5	0.8	310	225	1.6			
I-15	1061+00	LT	7-A	V-750	5	" "	7.4	0.8	310	232	1.8			
I-15	1061+00	MED	7	V-753	6	" "	8.2	0.8	310	265	1.9			
I-15	1061+00	RT	7-B	V-750	16	CATCH BASIN	13.0 11.5	1.0	310	330 292	2.0 2.4			
I-15	1058+00	MED	8	V-750	1	" "	9.4 10.2	1.6	310	282 305	1.8 2.6			
I-15	1058+00	RT	9-B	V-750	25	" "	12.4 7.4	1.0	310	269 232	2.9 1.8			
I-15	1055+80	LT	9-C	V-813	3	" "	31.0 7.4	2.6	310	709 232	7.3 1.8			
I-15	1055+00	LT	9-A	V-753	4	" "	36.3 9.0	3.0	310	831 241	8.5 2.0			
I-15	1055+00	MED	9	V-755	2	CATCH BASIN	9.8 14.2	0.8	310	284 358	2.1 3.5			
I-15	1053+40	LT	9-D	V-753	1	" "	13.3 8.3	1.1	310	301 216	3.1 1.8			
I-15	1053+00	RT	10	V-750	14	" "	7.4	0.6	310	204	1.6			
I-15	1052+00	RT	10-A	V-753	8	" "	24.7 8.3	2.0	310	559	5.5			
T-6	22+60	RT	11	V-755	7	" "	13.1 30.3	1.2	310	316 330	1.8 2.8			
T-5	12+40	LT	12	V-755	11	" "	18.1 17.1	1.5	310	726 600	7.5 4.2			
I-15	1067+00	LT	13	V-750	14	CATCH BASIN	21.9 14.8	1.8	310	305 484	3.8 5.1			
T-5	11+30	RT				OUTFALL NO. 2	24.7	2.0	310	232 559	1.8 5.8			
31 STREET	200+00	LT		SEE SHT. 2-B		STRUCTURE END DRAIN								9.3
31 STREET	200+00	RT		SEE SHT. 2-B		STRUCTURE END DRAIN								1.6
T-4	26+57	RT				Shoulder Drain								0.0
I-15	1059+00	LT	8A	V-750	3	Catch BASIN	6.7		310	225	1.6			2.2
I-15	1053+04	LT	9E	V-750	4	" "	5.9		310	232	1.8			1.2
I-15	1052+88	RT	10B	V-750	2	" "	7.4		310	188	1.3			
TOTAL USED							243.5	37.5	9300	11,250	104.0	22.2		2
TOTAL USED							243.5		9825	14,531	21.8	22.8		2

CONCRETE PAVED DITCH

CONCRETE PAVED DITCH						
LINE	STATION		TYPICAL NO.	REMARKS	CONCRETE CLASS "B"	LIN. FEET (CUBIC YARD)
	TO	FROM				
I - 15	1040+00	1047+30	2	LEFT CUT DITCH	730	57.4
I - 15	1040+00	1061+00	1	MEDIAN	2100	165.0
"	1041+50	1048+80	2	RIGHT CUT DITCH	730	57.4
"	1048+75	1053+50	2	LEFT CUT DITCH	475	37.3
"	C50+00	1053+50	2	RIGHT CUT DITCH	350	27.5
"	1055+00	1059+30	2	LEFT CUT DITCH	435	33.8
"	1055+00	C59+17	4	RIGHT CUT DITCH	417	32.8
T - 1	15+25	29+50	2	LEFT CUT DITCH	1425	112.0
T - 1	15+25	27+75	2	RIGHT CUT DITCH	1250	98.3
T - 4	16+00	25+50	2	LEFT CUT DITCH	950	74.7
T - 4	18+50	21+75	2	RIGHT CUT DITCH	725	57.6
T - 4	23+00	25+50	2	RIGHT CUT DITCH	250	19.6
T - 6	11+50	17+75	2	LEFT CUT DITCH	625	49.1
T - 6	10+00	19+00	2	RIGHT CUT DITCH	900	70.7
T - 7	10+00	17+25	2	LEFT CUT DITCH	725	57.0
T - 7	11+20	17+25	2	RIGHT CUT DITCH	605	47.5

SEE SHEET # 3B

TOTAL 365.7
 USE 966.6

LINE OR LANE	GRAVEL BASE COURSE	ROLLING 800 SQ.YL./HR
	SQ YD	HOURL
T-1	6919.15	384
T-4	5987.25	333
T-6	4537.50	252
T-7	3310.69	184
T-1 DECEL	544.00	030
I-15-N.B	5800.08	322
I-15-N.B	691.20	038
I-15-N.B	2625.00	146
I-15-N.B	3995.14	222
I-15-N.B	884.30	049
I-15-S.B	3194.44	177
I-15-S.B	2601.18	145
I-15-S.B	3565.73	198
I-15-S.B	4089.9	227
I-15-S.B	115.89	040
	Total	2749
	USE	3000

◆◆ SPECIAL ALKALI RESISTANT

DRAINAGE SUMMARY NO.2

BOX NO	LANES OF LINE	STATION		CROSSING OR REMARKS	PIPE CULVERT			STRUCT EXC	MECH. TAMP.
		FROM	TO		24"	36"	42"		
FROM-TO					REINF	CONC	PIPE	CUBIC YARD	HOURS
1	2	16+00	16+90	RT	32			325	13.1
2	3	16+90	17+00	RT	32			178.9	66.1
3	4	17+00	17+50	RT	300			241.5	65.1
4	5	17+50	18+00	RT	300			233.5	99.6
5	6	18+00	18+50	RT	300			273	70.6
6	7	18+50	19+00	RT	300			260	300
7	8	19+00	19+50	RT	300			350.3	40.4
8	9	19+50	20+00	RT	300			400.0	48.7
9	10	20+00	20+50	RT	300			427.0	53.2
10	11	20+50	21+00	RT	300			347.2	39.9
11	12	21+00	21+50	RT				344.3	30.7
12	13	21+50	22+00	RT				381.4	40.0
13	14	22+00	22+50	RT				411.8	44.6
14	15	22+50	23+00	RT				369.7	39.7
15	16	23+00	23+50	RT				380.6	41.7
16	17	23+50	24+00	RT				433.4	42.6
17	18	24+00	24+50	RT				364.9	36.0
18	19	24+50	25+00	RT				428.7	46.7
19	20	25+00	25+50	RT				406.0	61.6
20	21	25+50	26+00	RT				477.6	53.1
21	22	26+00	26+50	RT				345.3	47.1
22	23	26+50	27+00	RT				408.3	43.2
23	24	27+00	27+50	RT				383.2	39.0
24	25	27+50	28+00	RT				414.3	18.5
25	END	28+00	28+00	RT				195.5	3.6
1	16+90	16+90	16+90	RT				17.9	114.8
* Total					1370	1450	4295	8602.1	
Total Used					1371	1450	4295	8602.1	


SMALL STRUCTURES SUMMARY NO.2

LANE "or" F-LINE	STATION	BOX NO	CONCRETE STRUCTURES		STRUCT EXC	MECH. TAMP.	STRUCT STEEL	REINF. STEEL	CONC CLASS "A"	RIPRAP
			DWG NO	LINE NO						
					CUBIC YARD	HOURS	LBS	LBS	CUBIC YARD	CUBIC YARD
FLINE	16+90	1	V-750	15	Catch Basin	7.62	1.37	310	305	2.1
" I-15	16+90	2	V-750	18	"	8.199	3.32	310	285	1.9
" I-15	17+35	3	V-750	7	"	8.197	1.62	310	285	1.9
" I-15	17+40	4	V-750	64	"	8.197	4.13	310	285	2.1
" I-15	17+45	5	V-750	24	"	10.7248	4.13	310	285	2.1
" I-15	17+50	6	V-754	5	"	10.711.5	1.92	310	280	2.7
" I-15	17+55	7	V-754	5	"	11.52.3	2.05	310	280	2.7
" I-15	18+00	8	V-754	5	"	11.512.3	2.05	310	280	2.9
" I-15	18+05	9	V-754	10	"	10.715.6	2.60	310	249	2.3
" I-15	18+10	10	V-754	18	"	10.714.0	2.33	305	249	2.3
" I-15	18+15	11	V-755	1	"	12.4	2.07	305	271	2.6
" I-15	18+20	12	V-755	42	"	15.33	2.22	305	350	3.3
" I-15	18+25	13	V-755	3	"	14.3	2.70	305	316	3.7
" I-15	18+30	14	V-755	34	"	14.3	2.53	305	316	3.7
" I-15	18+35	15	V-755	3	"	14.3	2.70	305	316	3.5
" I-15	18+40	16	V-755	3	"	14.3	2.70	305	316	3.5
" I-15	18+45	17	V-755	3	"	14.3	2.70	305	316	3.5
" I-15	18+50	18	V-755	4	"	15.2	2.07	305	350	3.3
" I-15	18+55	19	V-755	19	"	12.4	3.17	305	271	2.6
" I-15	19+00	20	V-755	5	"	12.4	2.70	305	271	2.6
" I-15	19+05	21	V-755	5	"	12.4	2.70	305	271	2.6
" I-15	19+10	22	V-755	4	"	12.4	2.53	305	271	2.6
" I-15	19+15	23	V-755	4	"	12.4	2.53	305	271	2.6
" I-15	19+20	24	V-755	42	"	15.2	2.22	305	350	3.3
" I-15	19+25	25	V-755	2	"	13.3	2.22	305	301	2.9
Outfall										9.3
* Total					379.6	63.28	7675	8955	87.2	9.3
Total Used					292.0		7370	6949	64.5	7.5

* Note: For Use totals see Small Structures and Drainage Summaries Composite.

CONCRETE PAVED DITCH

LINE	STATION		TYPICAL NO	REMARKS	CONCRETE CLASS "B"	
	TO	FROM			LIN. FEET	CUBIC YARD
I-15	1061+08	1039+85	1	MEDIAN	2123	162.07
I-15	1036+81	1039+00	1	LT. CUT DITCH	319	24.35
I-15	1043+20	1039+85	2	" " "	335	26.30
I-15	1047+30	1044+66	2	" " "	264	20.73
I-15	1053+50	1048+41	2	" " "	509	39.96
T-1	15+45	28+15	2	" " "	1319	103.55
T-1-T-2	T-2	T-1	1	MEDIAN	465	35.50
	1-15	T-2	1	"	329	25.12
T-4	20+50	14+42	2	LT. CUT DITCH	608	47.73
T-4	24+57	20+50	2	" " "	399	31.32
T-4	26+02	23+29	2	RT " "	288	22.61
T-6	11+00	17+50	1	LT " "	668	51.00
T-6	1059+00	1022+10	1	RT " "	1147	87.56
	22+50	378.37	1	"	234	17.86
	T-7	T-8	1	MEDIAN	160	12.21
T-7	17+20	1055+00	2	LT. CUT DITCH	1021	80.14
I-15	1047+50	1045+50	2	RT " "	200	15.70
I-15	1053+50	1049+62	2	" " "	388	30.46
I-15	1059+00	1054+80	2	" " "	433	33.99
TOTAL USED					11204	868.18

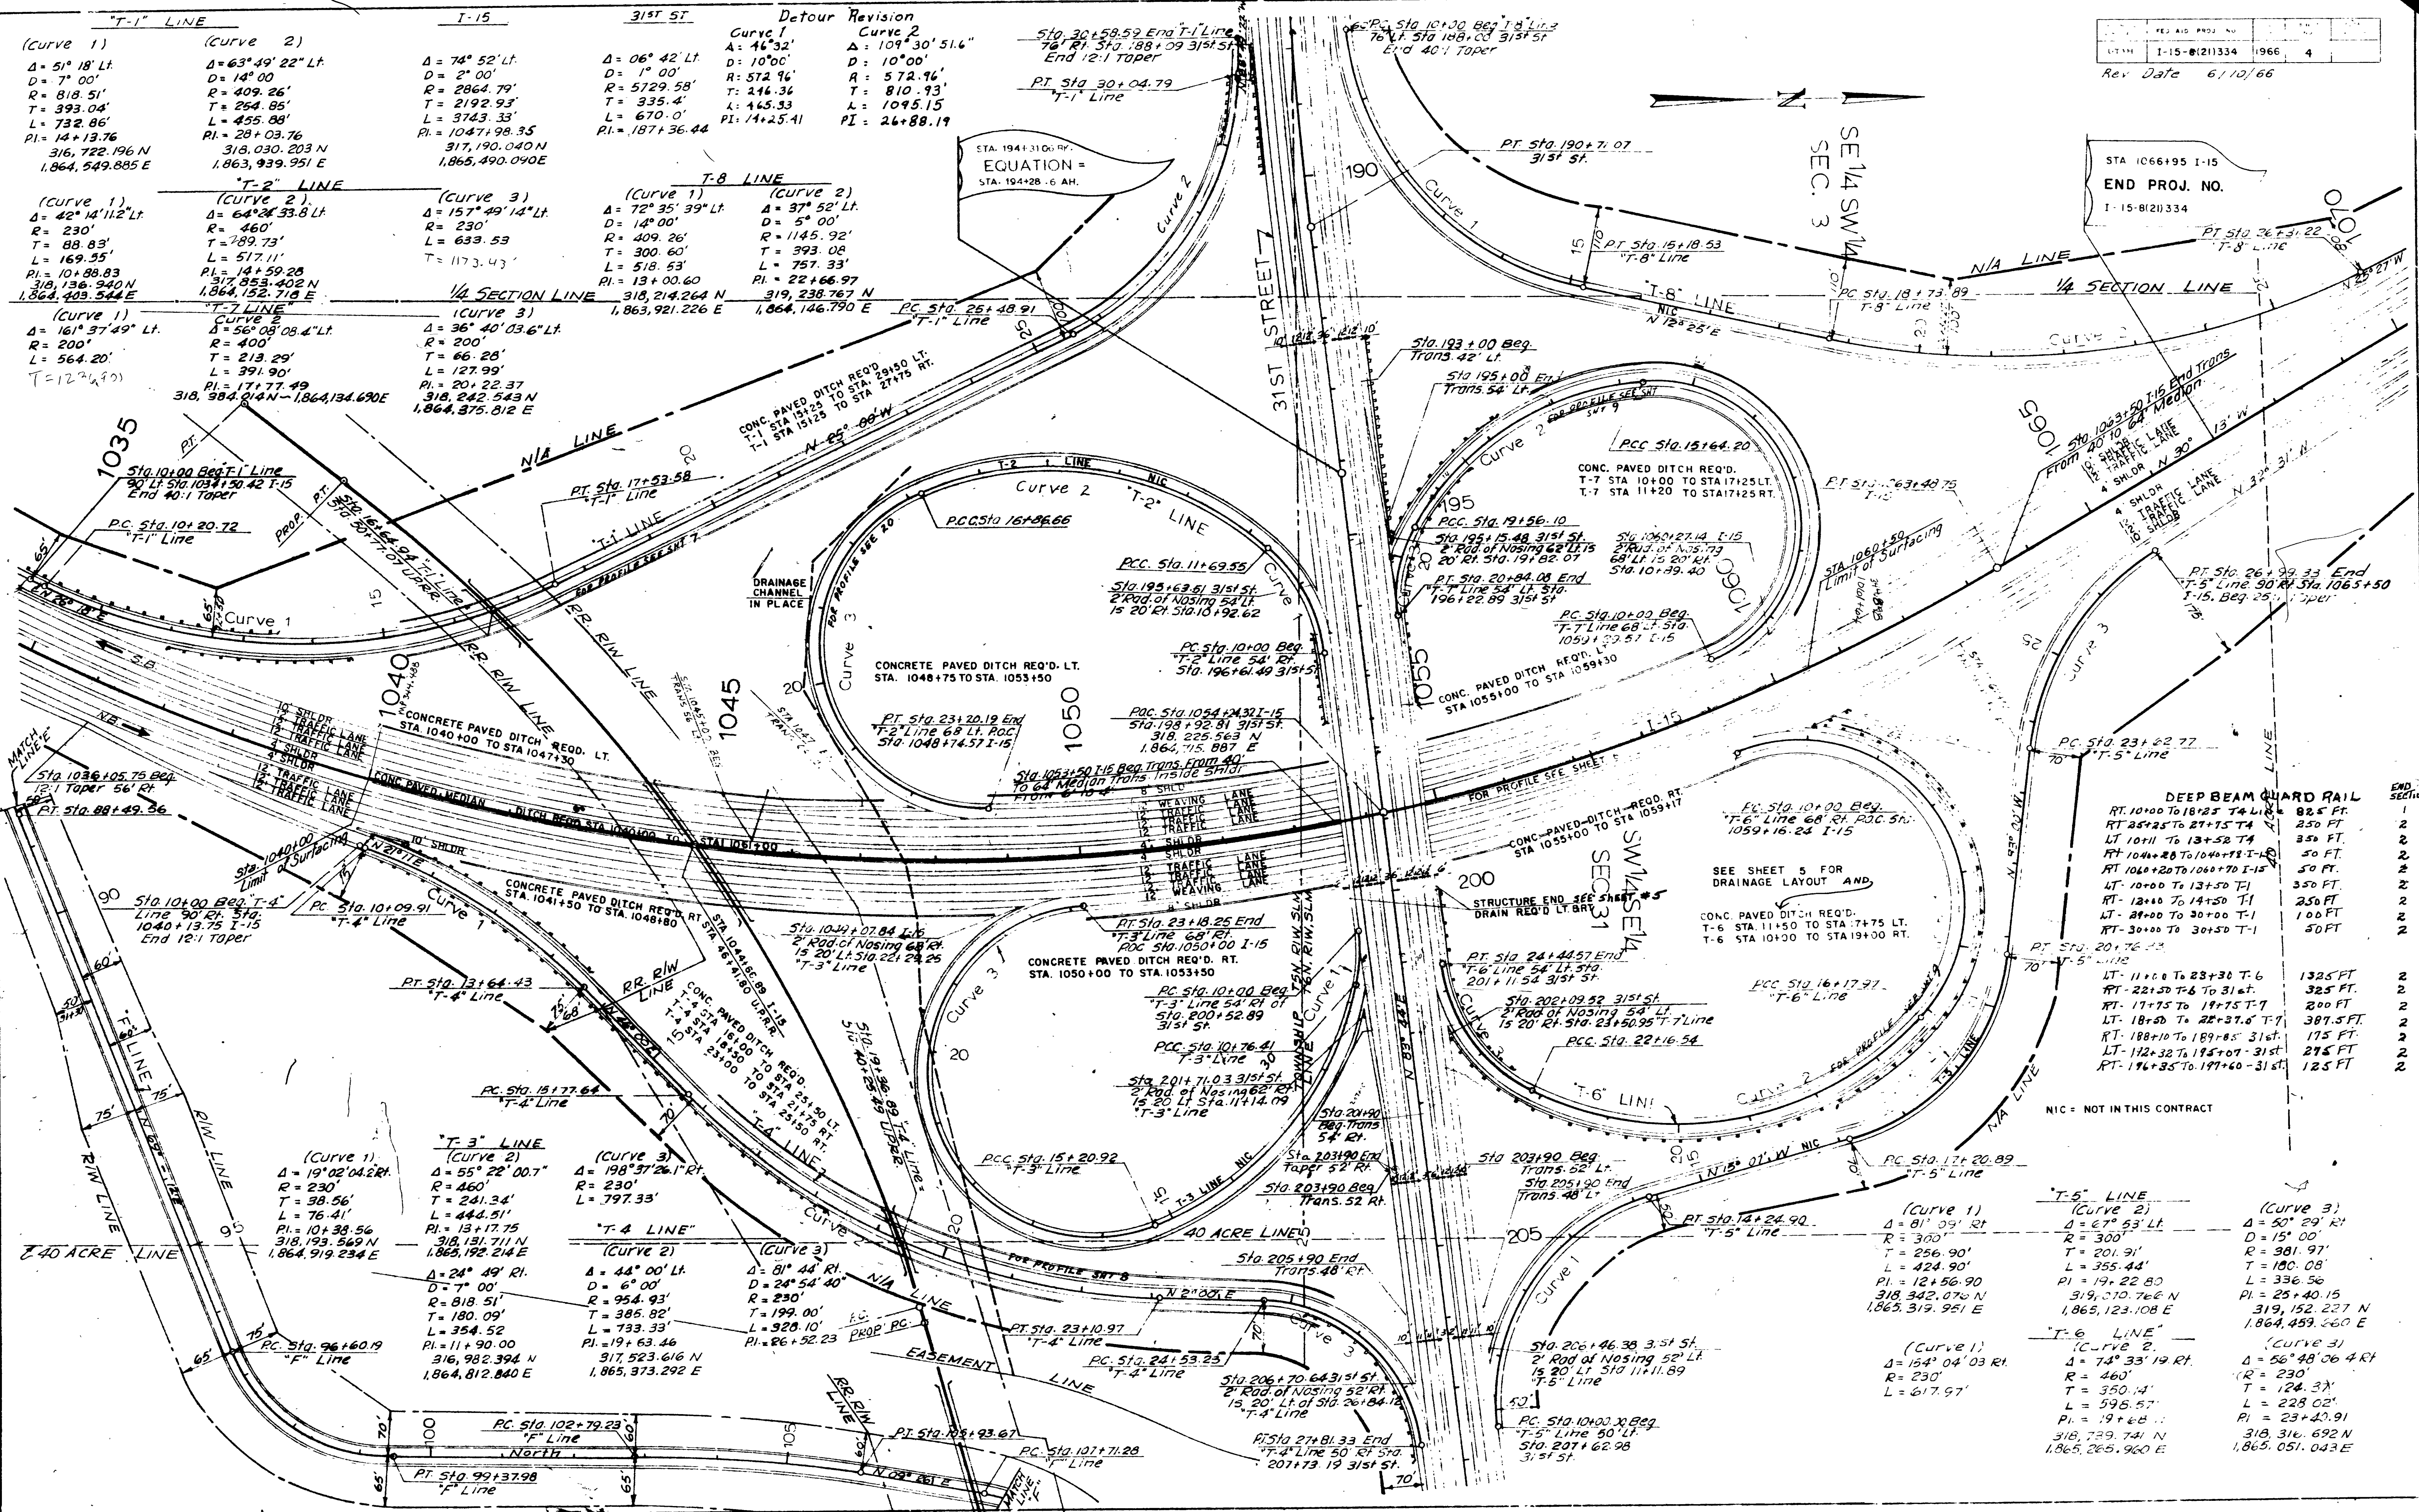

REVISIONS

NO.	DATE	BY	DESCRIPTION
1			
2			
3			
4			
5			
6			
7			
8			
9			
10			

DEEP BEAM GUARD RAIL

SECTION	RT. 1000 TO 18+25 T-4 LINE	82.5 FT.
1	RT. 25+25 TO 27+75 T-4	250 FT.
2	LT. 10+11 TO 13+58 T-4	350 FT.
2	RT. 104+20 TO 104+78 T-1	50 FT.
2	LT. 10+00 TO 13+50 T-1	350 FT.
2	RT. 12+10 TO 14+50 T-1	250 FT.
2	LT. 28+00 TO 30+00 T-1	100 FT.
2	RT. 30+00 TO 30+50 T-1	50 FT.
2	LT. 11+00 TO 23+30 T-6	1325 FT.
2	RT. 22+50 T-6 TO 31+0	325 FT.
2	RT. 17+75 TO 19+75 T-7	200 FT.
2	LT. 18+50 TO 22+37.6 T-7	387.5 FT.
2	RT. 188+10 TO 189+85 31st	175 FT.
2	LT. 112+32 TO 195+07 31st	275 FT.
2	RT. 196+35 TO 197+60 31st	125 FT.


Original Ground



Granular Backfill




TYPICAL SECTION
UNDERDRAIN SYSTEM



Note: For Storm Sewer Sta 964+00 to
Sta 1036+00 See Shts 12-14




REV. DATE 6/10/66

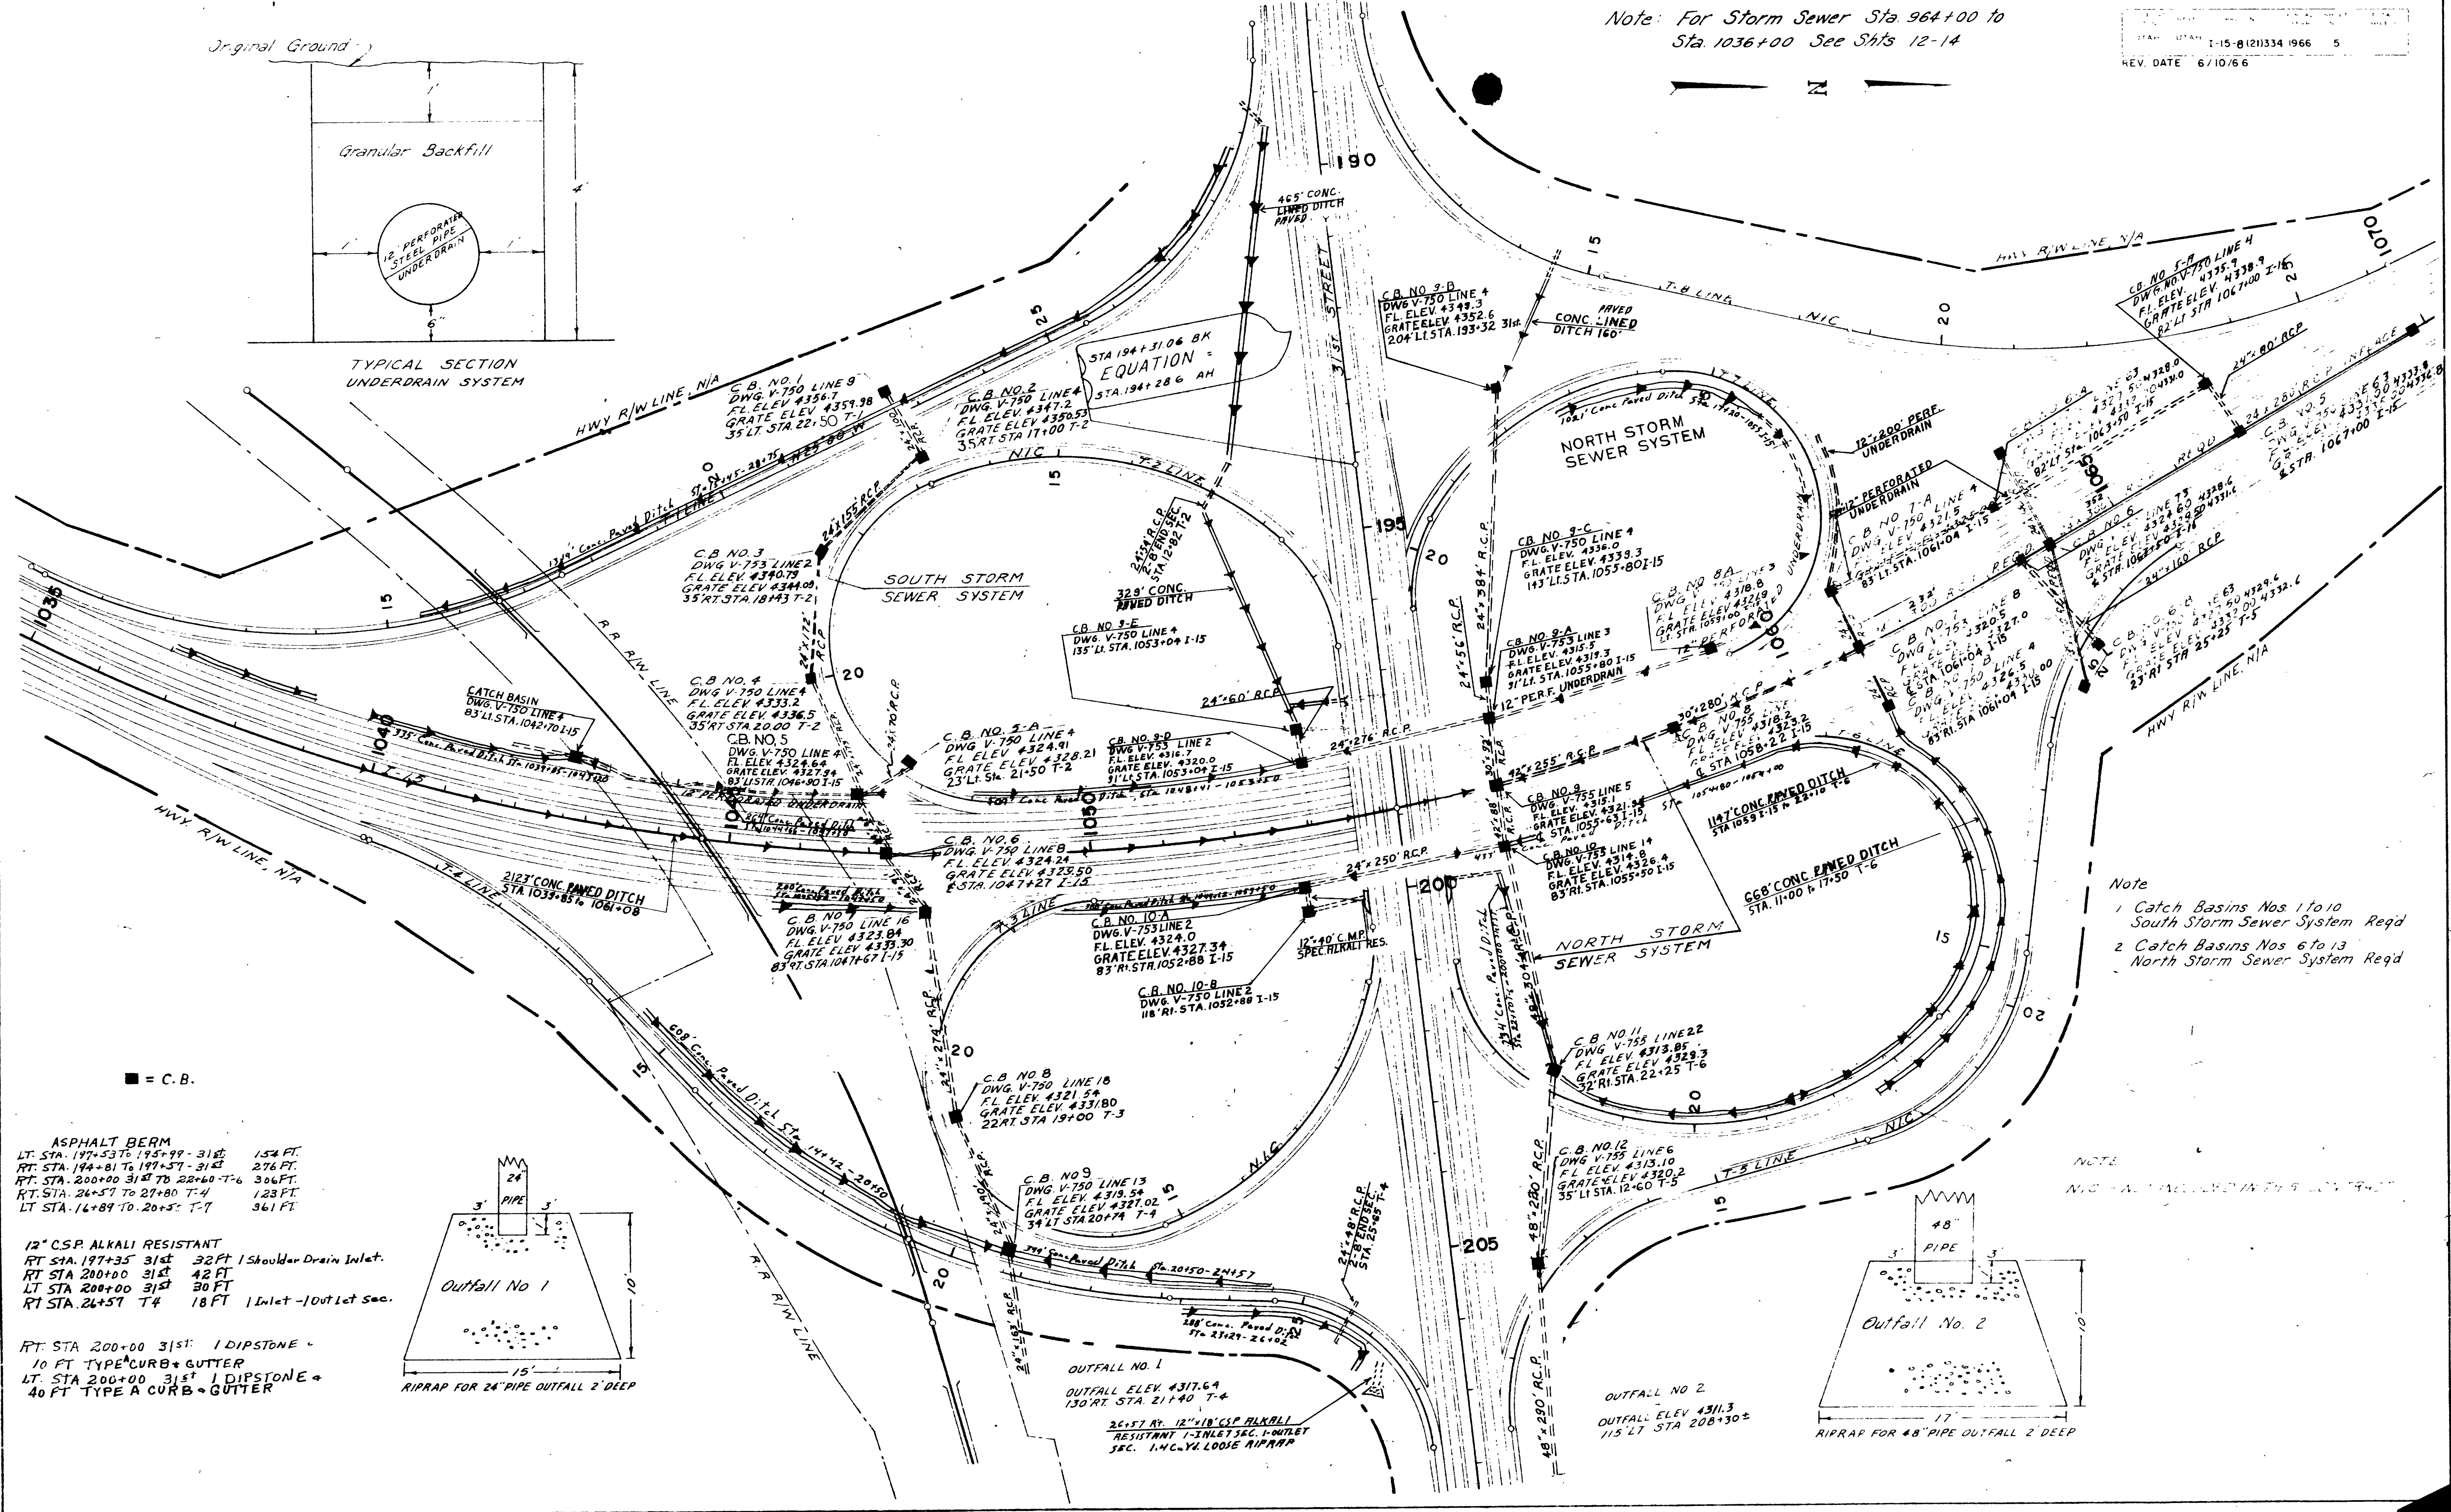

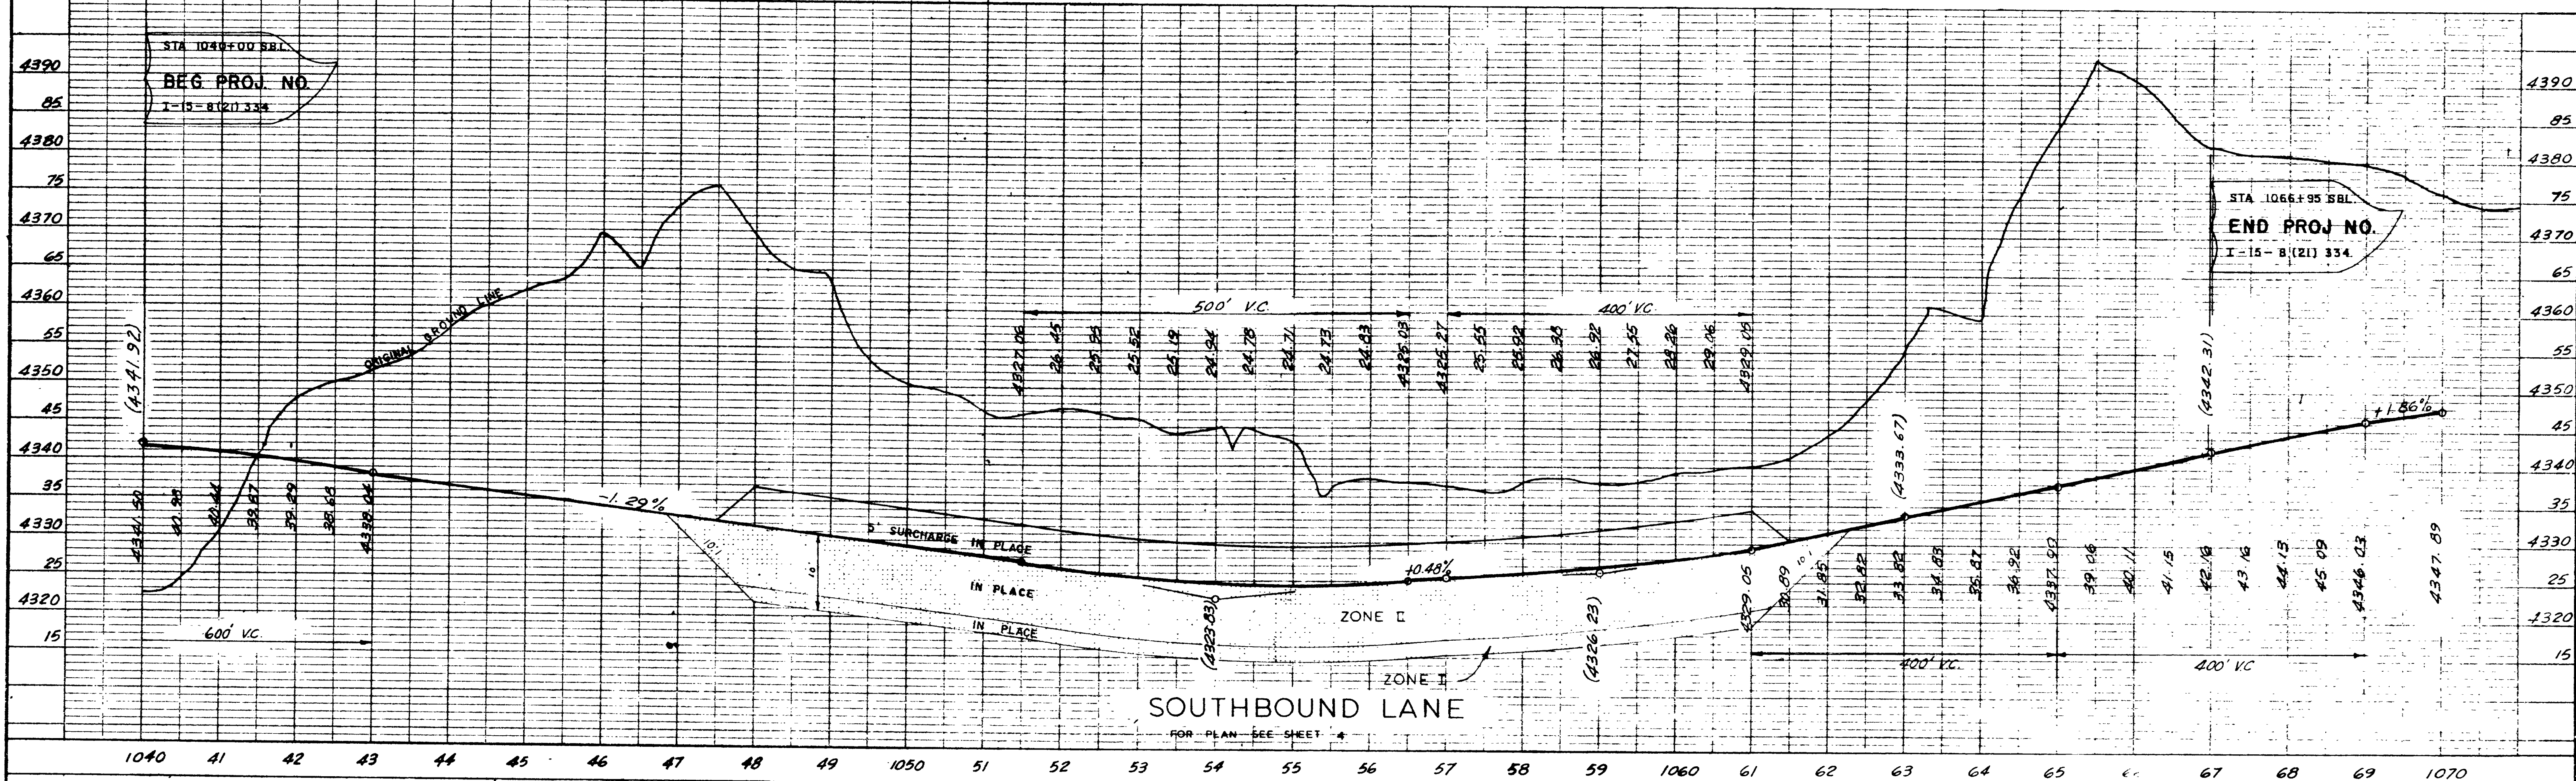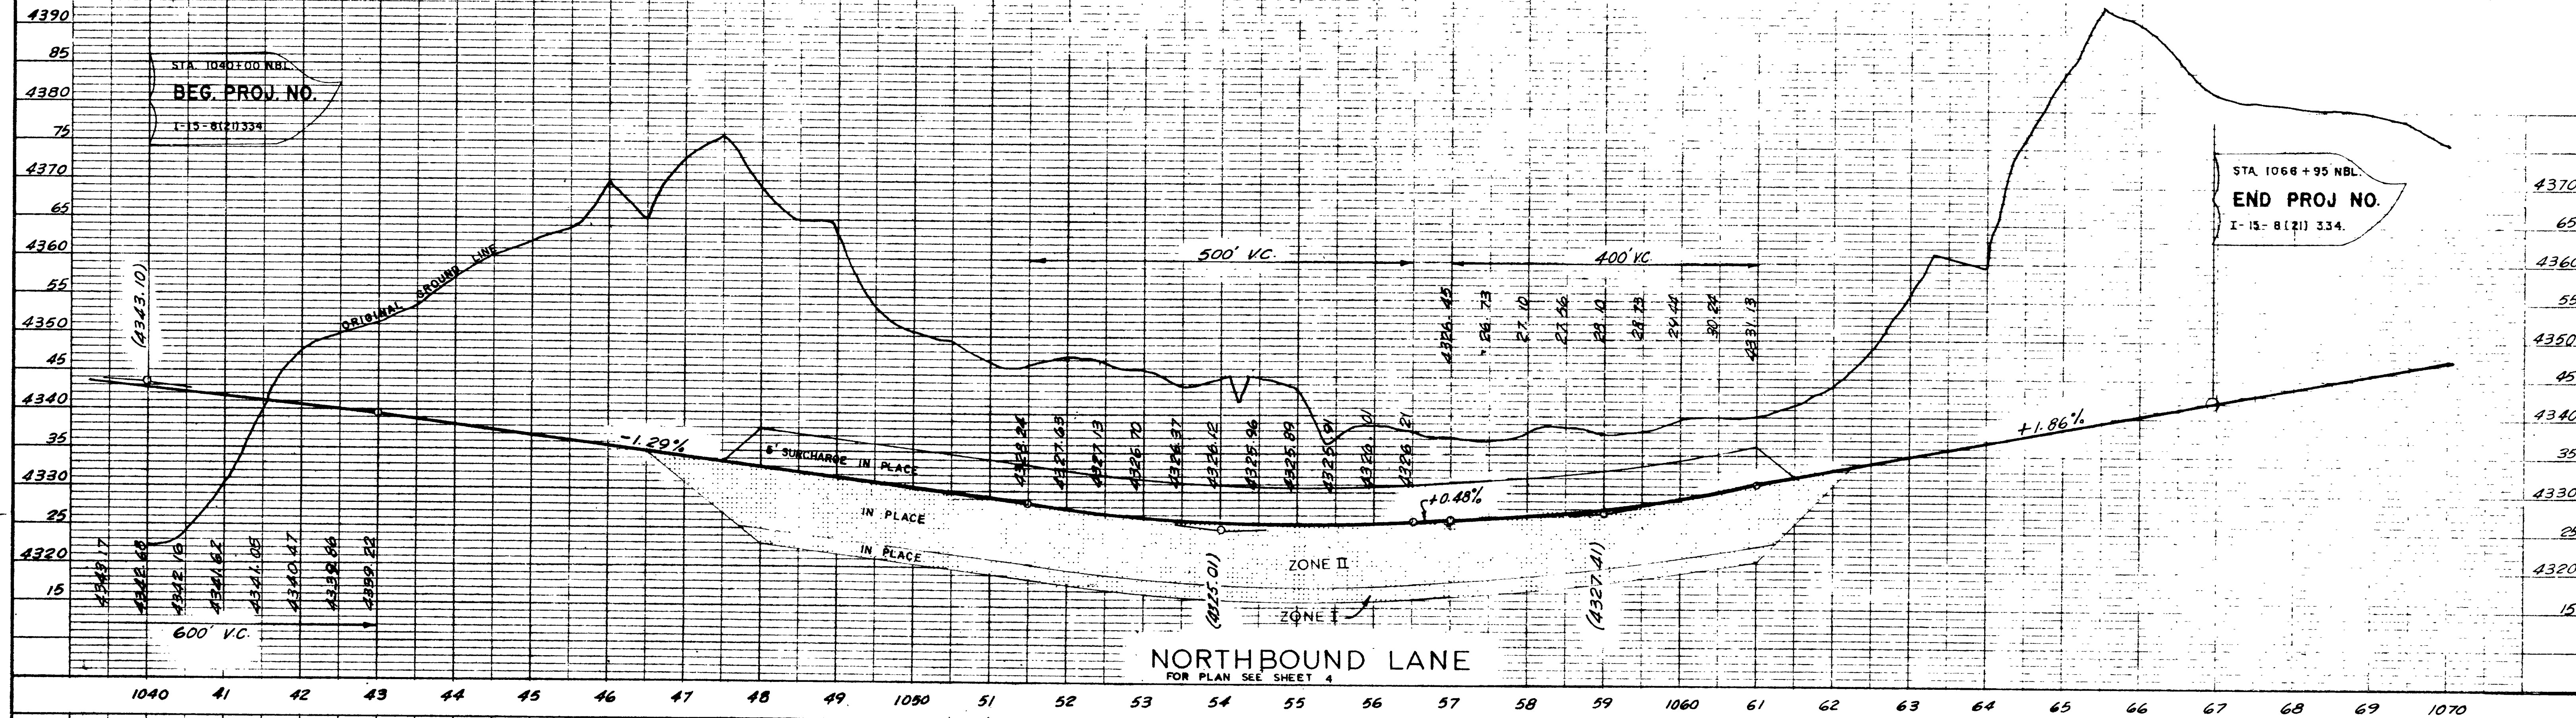

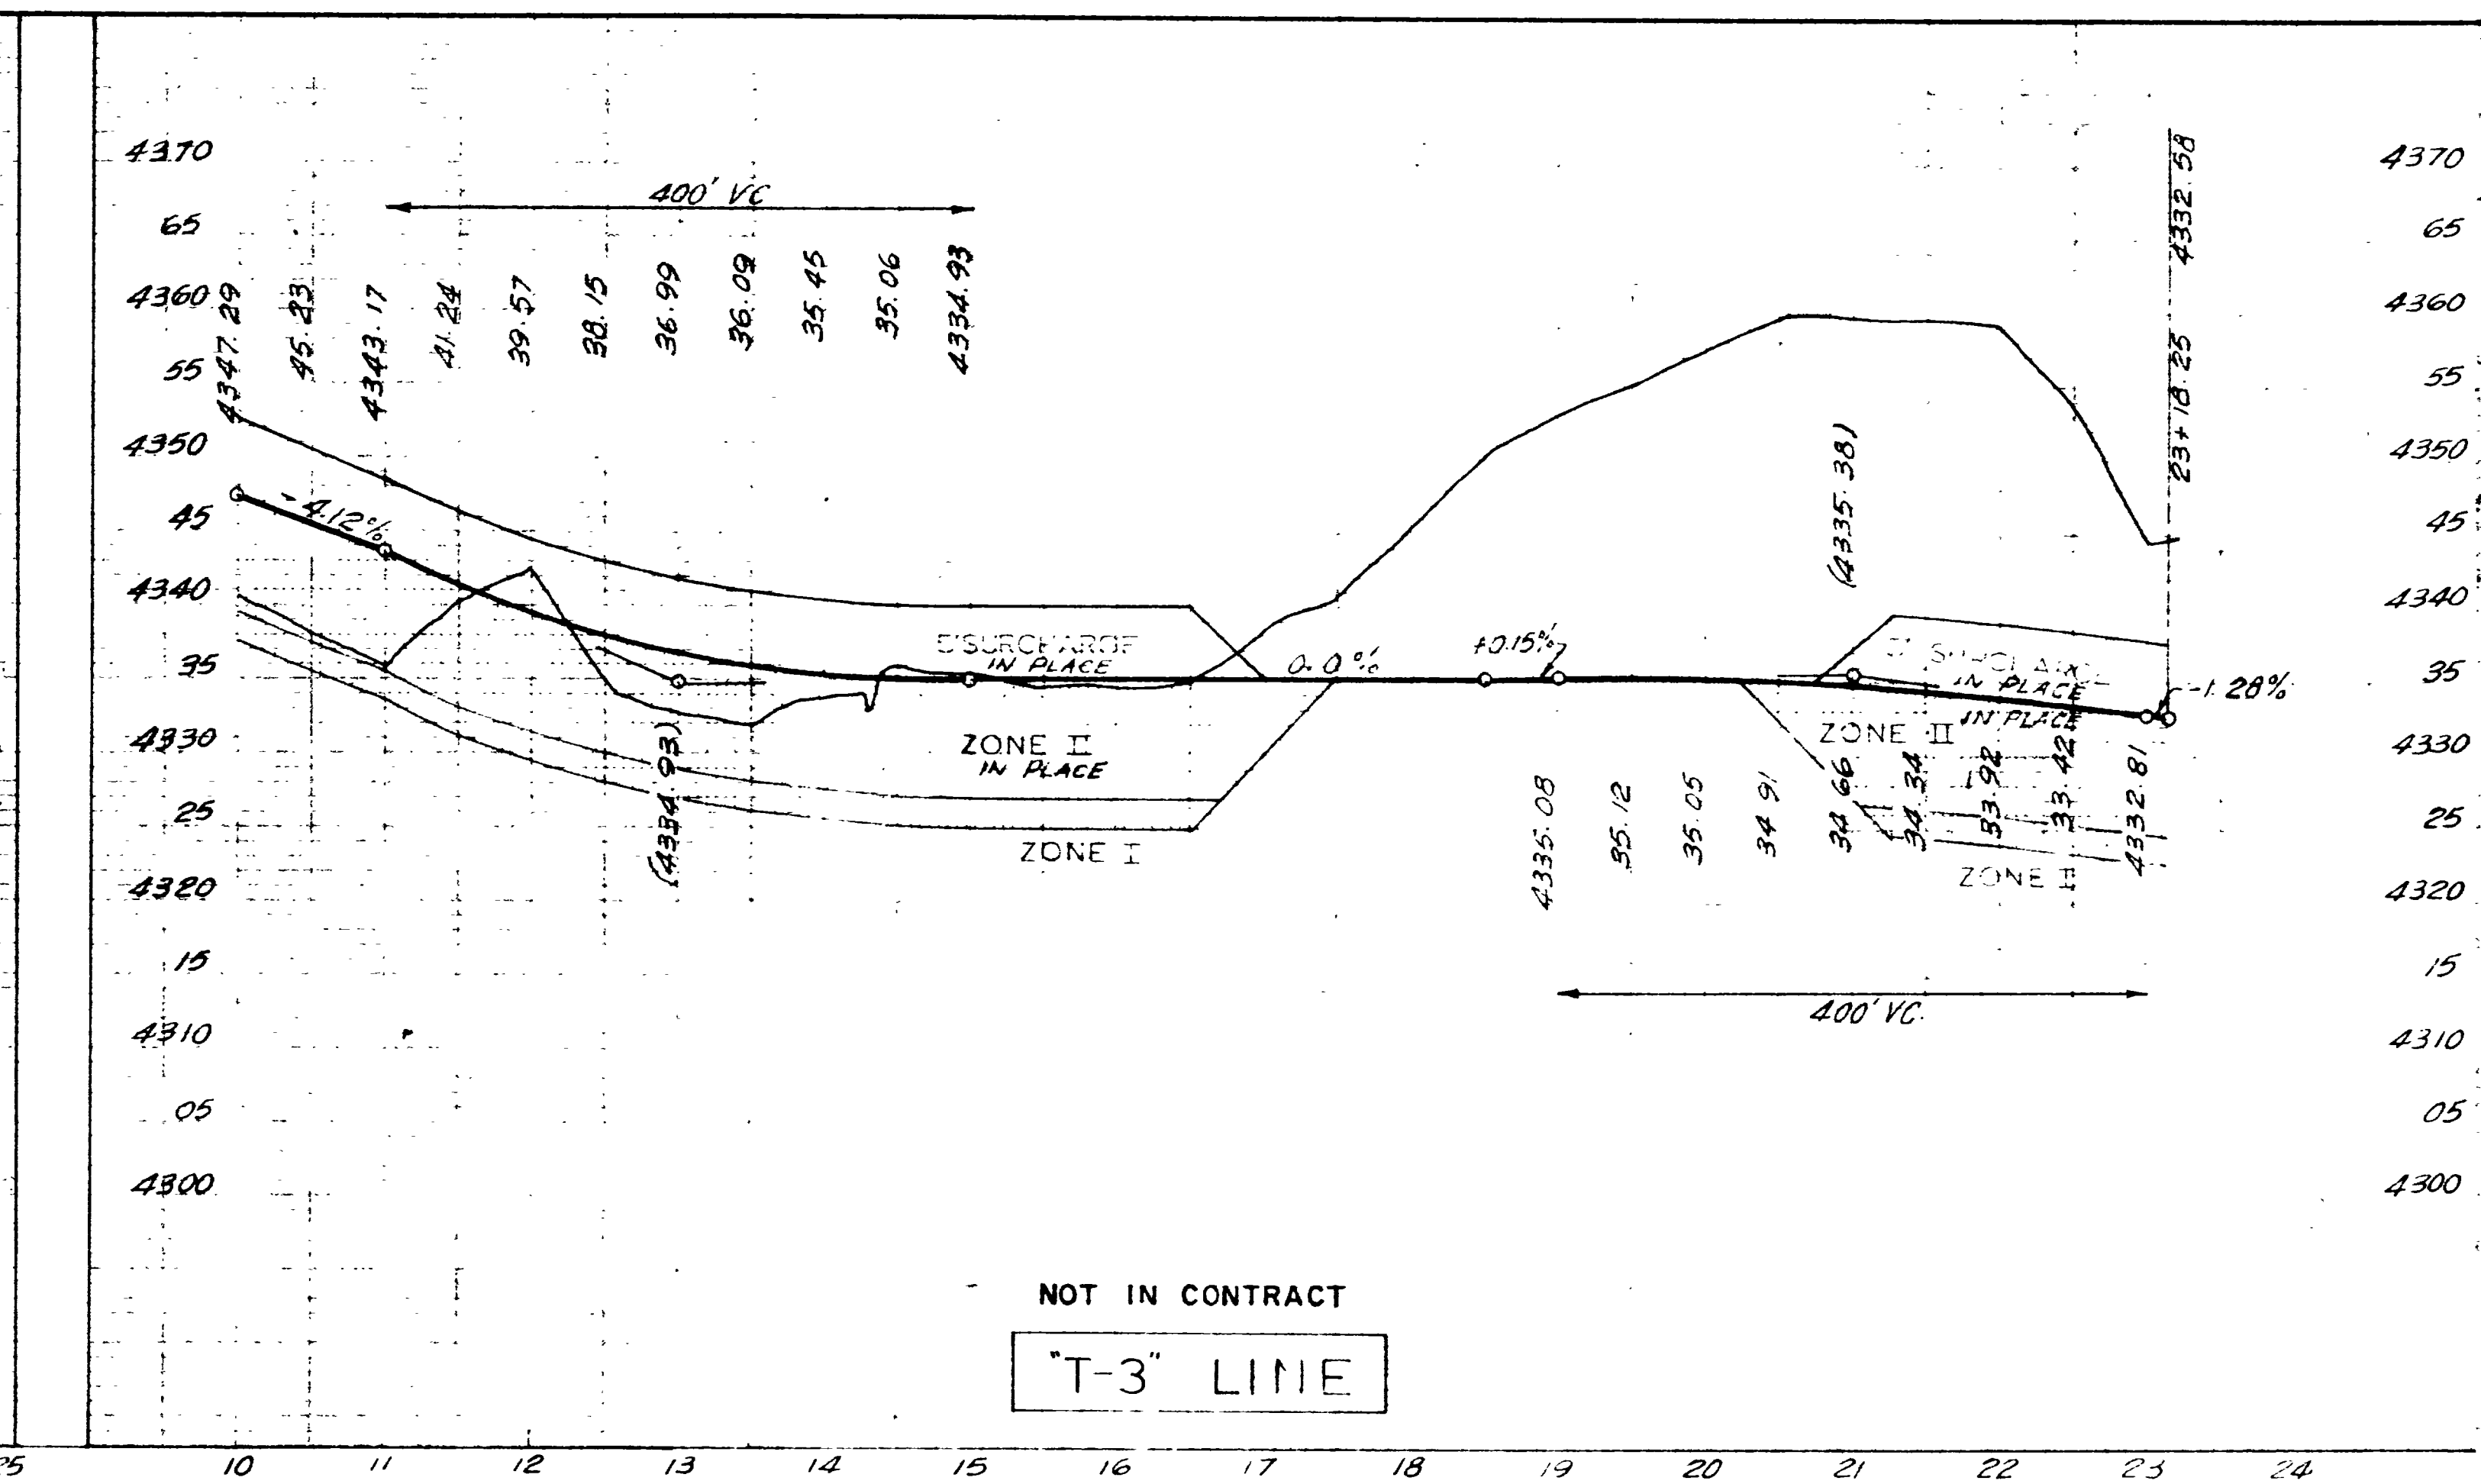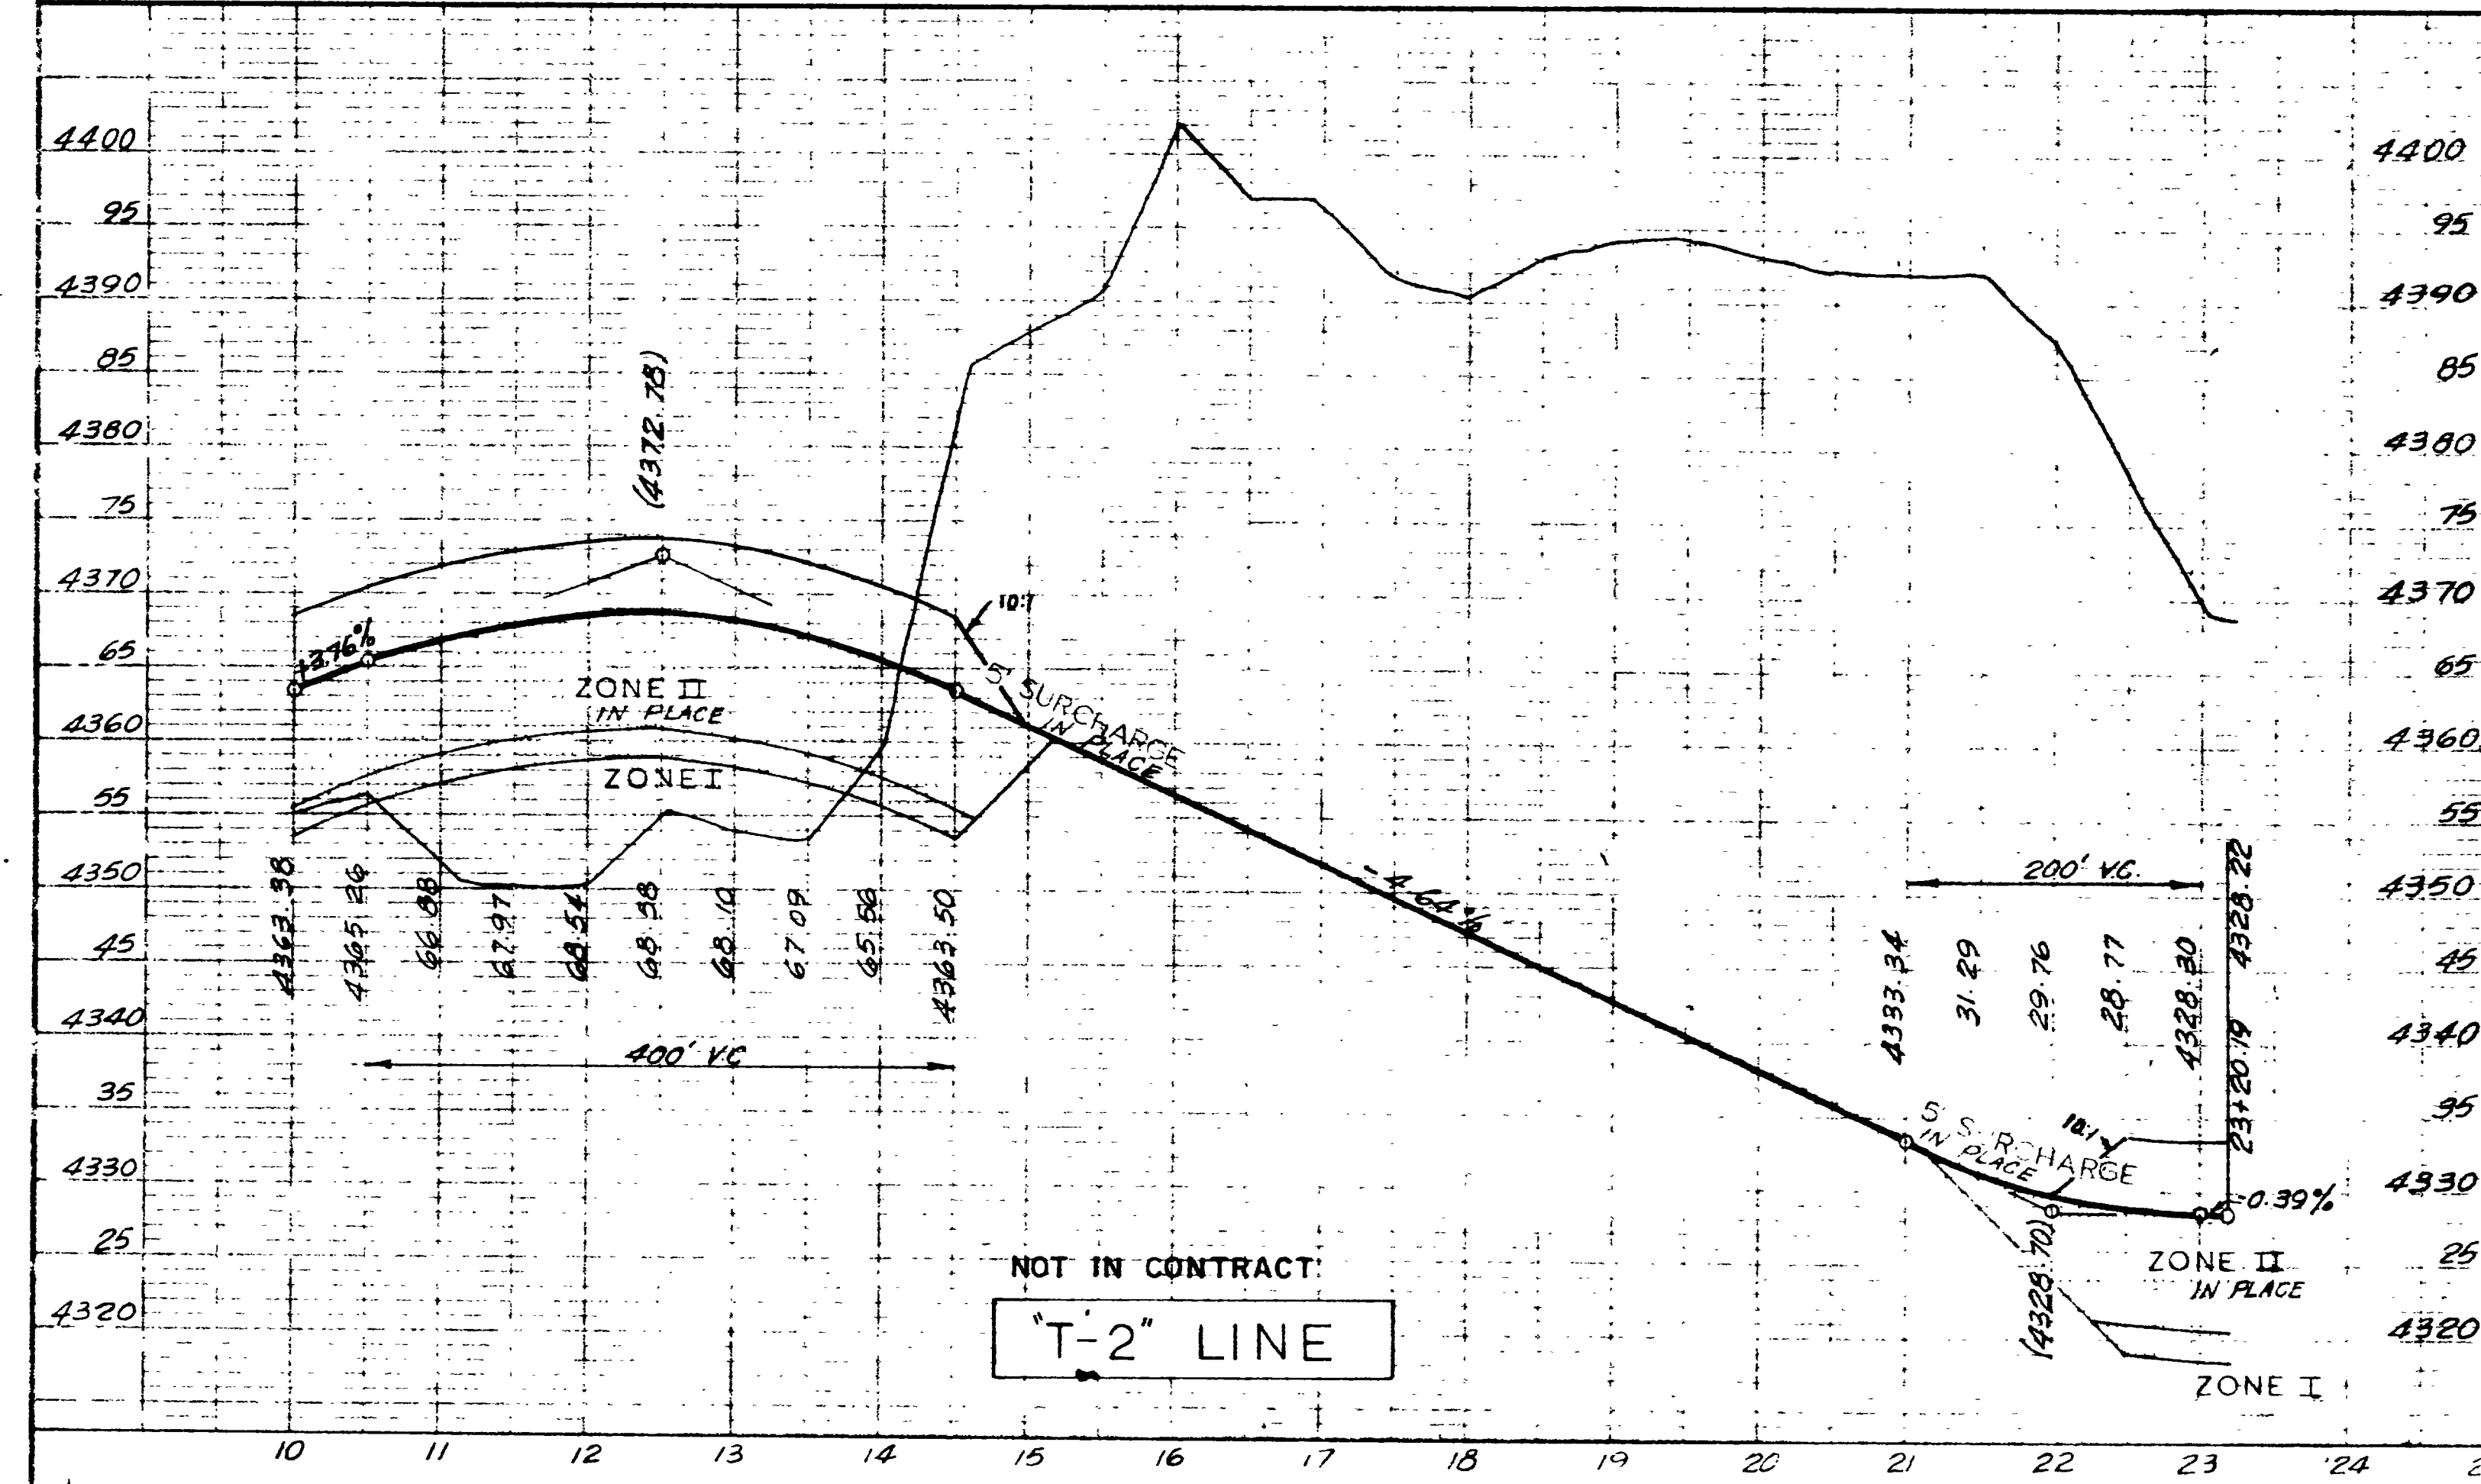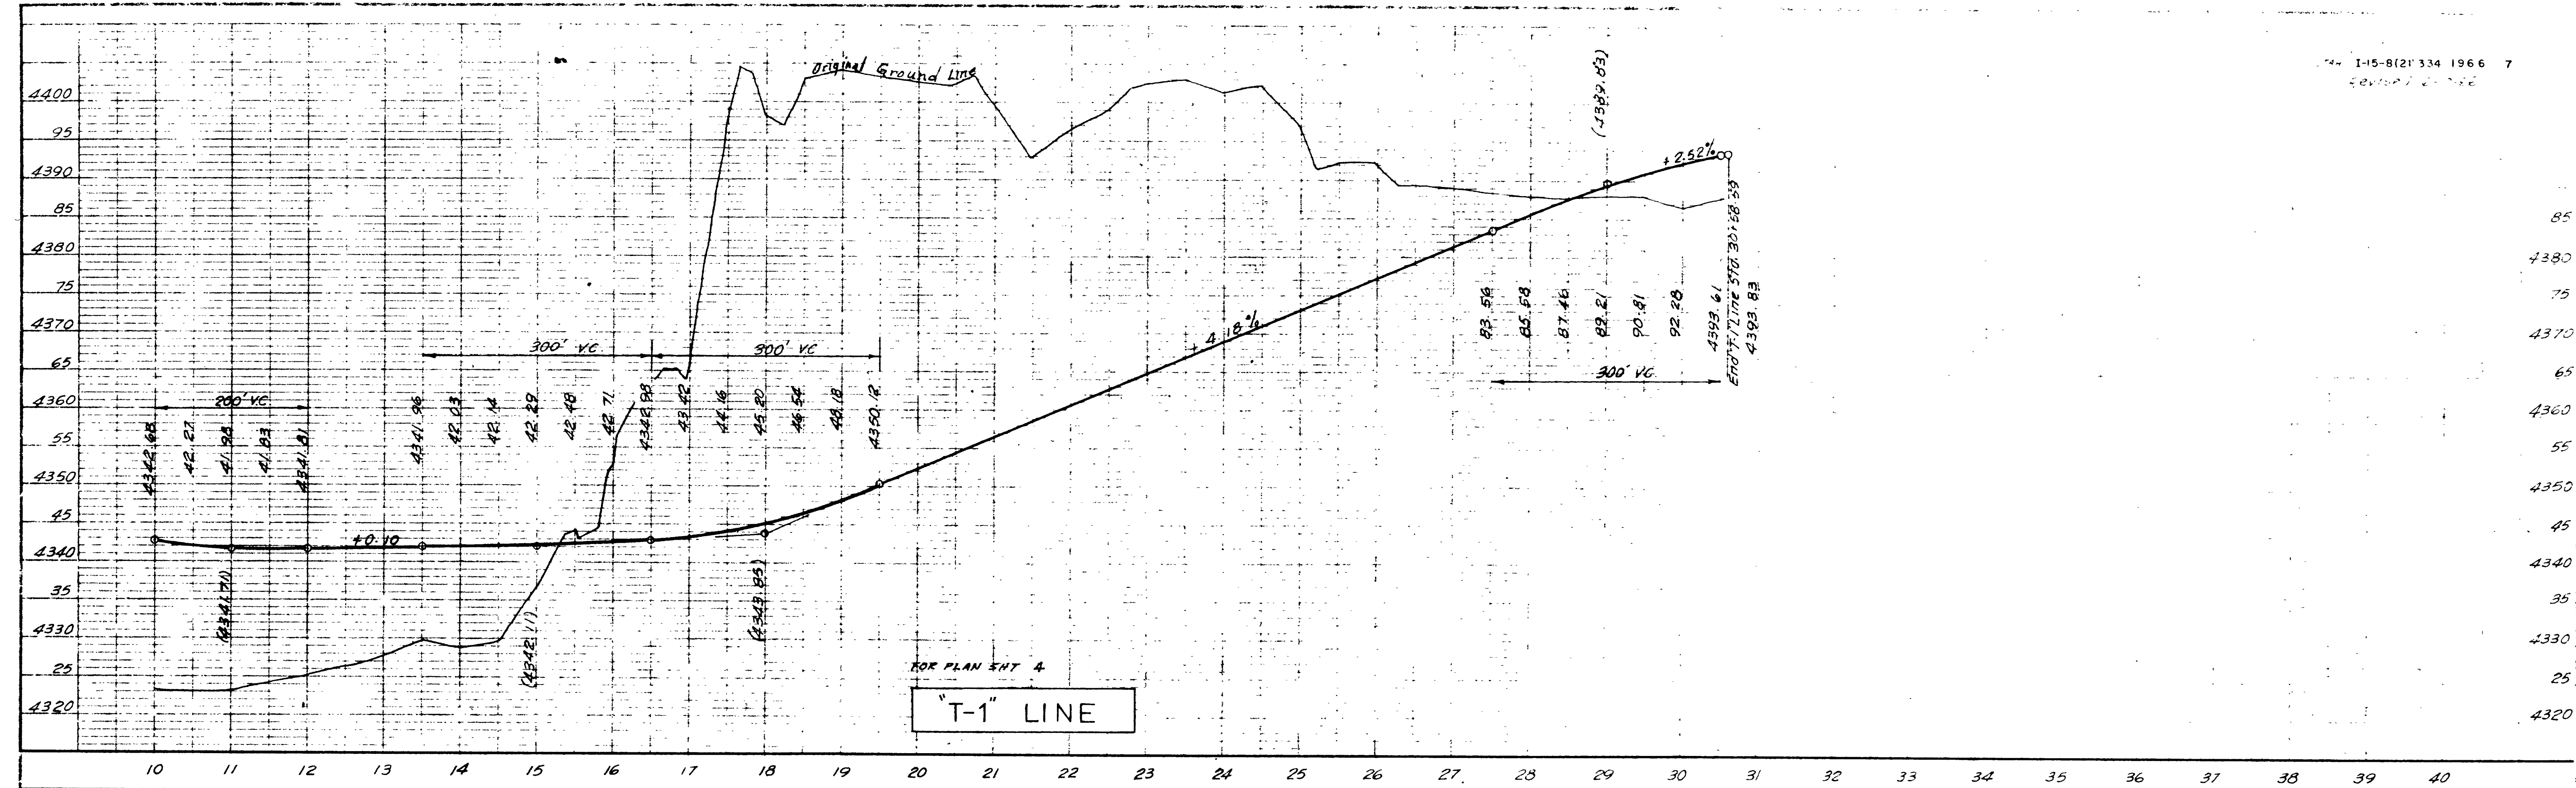


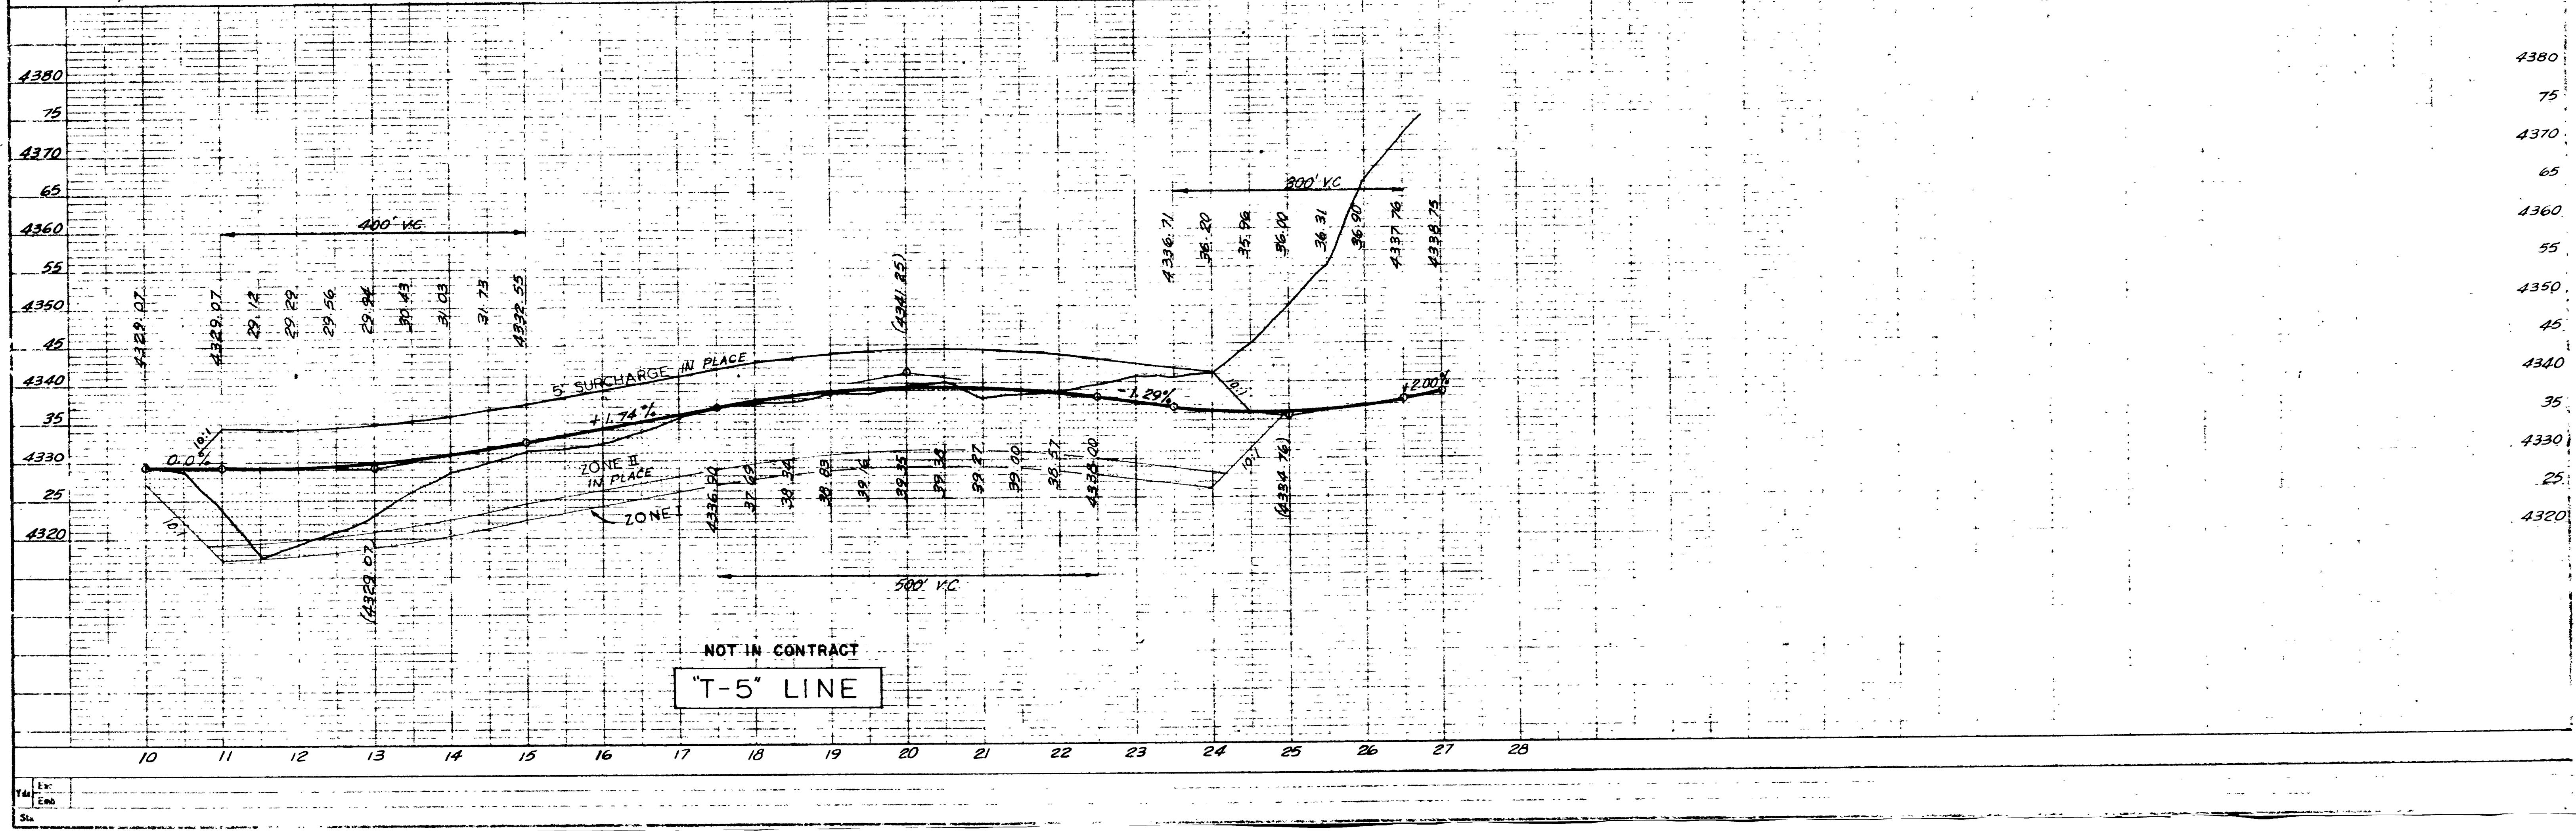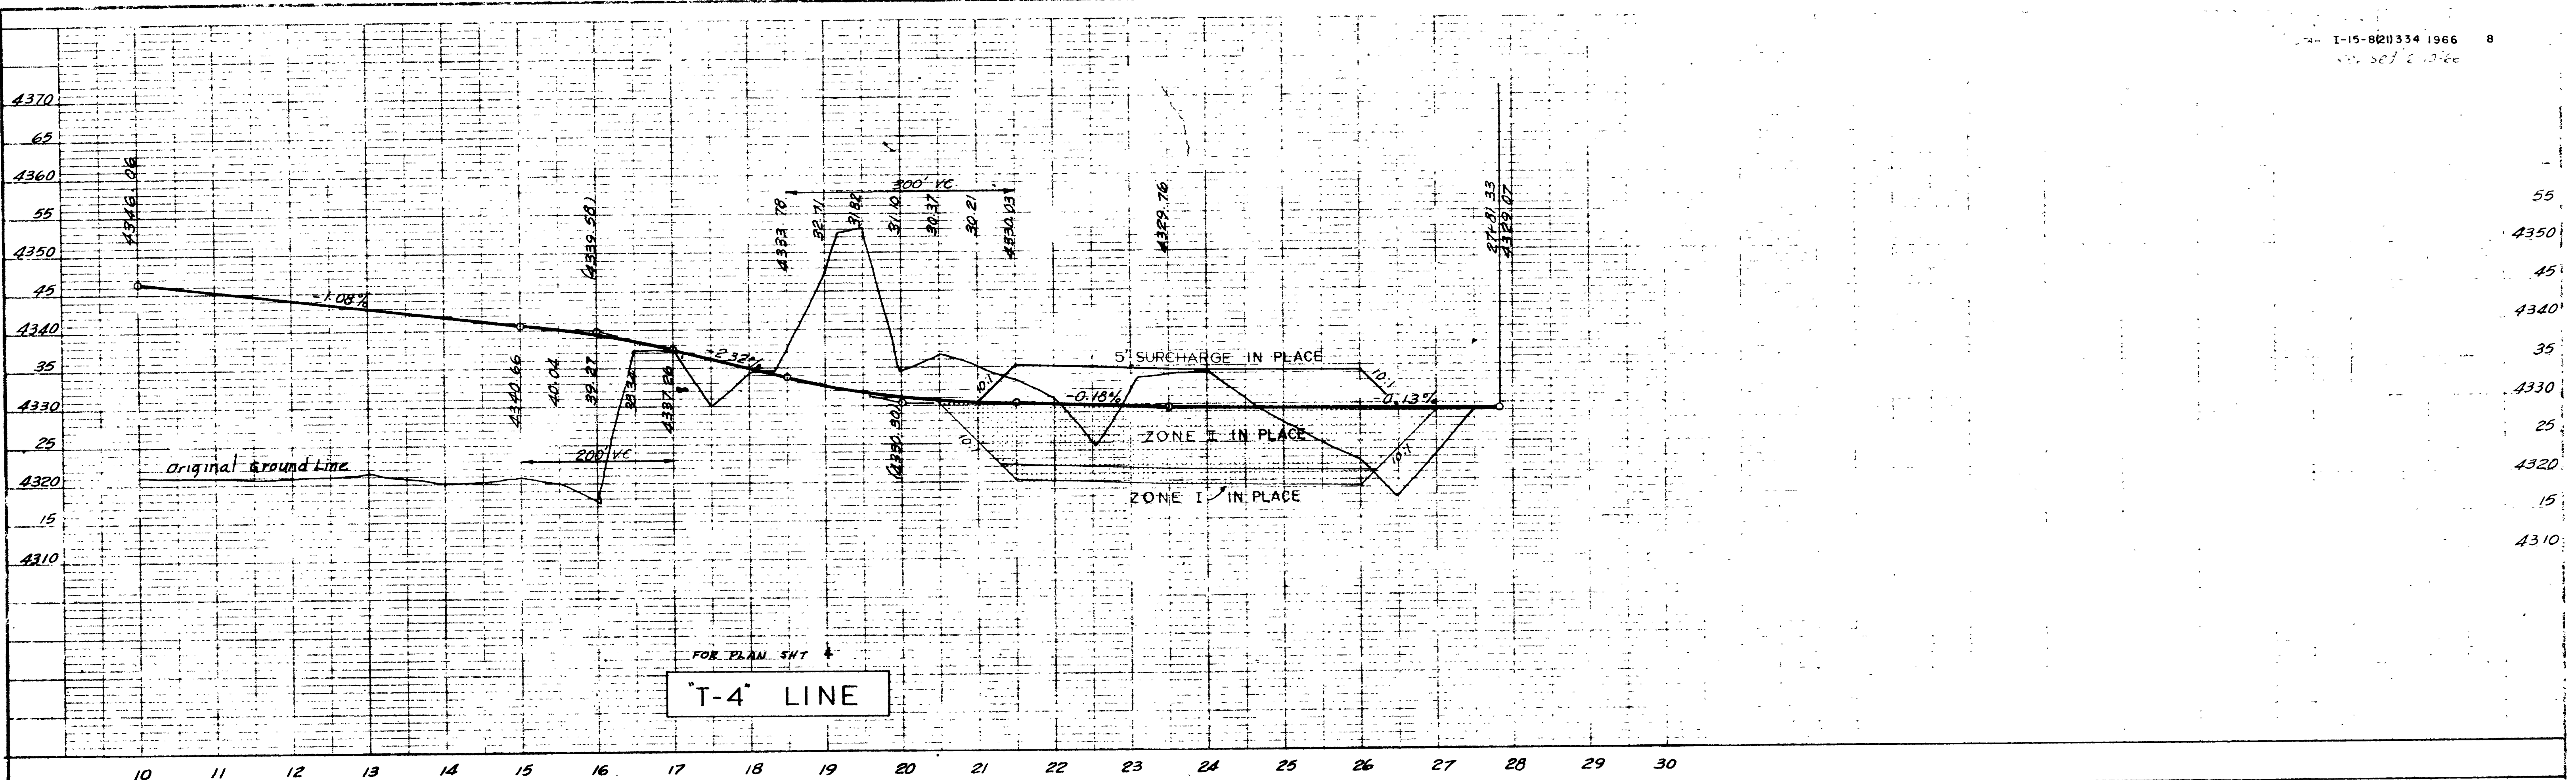

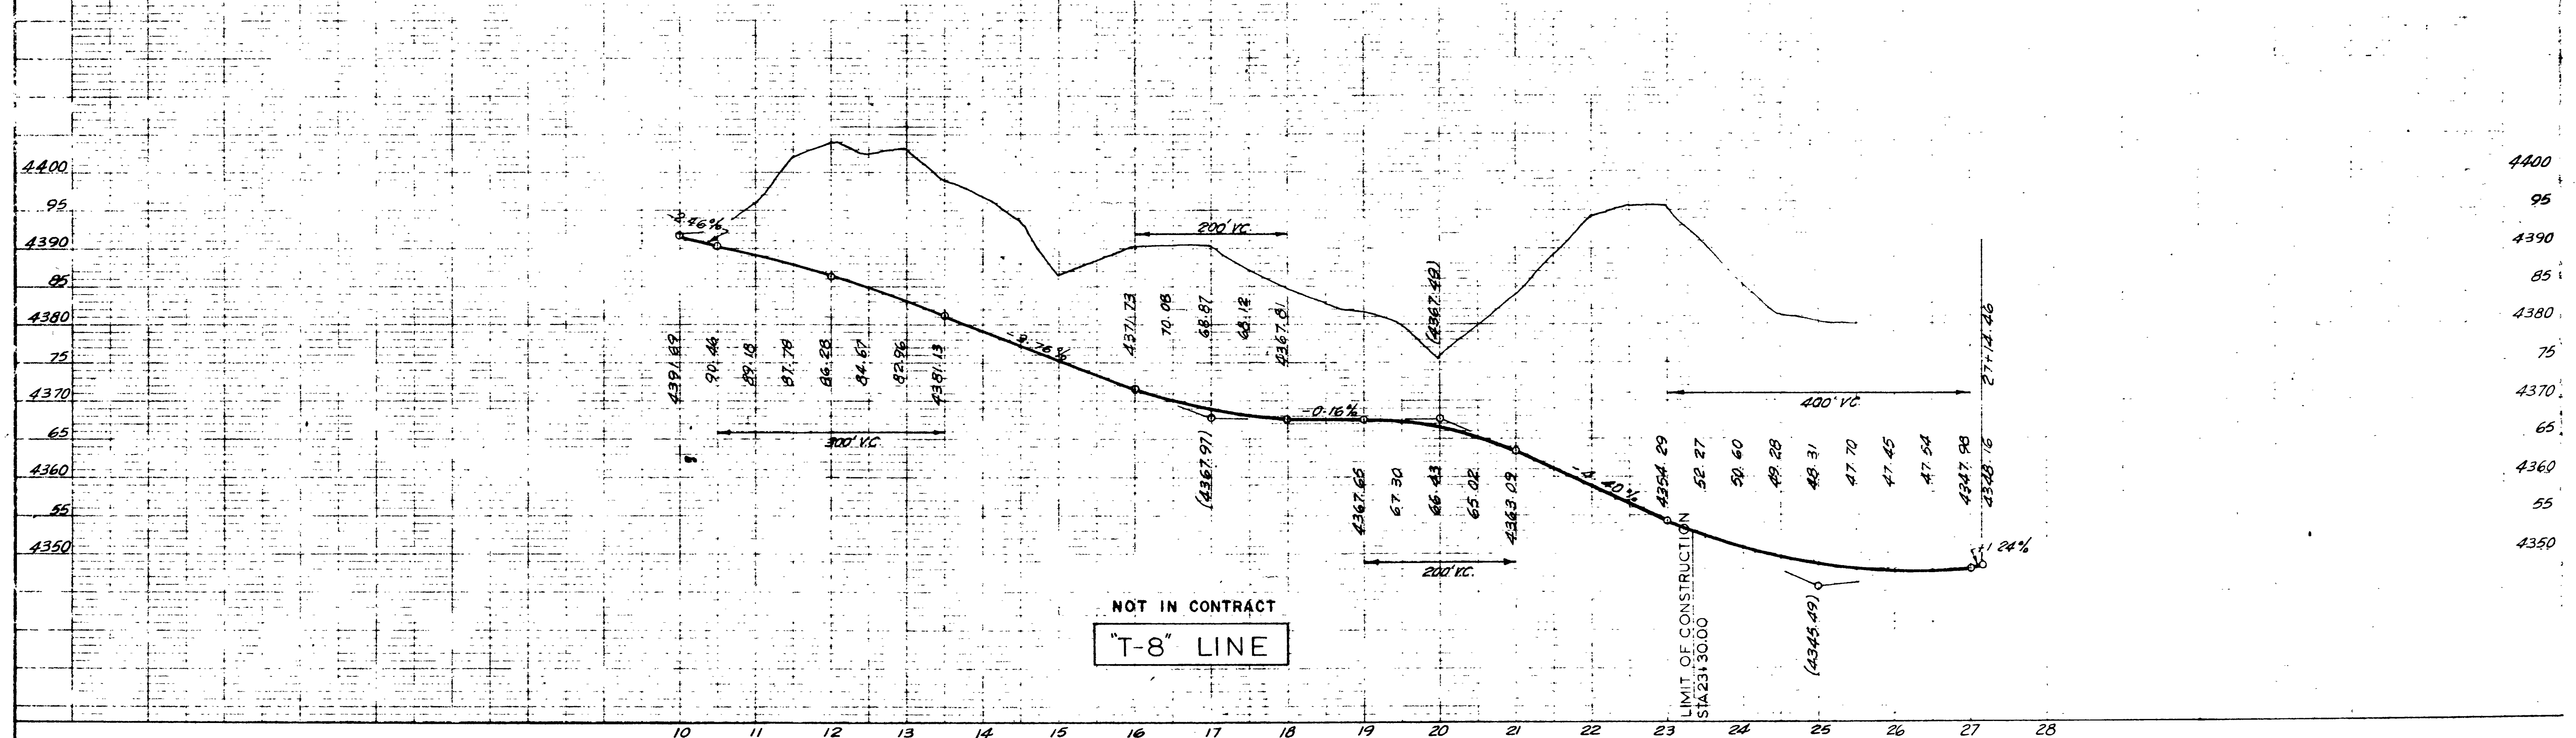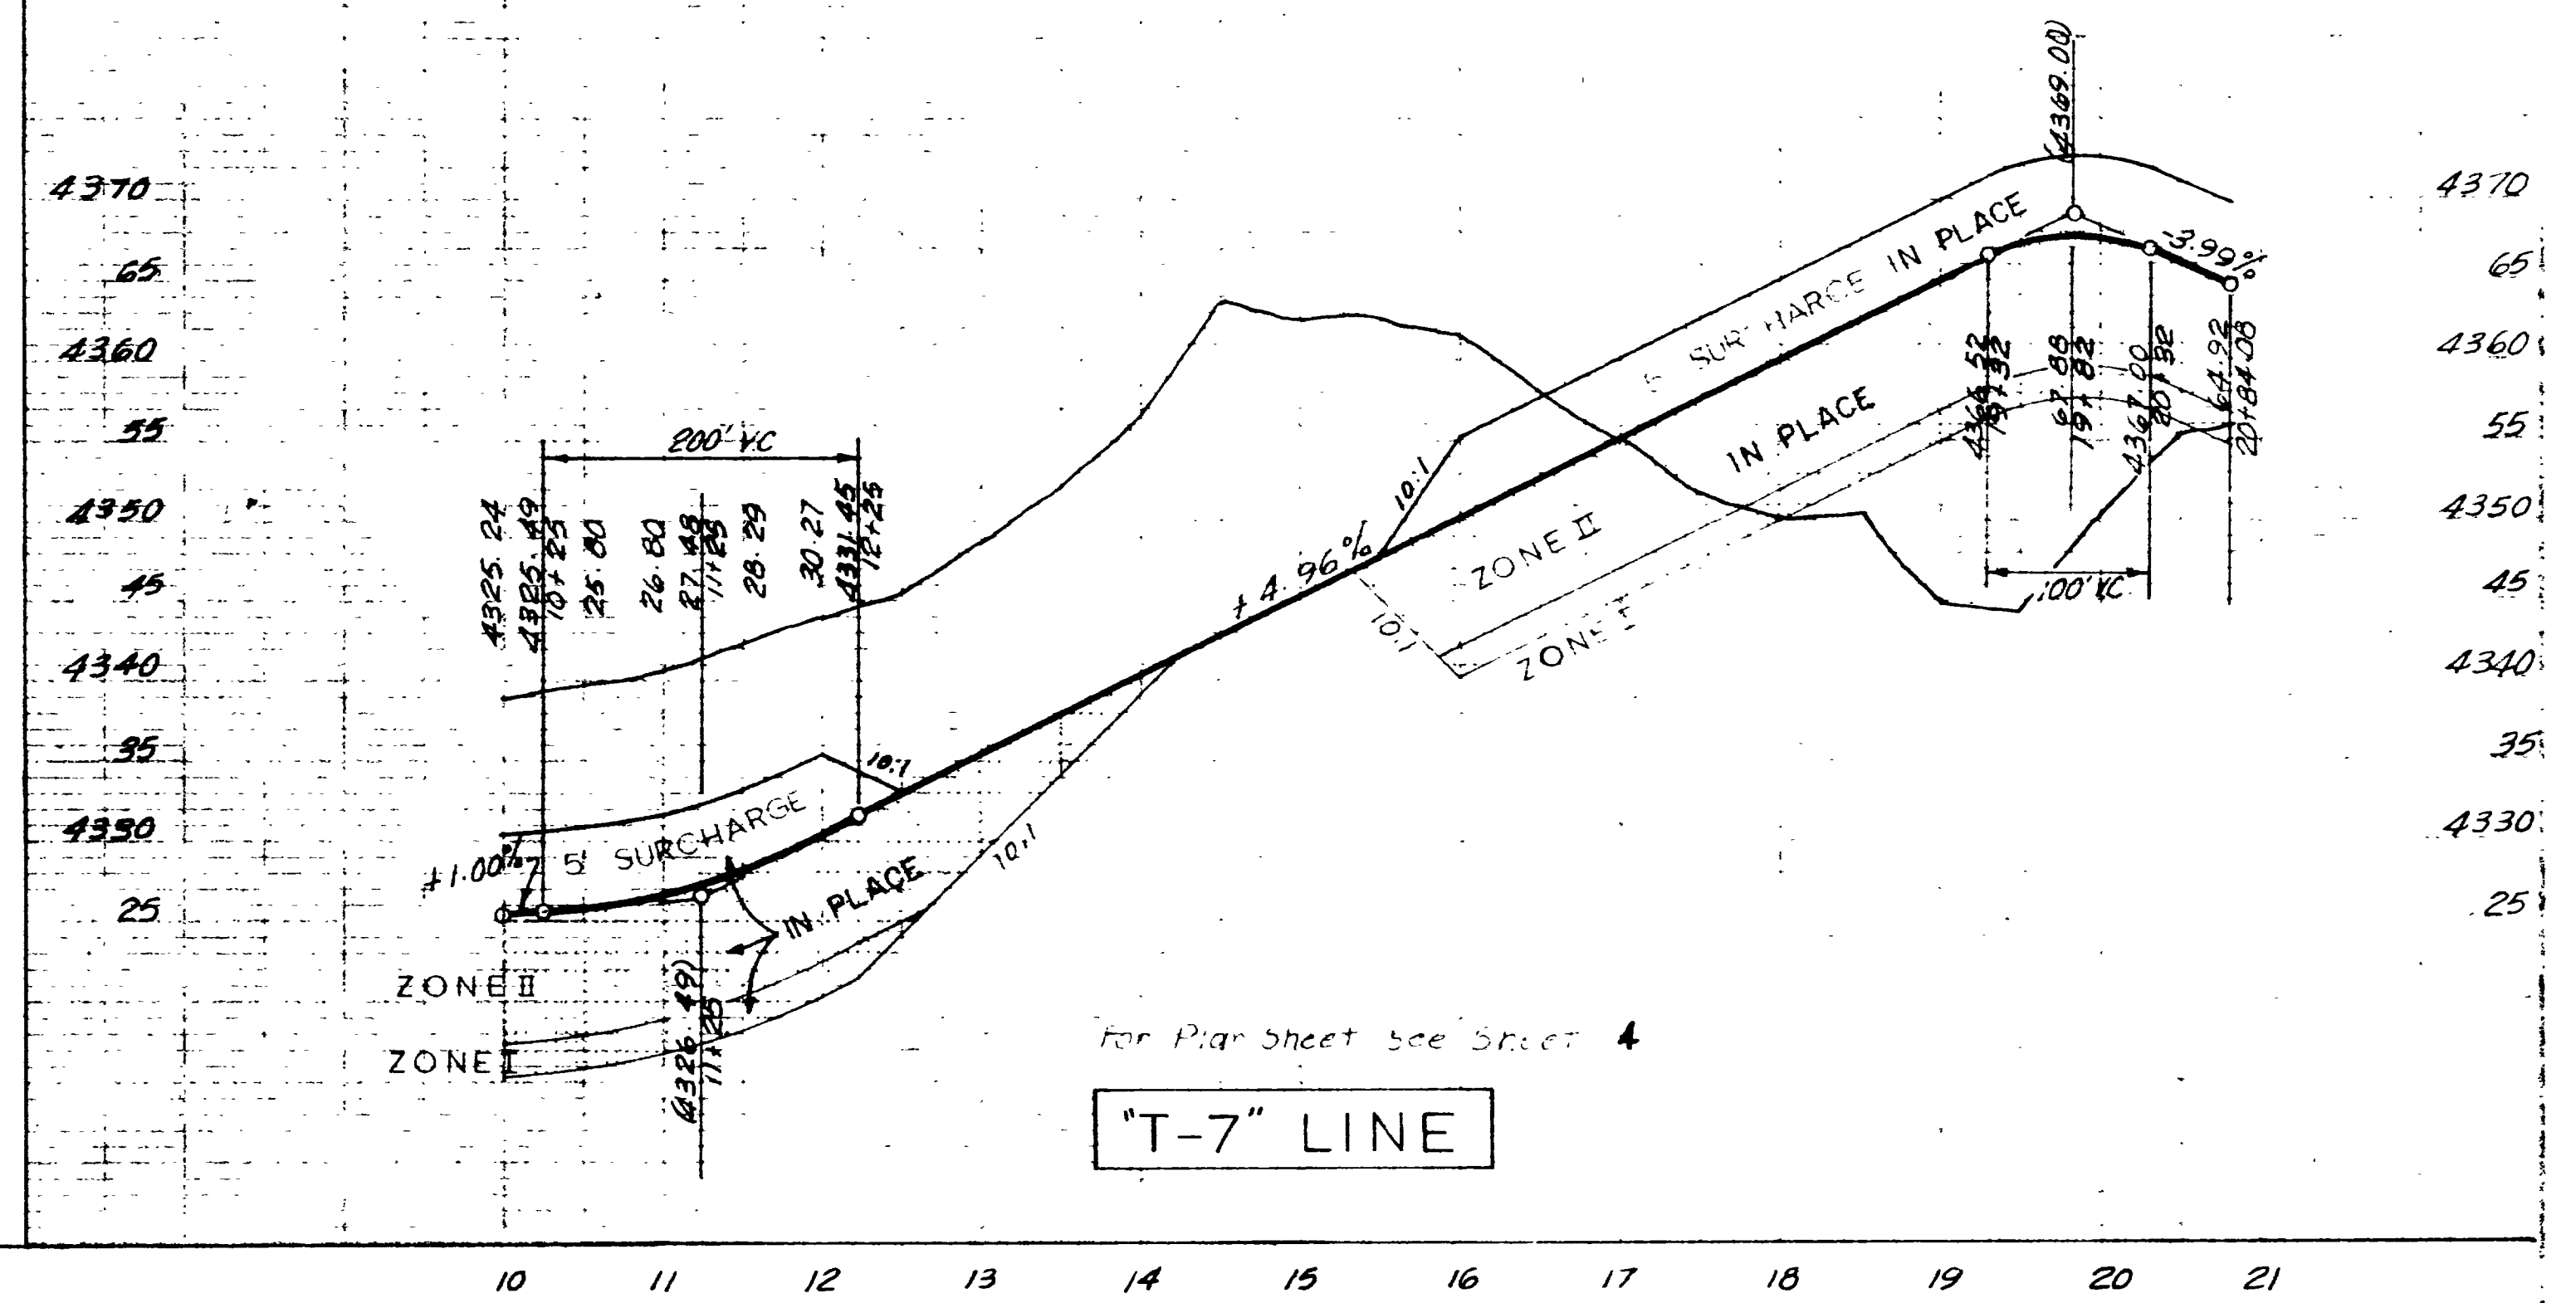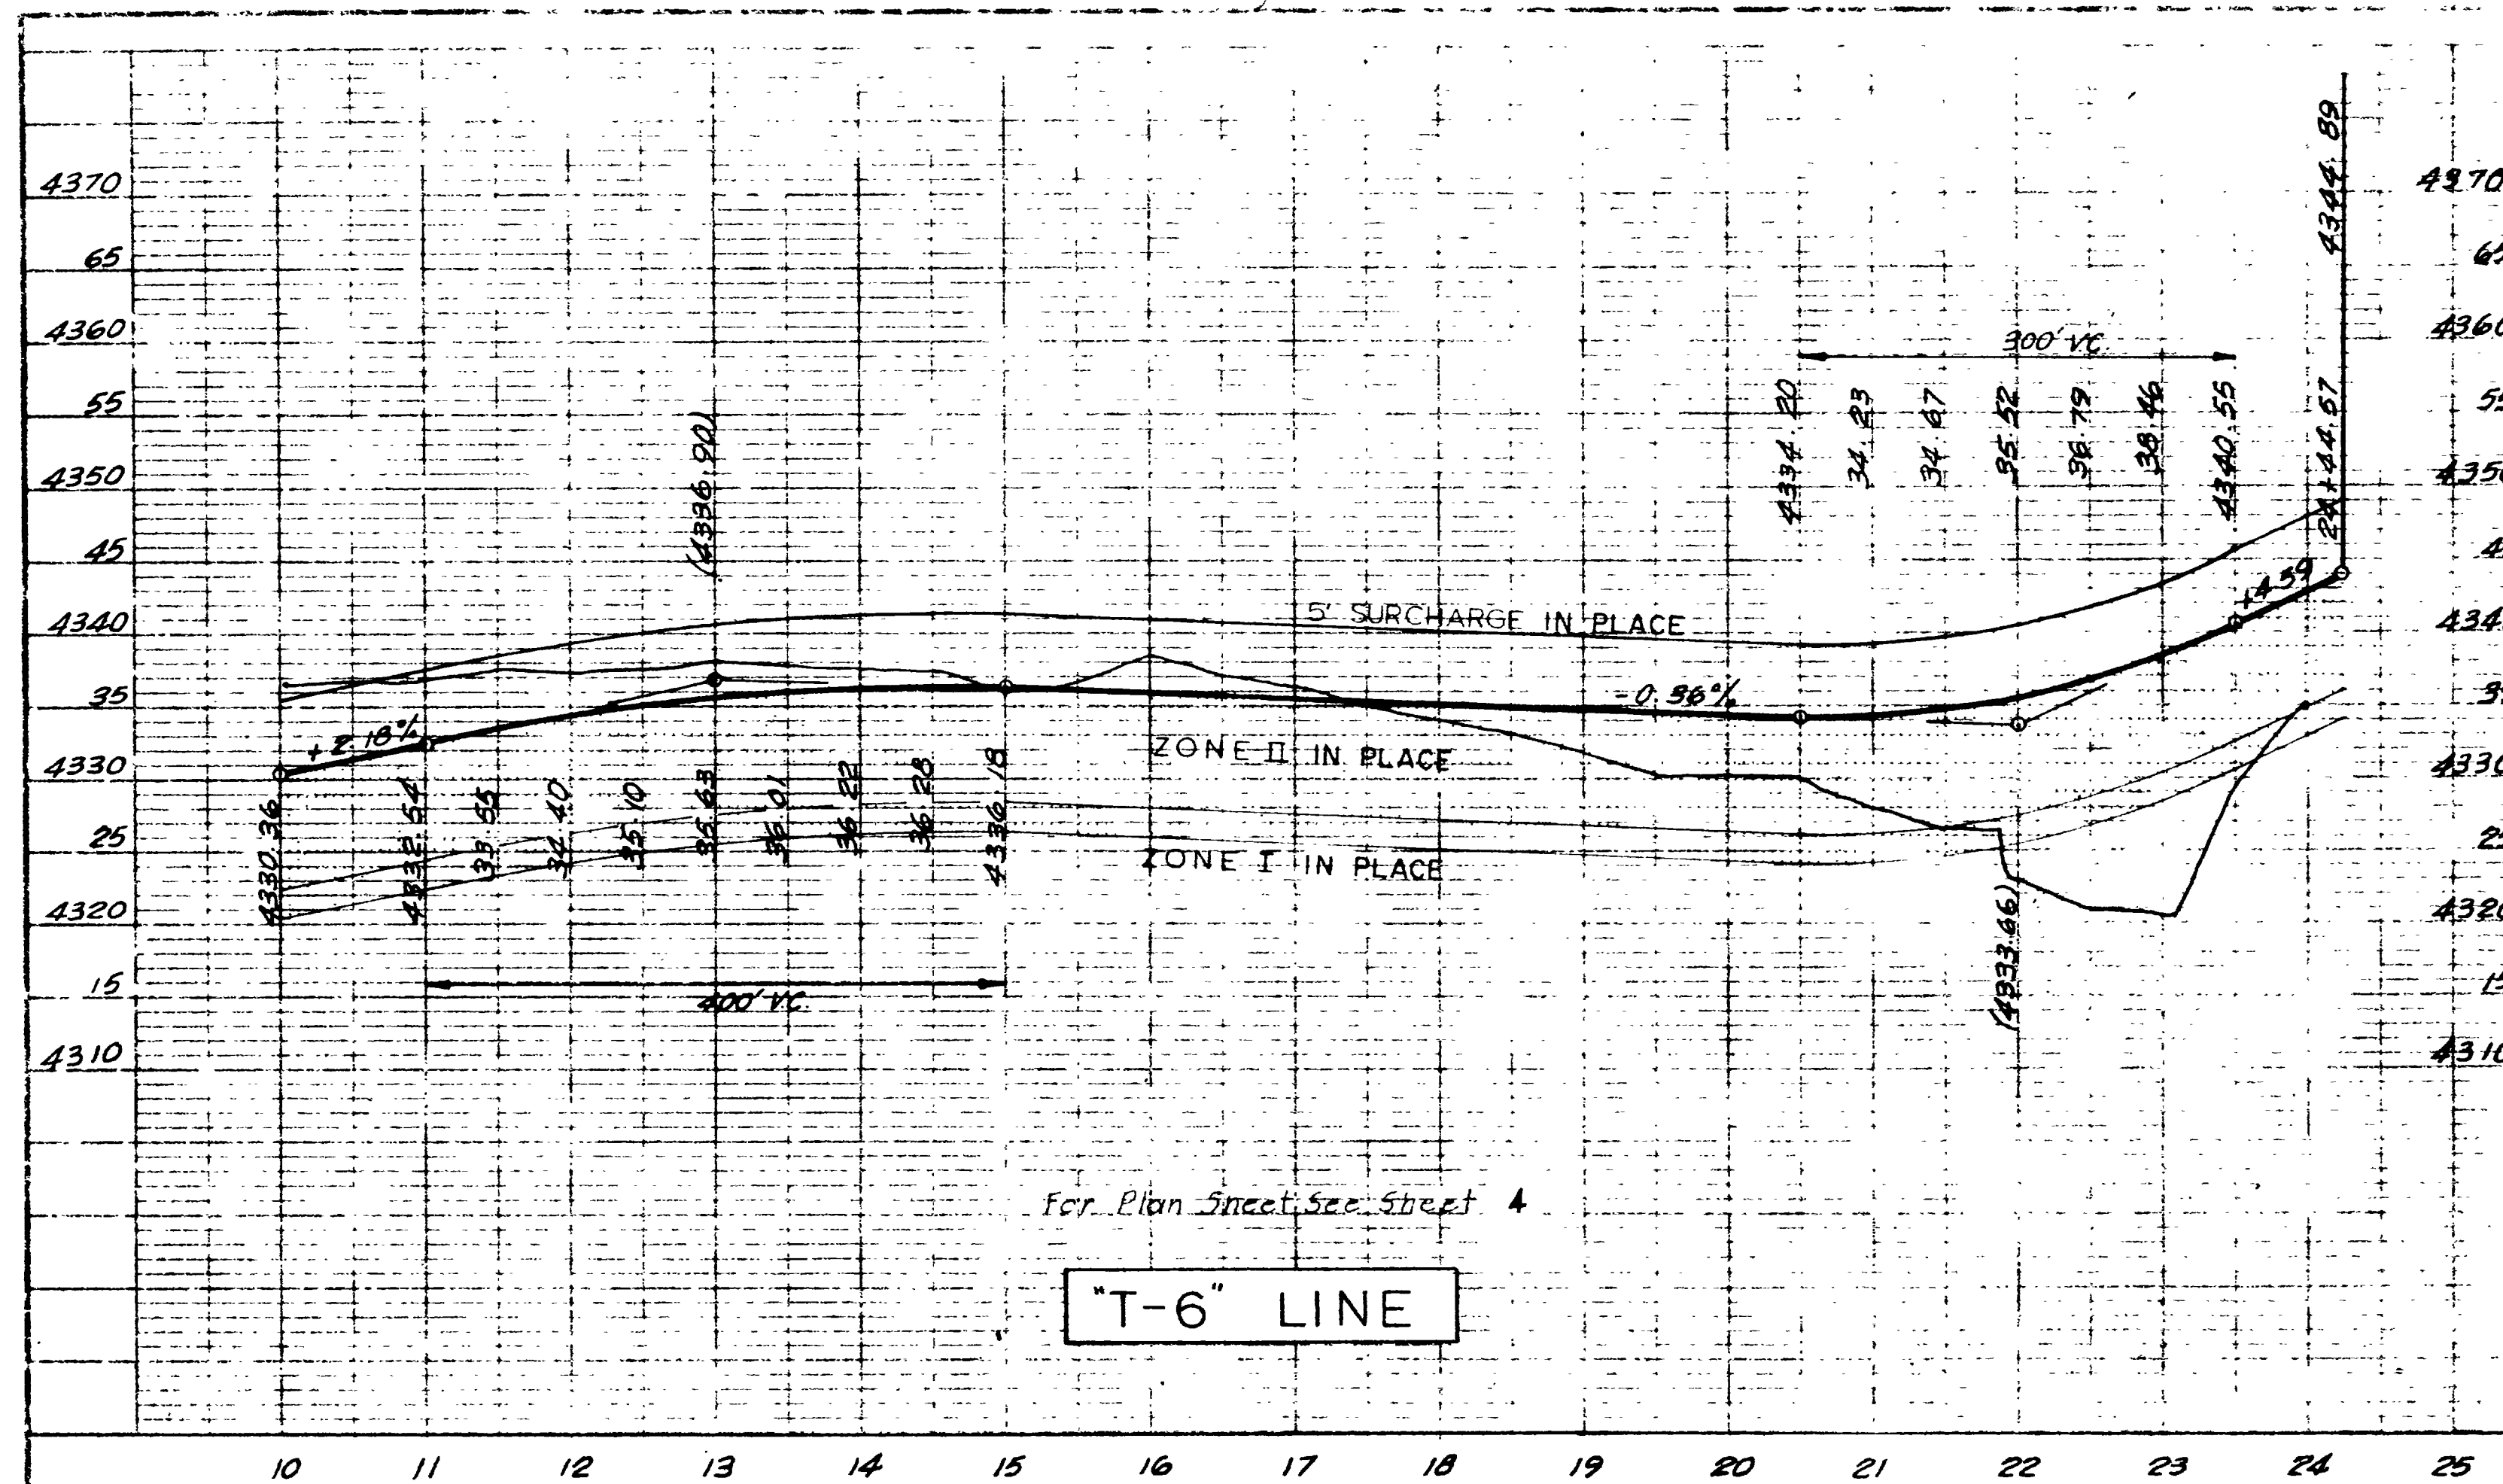


3rd STREET PROFILE

FOR PLAN SHEET NO. 4


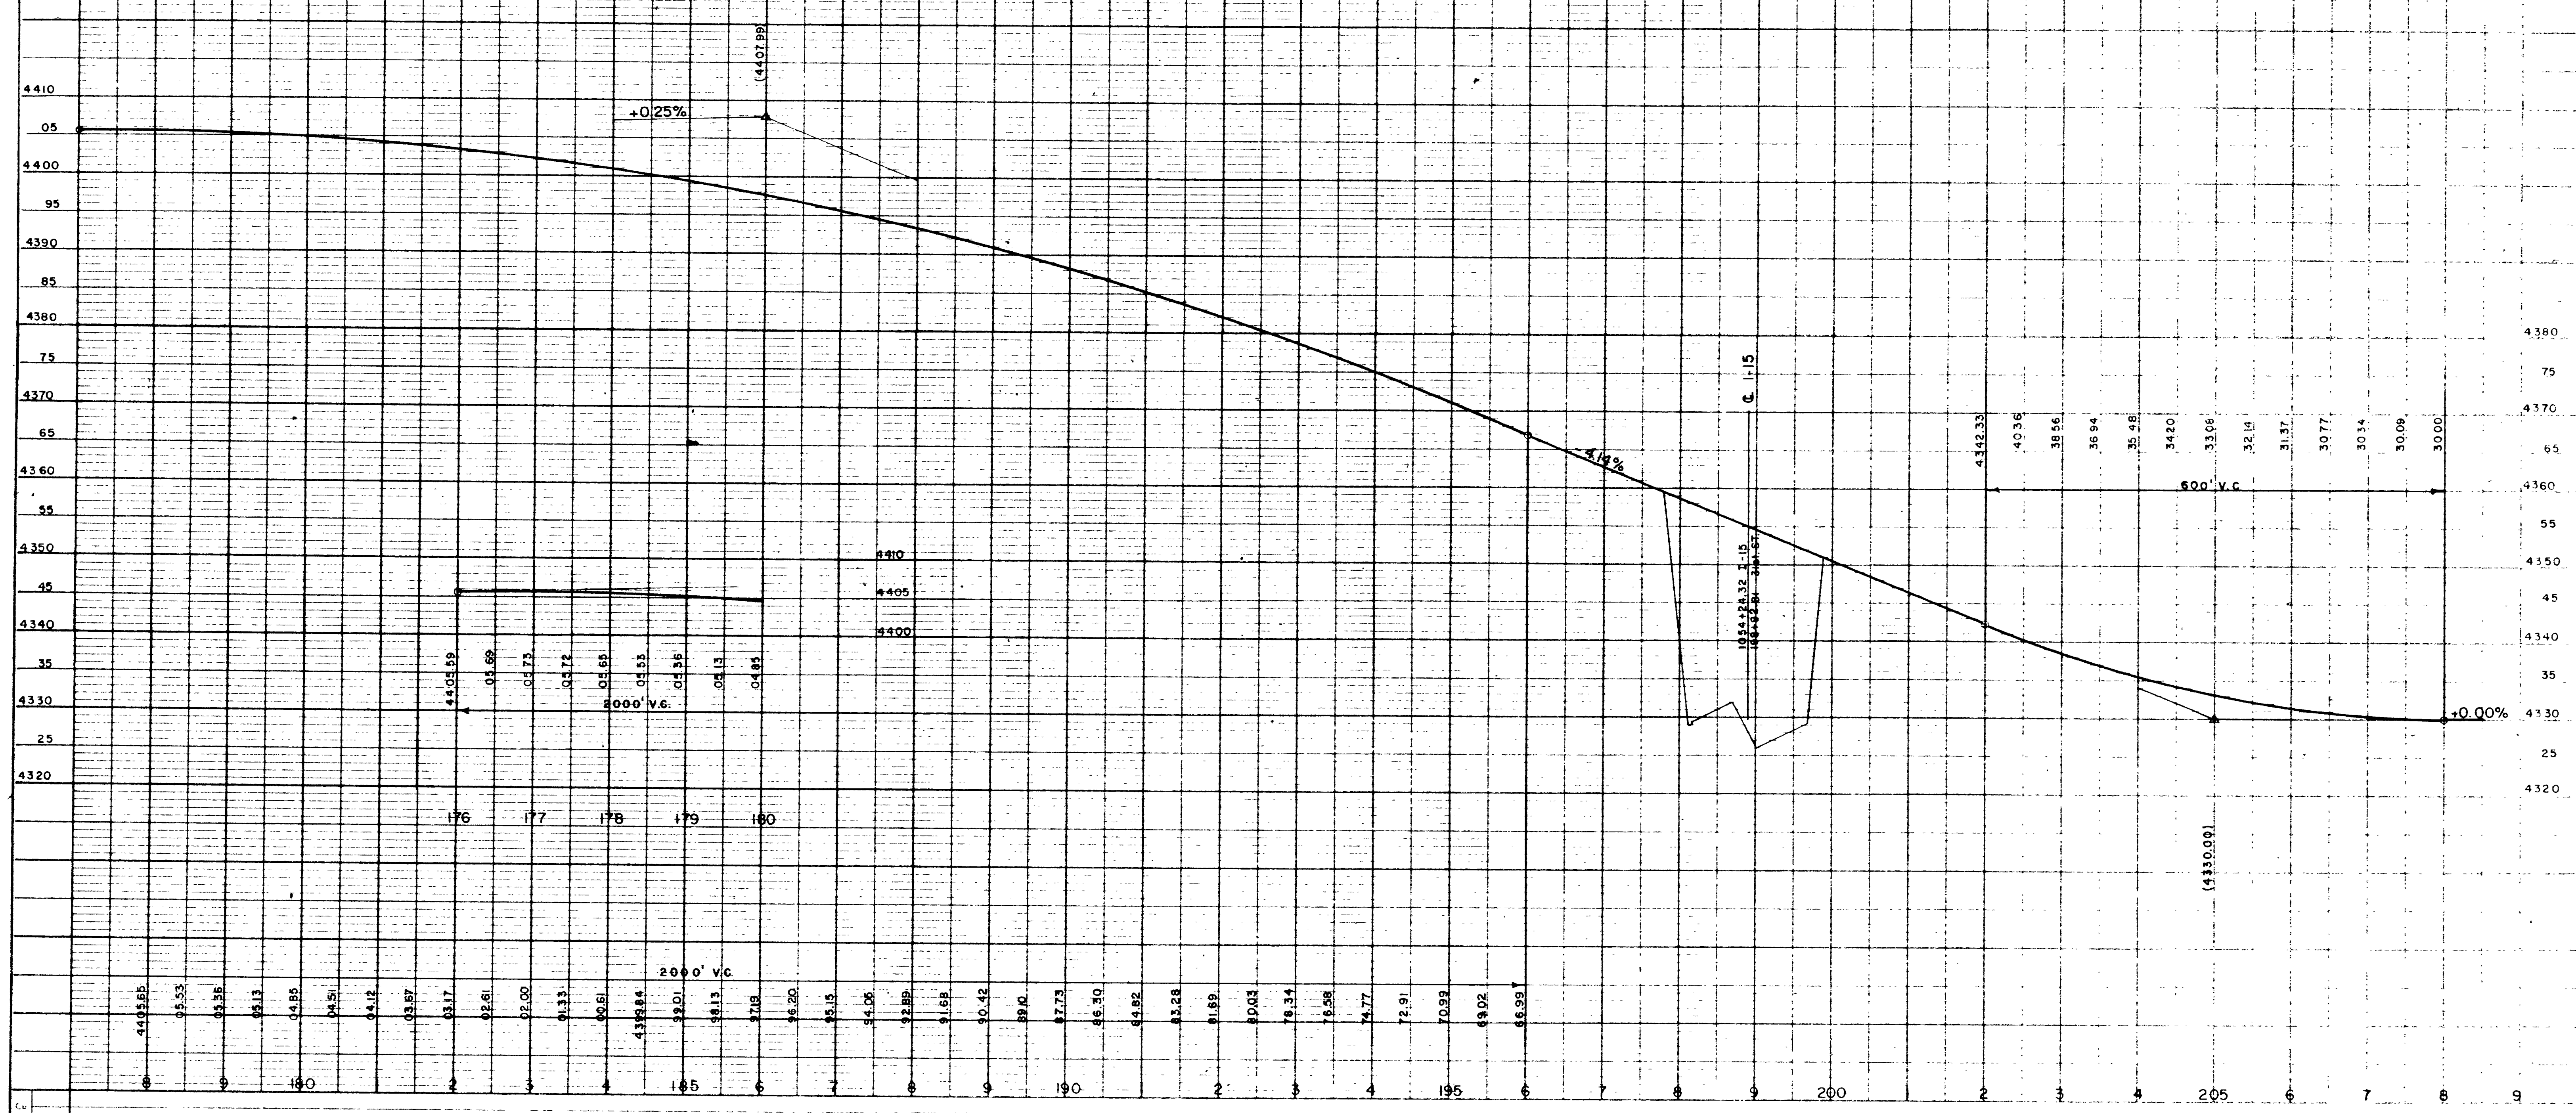


STORM SEWER PROFILE FOR THE
SOUTHERN PART OF 31st ST.
INTERCHANGE

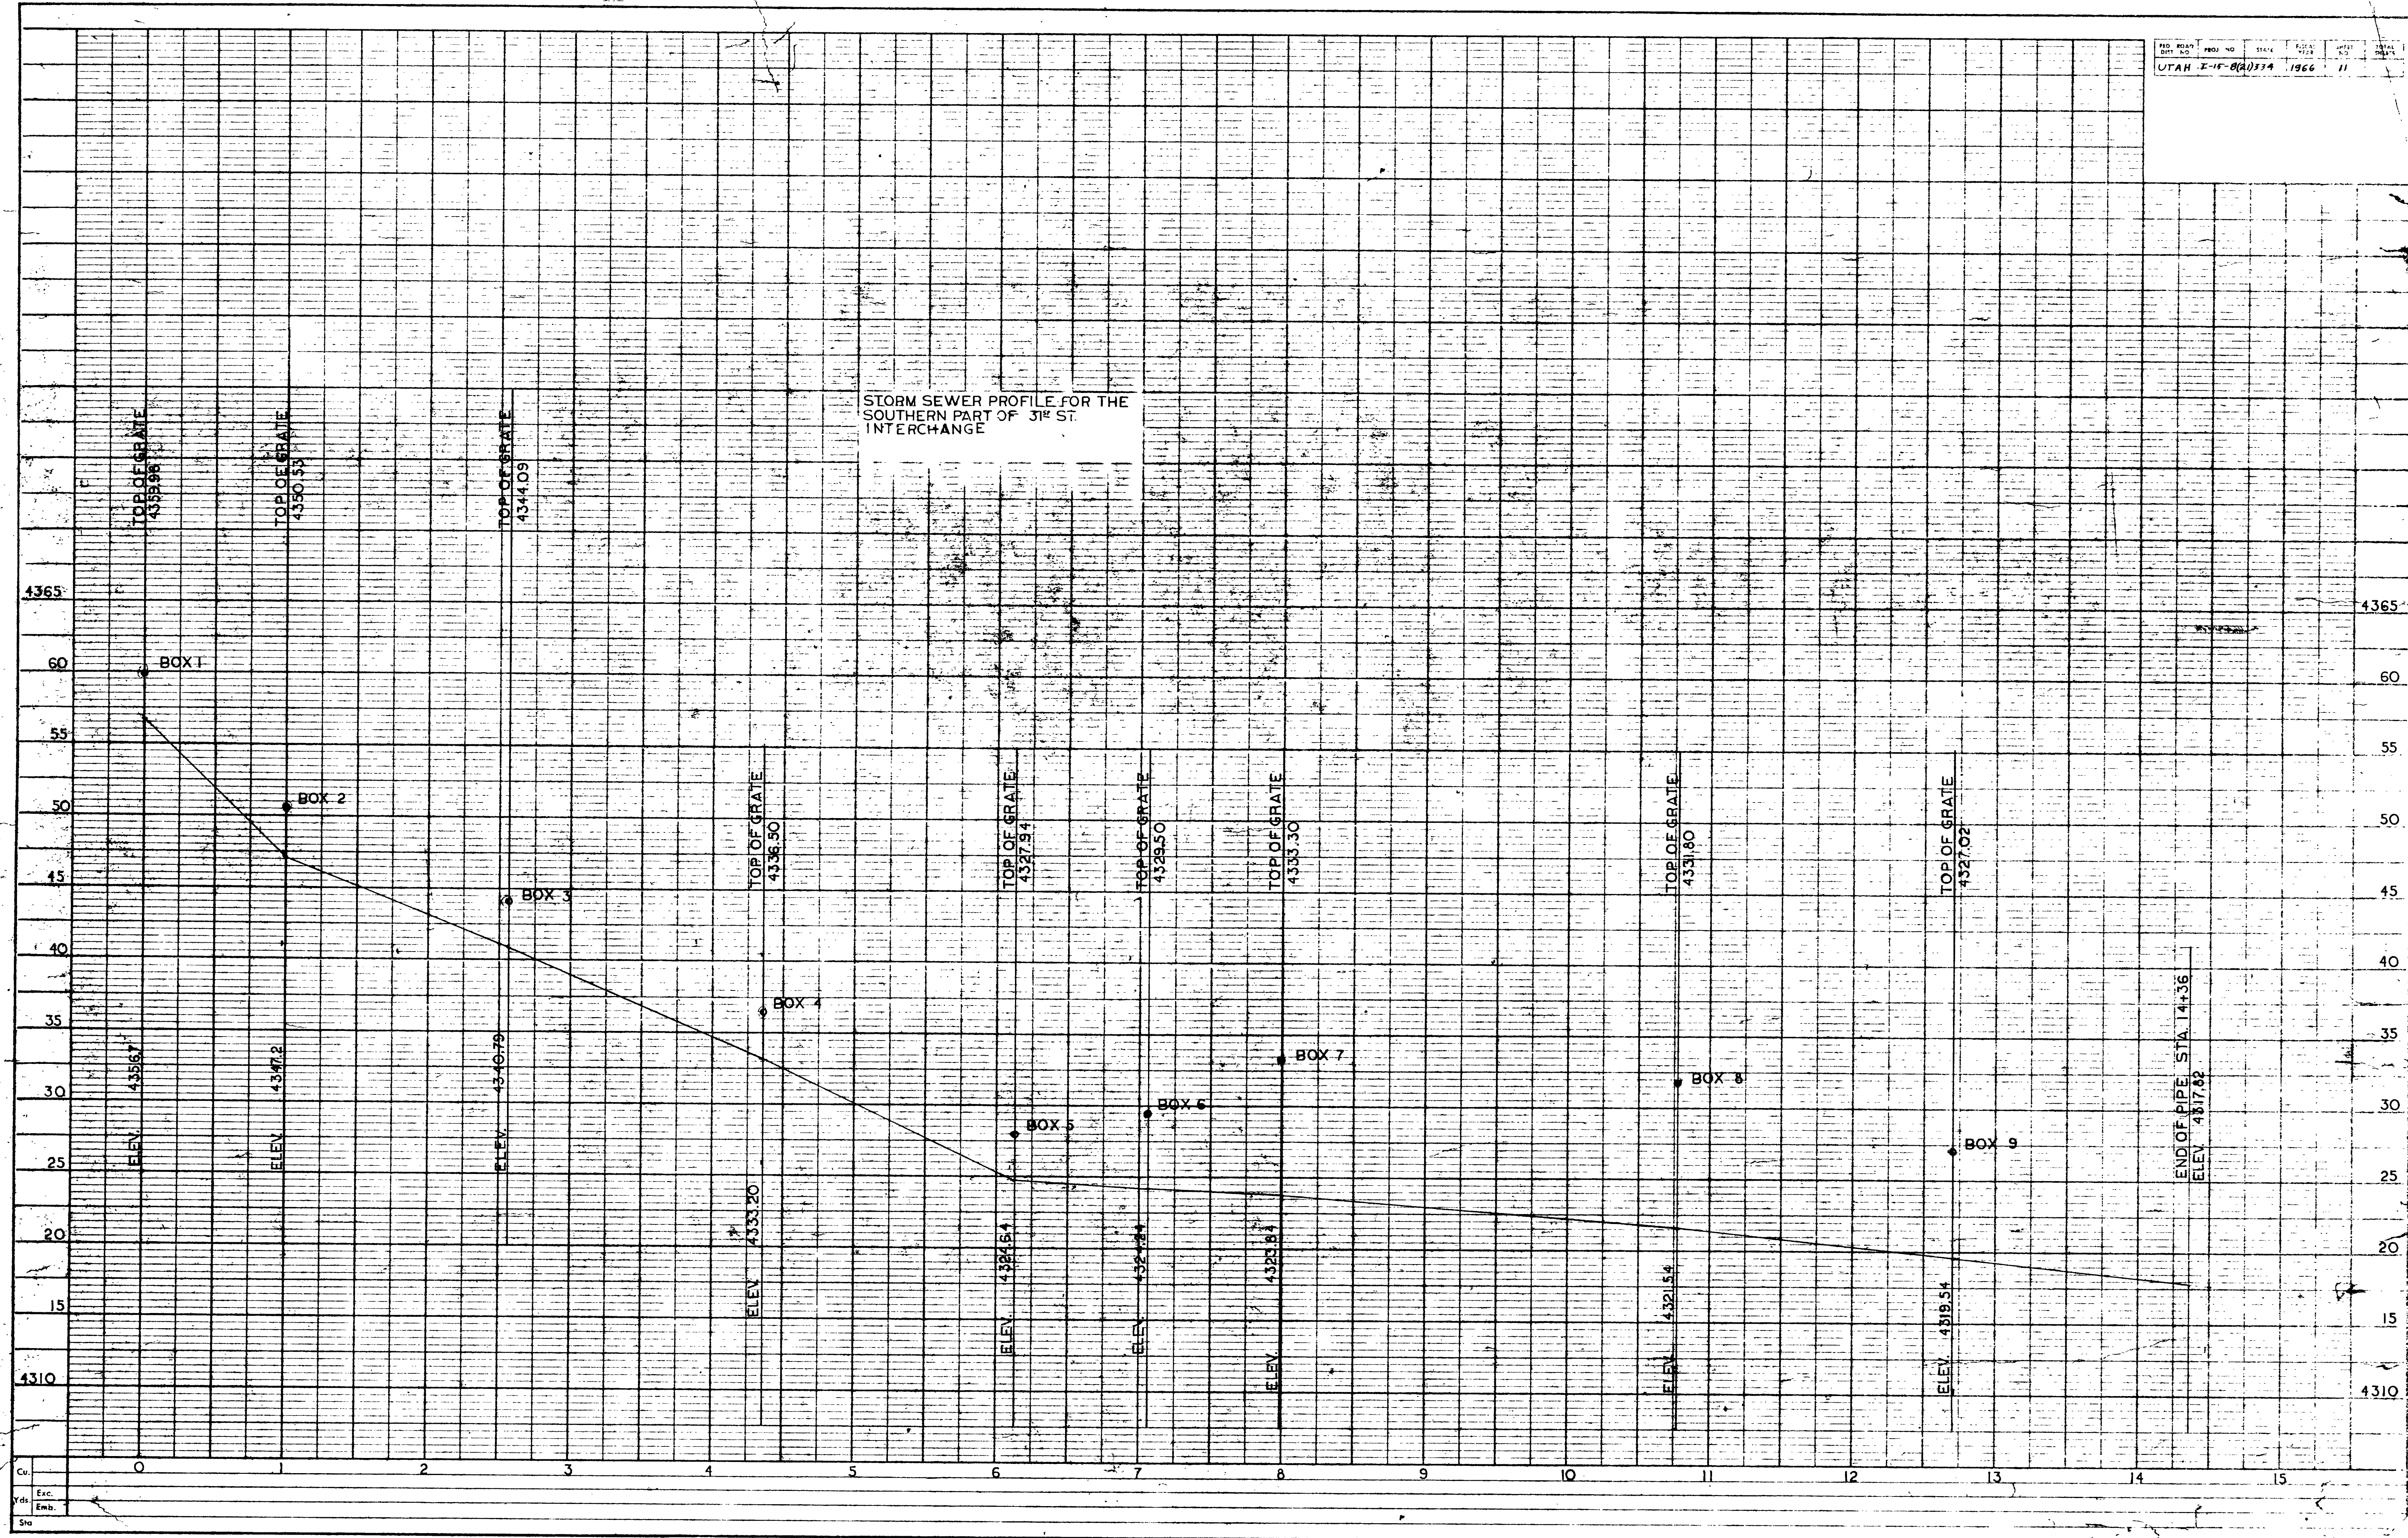


Co.
Exc.
Yds.
Emb.
Sha


PROFILE	DATE	BY	DATE
SURVEYED			
PLOTTED			
GRADES CHECKED			
S.E.T. NOTED			

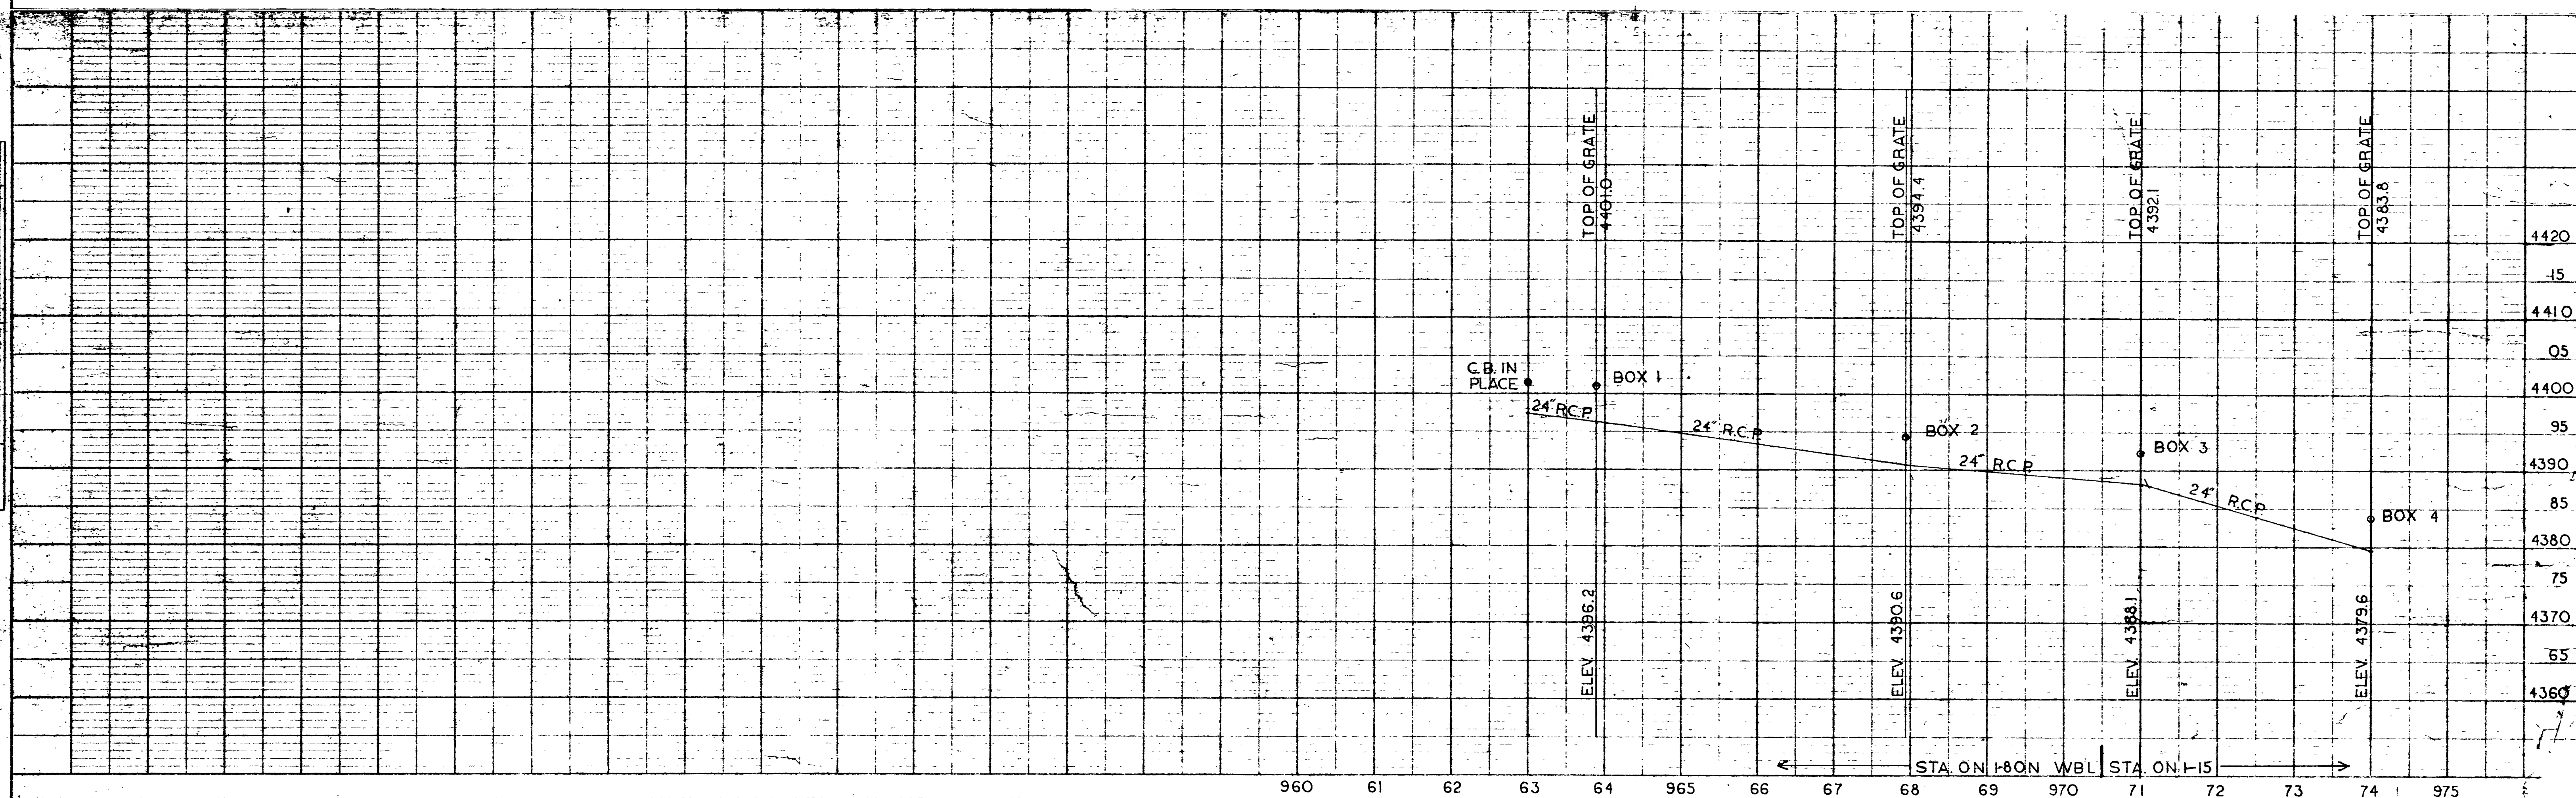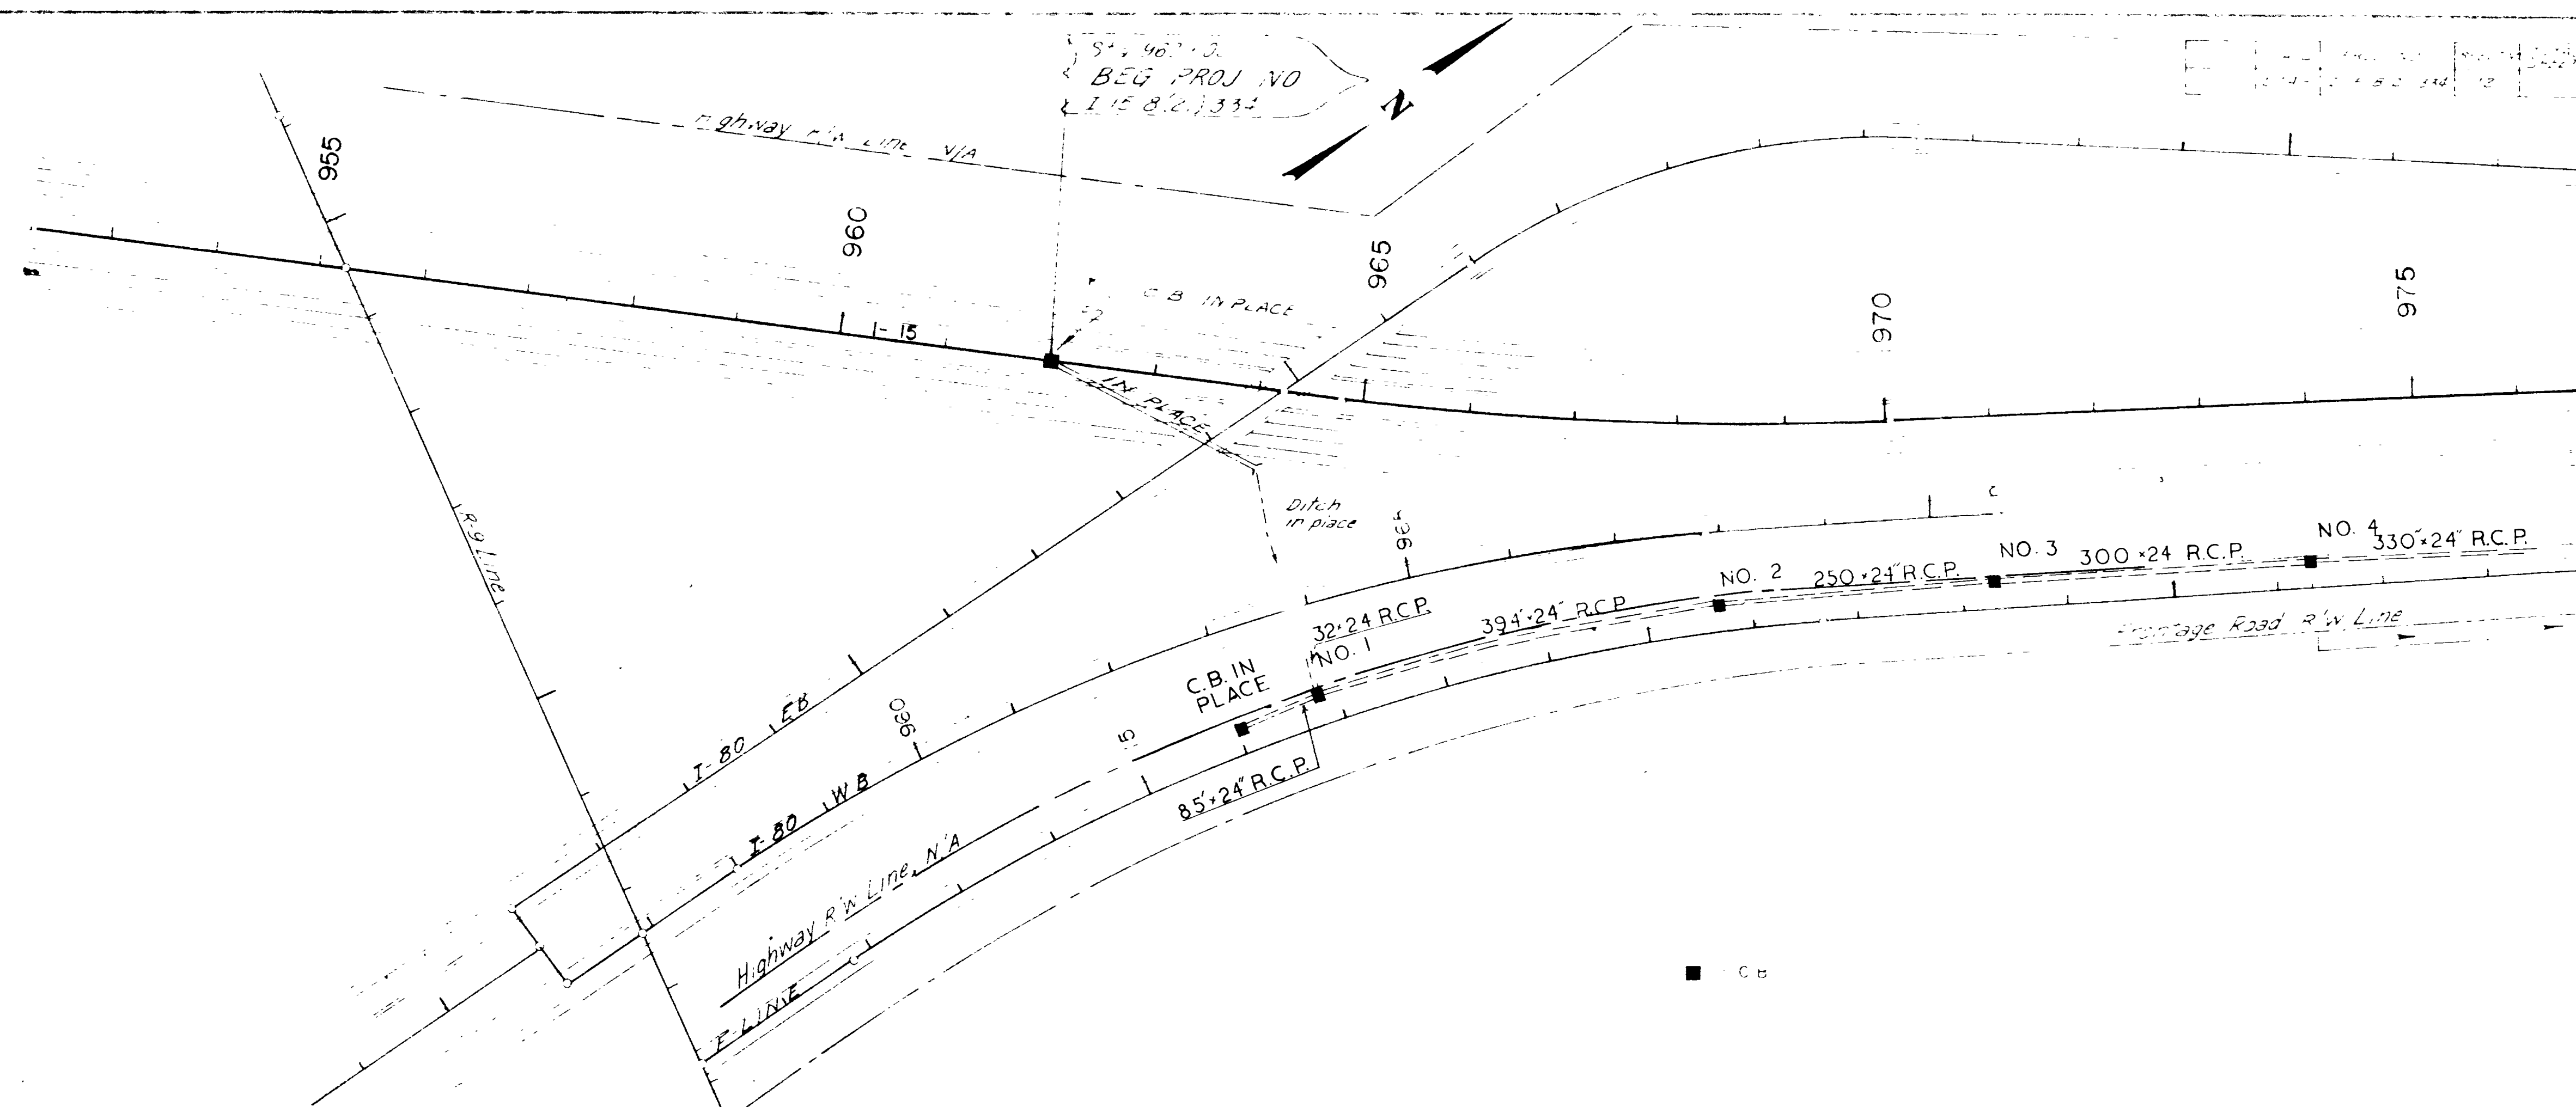



PLAN	SURVEYED	DATE
	PLANNED	BY
	NOTED	CHECKED
	BY	CHECKED

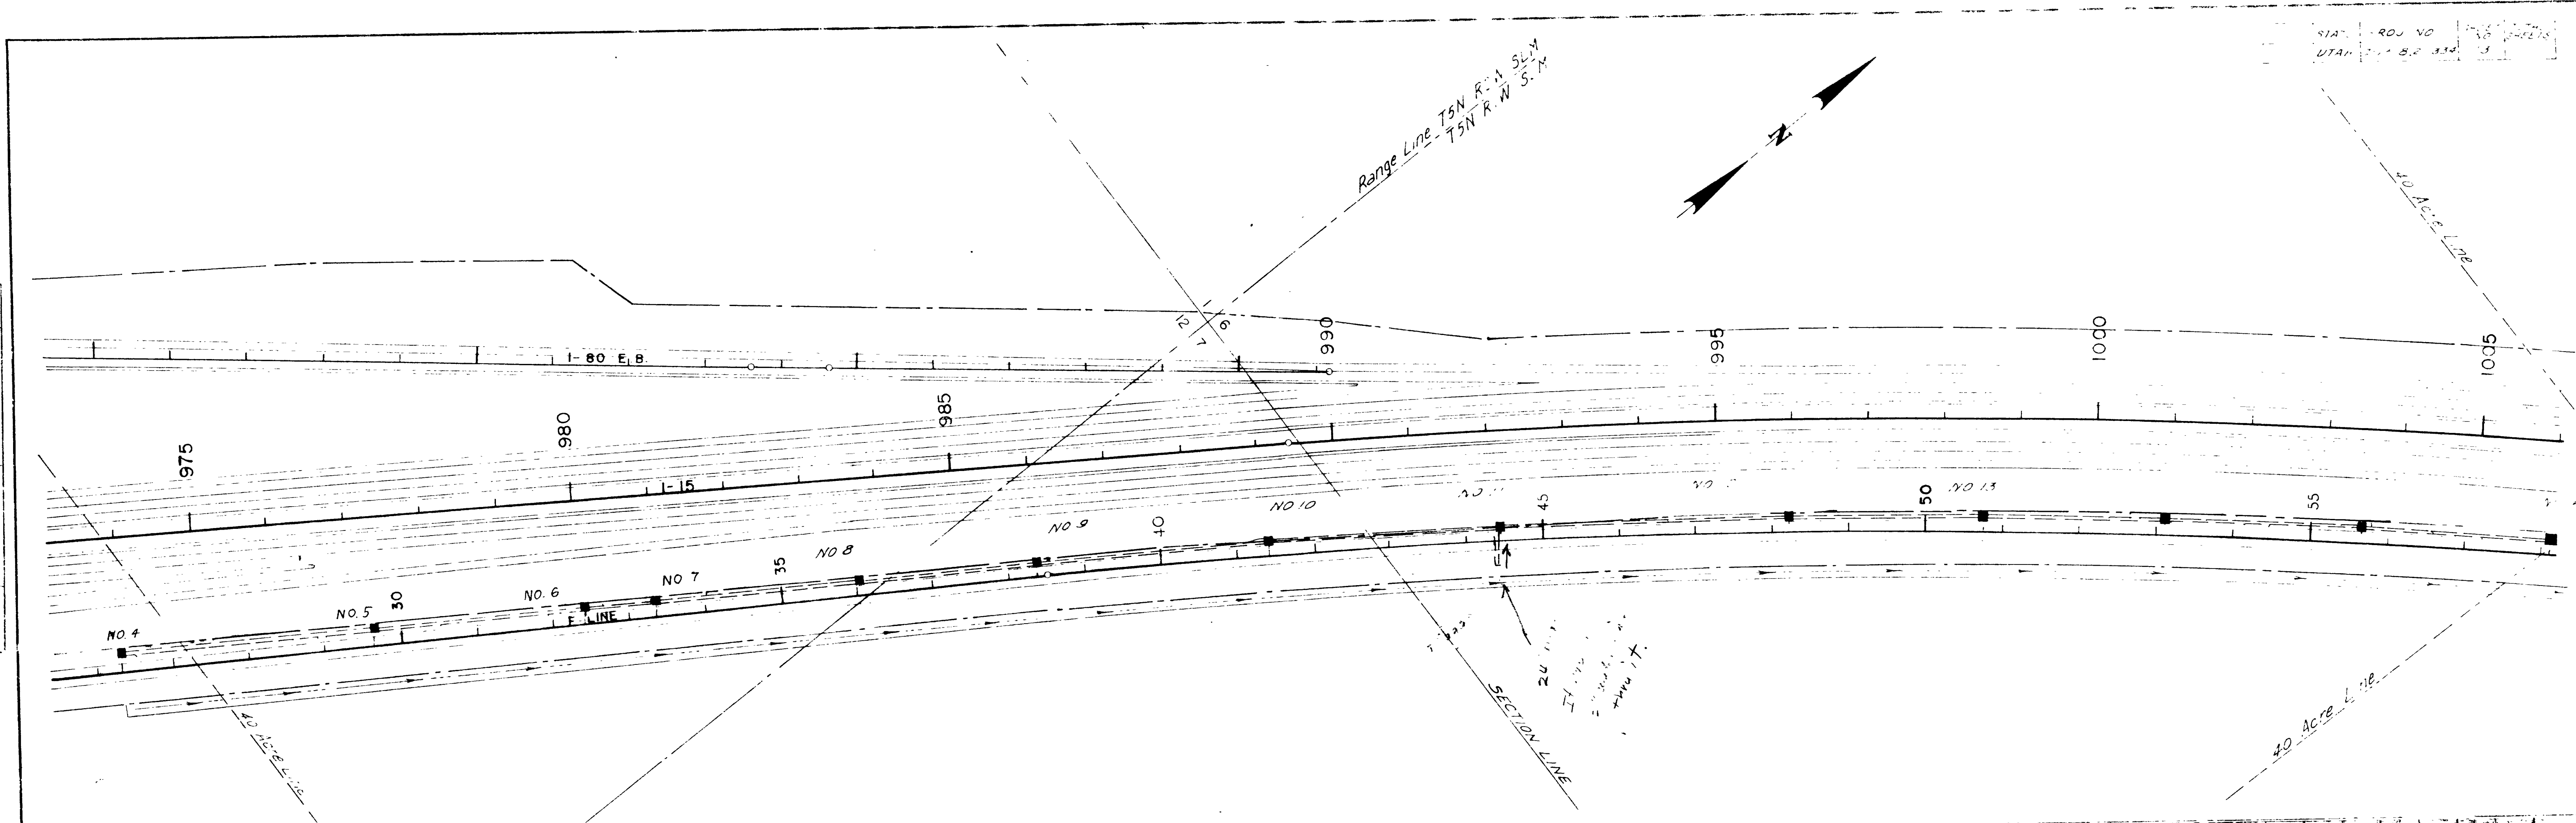


PROFILE	SURVEYED	DATE
	PLANNED	BY
	NOTED	CHECKED
	BY	CHECKED

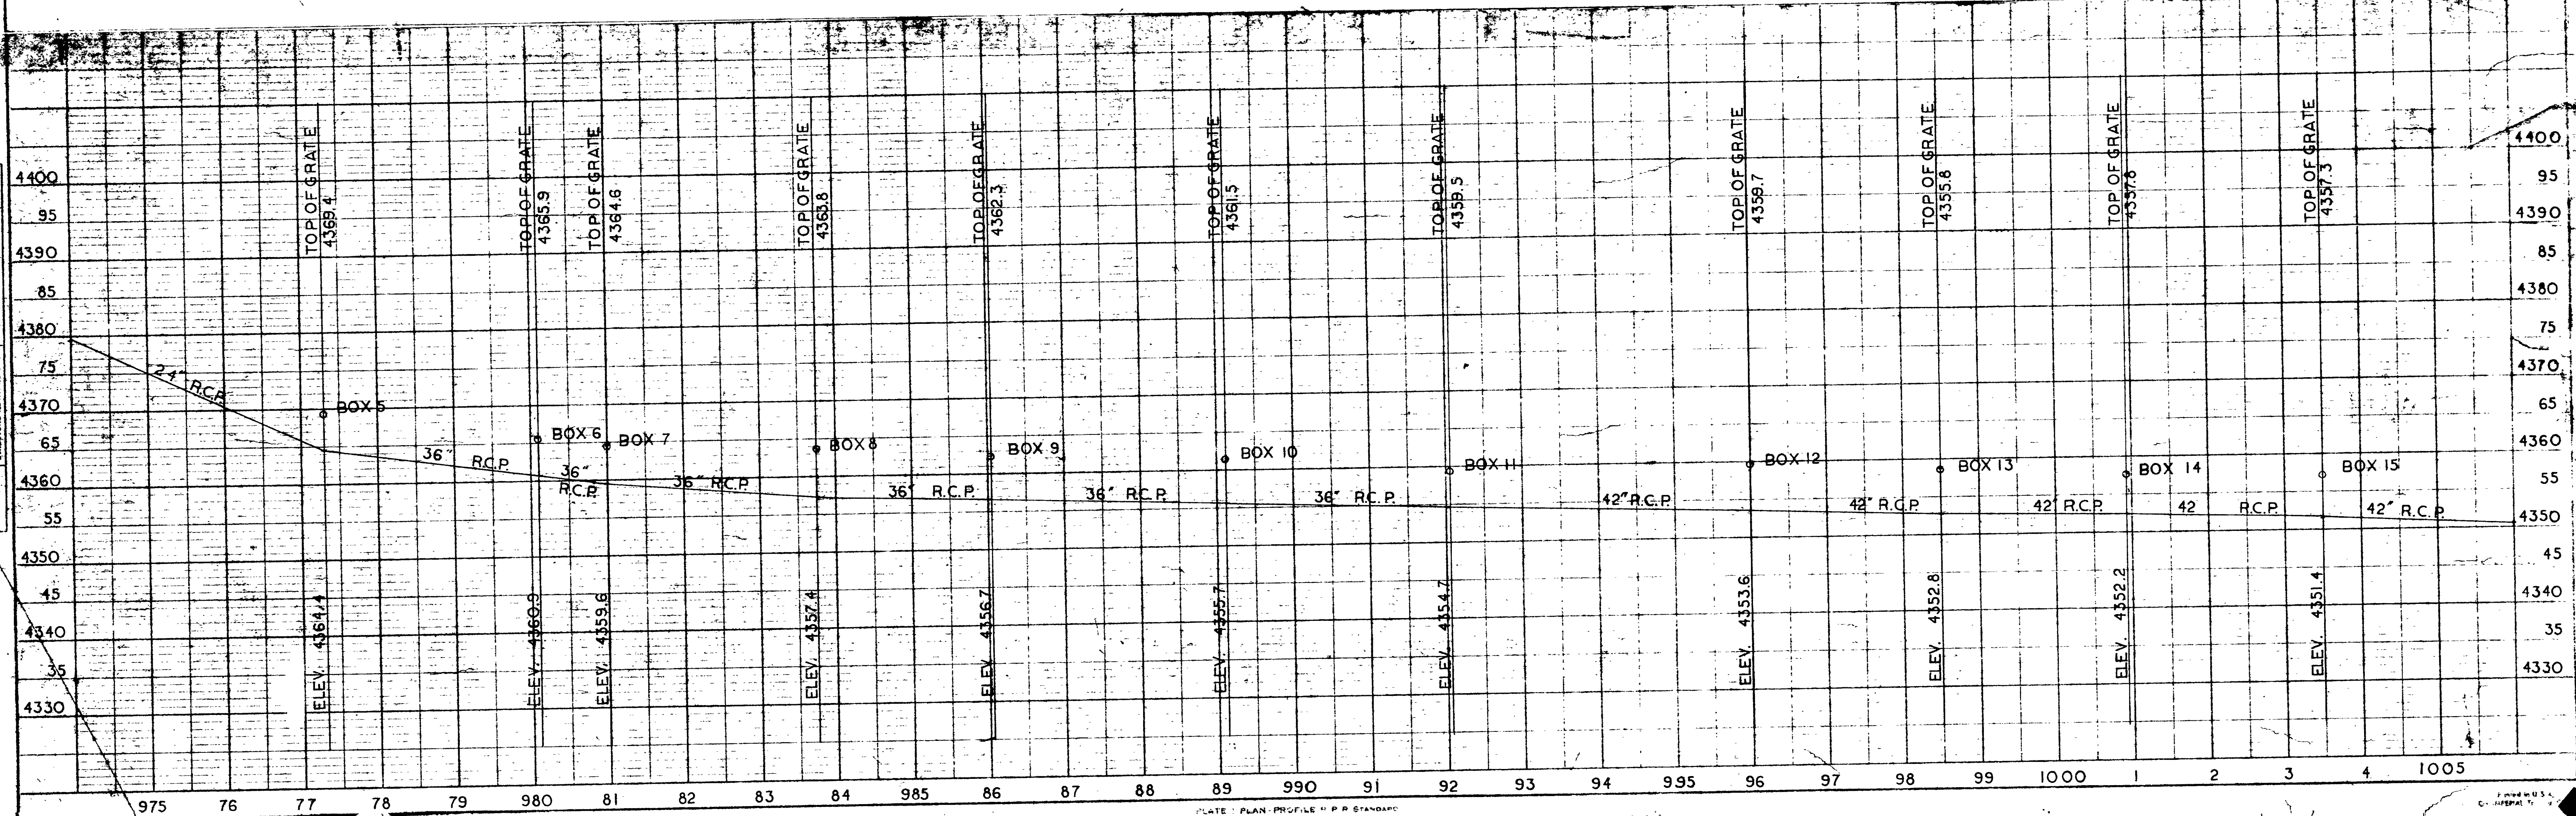

PLAN
 SURVEYED
 PLOTTED
 SCALE 1" = 40'
 BY UPAT/END

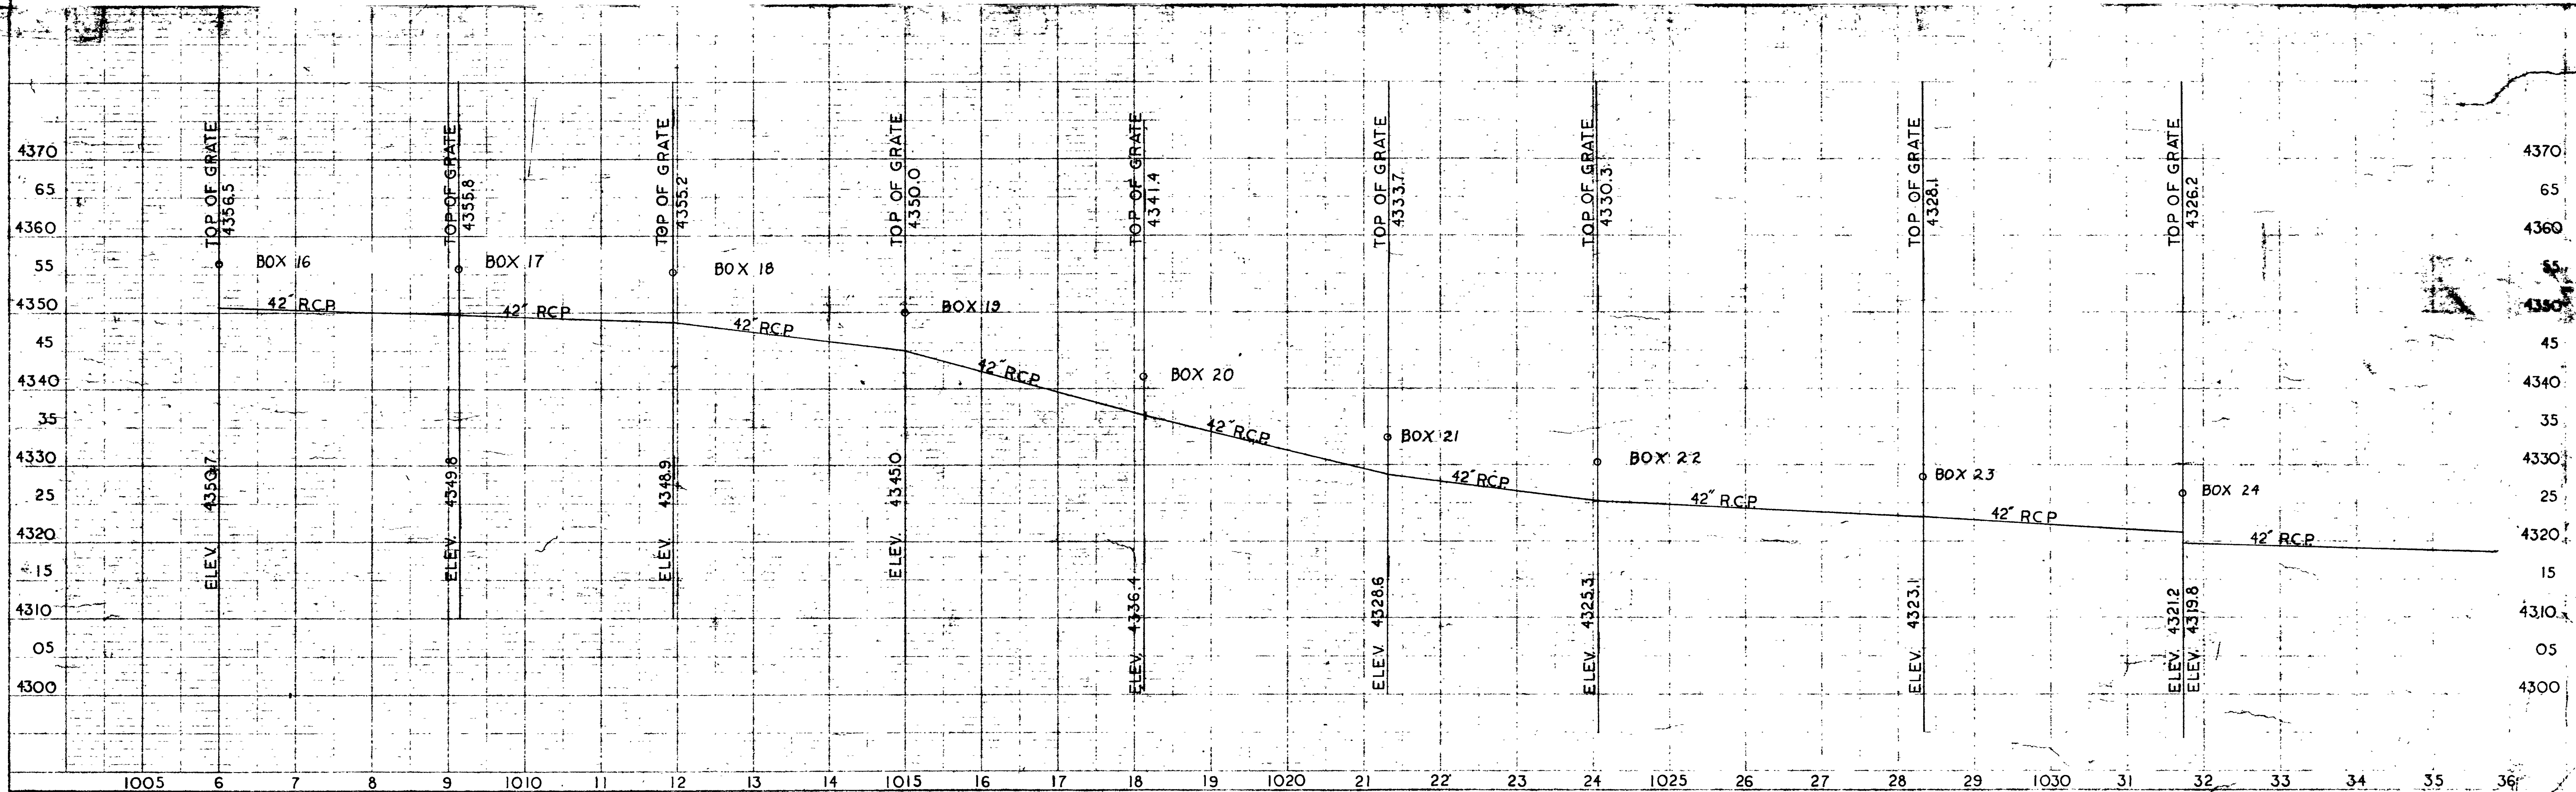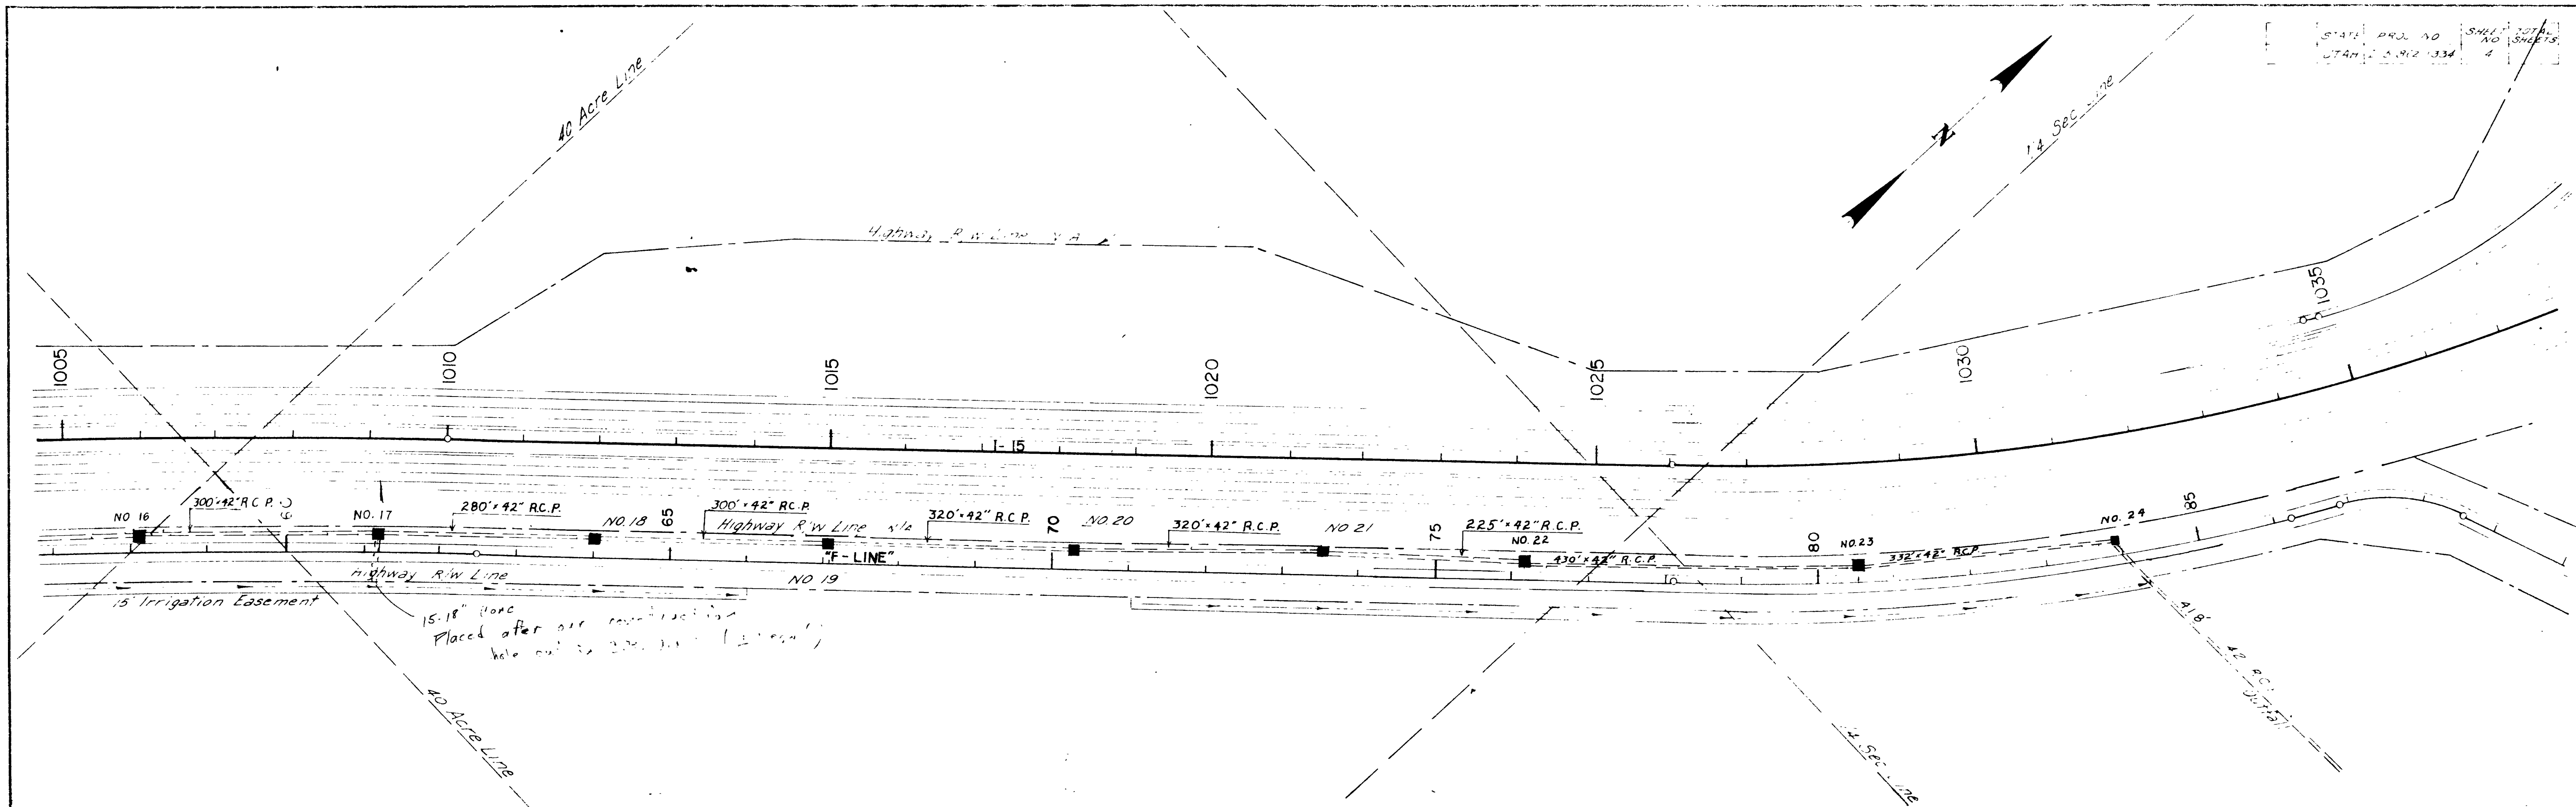

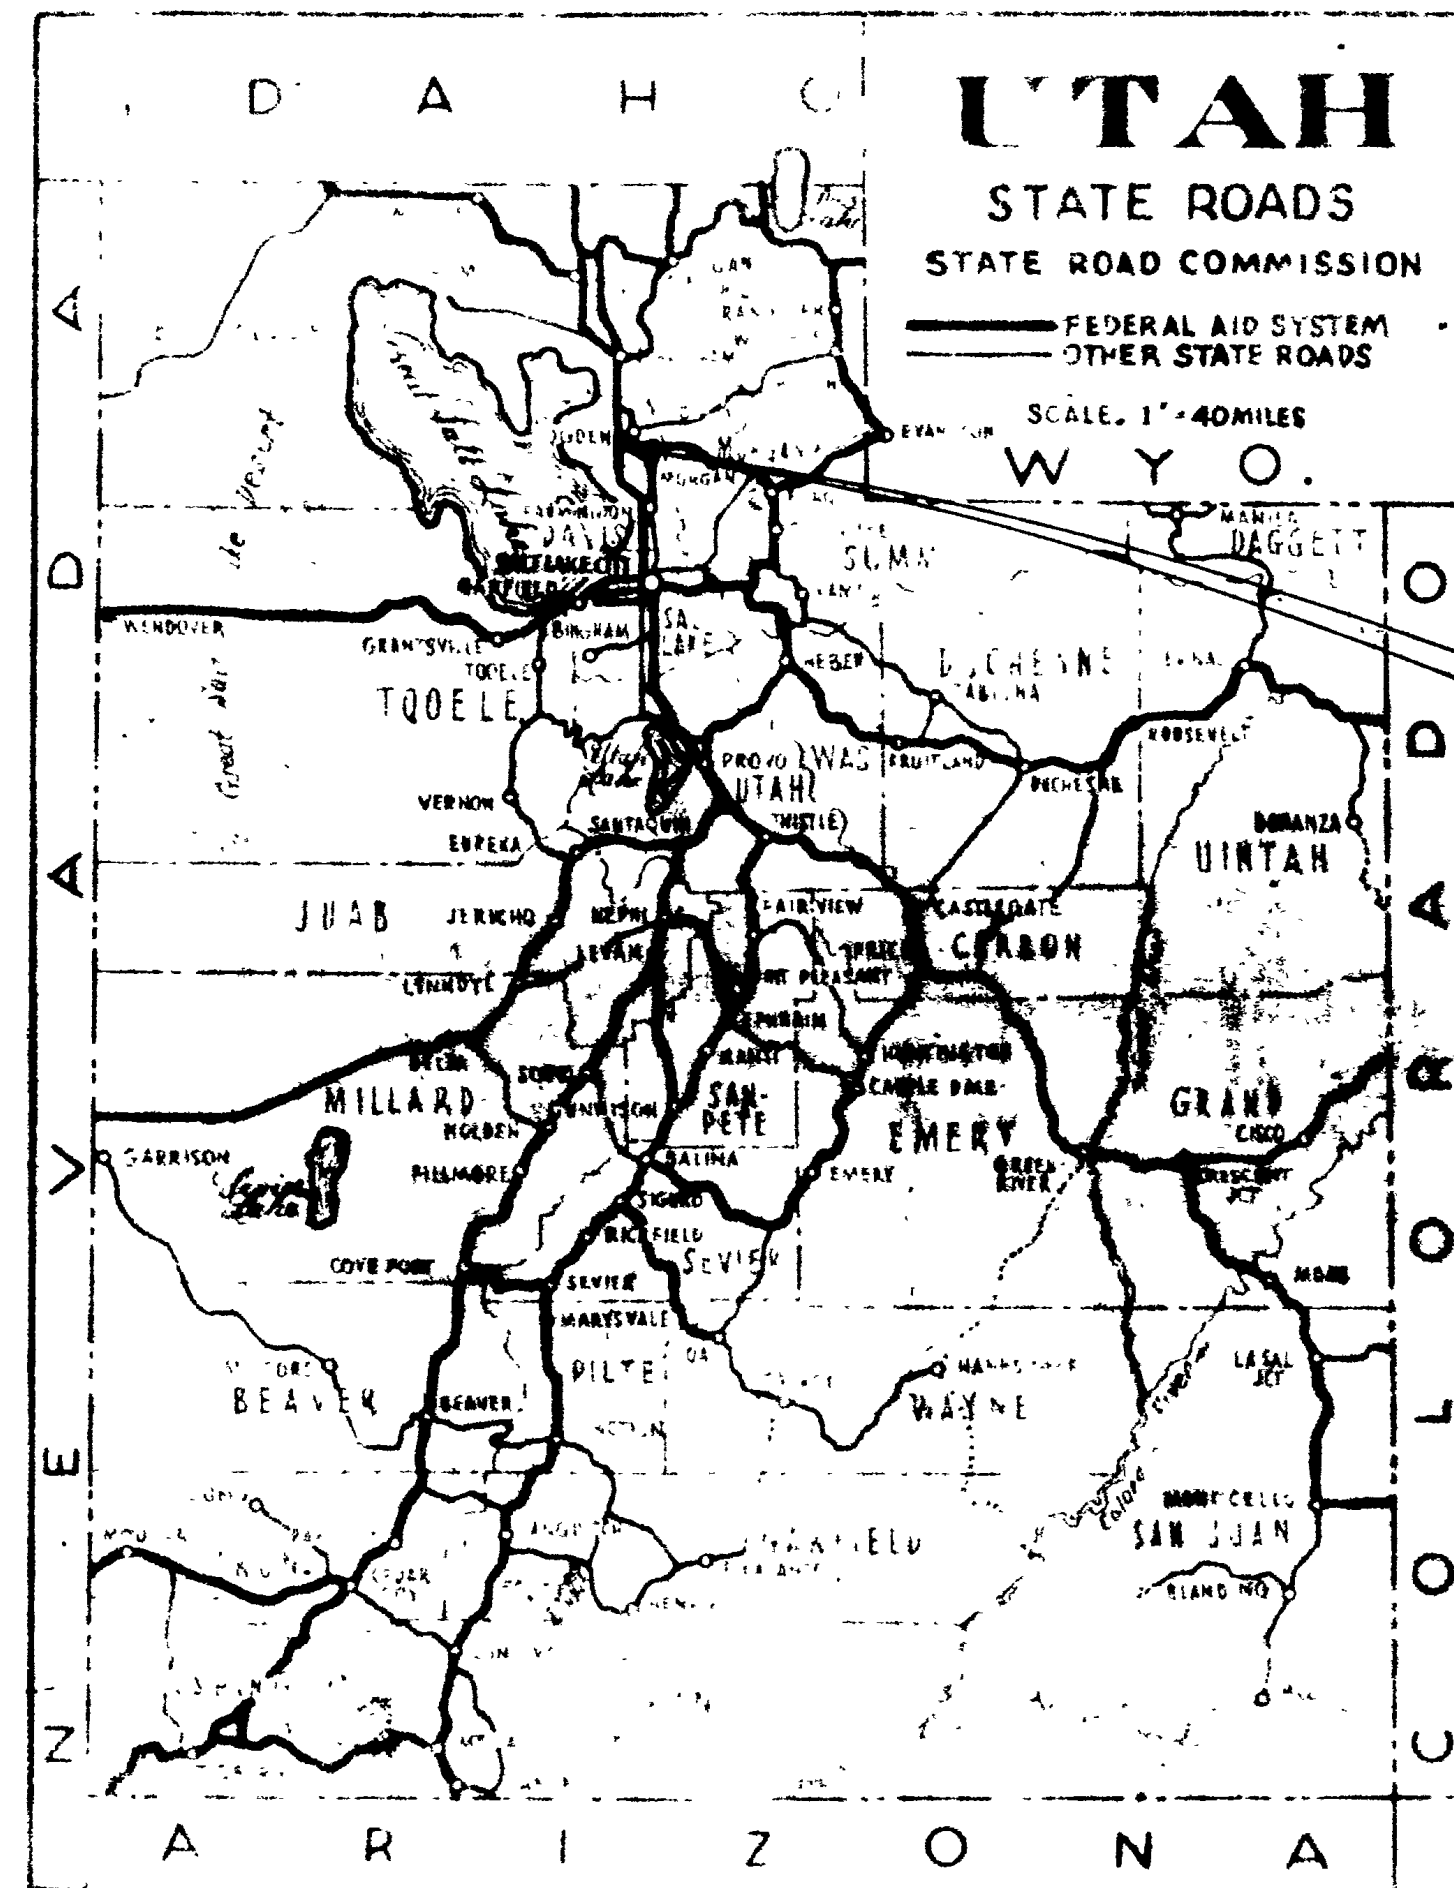

STATE OF UTAH STATE ROAD COMMISSION

PLANS OF PROPOSED STATE ROAD


FEDERAL AID PROJECT

I-15-8(2)D 334 1ST CONTRACT

DAVIS-WEBER COUNTY LINE TO 31ST STREET


WEBER COUNTY
LENGTH 3.862 MILES

AS CONSTRUCTED DRAWINGS

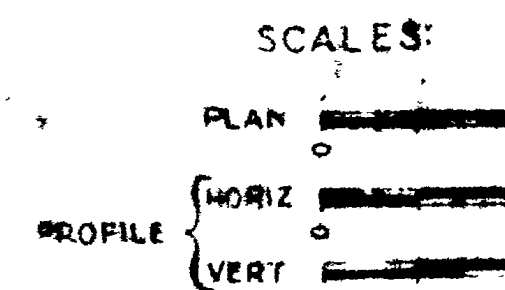

UTAH	PROJ. NO.	1
REV. DATE 3/10/65	I-15-8(2) 334	
REV. DATE 3/12/65		
1 ST Contract		
INDEX TO SHEETS I-15-8(2) 334		

1	TITLE SHEET	
2A-F	TYPICAL SECTION	
3(3A-F)	SUM. SHEETS AND MAT'L. SITE SHEETS	
4-23	PLAN & PROFILE SHEETS	
24	DEEP BEAM HIGHWAY GUARDRAIL	230
25	GROUND MOUNTED SIGN INSTALLATION DETAILS	813
26	CHAIN LINK FENCE	
27-31	CONSTRUCTION SIGNS	
32	ENTRANCE & EXIT RAMP EXISTING	
33	ENTRANCE & EXIT RAMP EXISTING	
34	CONCRETE CURB AND GUTTER	231
35	REINFORCED CONC. SHOULDER	232
36	METAL GULCH END CLOSURE	233
37	STD. CATCH BASIN FOR BUTTER ROOF	234
38	STANDARD CATCH BASIN	235
39	POLE FOUNDATION ALONG R.C. CULVERT	236
40	CROSSING	
41	JUNCT. BOX DETAILS FOR STRUTTING	237
42	RAISED MEDIAN	238
43	CORRUGATED METAL PIPE GULCH	239
44	SHOULDER AND MEDIAN DRAIN	240
45	REINFORCED CONCRETE PIPE GULCH	241

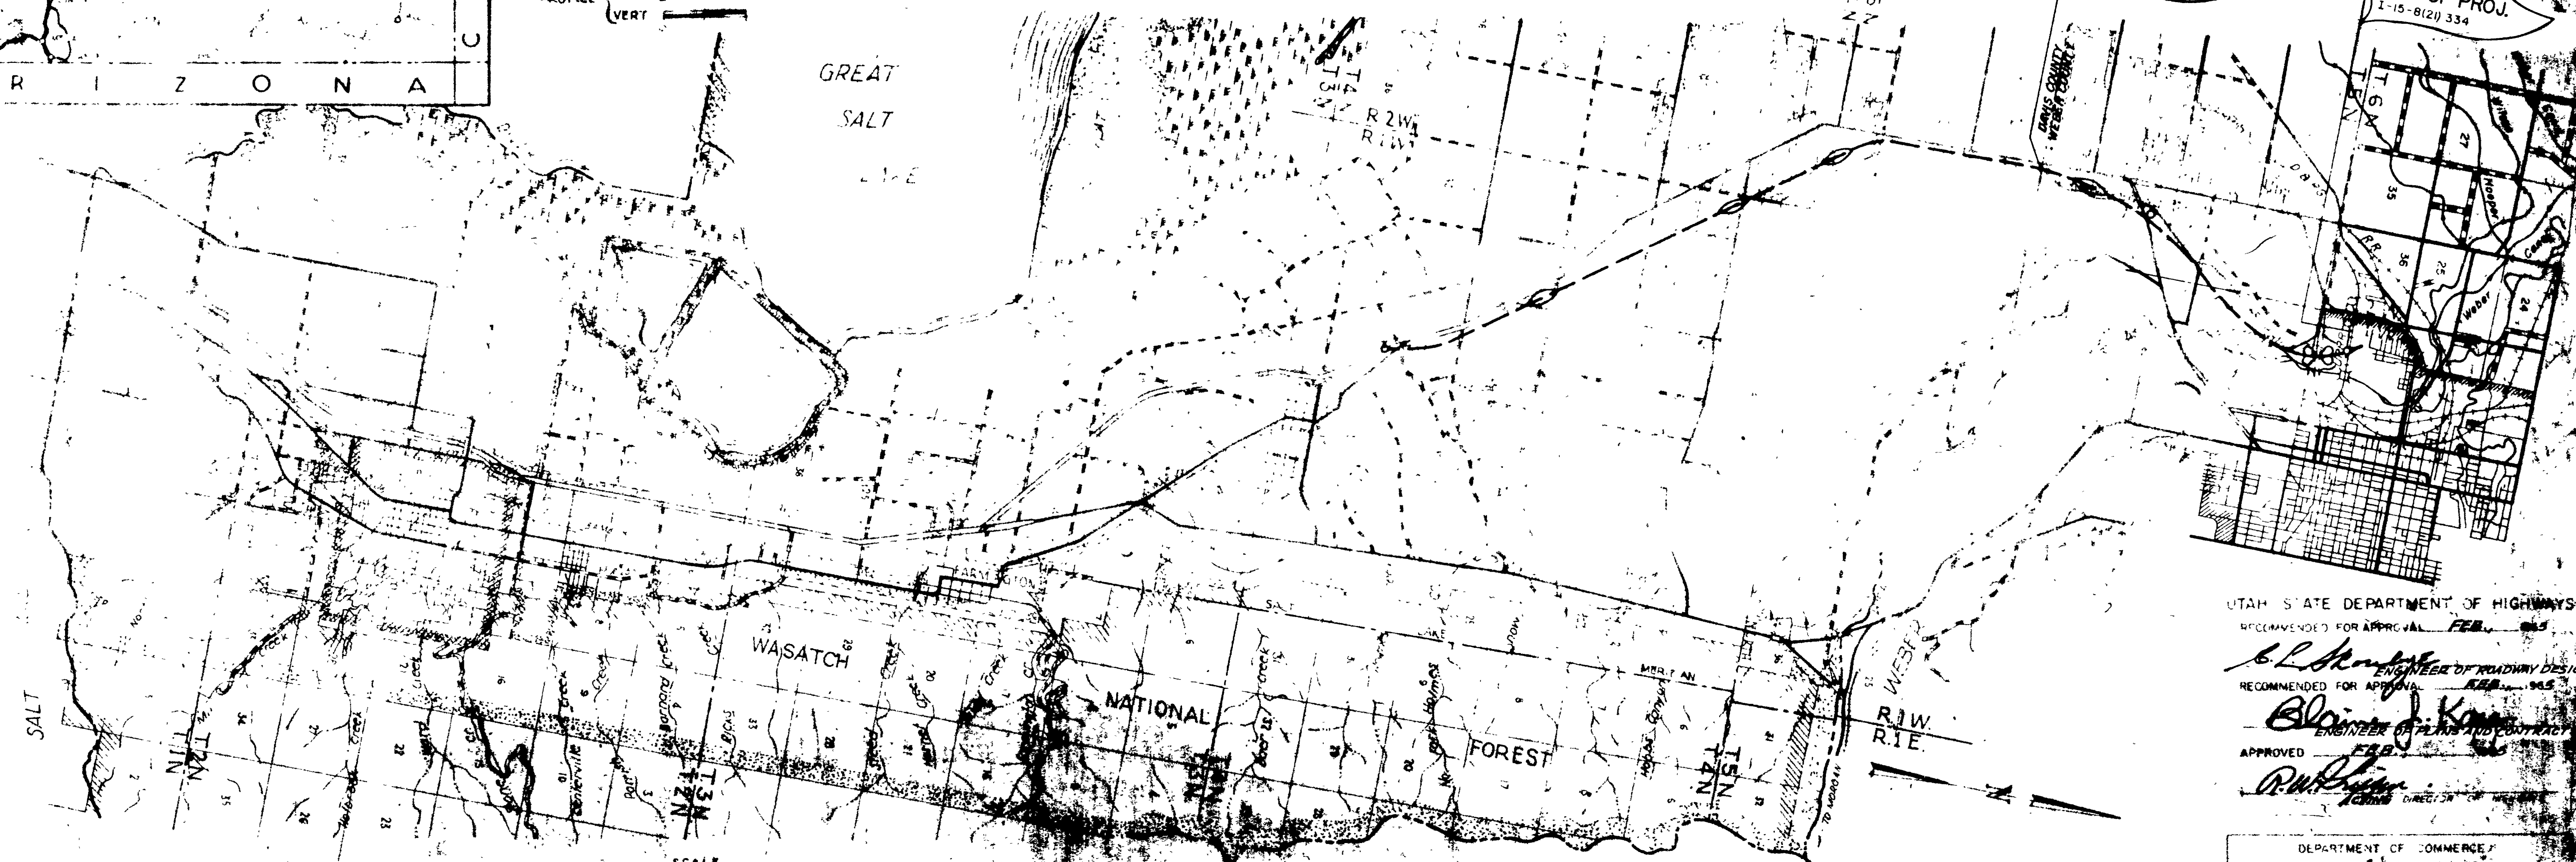

UTAH STATE DEPARTMENT OF HIGHWAYS
RECOMMENDED FOR APPROVAL FEB. 1965

RECOMMENDED FOR APPROVAL FEB. 1965

APPROVED FEB. 1965

APPROVED FEB. 1965

APPROVED FEB. 1965

DEPARTMENT OF COMMERCE
BUREAU OF PUBLIC ROADS

APPROVED


APPROVED

APPLICATION	TYPE	AMOUNT FOR EST. PURPOSES ONLY
PORTLAND CEMENT CONCRETE PAVEMENT	9" THICK	SQ YD
PORTLAND CEMENT TREATED BASE COURSE		140 LBS/CU FT
PORTLAND CEMENT	TYPE I	SEE SPECIAL PROVISION
GRAVEL BASE COURSE	1" MAX AGG	140 LBS/CU FT
GRAVEL SURFACE COURSE	1" MAX AGG	140 LBS/CU FT
BITUMINOUS SURFACE COURSE	1" MAX AGG	148 LBS/CU FT
BITUMINOUS SURFACE COURSE	3/4" MAX AGG	148 LBS/CU FT
BITUMINOUS MATERIAL	85-100 PENETRA	5% BIT SUR CRSE by WT
BITUMINOUS MATERIAL	60-70 PENETRA	7% BIT SUR CRSE by WT
BITUMINOUS MATERIAL SEAL COAT	RC-800	0.2 GAL / SQ YD
BITUMINOUS MATERIAL TACK COAT	RC-70 OR RC-250	0.15 GAL / SQ YD
BITUMINOUS MATERIAL CURING COAT	MC-70 OR MC-250	0.15 GAL / SQ YD
BITUMINOUS MATERIAL PRIME COAT	MC-70 OR MC-250	0.5 GAL / SQ YD
BITUMINOUS ADDITIVE	COMMERCIAL GRADE	1% of RC-800 IN GALS
HYDRATED LIME		1% of BIT SUR CRSE
COVER MATERIAL	TYPE A	20 lbs / CU YD
PLANT MIX SEAL COAL		148 lbs / CU FT
FLUSH COAT	RC-70 OR RC-250	0.1 GAL / SQ YD

TYPICAL CROSS SECTION

FED. ROAD DIST. NO.	STATE	PROJ. NO.	SHEET NO.	TOTAL SHEETS
UTAH	UTAH	1-15-B(2)1334	2	



REVISION DATE 3/10/65

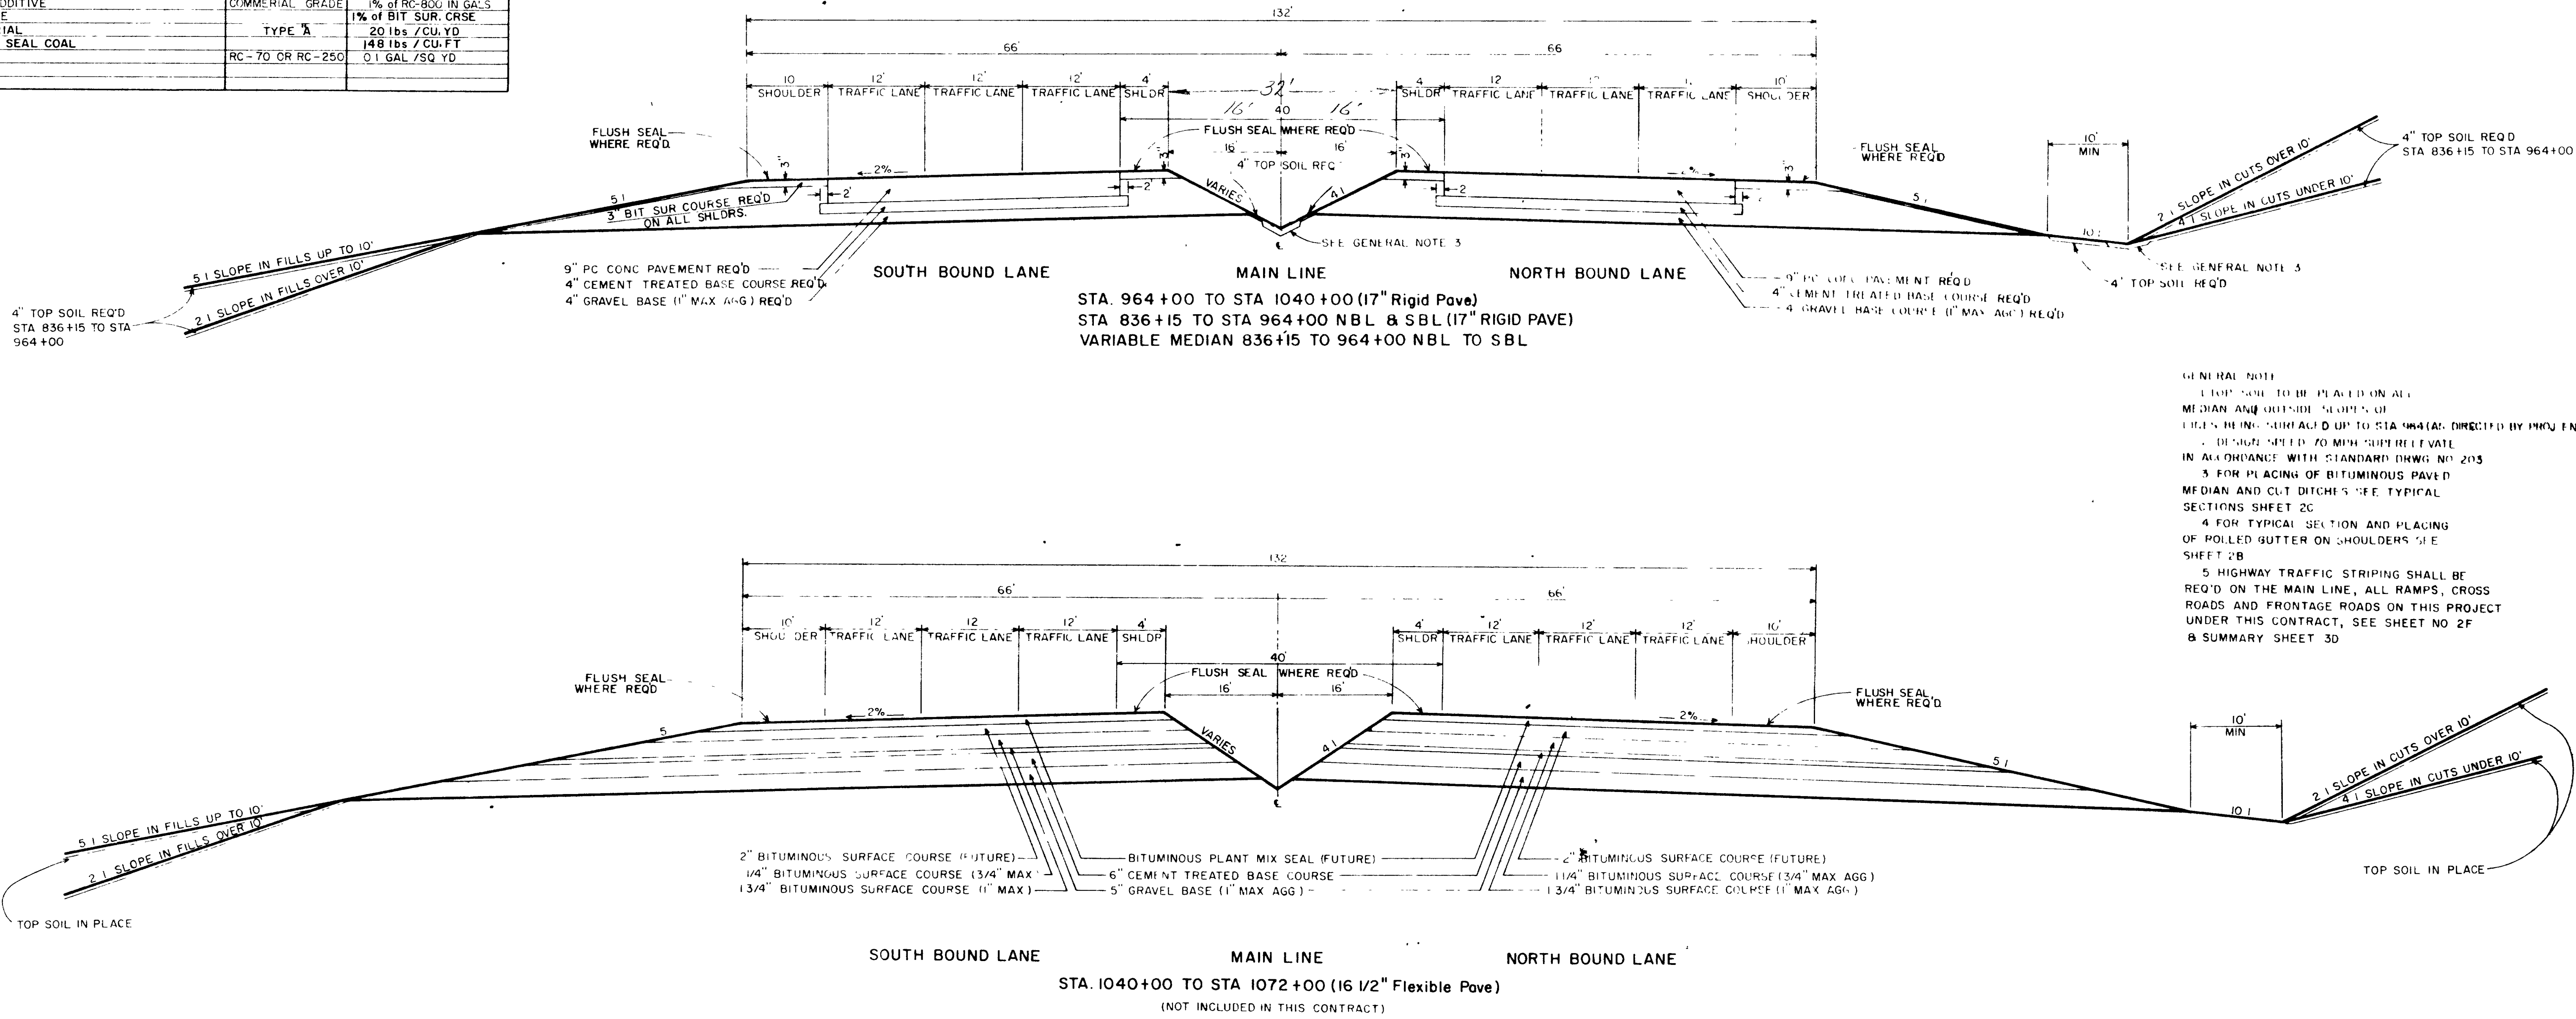

REVISIONS	DATE	BY

TYPICAL CROSS SECTION





FED. ROAD DIST. NO.	STATE	PROJ. NO.	SHEET NO.	TOTAL SHEETS
UTAH	UTAH	15-8(2)334	24	
REV. DATE 3/10/65 REV. DATE 3/10/65				

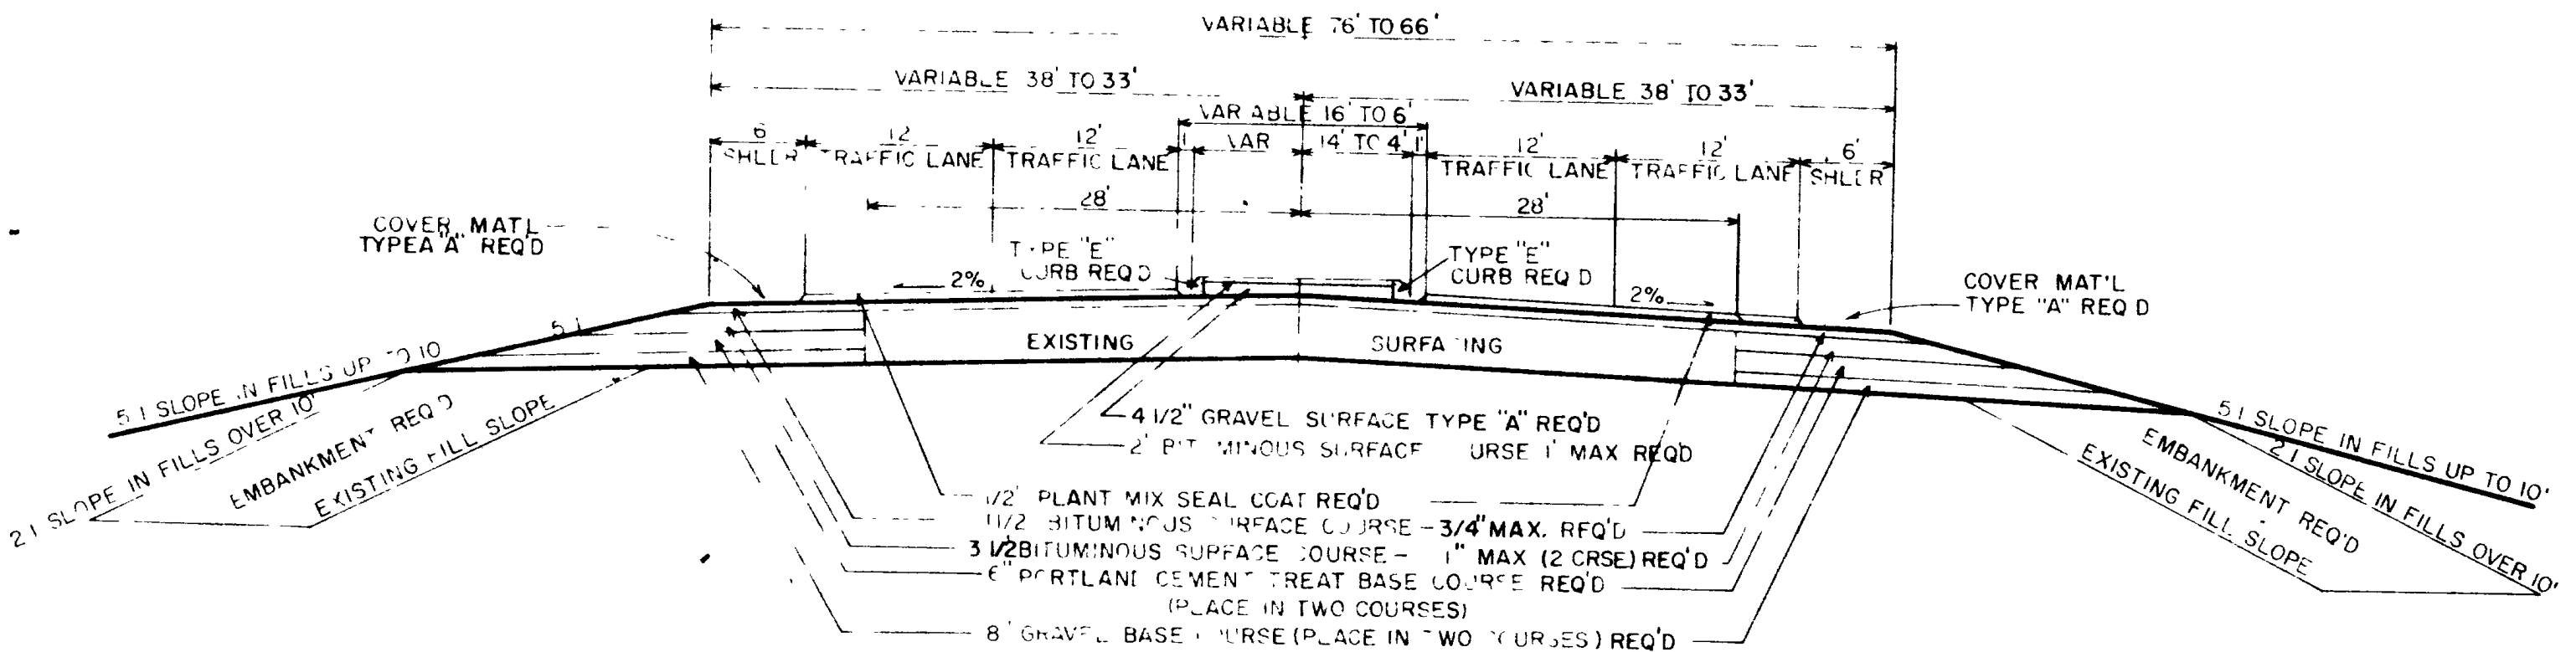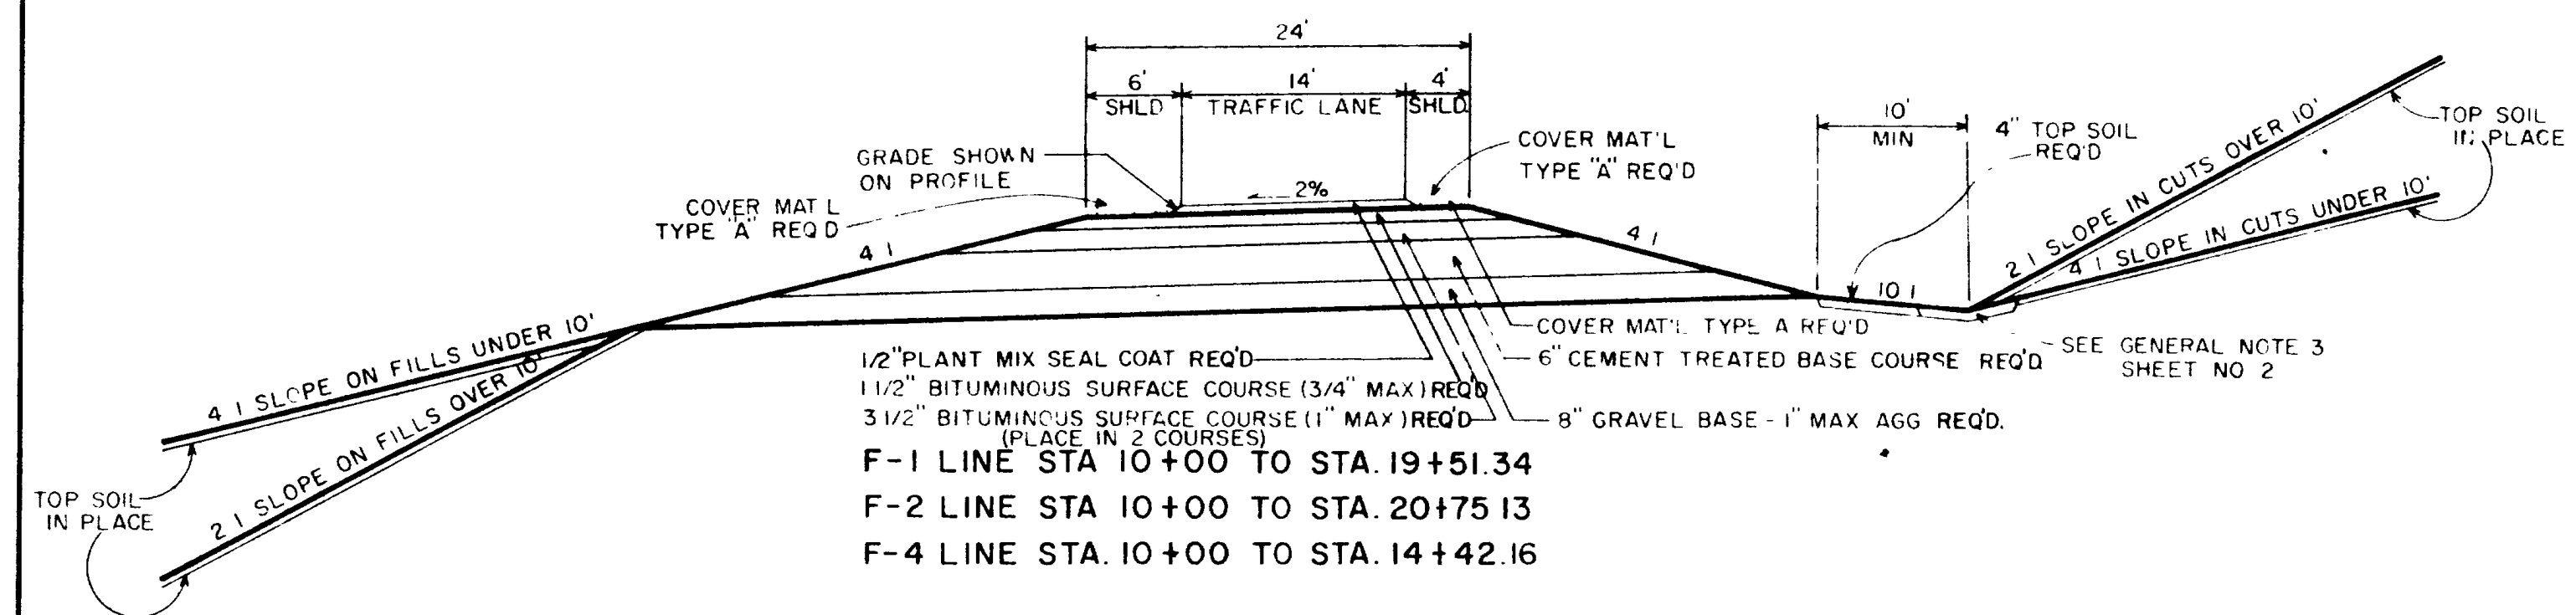

RIVERDALE ROAD
STA. 23+00 TO STA 54+22


NOTE:
STA 31+95 TO STA. 40+00 WHERE FINISHED GRADE IS HIGHER THAN THE EXISTING ROADWAY SURFACE EXTEND THE SHOULDER TREATMENT OVER THE EXISTING ROADWAY (AVE. DEPTH OF GRAVEL BASE COURSE IS 11" PLACE IN 3 COURSES)

REVISIONS
DATE BY

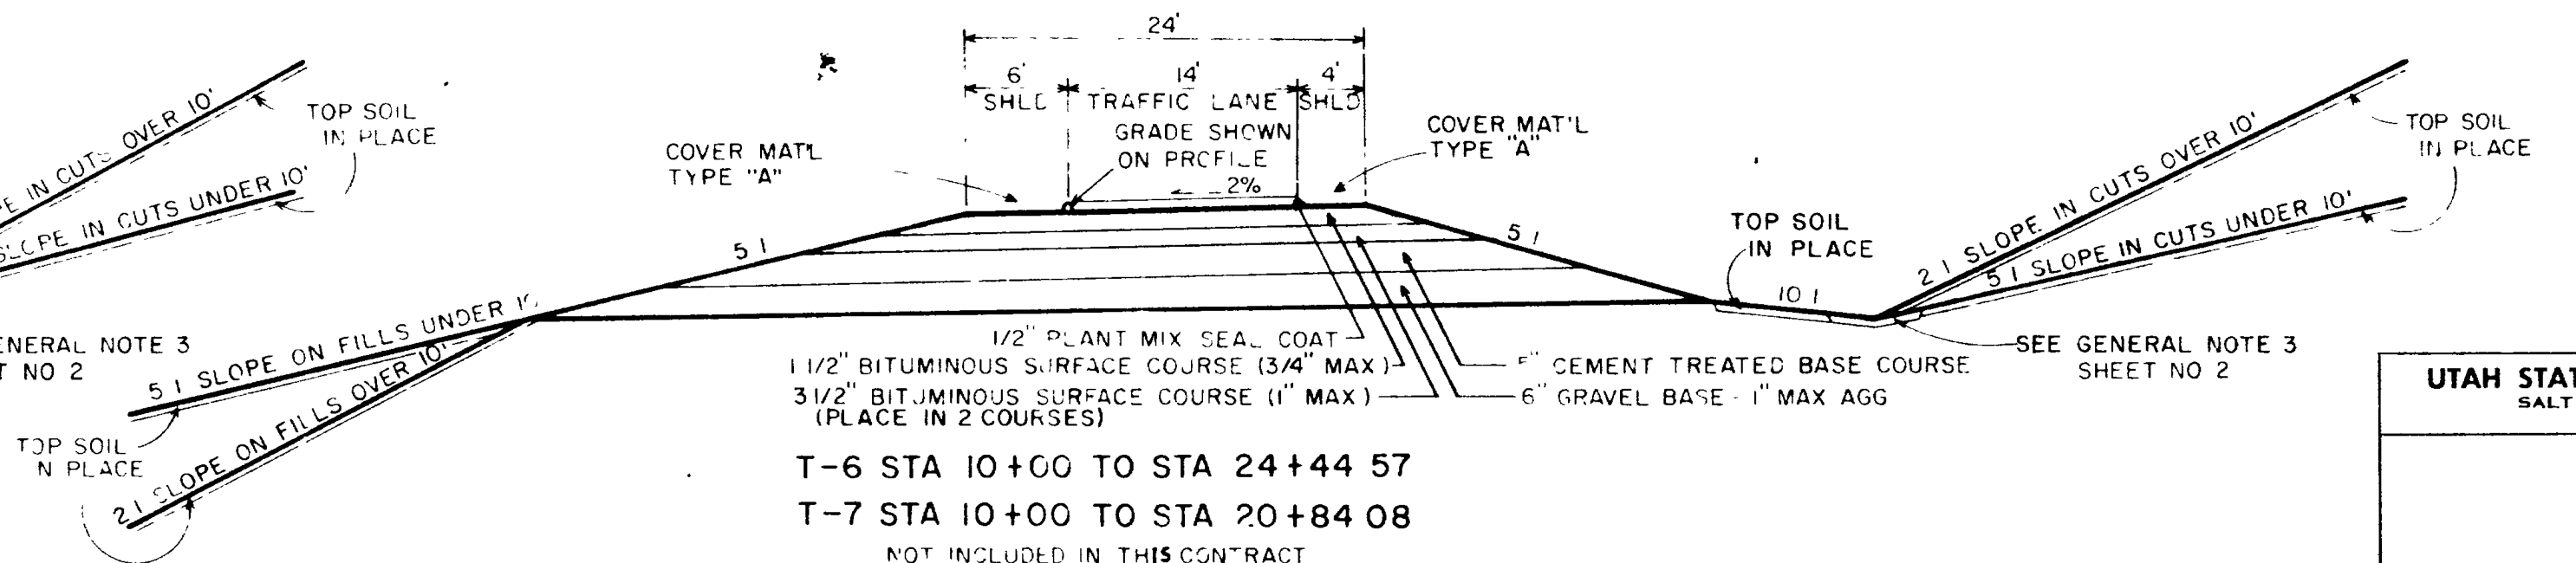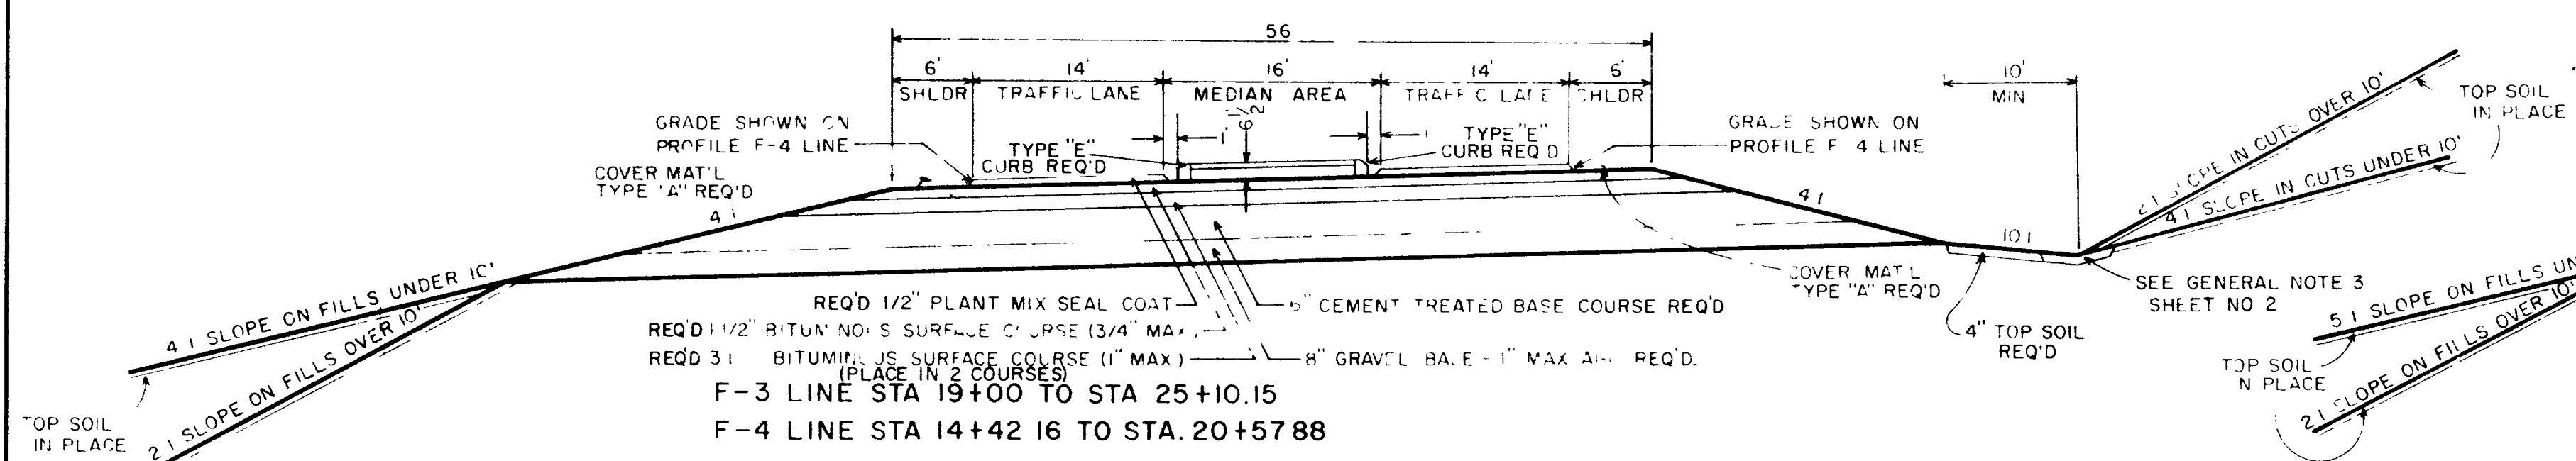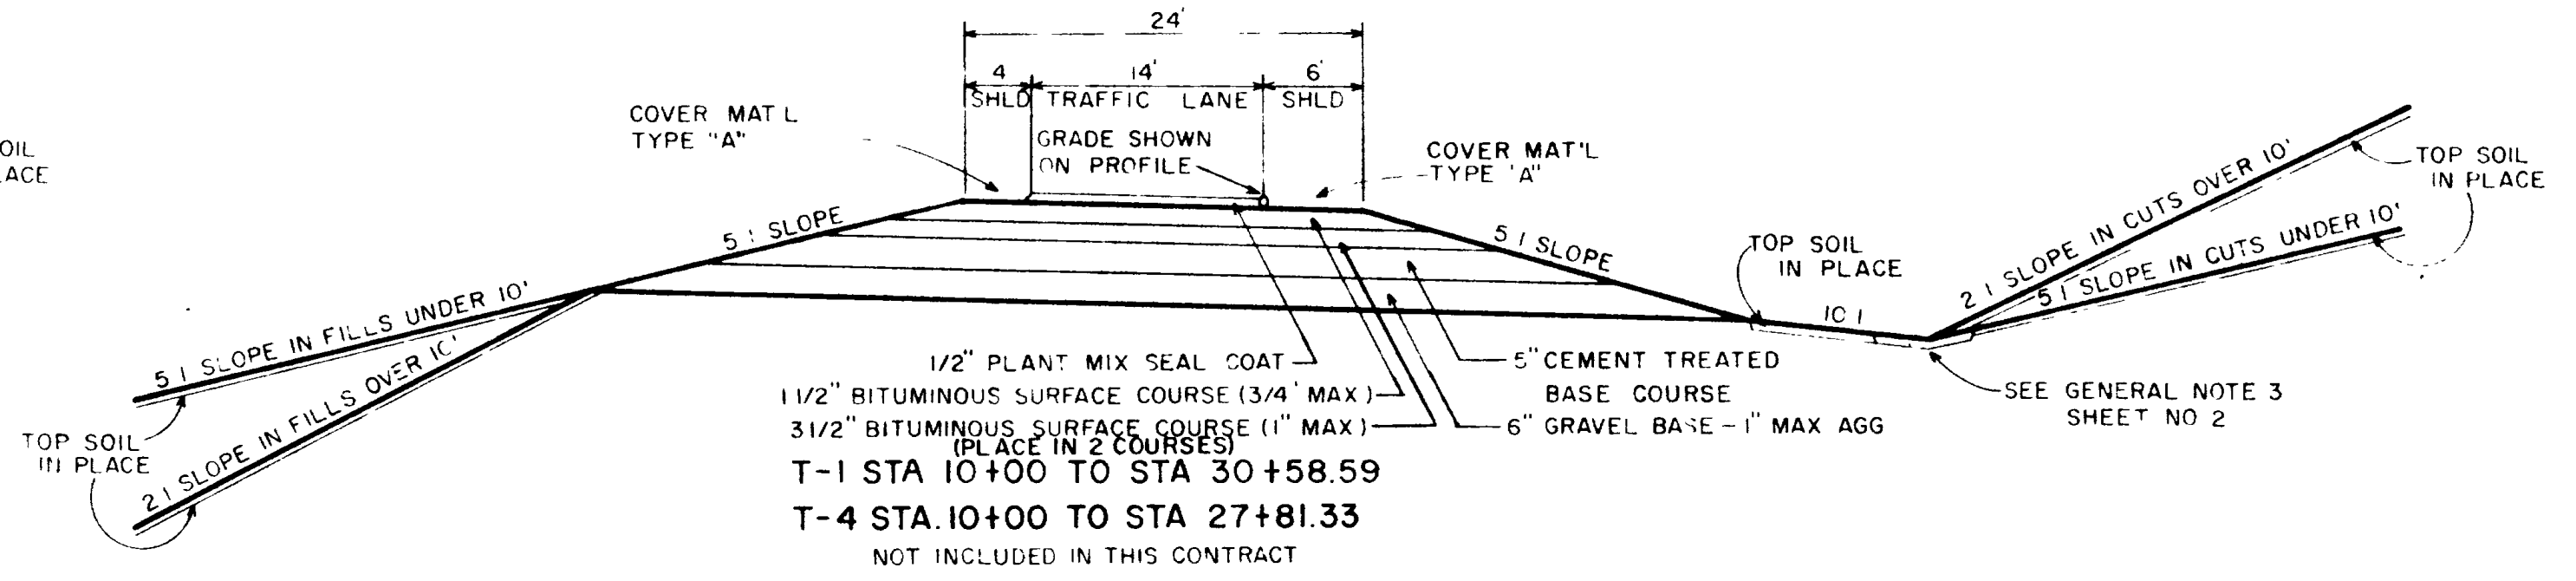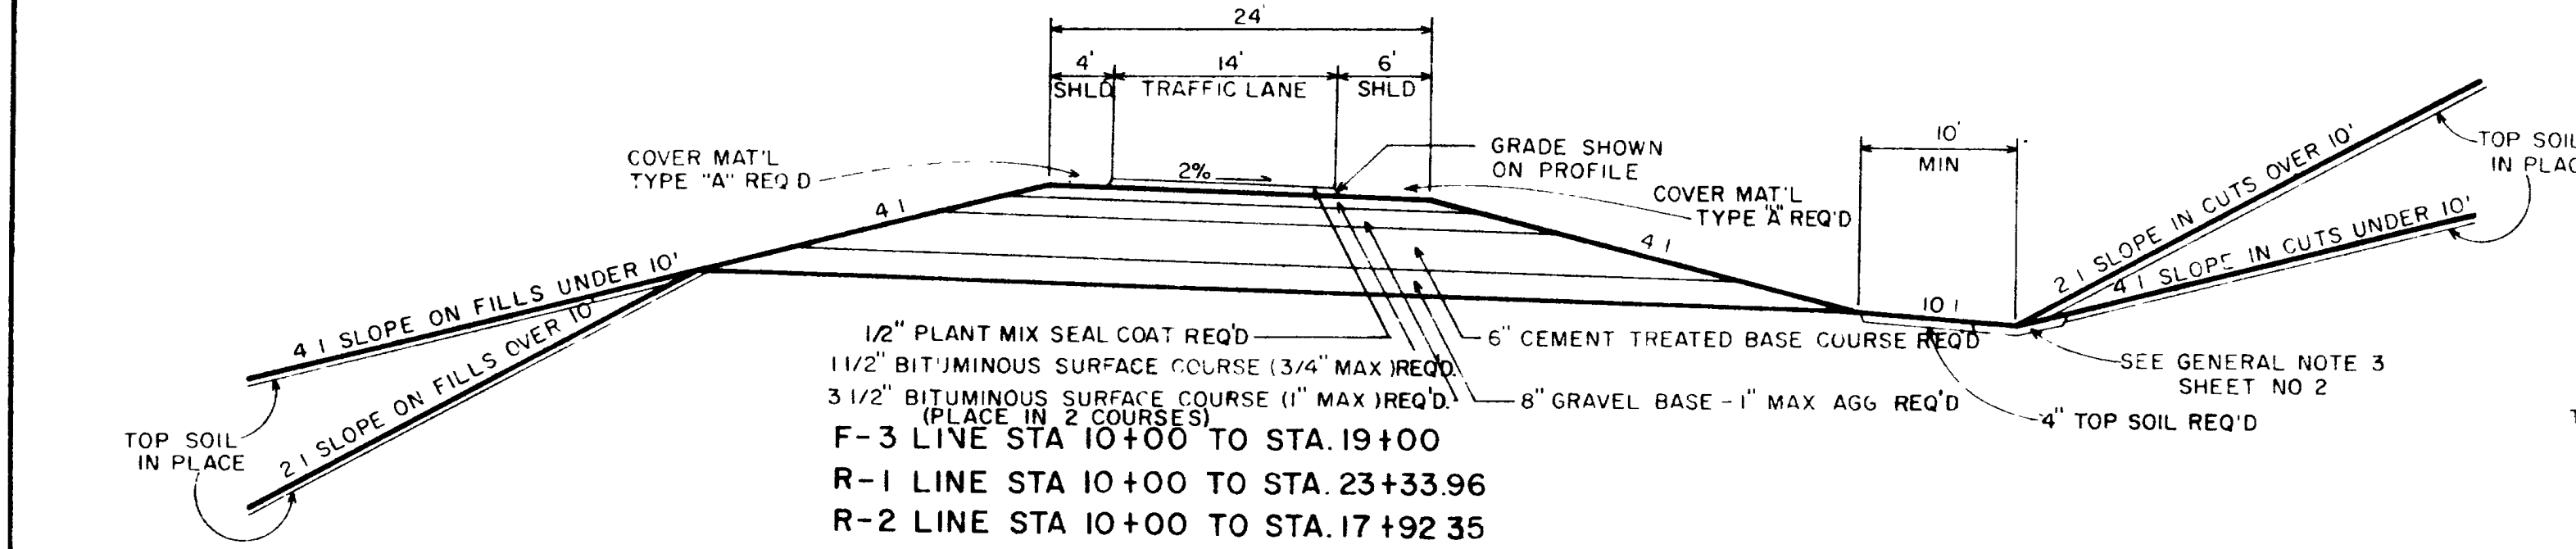


SHOULDER DRAIN

- 1 SHOULDER DRAIN SHALL BE PLACED IN CONJUNCTION WITH BITUMINOUS ROLLED GUTTER TO PREVENT EROSION OF THE FILL SLOPES
- 2 WHEN DRAINS ARE PLACED AT INTERMEDIATE POINTS ON A GRADE, A 45° ELBOW SHALL BE USED TO PROVIDE A MORE DIRECT ENTRANCE
- 3 THE BITUMINOUS ROLLED GUTTER AND SURFACING SHALL BE TRANSITIONED TO PROVIDE A GOOD ENTRANCE CONDITION. THE ENTRANCE SHALL BE LOWED A MINIMUM OF 3" BELOW NORMAL GUTTER FLOWLINE
- 4 SPACING SHALL BE DETERMINED FROM THE PLAN SHEETS UNLESS OTHERWISE DIRECTED BY THE PROJECT ENGINEER
- 5 A BITUMINOUS DIKE SHALL BE PLACED ACROSS THE BITUMINOUS ROLLED GUTTER TO DIRECT THE DRAINAGE INTO THE SHOULDER DRAIN.
- 6 SHOULDER DRAIN INLET SHALL BE A STANDARD METAL END SECTION WITH 1/2" STEEL BARS BOLTED OR WELDED ON 5" CENTERS AS PER STD DWG NO. 347
- 7 RIPRAP SHALL BE PLACED IN A FANSHAPED HOLE ONE FOOT DEEP, REQUIRING 200 CU YD PER END SEC

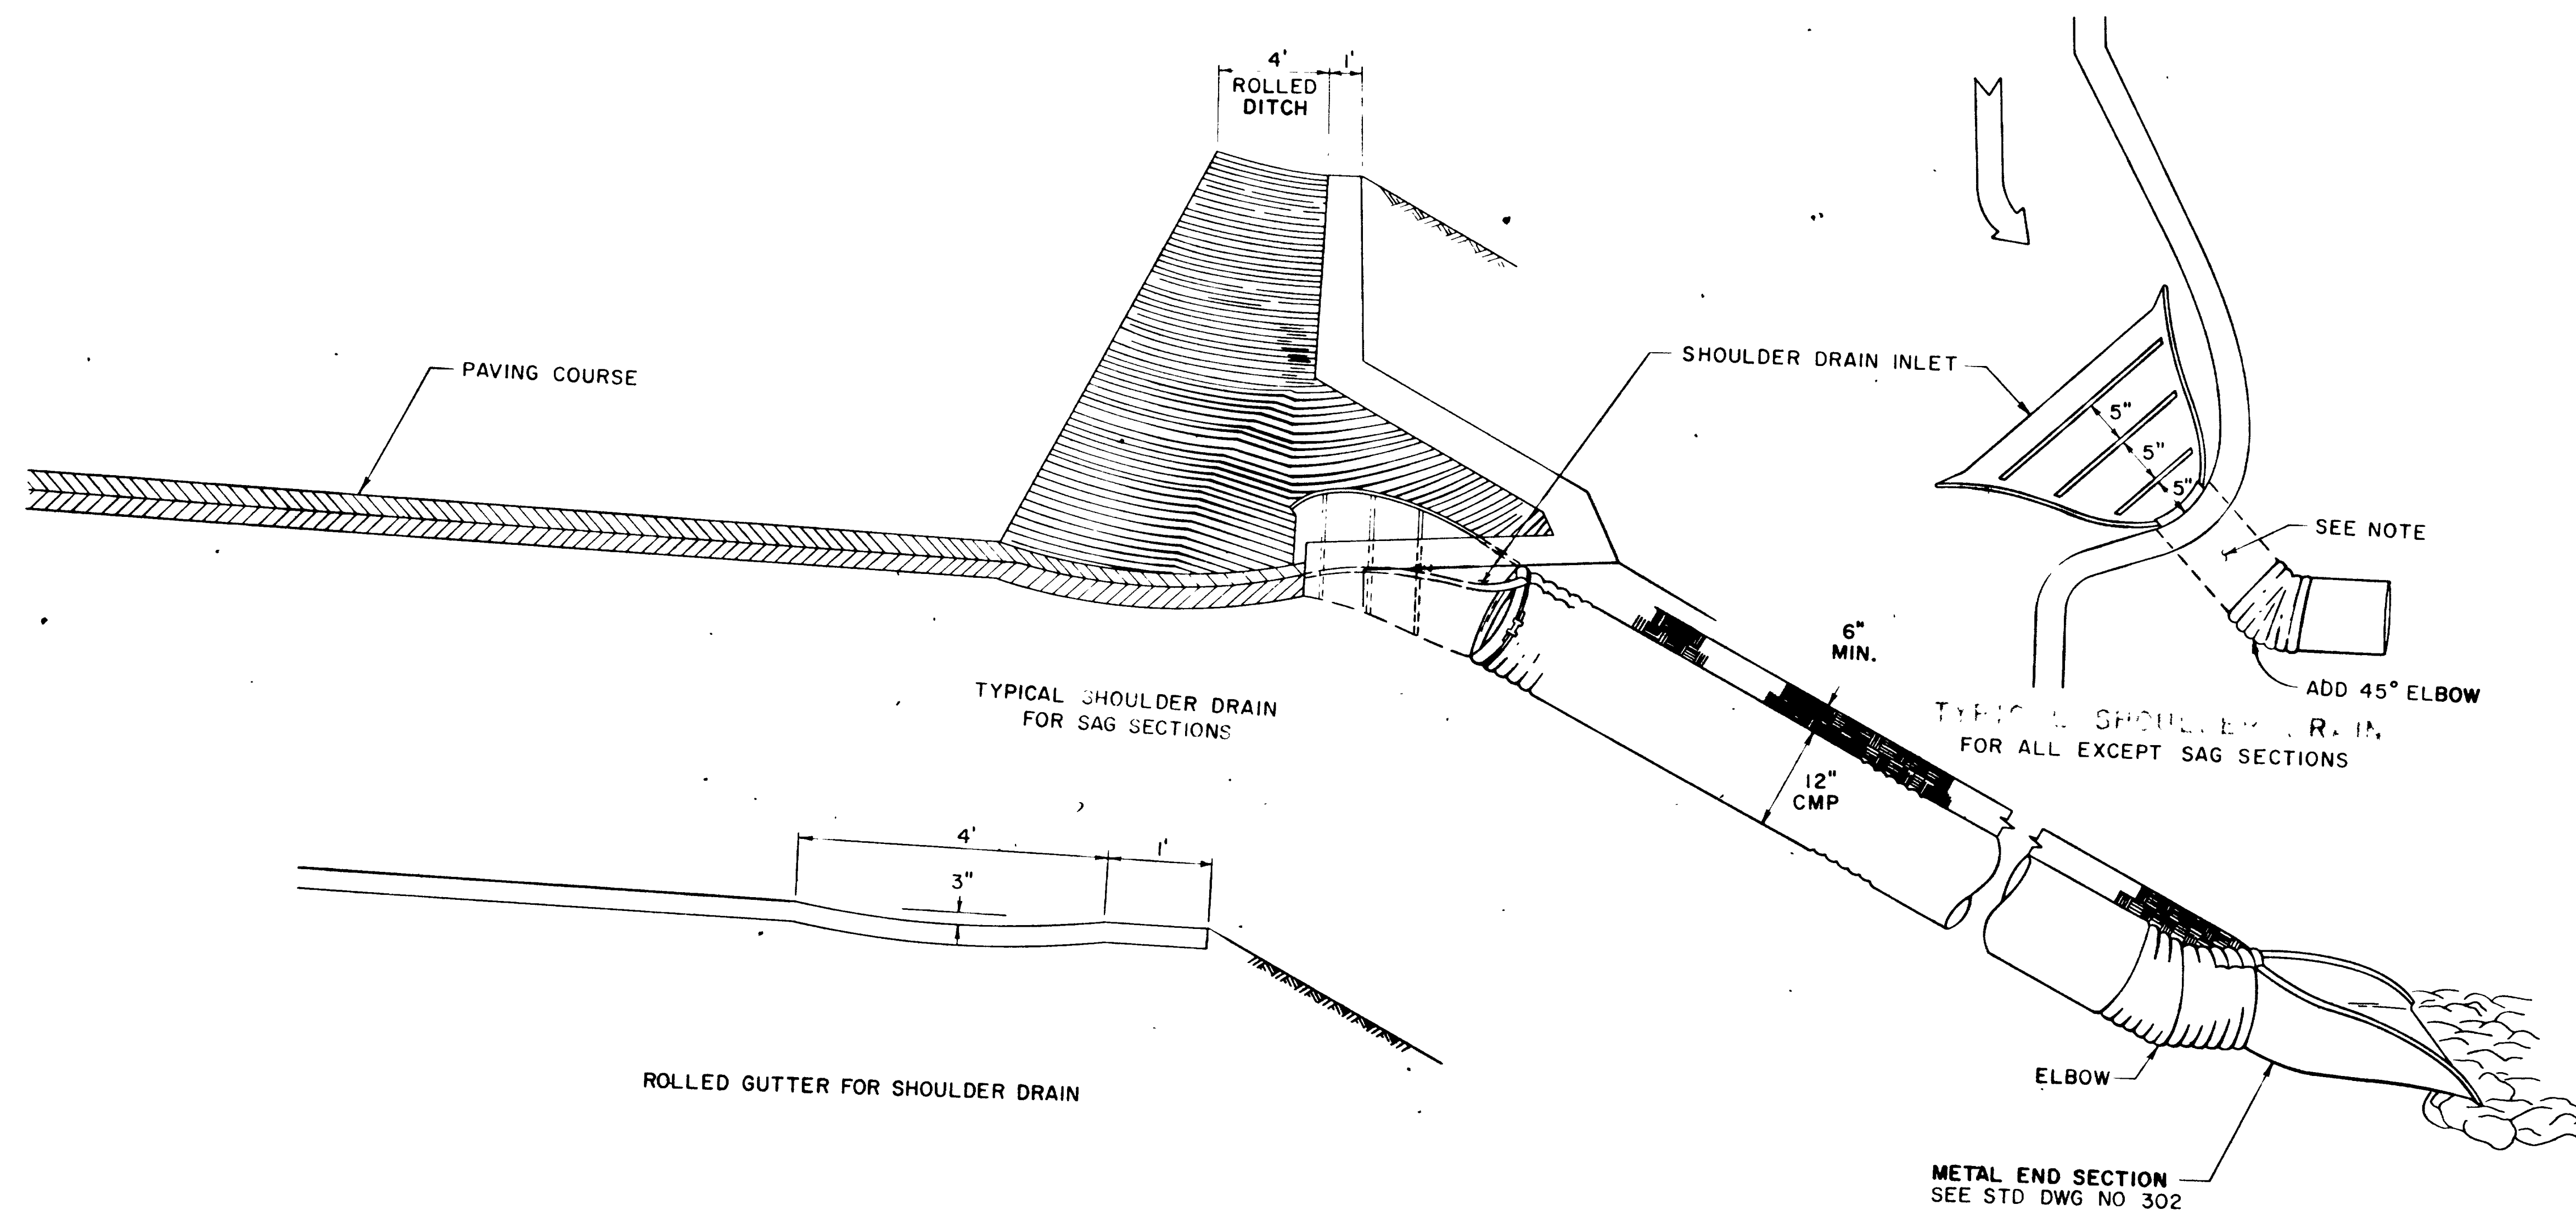



GENERAL NOTE
FOR LOCATIONS OF BITUMINOUS ROLLED
GUTTER SEE SHEET NO 3 AND
SHOULDER DRAINS, SEE SUMMARY SHEET 3B

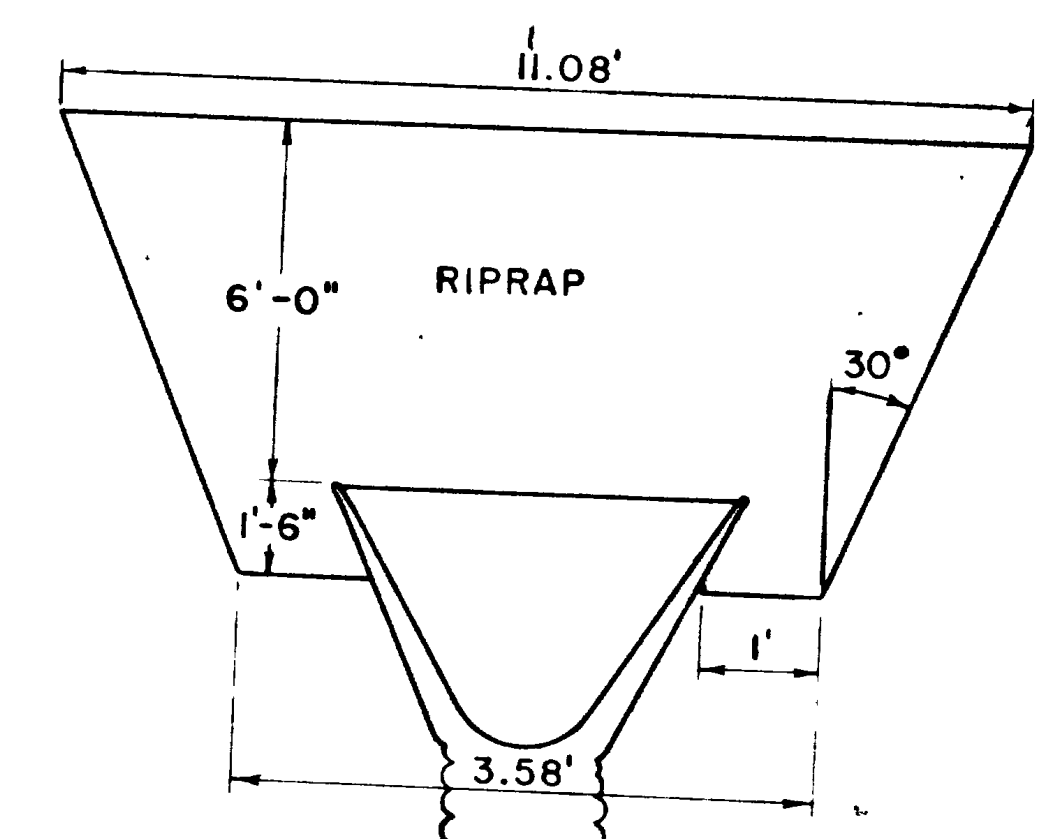


SLOPE PROTECTION FOR MAJOR STRUCTURES DETAIL FOR STATIONS SEE SUMMARY SHEET NO. 3C

FED. ROAD DIST. NO.	STATE	PRJ. NO.	SHEET NO.	TOTAL SHEETS
UTAH	UTAH	81211334	20	


REV. DATE 3 12 65

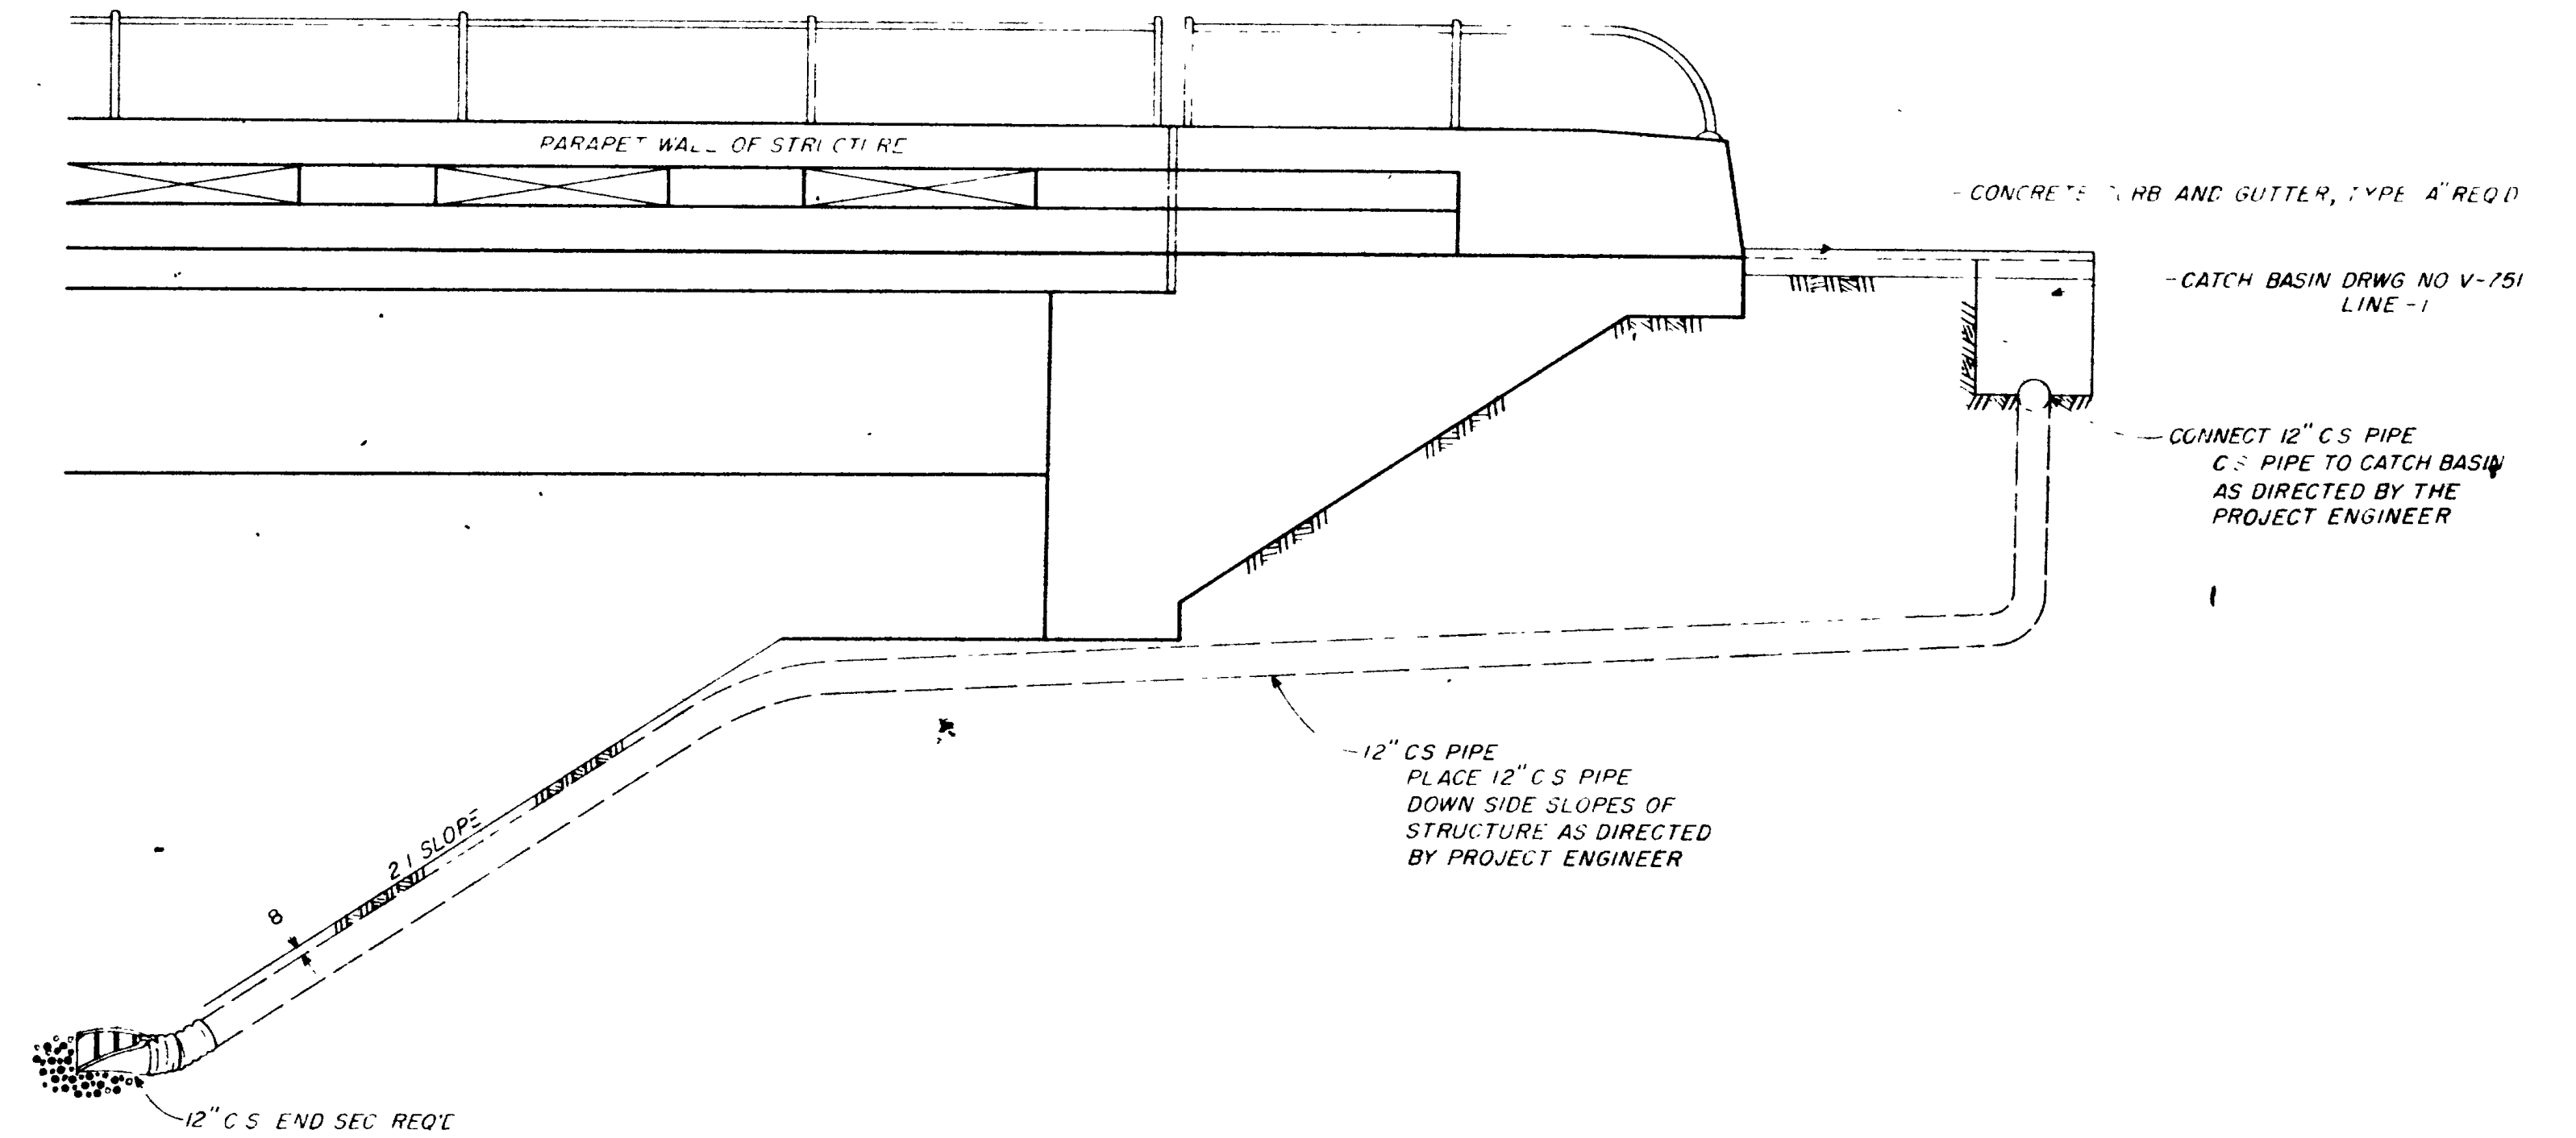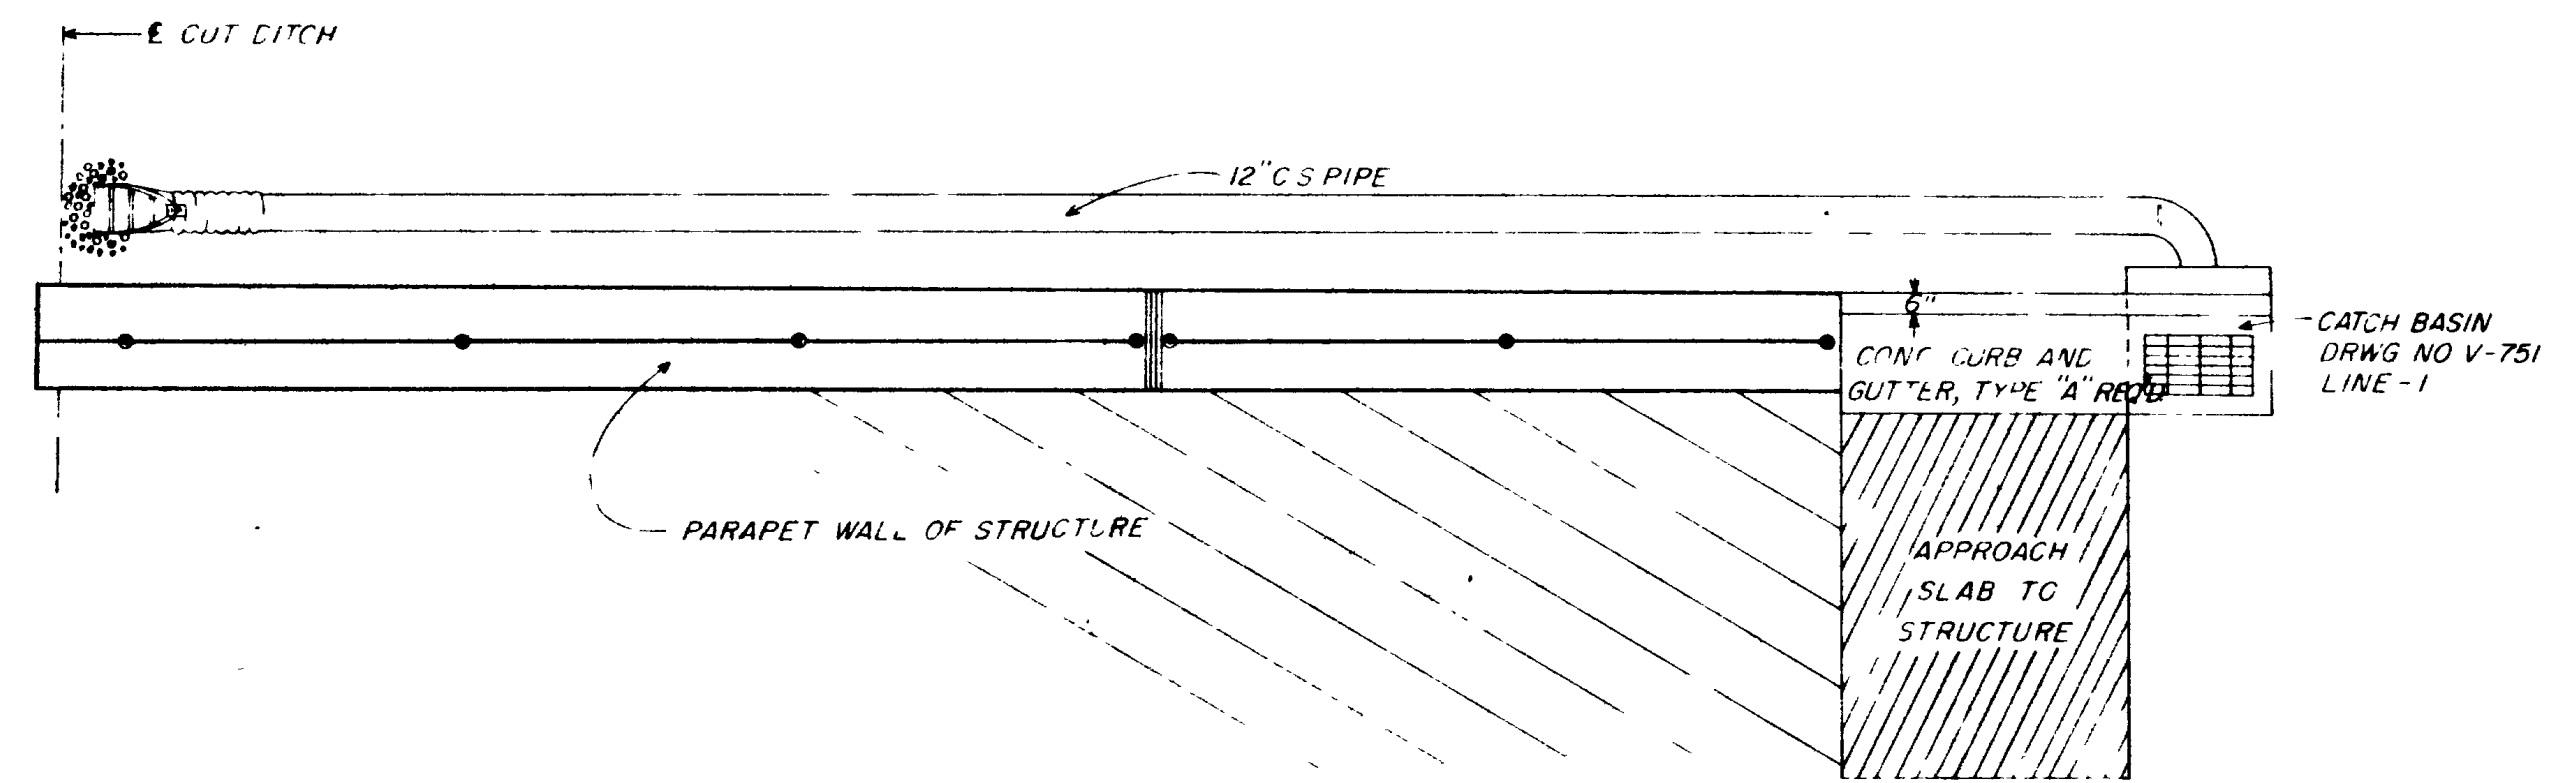

REVISIONS	DATE	BY


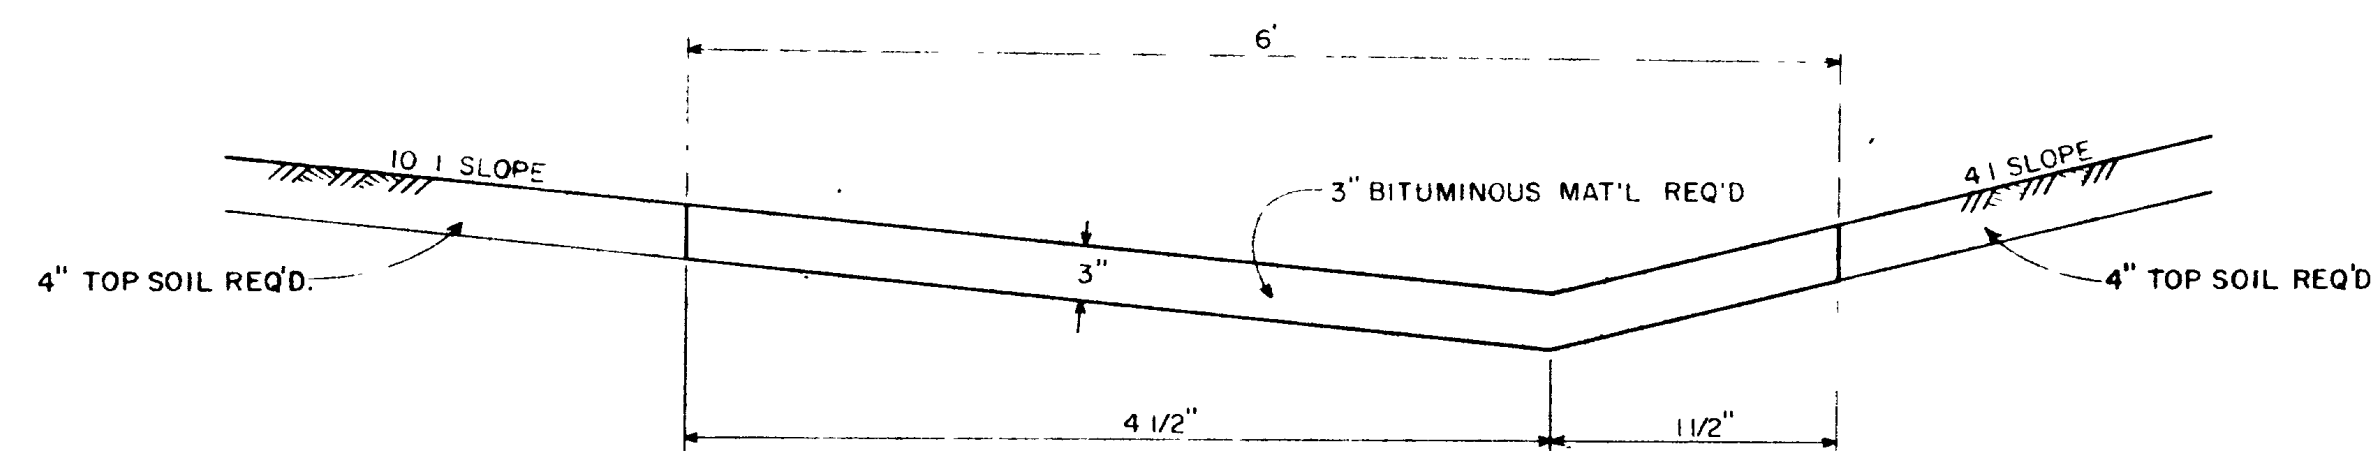


TYPICAL SECTION FOR PAVED CUT DITCH
FOR PLACING OF PAVED CUT DITCH
SEE SUMMARY SHEET NO. 3
FOR BITUMINOUS MATERIAL QUANTITIES
SEE SURF. SUM SHEET NO. 3A

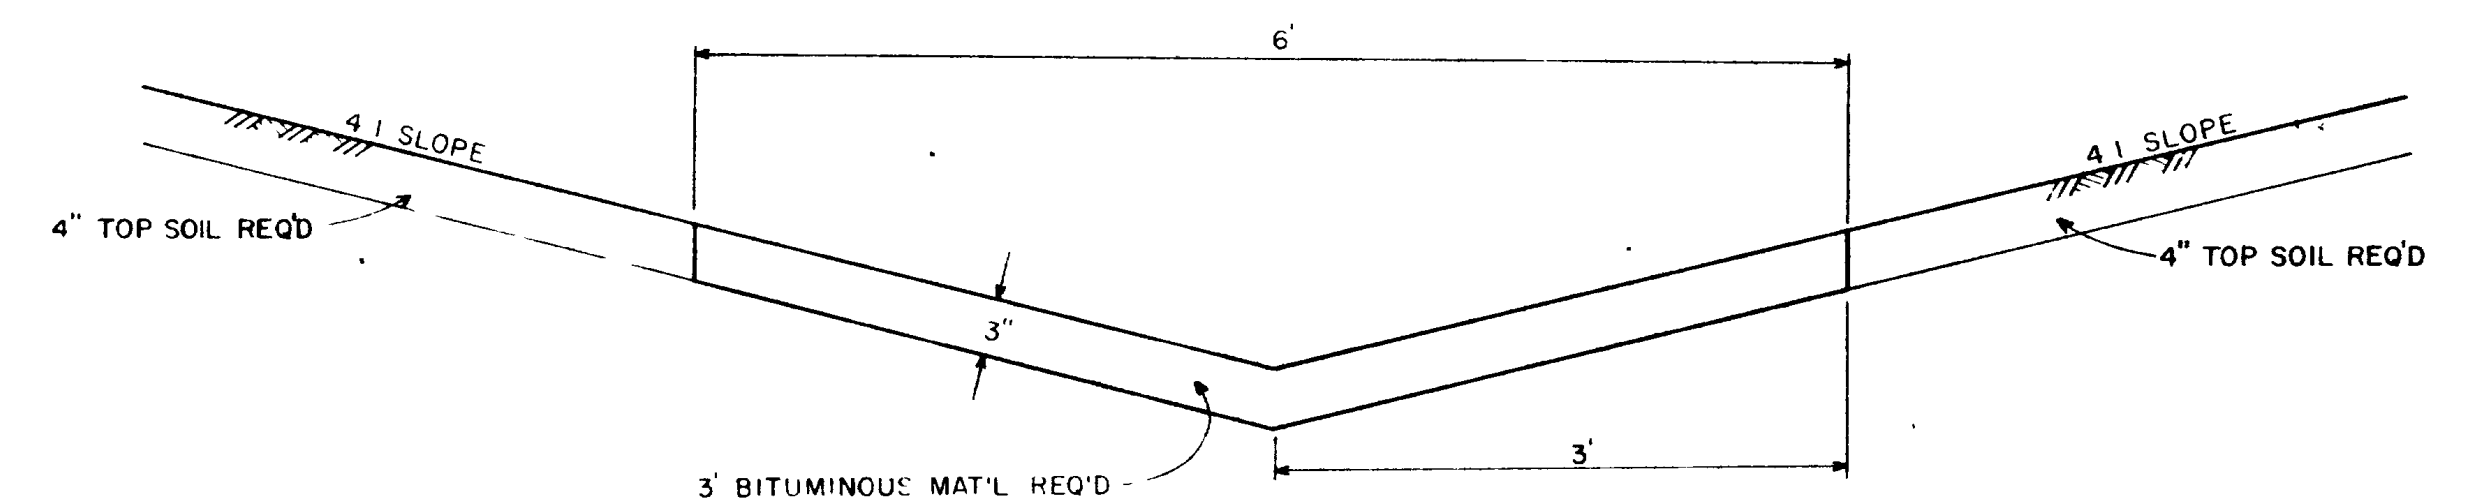

TYPICAL SECTION FOR PAVED MEDIAN DITCH
FOR PLACING OF PAVED MED DITCH
SEE SUMMARY SHEET NO. 3



PER. GOOD SUP. NO.	STATE	PROD. NO.	ENTRY NO.	TOTAL ENTRIES
UTAH	UTAH	1-15-8(21)334	28	

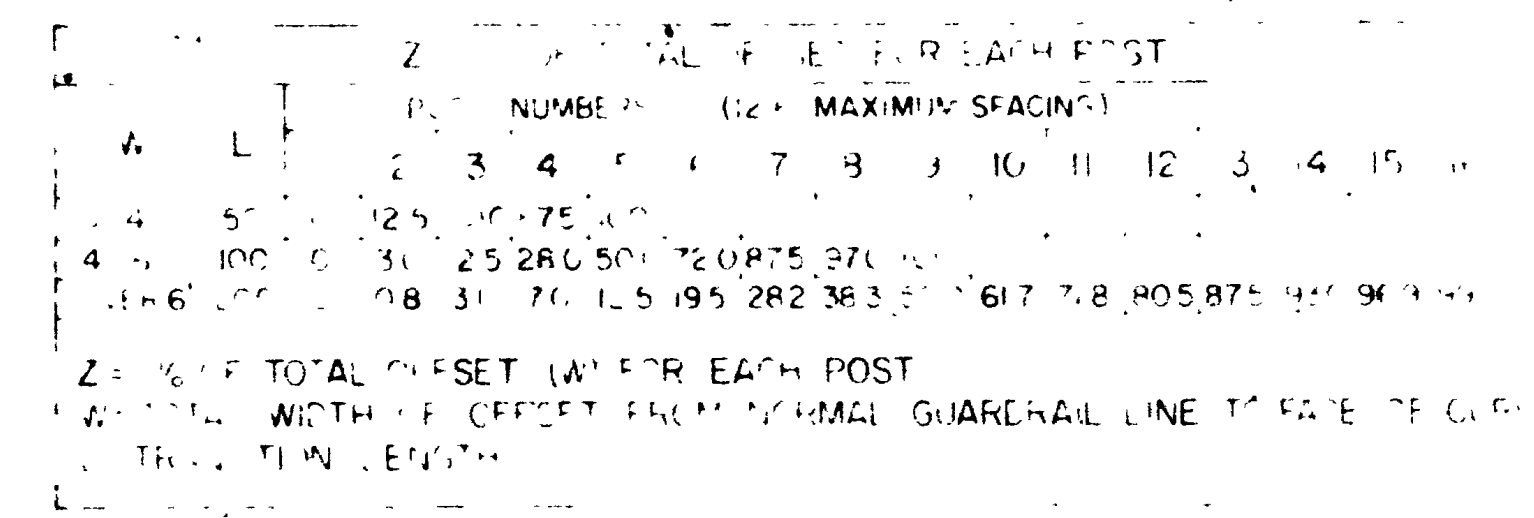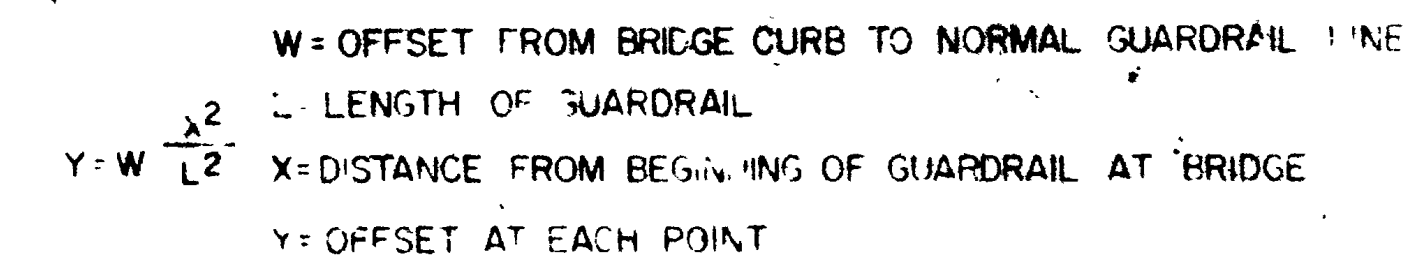


TYPICAL STRUCTURE APPROACH INSTALLATION

TWO WAY STRUCTURE


ONE WAY STRUCTURE

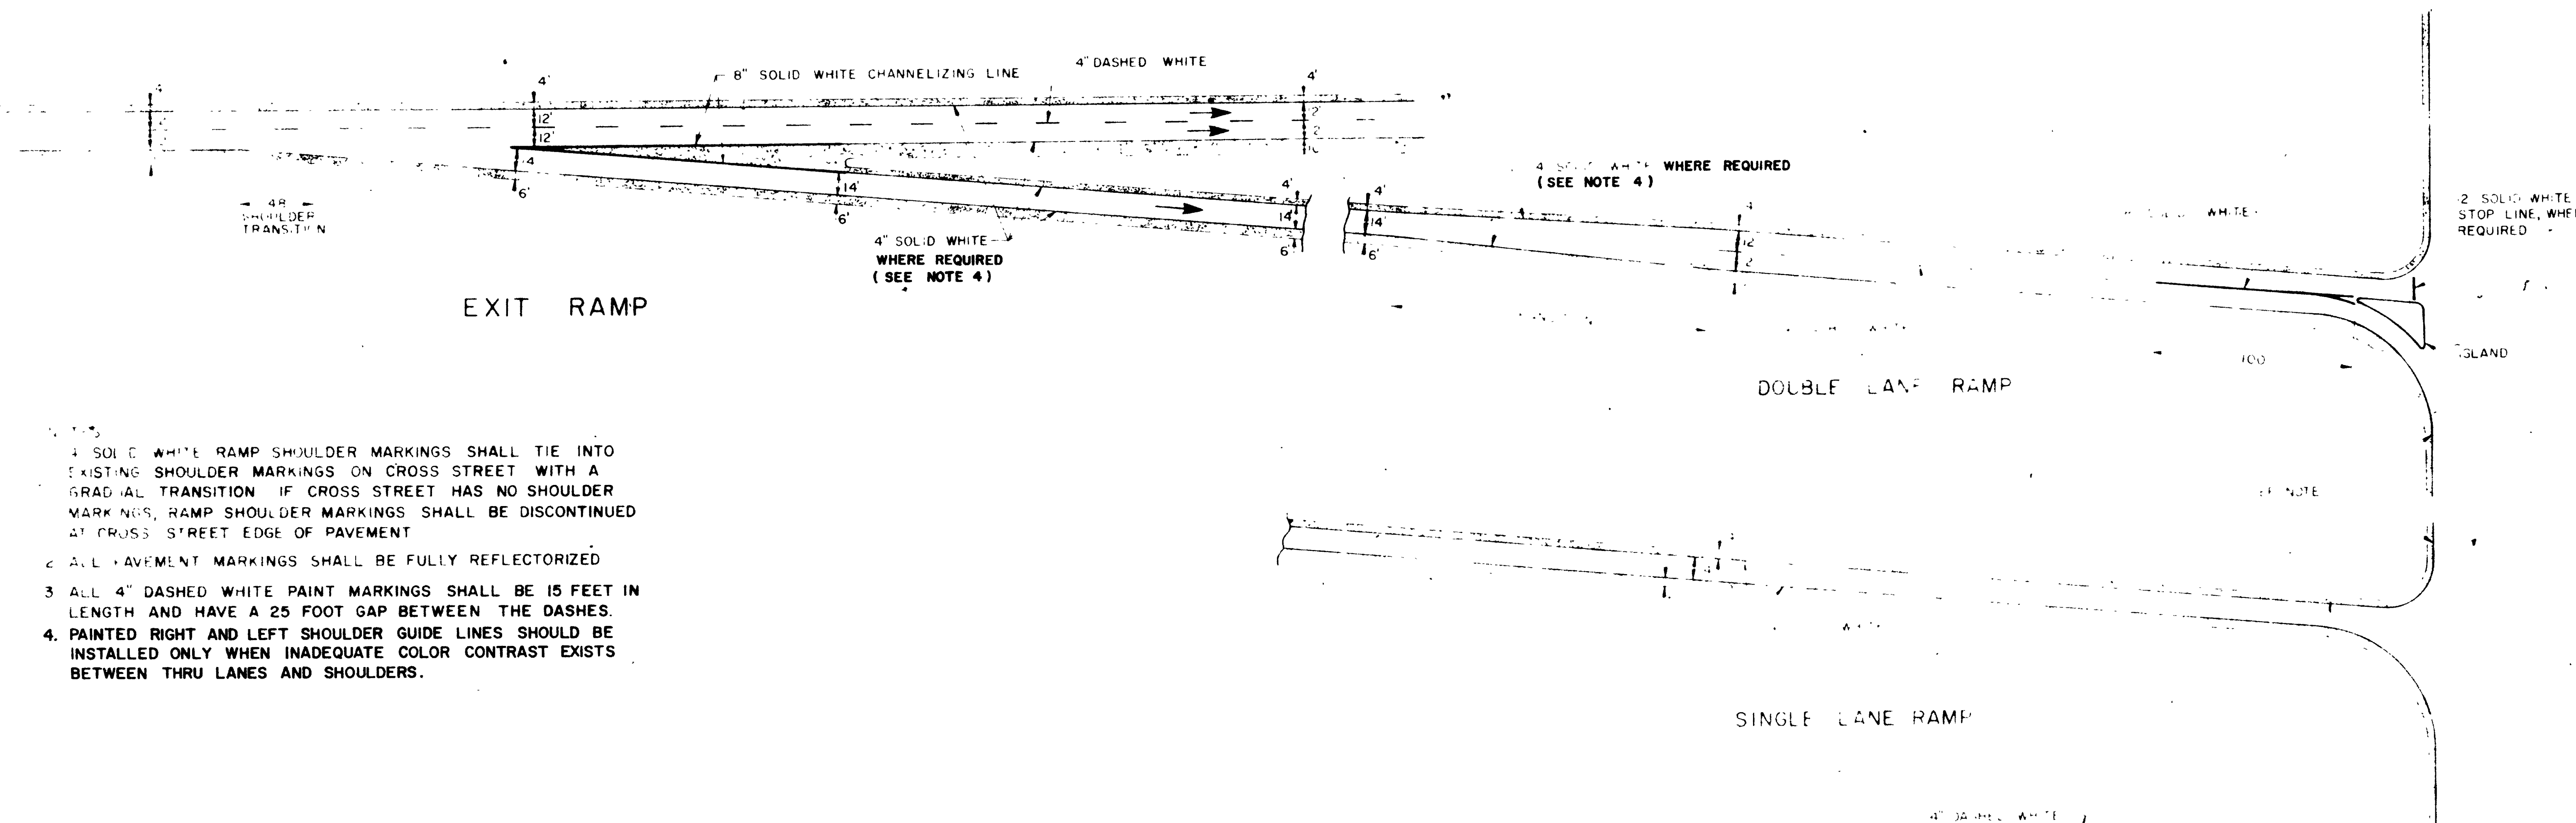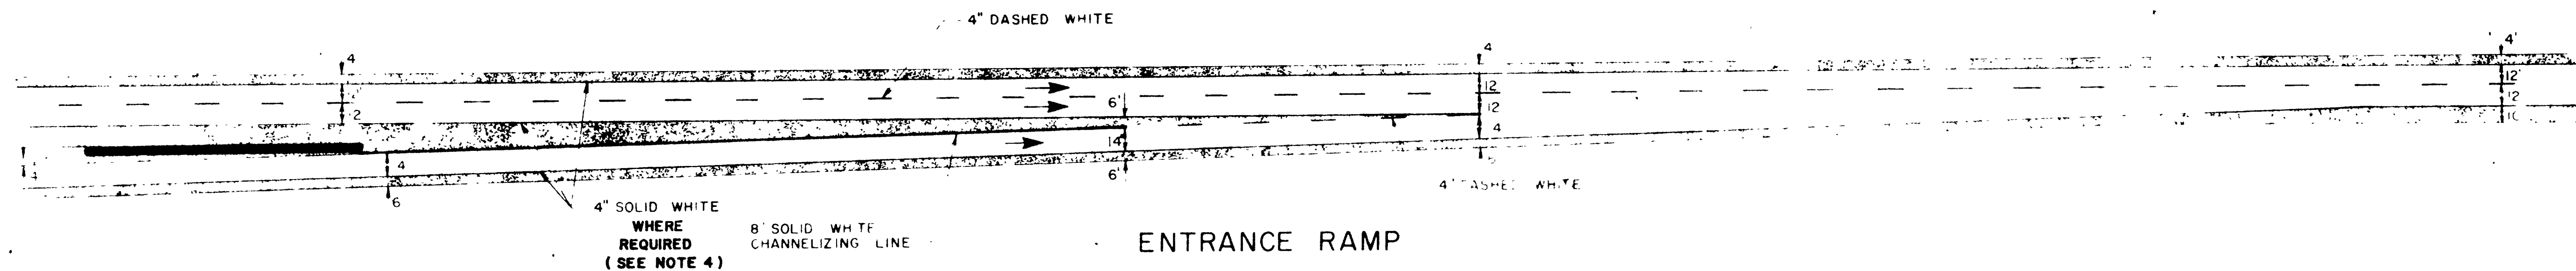


1. SOLID WHITE RAMP SHOULDER MARKINGS SHALL TIE INTO EXISTING SHOULDER MARKINGS ON CROSS STREET WITH A GRADUAL TRANSITION. IF CROSS STREET HAS NO SHOULDER MARKINGS, RAMP SHOULDER MARKINGS SHALL BE DISCONTINUED AT CROSS STREET EDGE OF PAVEMENT.
2. ALL PAVEMENT MARKINGS SHALL BE FULLY REFLECTORIZED.
3. ALL 4" DASHED WHITE PAINT MARKINGS SHALL BE 15 FEET IN LENGTH AND HAVE A 25 FOOT GAP BETWEEN THE DASHES.
4. PAINTED RIGHT AND LEFT SHOULDER GUIDE LINES SHOULD BE INSTALLED ONLY WHEN INADEQUATE COLOR CONTRAST EXISTS BETWEEN THRU LANES AND SHOULDERS.

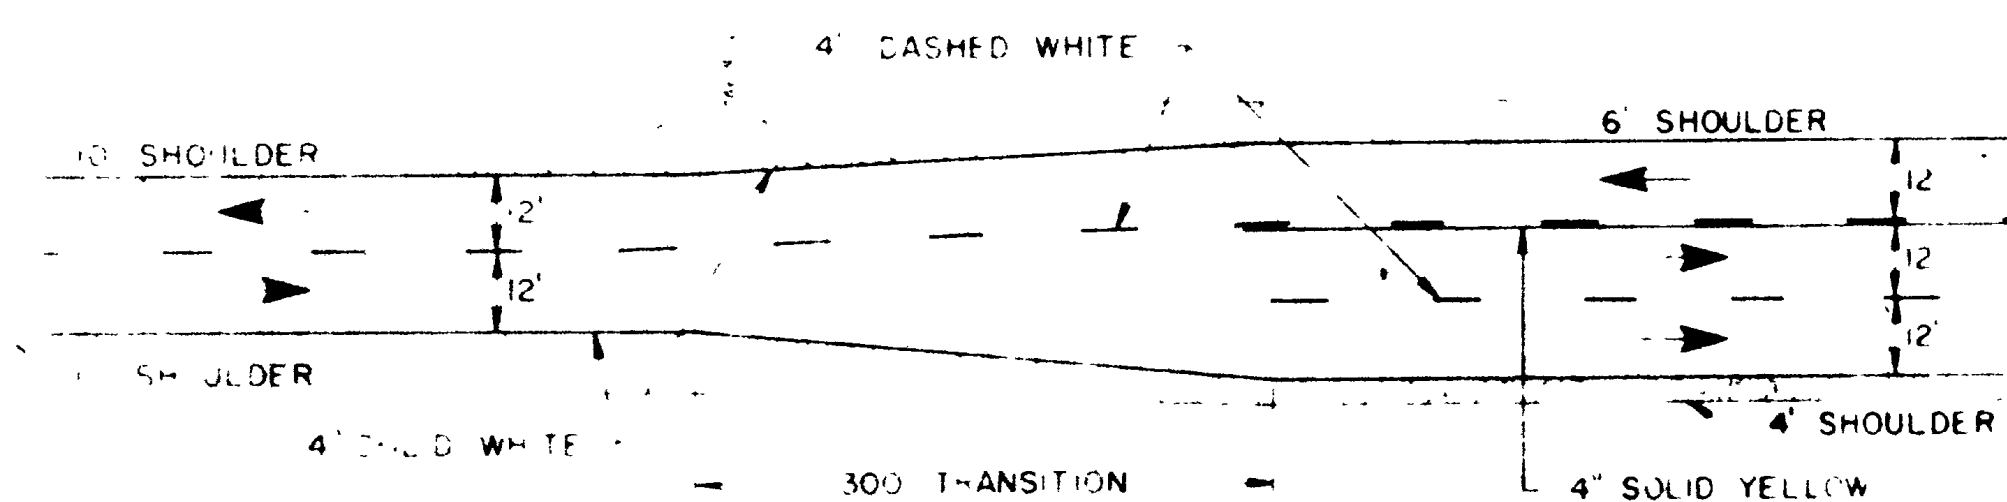


TWO LANE, TWO WAY, WITH TRUCK LANE

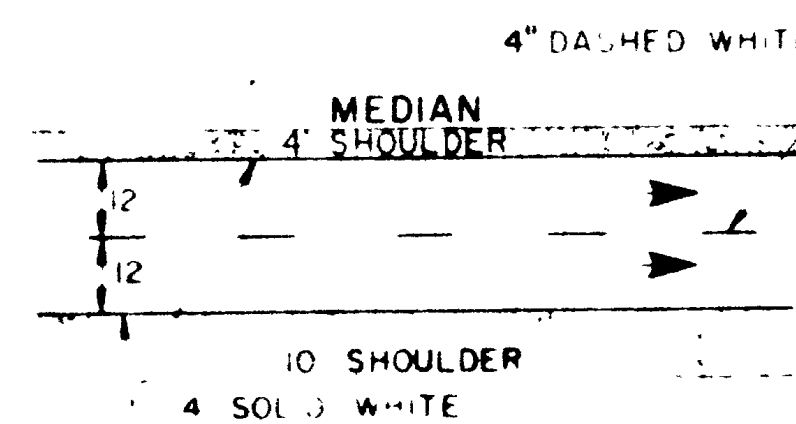

TWO LANES

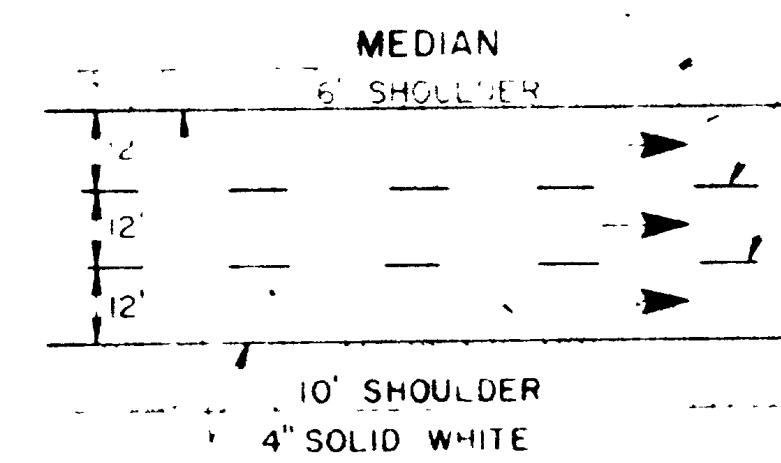

THREE LANES

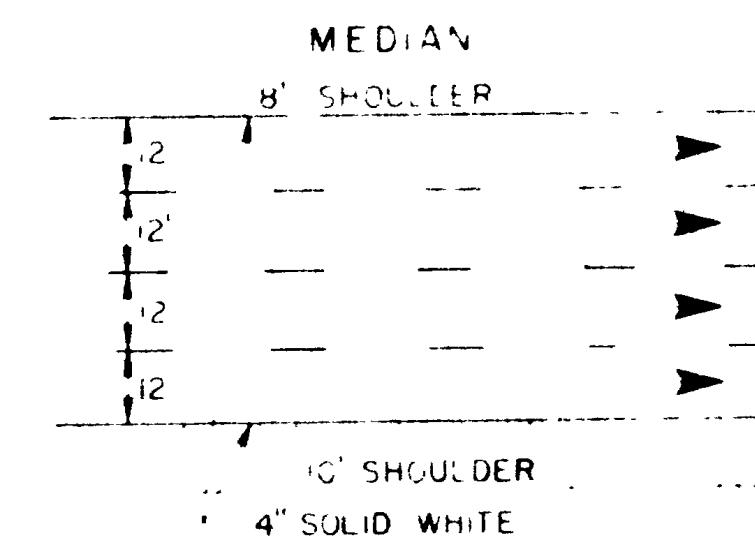

FOUR LANES

ROADWAY SECTION

UTAH DEPARTMENT OF HIGHWAYS

TYPICAL PAVEMENT MARKINGS
 INTERSTATE SYSTEM

SUPERSEDES
 REVISIONS
 Date Appr

APPROVED BY: _____

STD. DWG. NO.

SMALL STRUCTURES AND PIPE SUMMARY																						
LINE	STATION	12 CSP		12 CSP PERF		18 CSP		18 CSP PERF		24 RCP		12 END SECT	18 END SECT	24 END SECT	BOX DWG & LINE NO	REINF STEEL LBS	STRUC STEEL LBS	CLASS A CON (AB) CUYD	STRUCT EXC CUYD	RIP RAP CUYD	REMARKS	
		L	T	L	T	L	T	L	T	L	T	L	T	L	T	L	T	L	T	L		T
		FT	FT	FT	FT	FT	FT	FT	FT	FT	FT	FT	FT	FT	FT	FT	FT	FT	FT	FT		FT
5600 SO	NE COR STRUCT		56.0									1			V 751 - 2	184	310	1.8	17.30	00	SLOPE PROTECTION	
	NWCOR		58.0									1			V 751 - 2	184	310	1.8	24.18	00	" "	
	SW COR		80.0									1			V 751 - 3	220	310	19	2100	00	" "	
	SE COR		57.0									1			V 751 - 2	184	310	1.8	22.10	00	" "	
RAILROAD	SW COR STRUC		49.0									1			V 751 - 2	184	310	1.8	14.50	00	" "	
	NE COR		59.0									1			V 751 - 2	184	310	1.8	17.70	2.0	" "	
	NW COR		130.0									1			V 751 - 2	184	310	1.8	45.60	2.0	" "	
RIVERDALE ROAD	SE COR		33.0									1			V 751 - 2	184	310	1.8	15.75	2.0	" "	
	NE COR		39.0									1			V 751 - 2	184	310	1.8	18.30	2.0	" "	
	SW COR		49.0									1			V 751 - 2	184	310	1.8	25.90	2.0	" "	
F 5 LINE															V 750 - 1	181	310	1.3	5.20	00		
5600 SO	SW COR STRUC					56.0						1							11.40	00		
R 9 LINE						210.0													72.30	00		
I 15	896+00					30 mod.													1.00	00		
I 15	880+00					103.0						2							31.60	00		
F 1	17+82					68.0						2							27.47	1.00		
RIVERDALE ROAD	52 TO 55+00							320.0							V 750 - 2	188	310	1.5	156.8	00		
"															V 750 - 1	181	310	1.3	5.2	00		
"	43+00							86.0							V 750 - 2	188	310	1.5	50.0	00		
UNDER	RR STRUCTURE									44.0									25.5			
I 15	937.90-943.95			600.0											V 777 - 6	244	479	19	319.17	00		
															V 777 - 6	244	479	19	8.0			
I 15	944+00			82.0											V 777 - 5	214	474	1.8	39.4			
I 15	944+00 949+00			500.0															250.0			
I 15	950+00			130.0											V 777 - 5	214	474	1.8	72.8			
I 15	947+00			102.0											V 777 - 5	214	474	1.8	69.20			
I 15	945+50			80.0											V 777 - 5	214	474	1.8	49.70			
I 15	944+00 945+00			120.0											V 777 - 5	214	474	1.8	70.8			
	TOTALS		610.0	1614.0	201.0	2660.0	320.0	86.0	44.0		10	5			4172.0	7468.0	36.5	1488.47	10			

CONCRETE CURB TYPE "E"			
LINE	STATION	STATION	LINE FT
	864.39	866.00	340.4
F 9	95.50	24.55	1122.0
RIVERDALE ROAD	26.00	28.25	457.5
"	31.96.6	43.26	2267.4
"	44.10	54.22	2049.2
R-2	17.25	18.40	114.8
R-1	23.40	27.15	374.7
F 1	11.25		595.5
T 1			329.1
5600 SO			193.8
TOTALS			7844.40

SURFACING

DELETED	BY	W.O.	NO. 1
---------	----	------	-------



① ② ③ ④ ⑤ ⑥ ⑦ ⑧ ⑨ ⑩ ⑪ ⑫ ⑬ ⑭ ⑮ ⑯ ⑰ ⑱ ⑲ ⑳ ㉑ ㉒ ㉓ ㉔ ㉕ ㉖ ㉗ ㉘ ㉙ ㉚ ㉛ ㉜ ㉝ ㉞ ㉟ ㊱ ㊲ ㊳ ㊴ ㊵ ㊶ ㊷ ㊸ ㊹ ㊺ ㊻ ㊼ ㊽ ㊾ ㊿

DELETED BY W.O. N.O. 11

The information on these materials' properties shall in no way be construed as to conflict with "Division I, Section 1.6.2 of Designated Local Materials Sources of the State of Utah Standard Specifications, 1960 Edition and Supplements,"

Ground Water Table (GWT) =  ,  = Test Hole
Bottom of Test Hole = * , () = Section No.
Section Line (S) = _____
1/4 Section Line = _____
1/8 Section Line = _____
E Proposed Highway = _____
Prospect Boundary = _____
Property Boundary = _____

REVISED 6/2/64

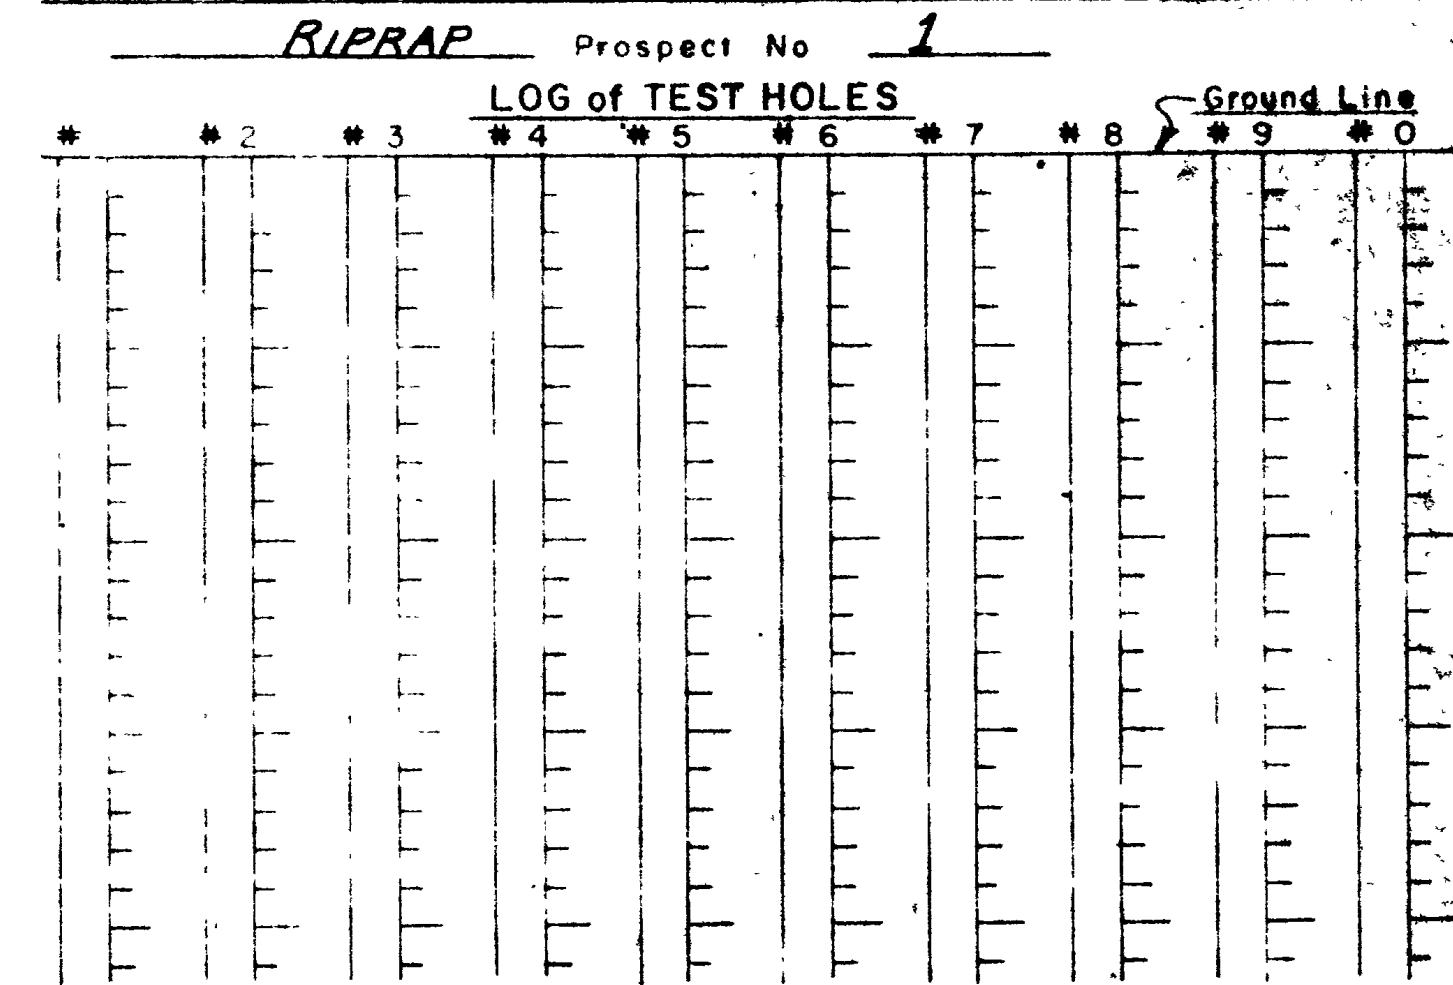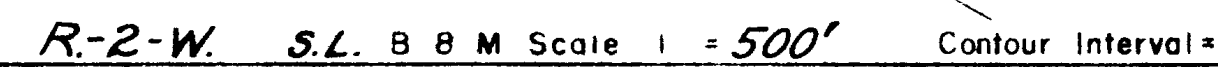

FOR INFORMATION ONLY
This information is not a part of the contract and shall not be construed so as to conflict with Division I, Subsection 1-6.2, Designated Local Materials Sources, of the State of Utah Standard Specifications, Edition of 1960.

LEGEND

Ground Water Table = (G.W.T.)

Prospect Boundary

Property Boundary

Section No.

Test Hole

Clay

Silt

Sand


Gravel or Boulders

Solid Rock


UTAH STATE DEPARTMENT OF HIGHWAYS
MATERIALS & RESEARCH DIVISION
MATERIALS PROSPECT & TEST HOLE QUALITY & GRADING DATA
PROJECT NUMBER I-15-8(21)334
PROJECT NAME Davis-Weber County Line
to 31st Street
COUNTY Weber DATE Mar, 1965

FED. ROAD DIST. NO.	STATE	PROJ. NO.	FISCAL YEAR	SHEET NO.	TOTAL SHEETS
UTAH	UTAH			3-F	

These materials were sampled and tested for use as base and surfacing. Scarcity of borrow sources necessitated making them available for use as borrow.

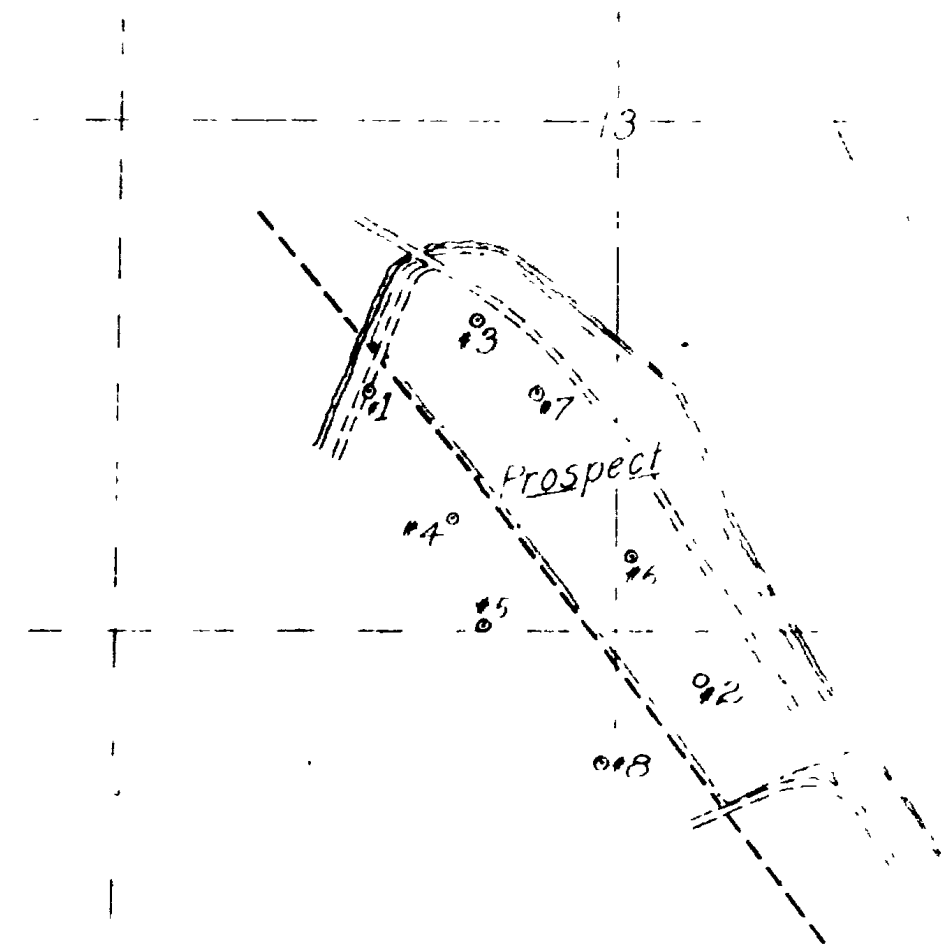



Test Hole Number	757-SA-62 1 0-14'	945-SA-62 2	925-SA-62 3	926-SA-62 3 16'-25'	927-SA-62 3	931-SA-62 4	962-SA-62 5	963-SA-62 6	964-SA-62 7	948-SA-62 8
Struck Analysis:										
Before Crushing										
Passing 3" %		100.0	100.0	100.0	100.0	-	100.0	100.0	100.0	100.0
Passing 1" %		80.6	71.3	78.8	100.0	-	80.1	80.6	68.9	81.4
Passing No. 4 %		58.8	9.3	47.6	96.4	-	67.5	63.2	29.5	38.7
After Crushing										
Passing 1" %		100.0	100.0	100.0	100.0	100.0	100.0	100.0	100.0	100.0
Passing 3/4" %		93.6	73.8	89.1	99.4	100.0	94.3	94.3	88.0	89.2
Passing No. 4 %		63.1	13.1	53.2	96.4	97.0	71.4	66.8	34.7	41.1
Passing No. 10 %		58.6	11.5	50.8	95.8	96.3	68.9	63.3	28.9	34.7
Passing No. 200 %		21.8	3.4	18.3	11.0	29.8	17.1	18.4	3.9	3.9
Liquid Limit		18.0	18.9	16.5	18.7	18.6	19.3	18.5	17.2	15.3
Plasticity Index		N.P.	N.P.	N.P.	N.P.	N.P.	N.P.	N.P.	N.P.	N.P.
Swell	.010	.008	.007	.007	.010	.016	.012	.010	.010	.008
L.A. Rattler	18.20	22.00	18.00	22.00	-	-	20.00	22.00	19.80	20.00
F.F. Count		52.0	68.0	61.0	-	-	55.0	50.0	53.0	40.0
Sodium Sulfate Loss										
Immersion Compression										
Marshall Stability										
Flow										
P.S. Without Lime										
P.S. With 1% Lime										

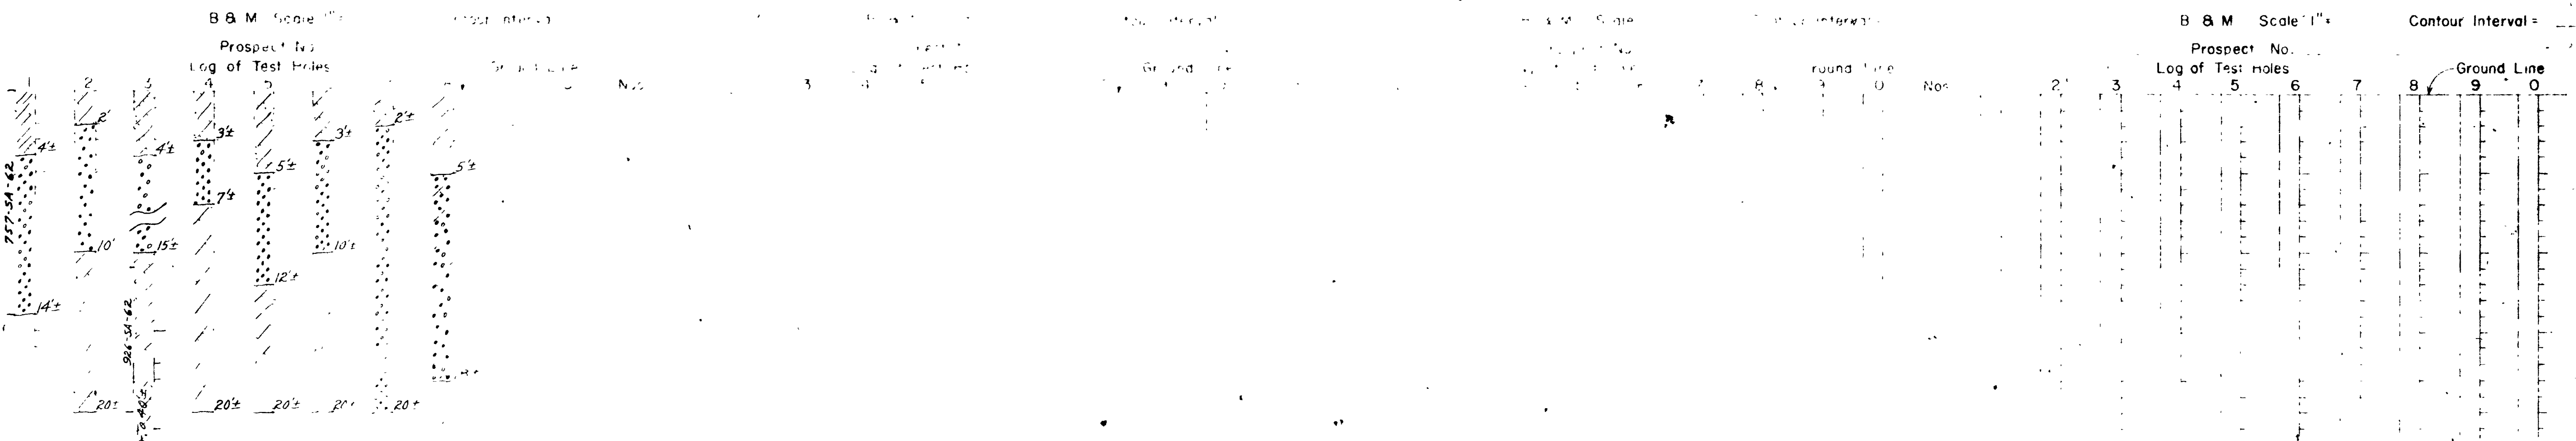


FED. ROAD DIST. NO.	STATE	PROJ. NO.	SHEET NO.	TOTAL SHEETS
UTAH	UTAH	I-15-8(21) 334	4	

REV. DATE: 3/10/65

NOTE:
8" C.S.P. CASINGS AT VARIOUS STATIONS AS SHOWN ON SUMMARY SHEET TO BE USED ON LANDSCAPING CONTRACT TO CASE WATER LINES. THE ENDS OF THE 8" C.S. CROSSOVER PIPES SHALL NOT EXTEND THROUGH THE CUT OR FILL SLOPES BY 1' BUT SHALL BE PLUGGED AND MARKED FOR FUTURE EASE OF LOCATION.

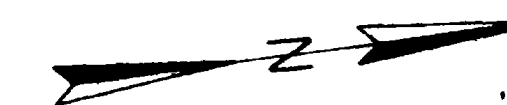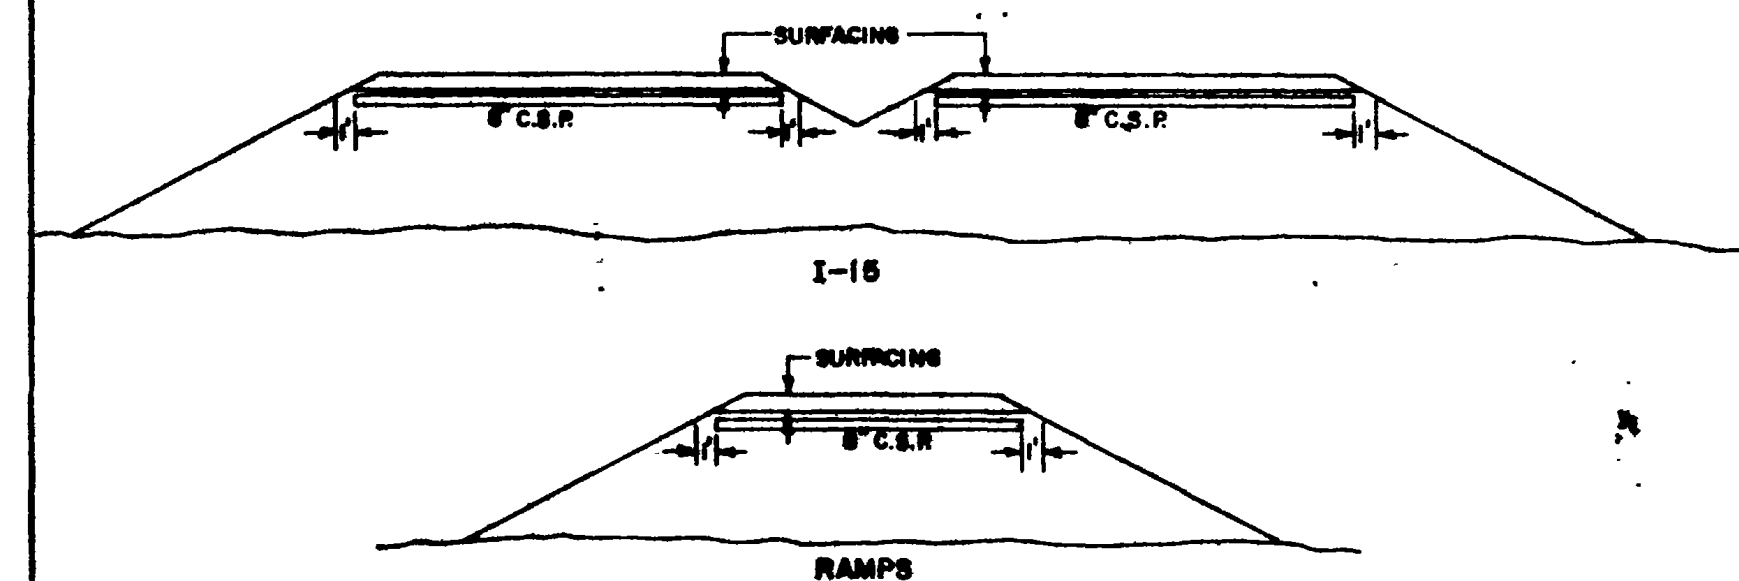

REVISIONS	DATE	BY

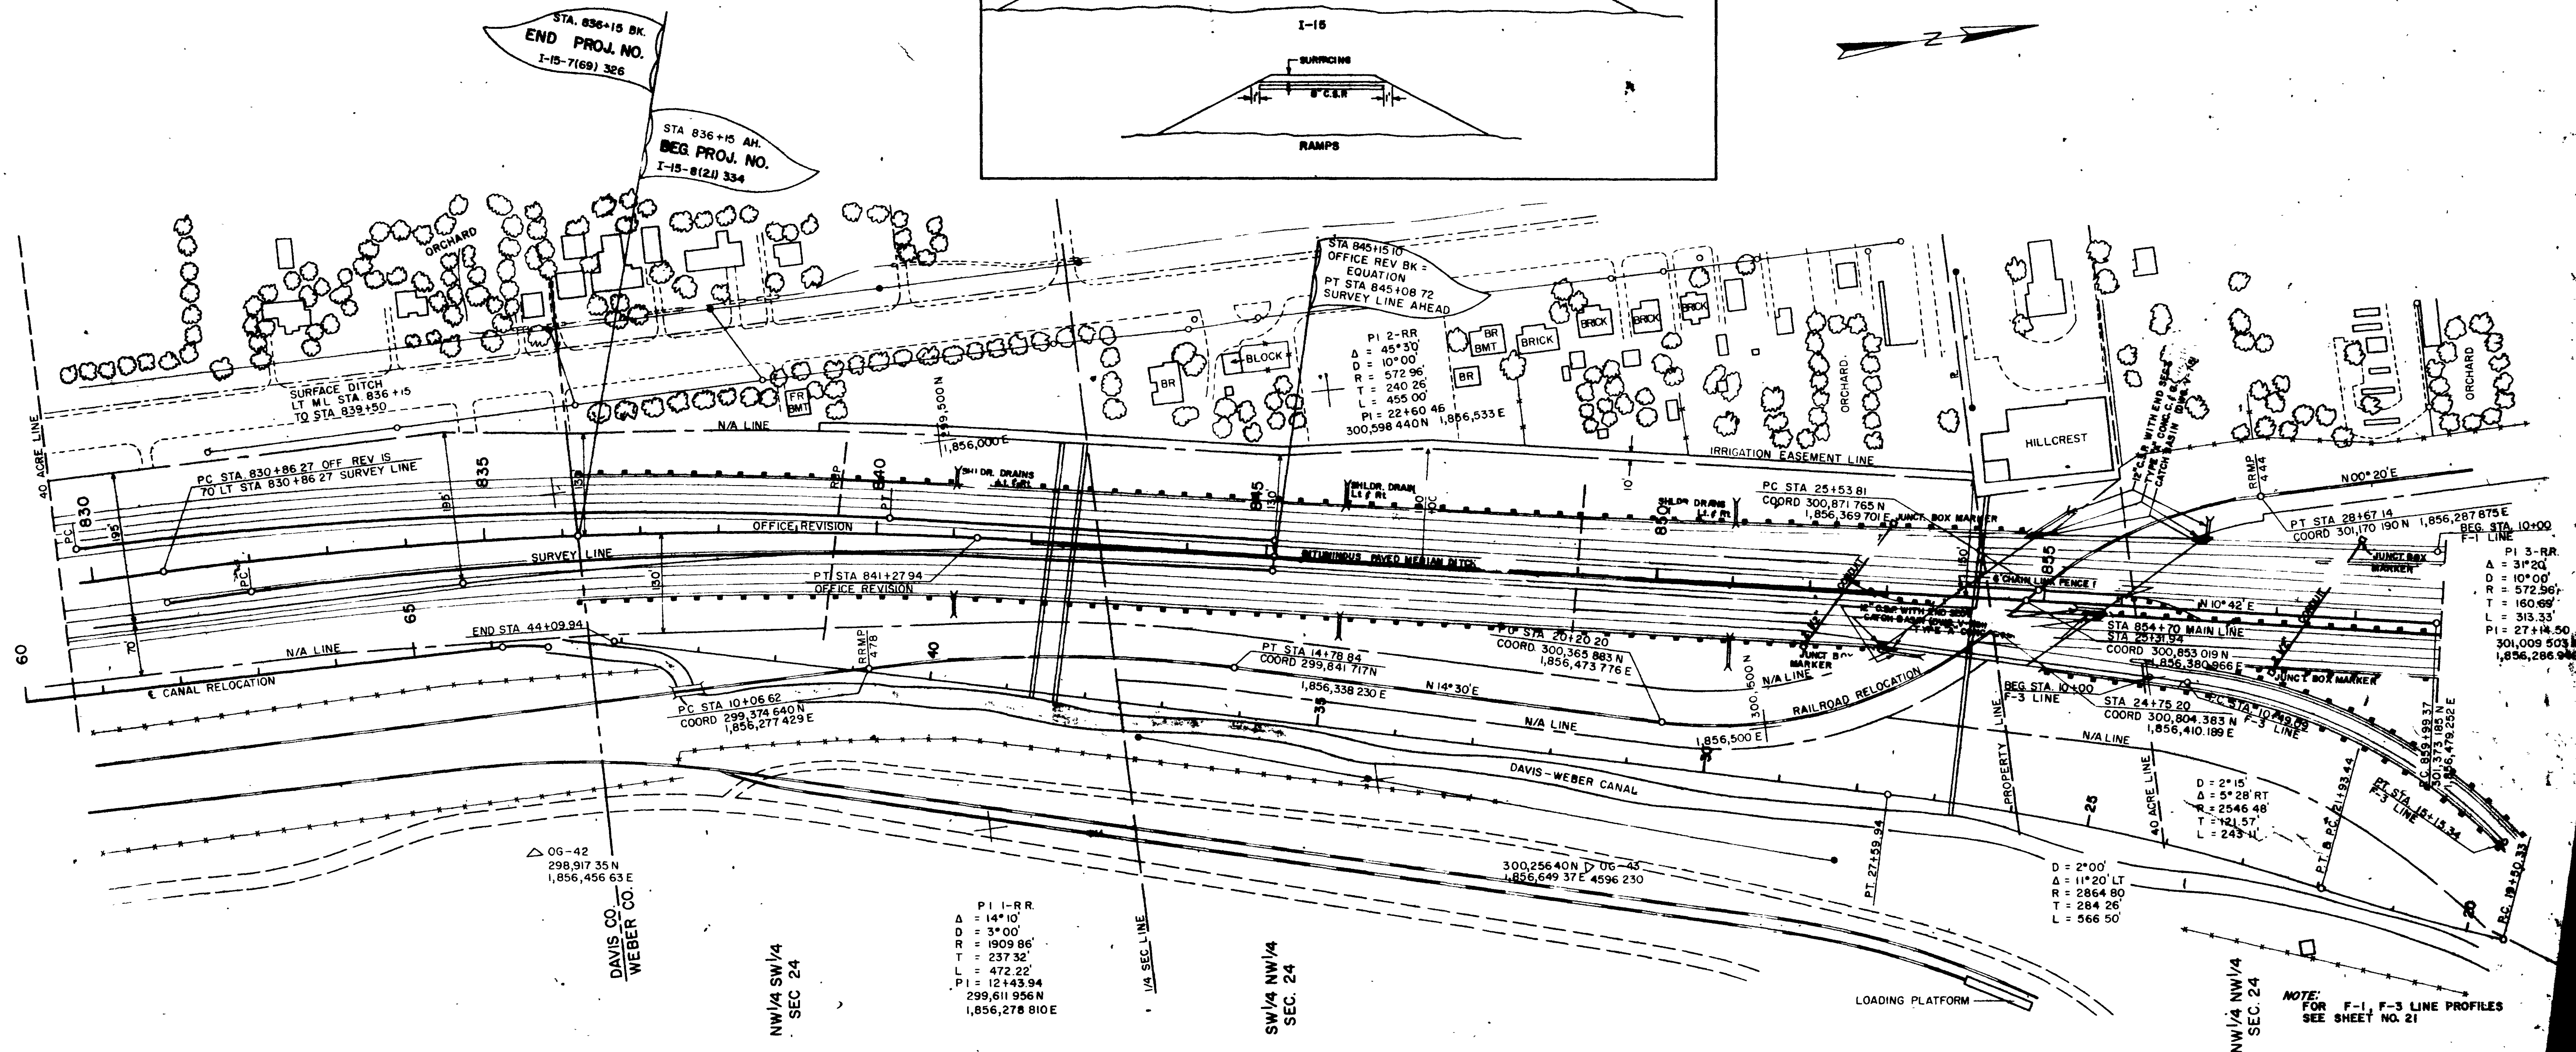

STA 842+00	12' 12" CSP	SHOULDER DRAINS
STA 846+00	29' 12" CSP	
STA 846+00	16' 12" CSP	
STA 851+00	51' 12" CSP	
STA 851+00	63' 12" CSP	

STRUCTURE DRAINS (RAILROAD STRUCTURE)			
SBL	SW CORNER	49'	12" CSP
NBL	NE CORNER	59'	12" CSP
SBL	NW CORNER	130'	12" CSP


STA 31+02 UNDERNEATH RR STRUCTURE 44' 24" RCP

NOTE:
FOR F-1, F-3 LINE PROFILES
SEE SHEET NO. 21


NOTE:
R-1 LINE AND RIVERDALE ROAD DETOUR
REMOVE BITUMINOUS SURFACING AS DIRECTED
BY THE PROJECT ENGINEER.

PER ROAD	STATE	PRIN. NO.	SHEET NO.	TOTAL SHEETS
UTAH	UTAH	I-15-8(2) 334	8	


REV. DATE 3/10/65

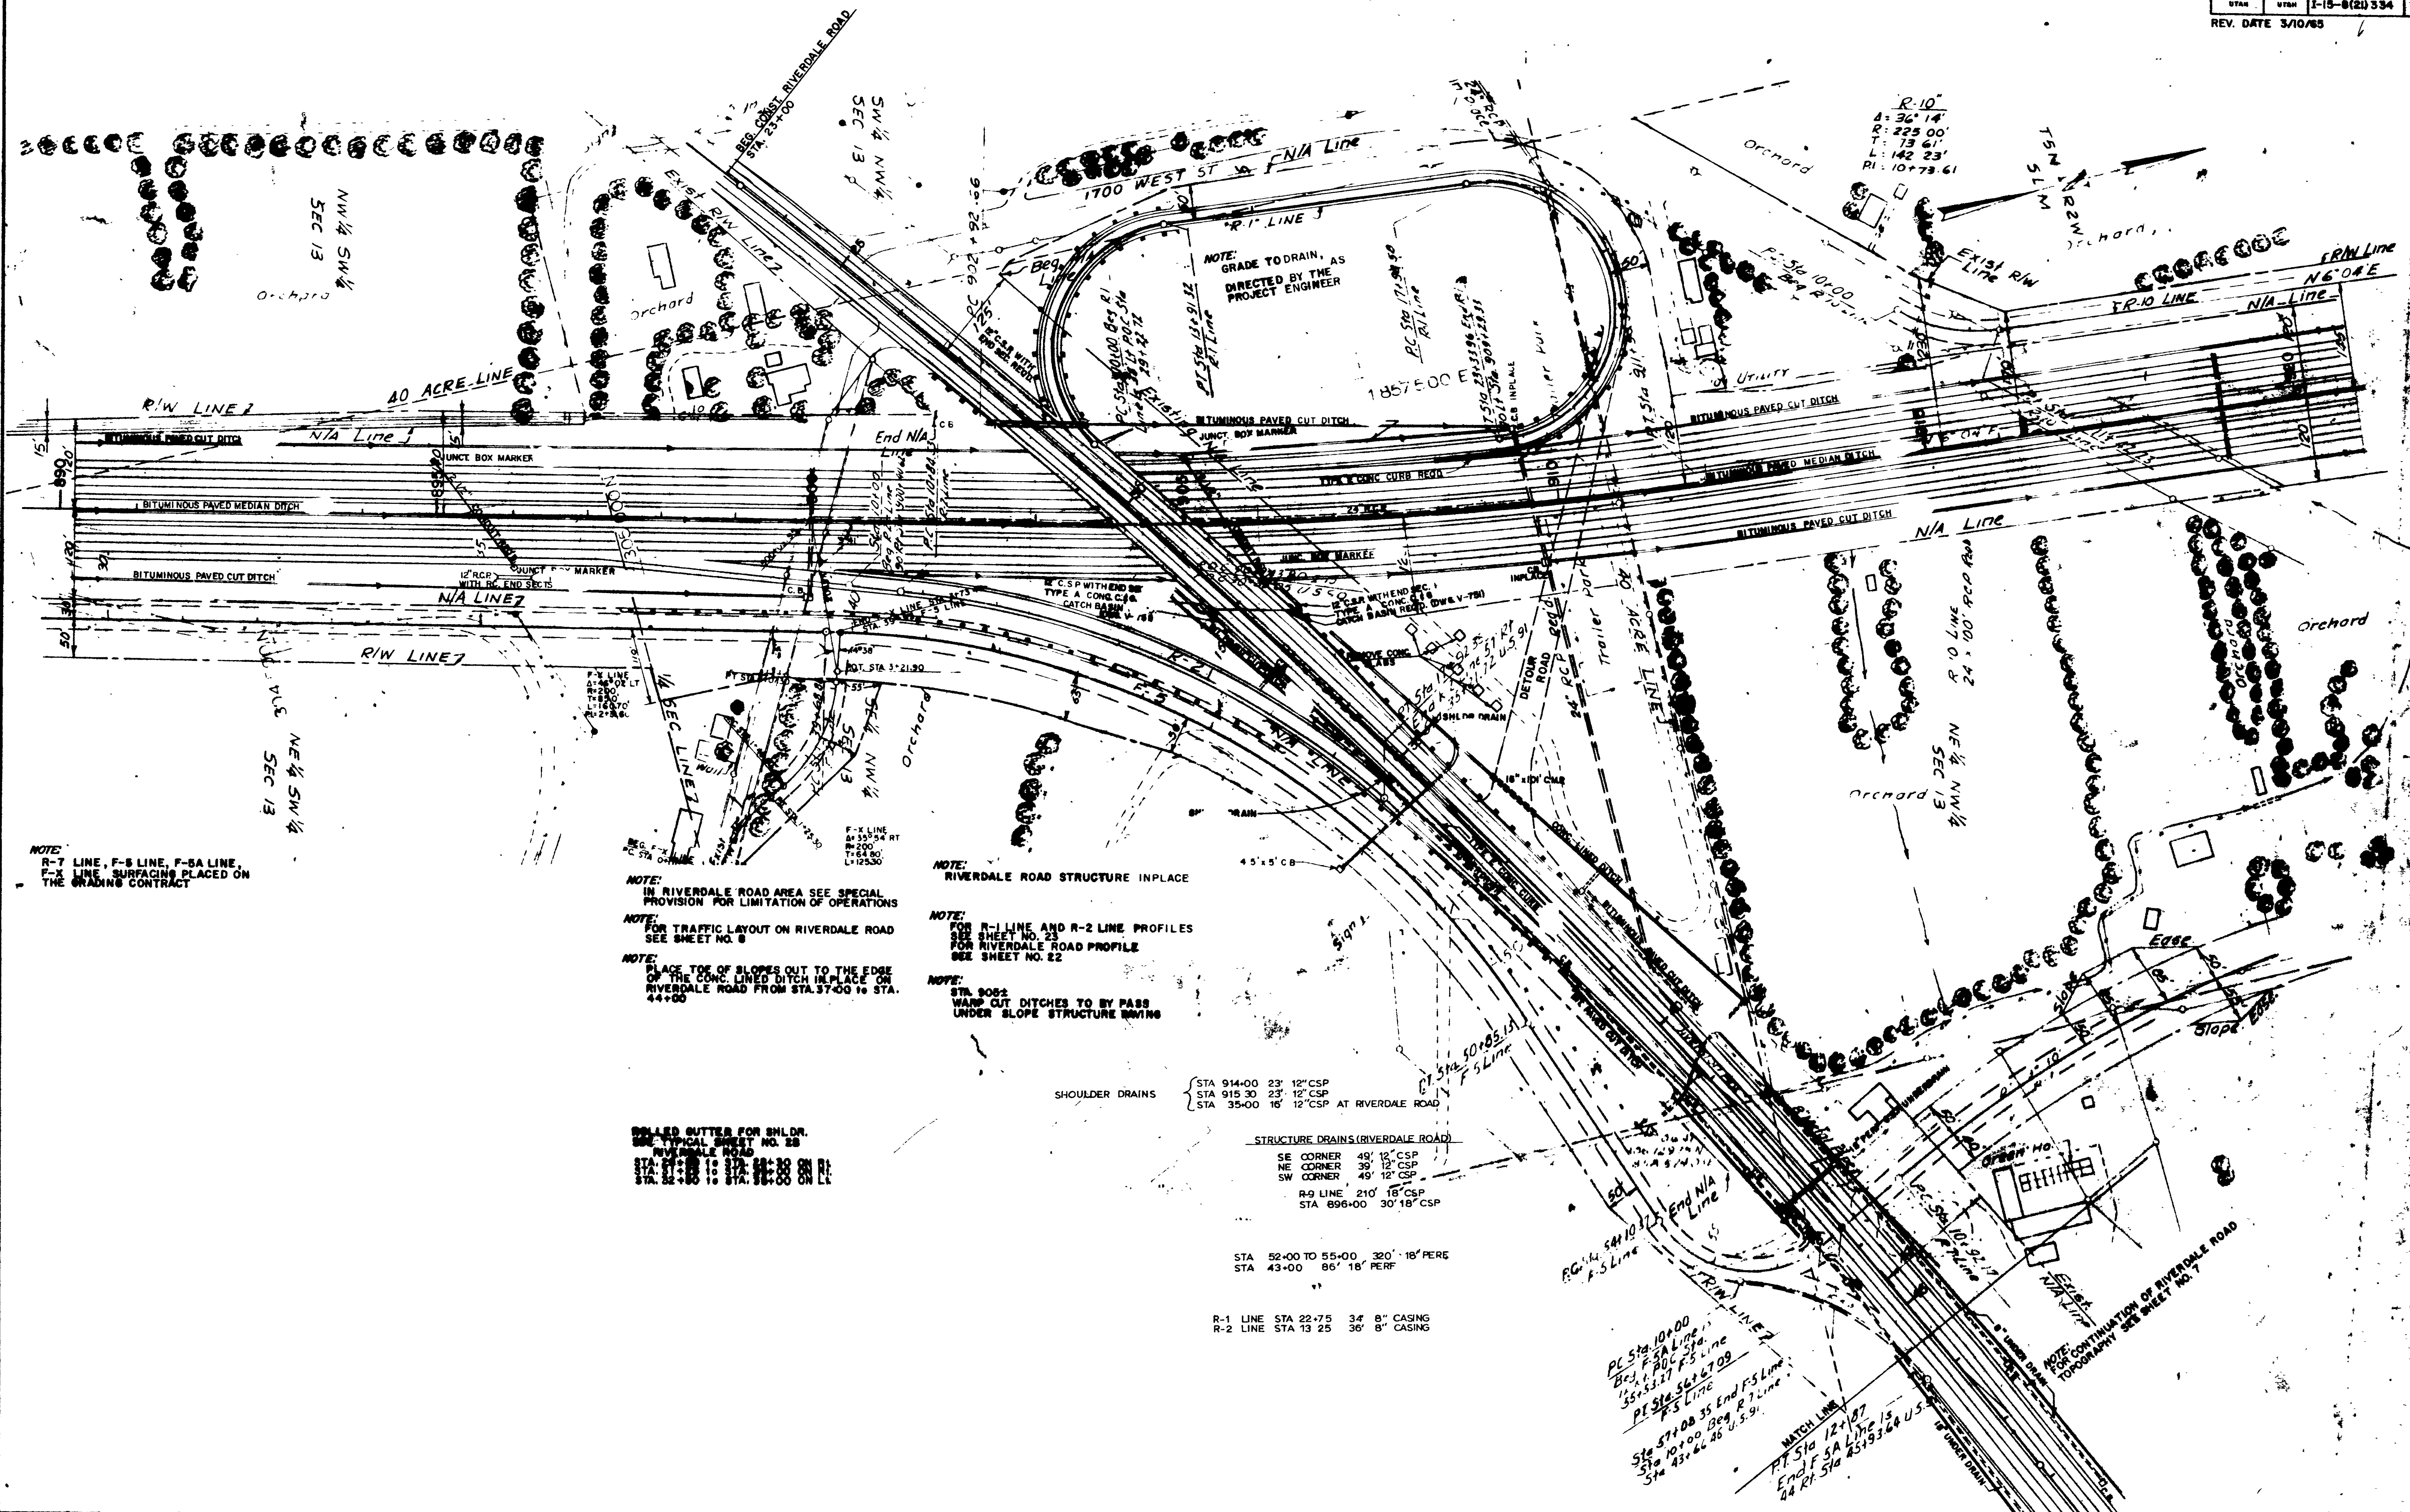



RIVERDALE ROAD

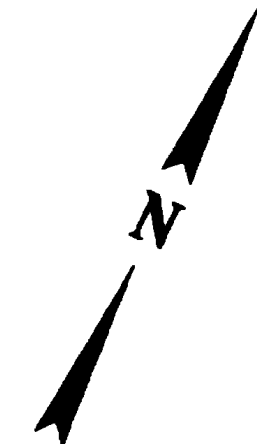


REV.	DATE	BY
1		
2		
3		
4		
5		

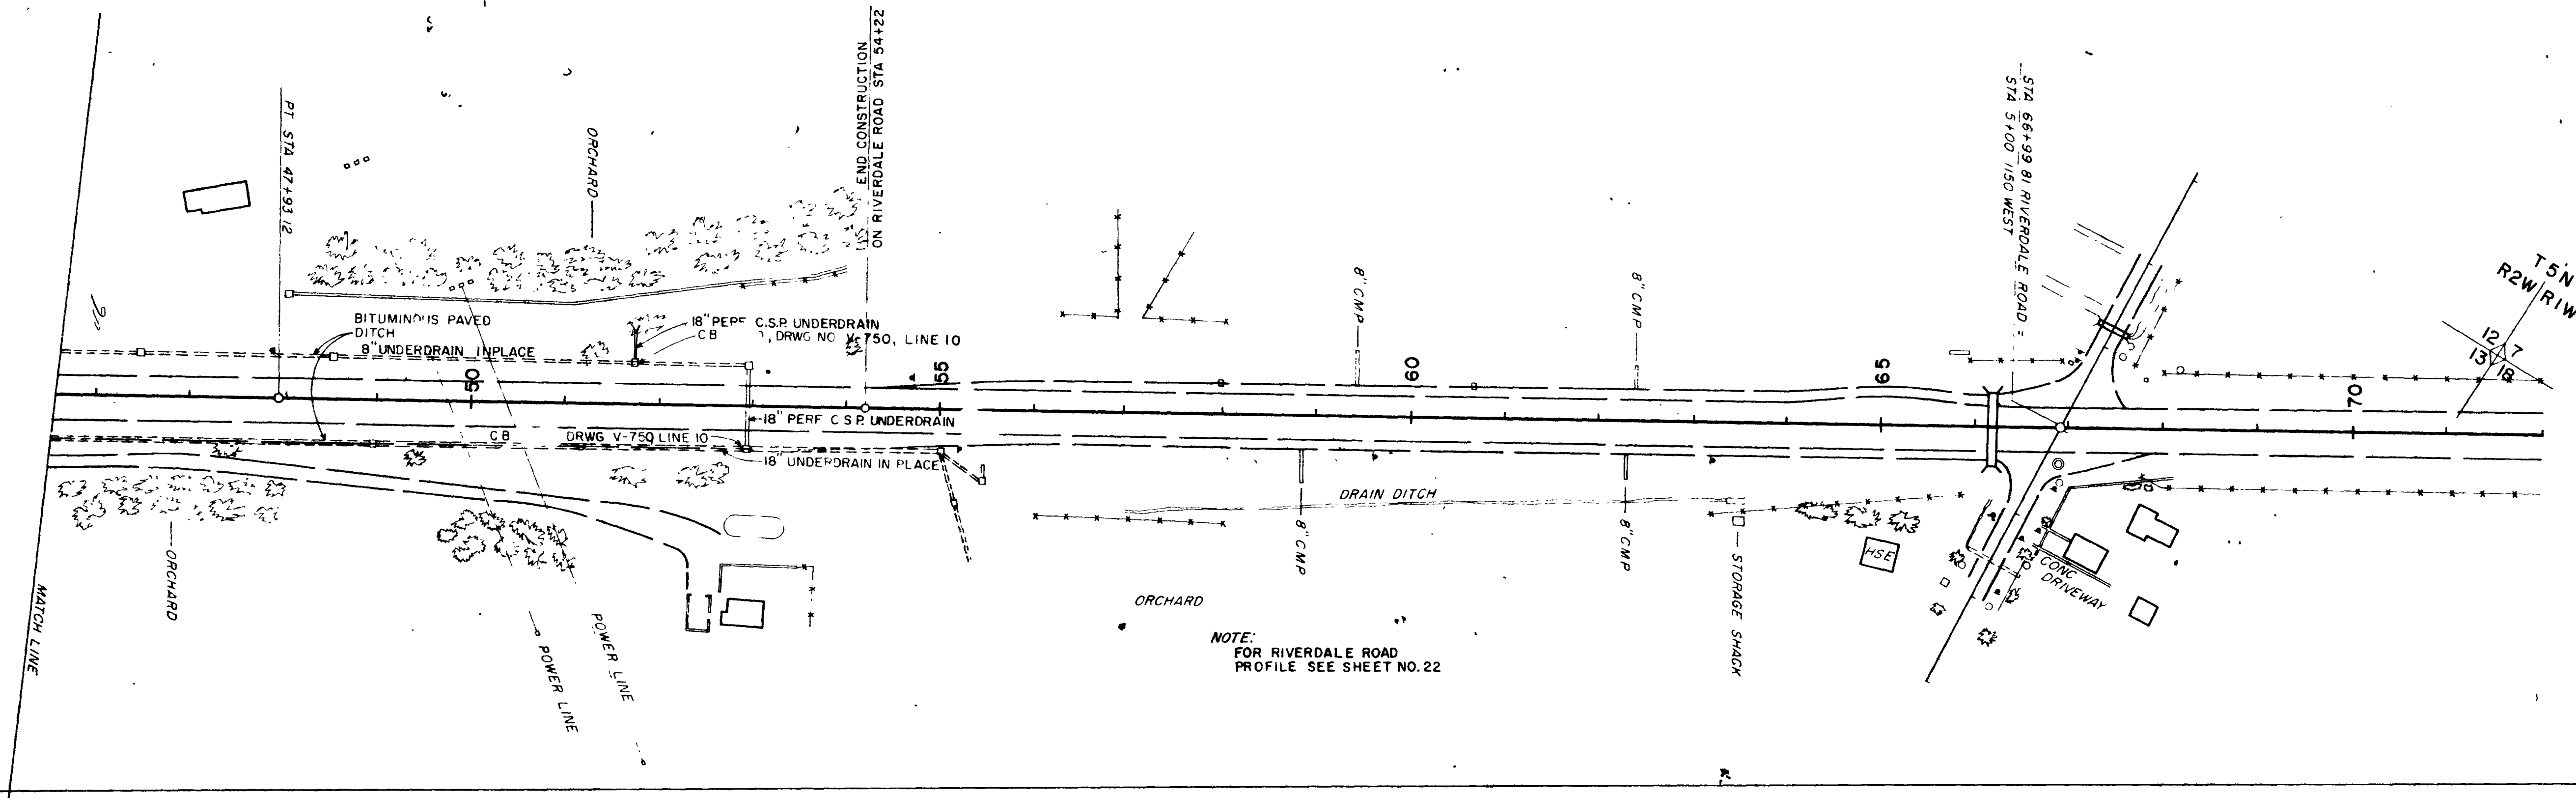

NOTE:
FOR RIVERDALE ROAD
PROFILE SEE SHEET NO. 22

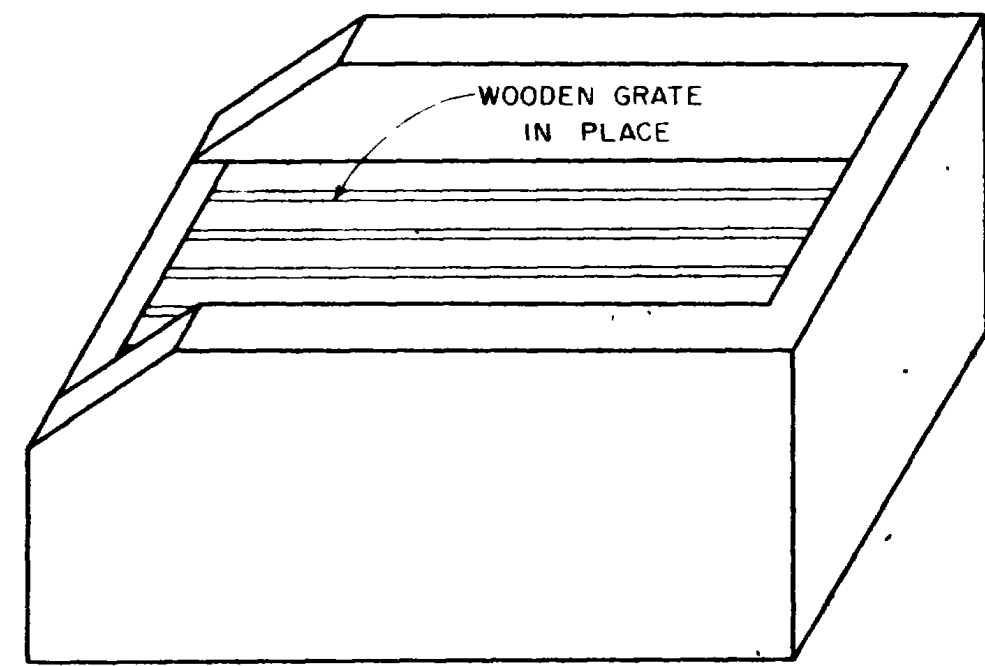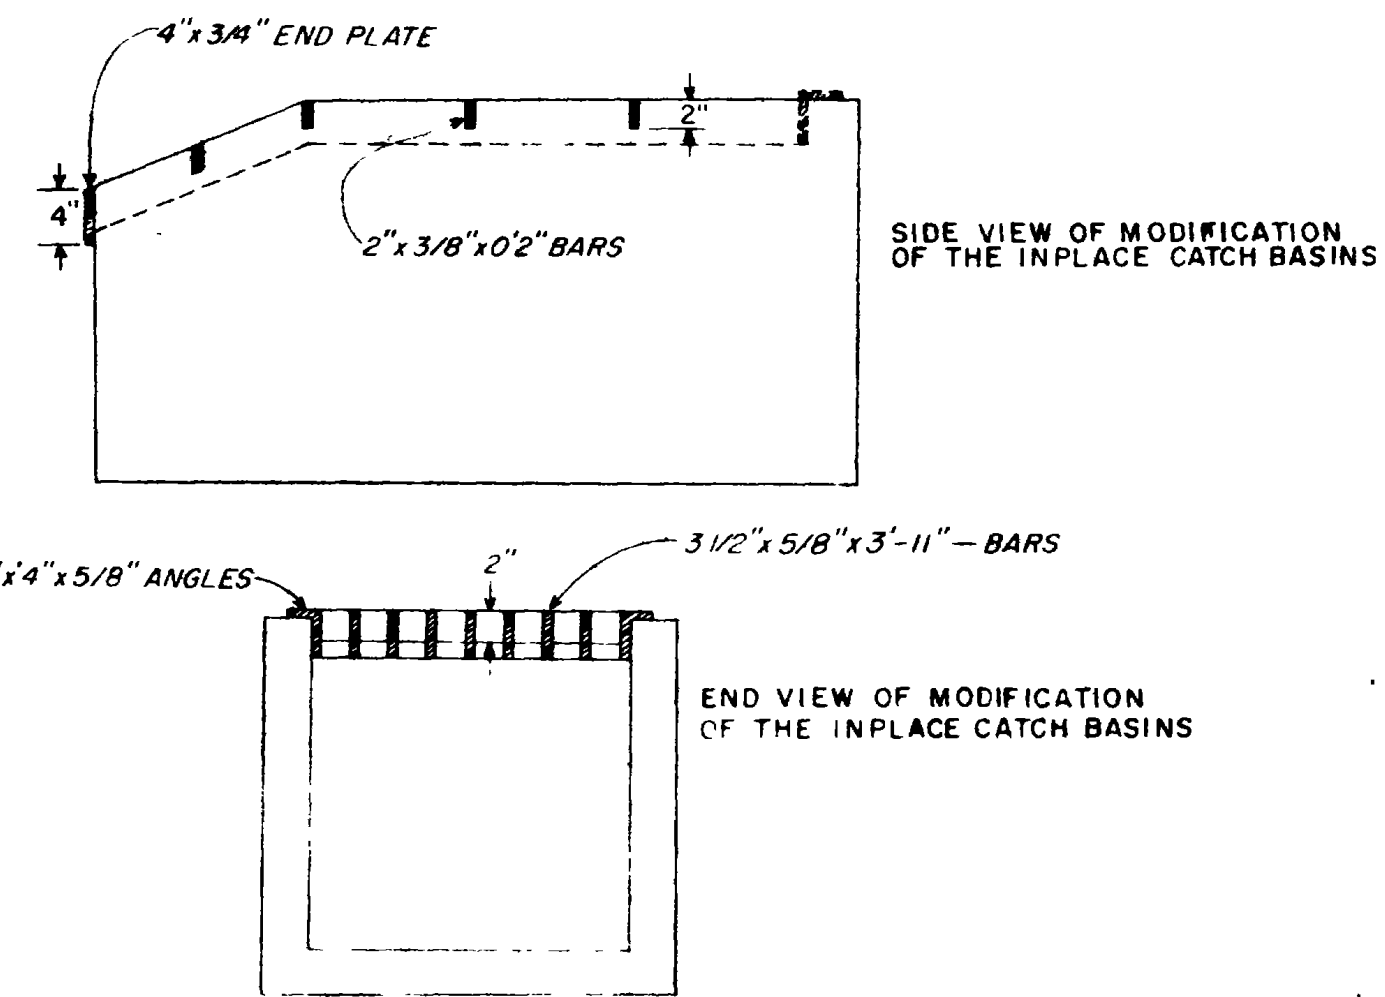

CATCH BASIN INPLACE AT VARIOUS STATIONS ON RIVERDALE ROAD

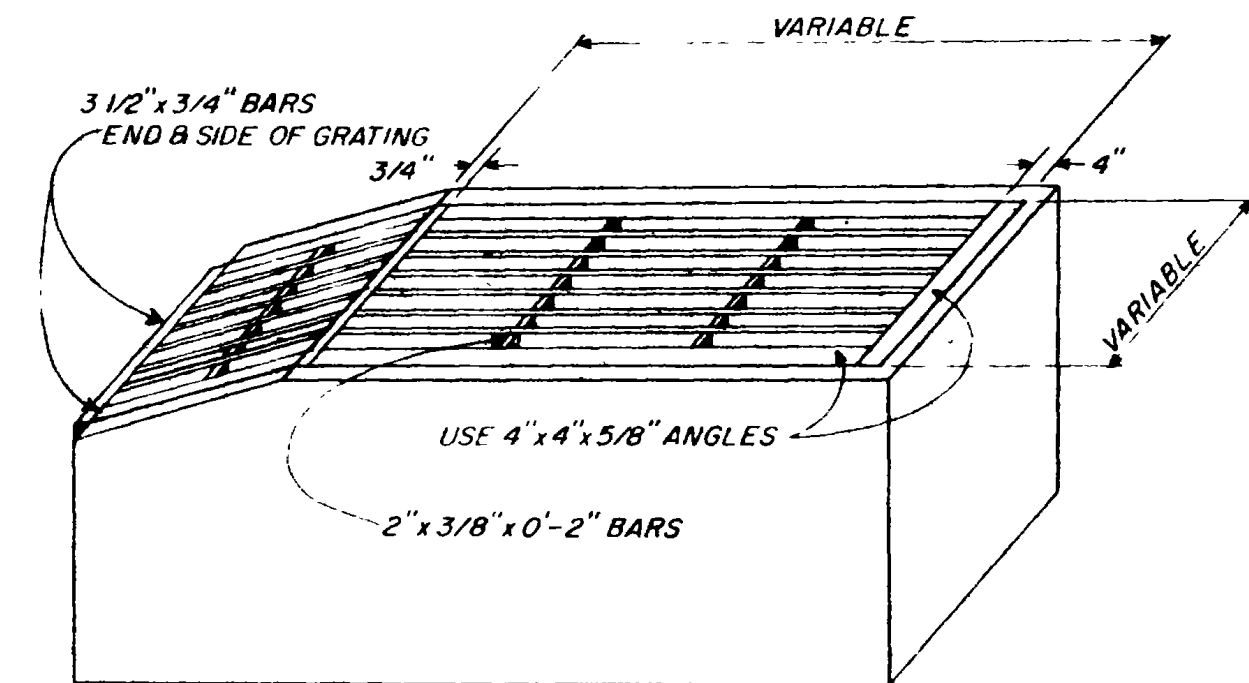

GRATING DETAIL
FOR MODIFICATION OF
EXISTING CATCH BASIN

STA. 33+00 RI, STA. 38+00 LI, STA. 38+50 RI, STA. 41+00 RI,
STA. 42+20 RI, STA. 43+00 LI, STA. 44+10 RI, STA. 46+50 LI,
STA. 48+50 LI, STA. 49+00 RI, STA. 51+10 RI, STA. 53+00 LI, AND
STA. 55+00 RI
MODIFY THE GRATING ON C.B.'S. IN UNDERDRAIN SYSTEM AS SHOWN
IN DETAIL ON THIS SHEET AND AS DIRECTED BY THE PROJECT ENGINEER

I-15
Δ = 9° 02'
D = 1° 00'
R = 5729.58'
T = 452.60'
L = 903.32'
P.I. = 907+45.27

STATE	UTAH
PROJECT	1-15-8(20)334

INTERCHANGE
I-15 RIVERDALE ROAD

BEGIN CONSTRUCTION OF
RIVERDALE ROAD STA. 25+00

Coordinates 508,668.680 N
1,853,518.699 E
ROC 904+43.00 I-15
POC 30+95.08 US 91
PC 510.902+98.66 I-15

Begin 12:1 Taper 55' Rt.
Sta. 896+42.08 I-15

F-5 LINE
Δ = 5° 00'
D = 1° 00'
R = 1145.92'
T = 365.81'
L = 707.82'
P.I. = 510+50.14

R-1 LINE
Δ = 5° 00'
D = 1° 00'
R = 1145.92'
T = 365.81'
L = 707.82'
P.I. = 510+50.14

F-5 LINE
Δ = 5° 00'
D = 1° 00'
R = 1145.92'
T = 365.81'
L = 707.82'
P.I. = 510+50.14

PT. STA. 17+98.58
END R-1 LINE 15' RT.
Sta. 20+1 Taper

PC = 23+25.20
PT = 47+78.5

MATCH LINE A
Sta. 49+00

Begin Taper 44' Rt.
Sta. 51+72.00 US 91

End Taper 32' Rt.
Sta. 54+22.00 US 91

END CONSTRUCTION OF
RIVERDALE ROAD STA. 54+22

NOTE:
FOR RIVERDALE ROAD PROFILE SEE SHEET NO. 22
FOR R-1 AND R-2 LINE PROFILES SEE SHEET NO. 23

PC STA. 101+00
Beg. F-5A LINE 15' RT.
POC STA. 55+53.27
F-5 Line


PT. STA. 66+67.09
F-5 Line



PT. STA. 12+07.01
END F-5A LINE 15' RT.
Sta. 40+93.64 US 91

PT. STA. 47+78.50
US 91

MATCH LINE B

FED. ROAD	STATE	PROJ. NO.	SHEET NO.	TOTAL SHEETS
UTAH	UTAH	I-15-821) 334	9	

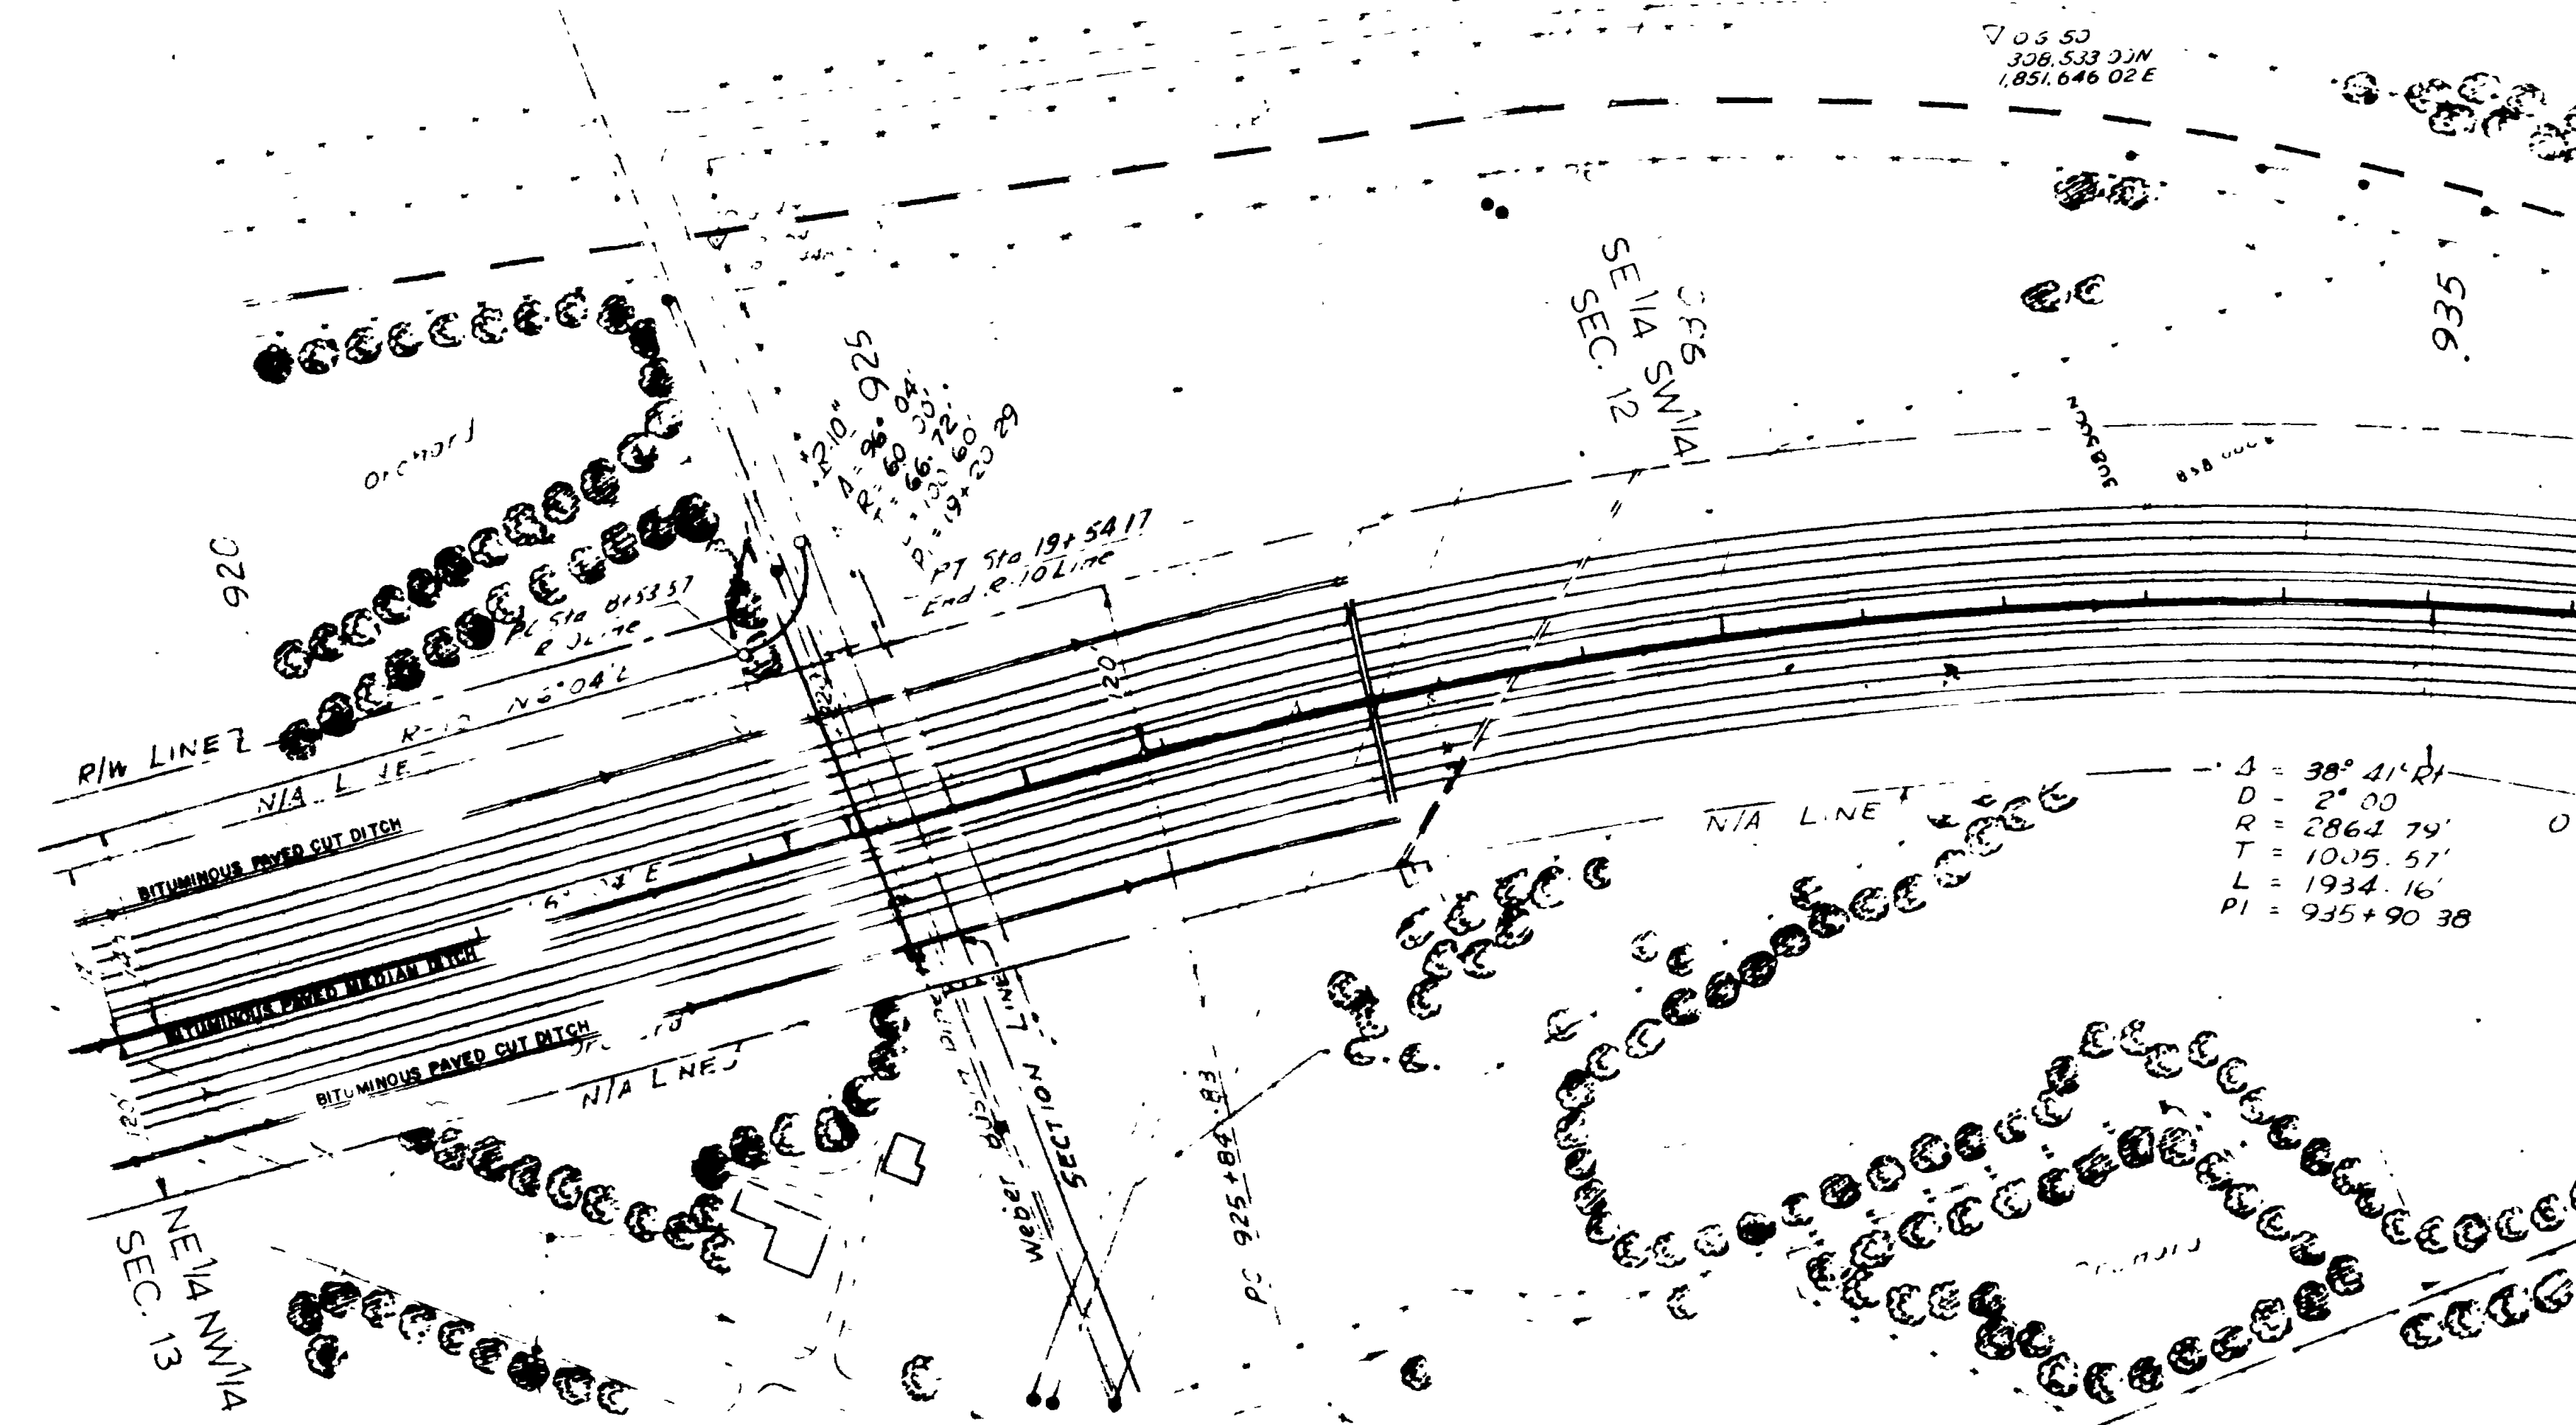


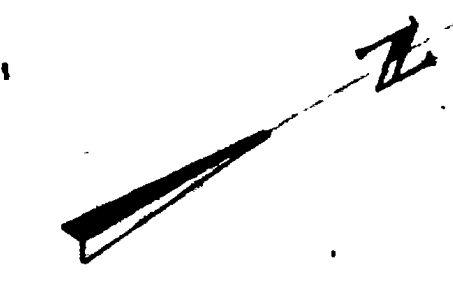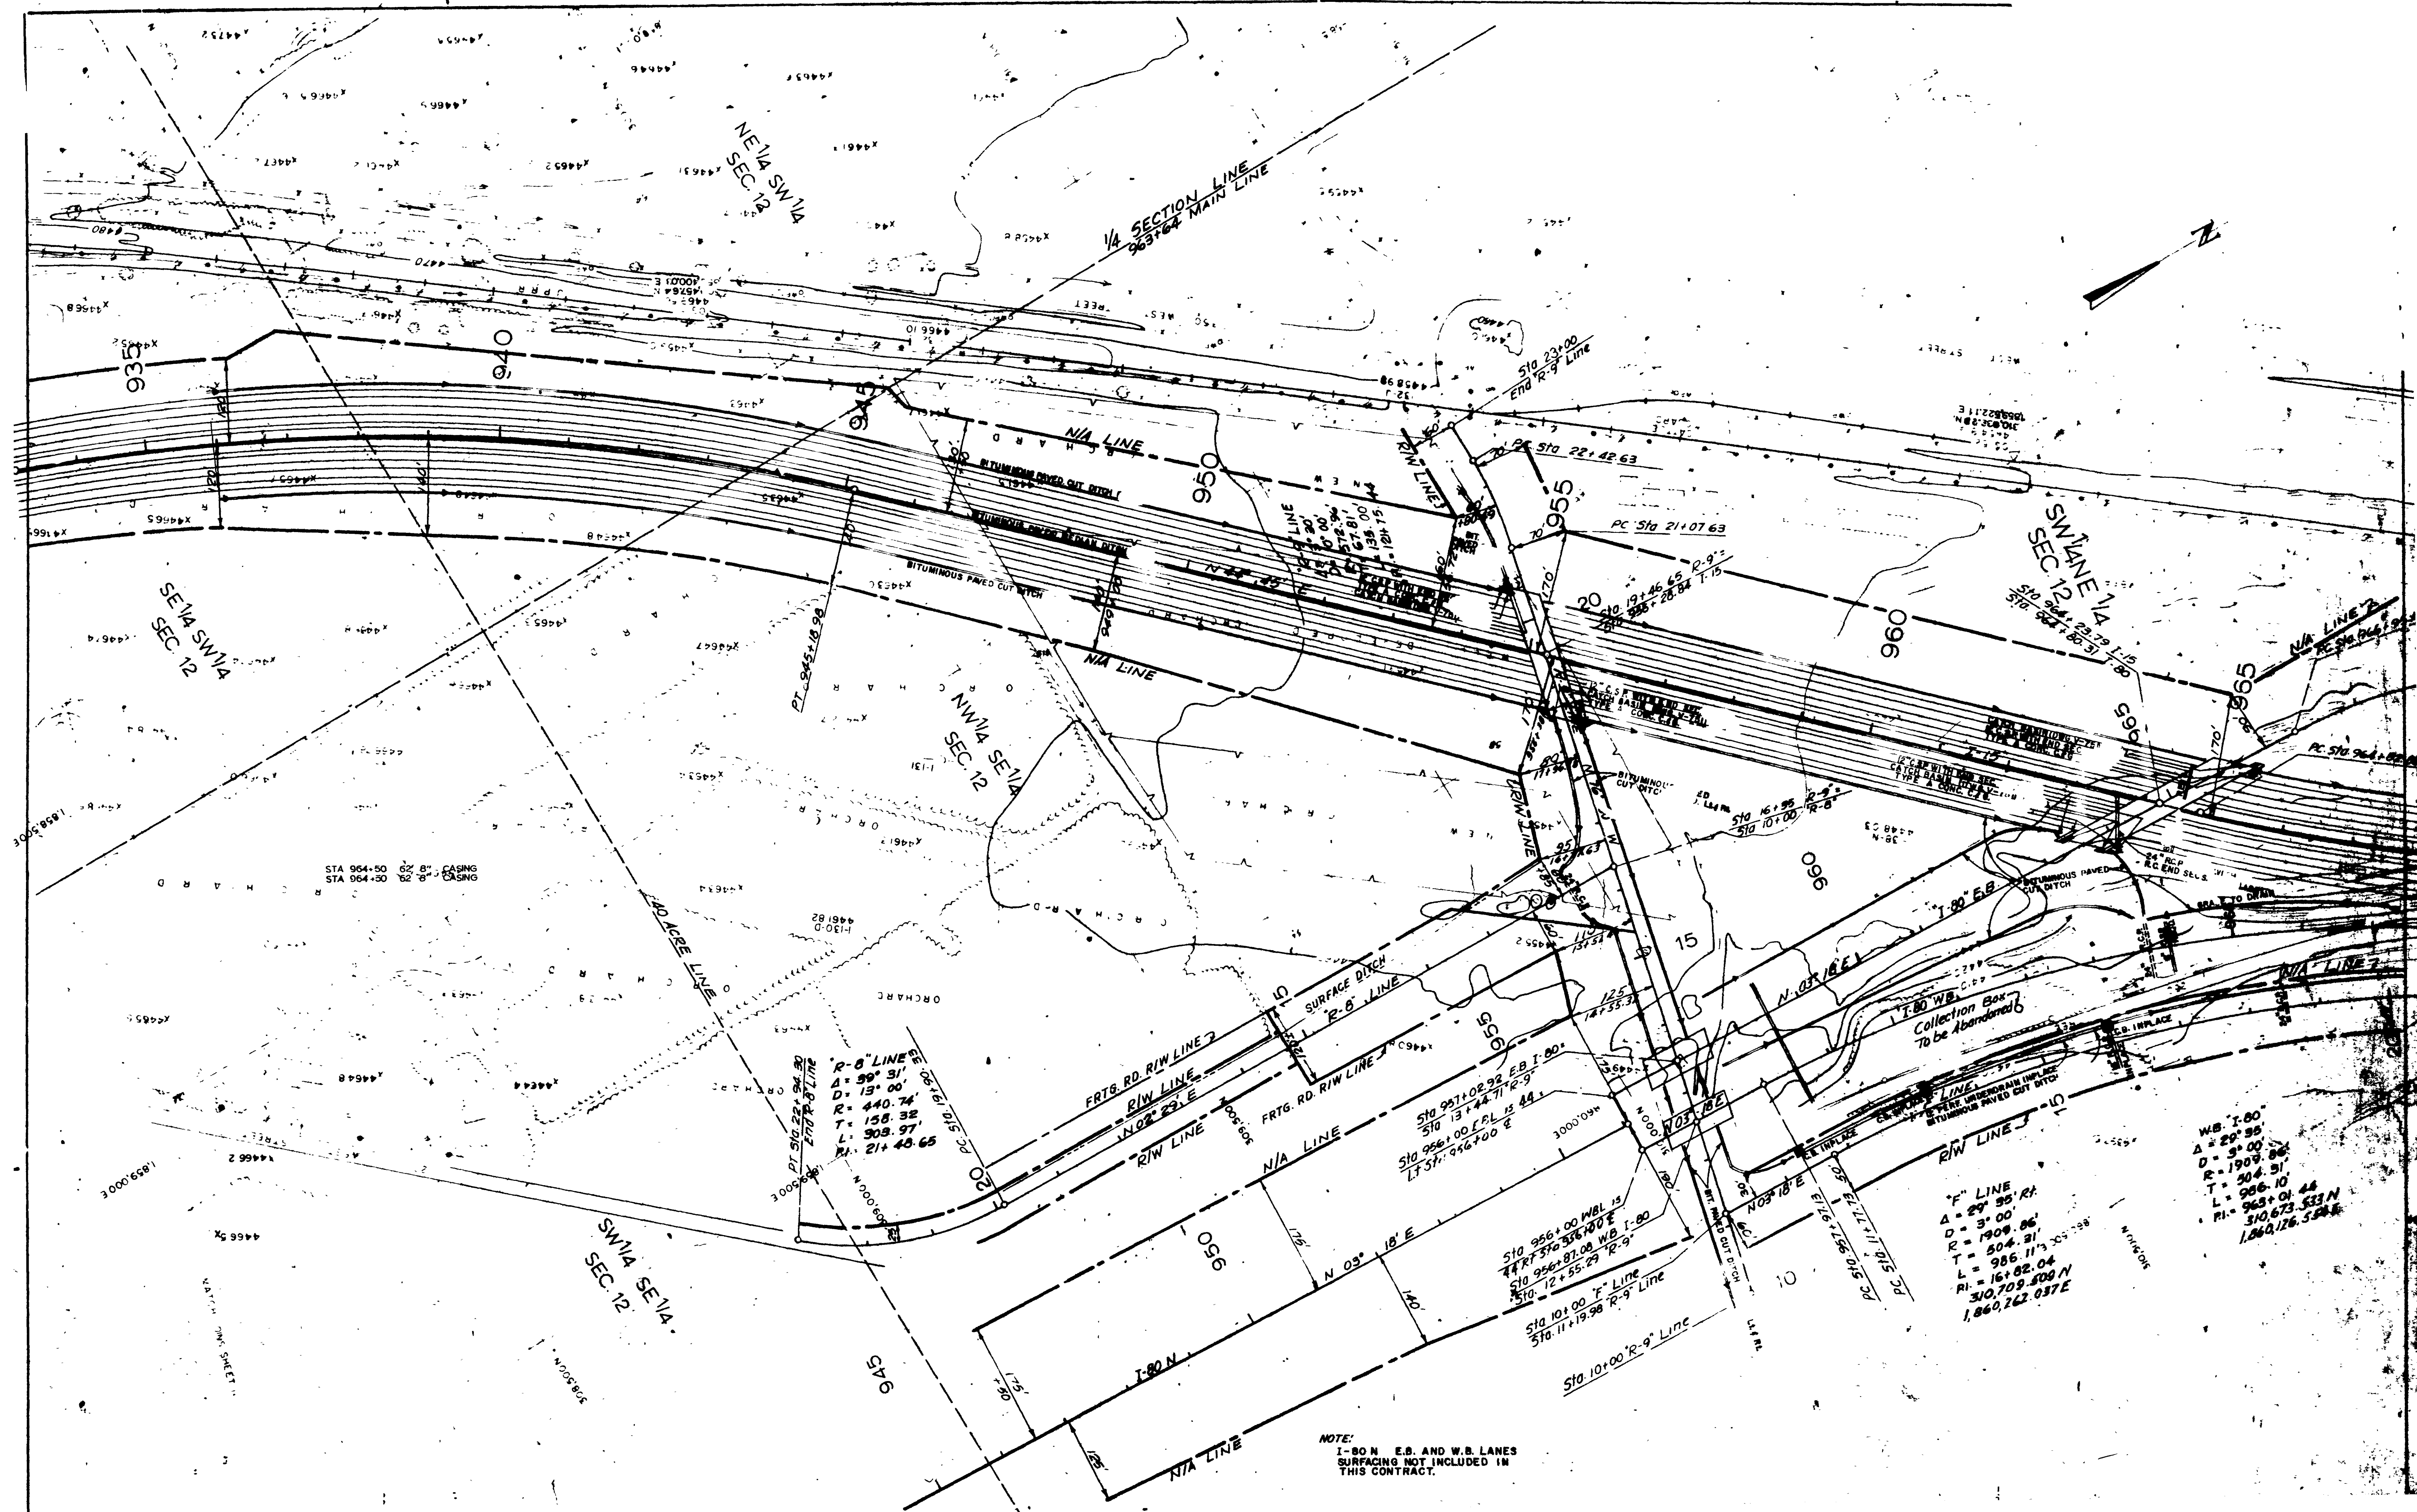

NOTE:
1-80 N. E.B. AND W.B. LANES
SURFACING NOT INCLUDED IN
THIS CONTRACT.

F LINE
A = 29° 35' R
D = 3° 00'
R = 1909.86'
T = 504.31'
L = 986.11'
PI = 963+01.44
S 10° 10' 00" N
1,860,262.037 E

W.B. 1.80
A = 29° 35'
D = 3° 00'
R = 1909.86'
T = 504.31'
L = 986.11'
PI = 963+01.44
S 10° 10' 00" N
1,860,262.037 E

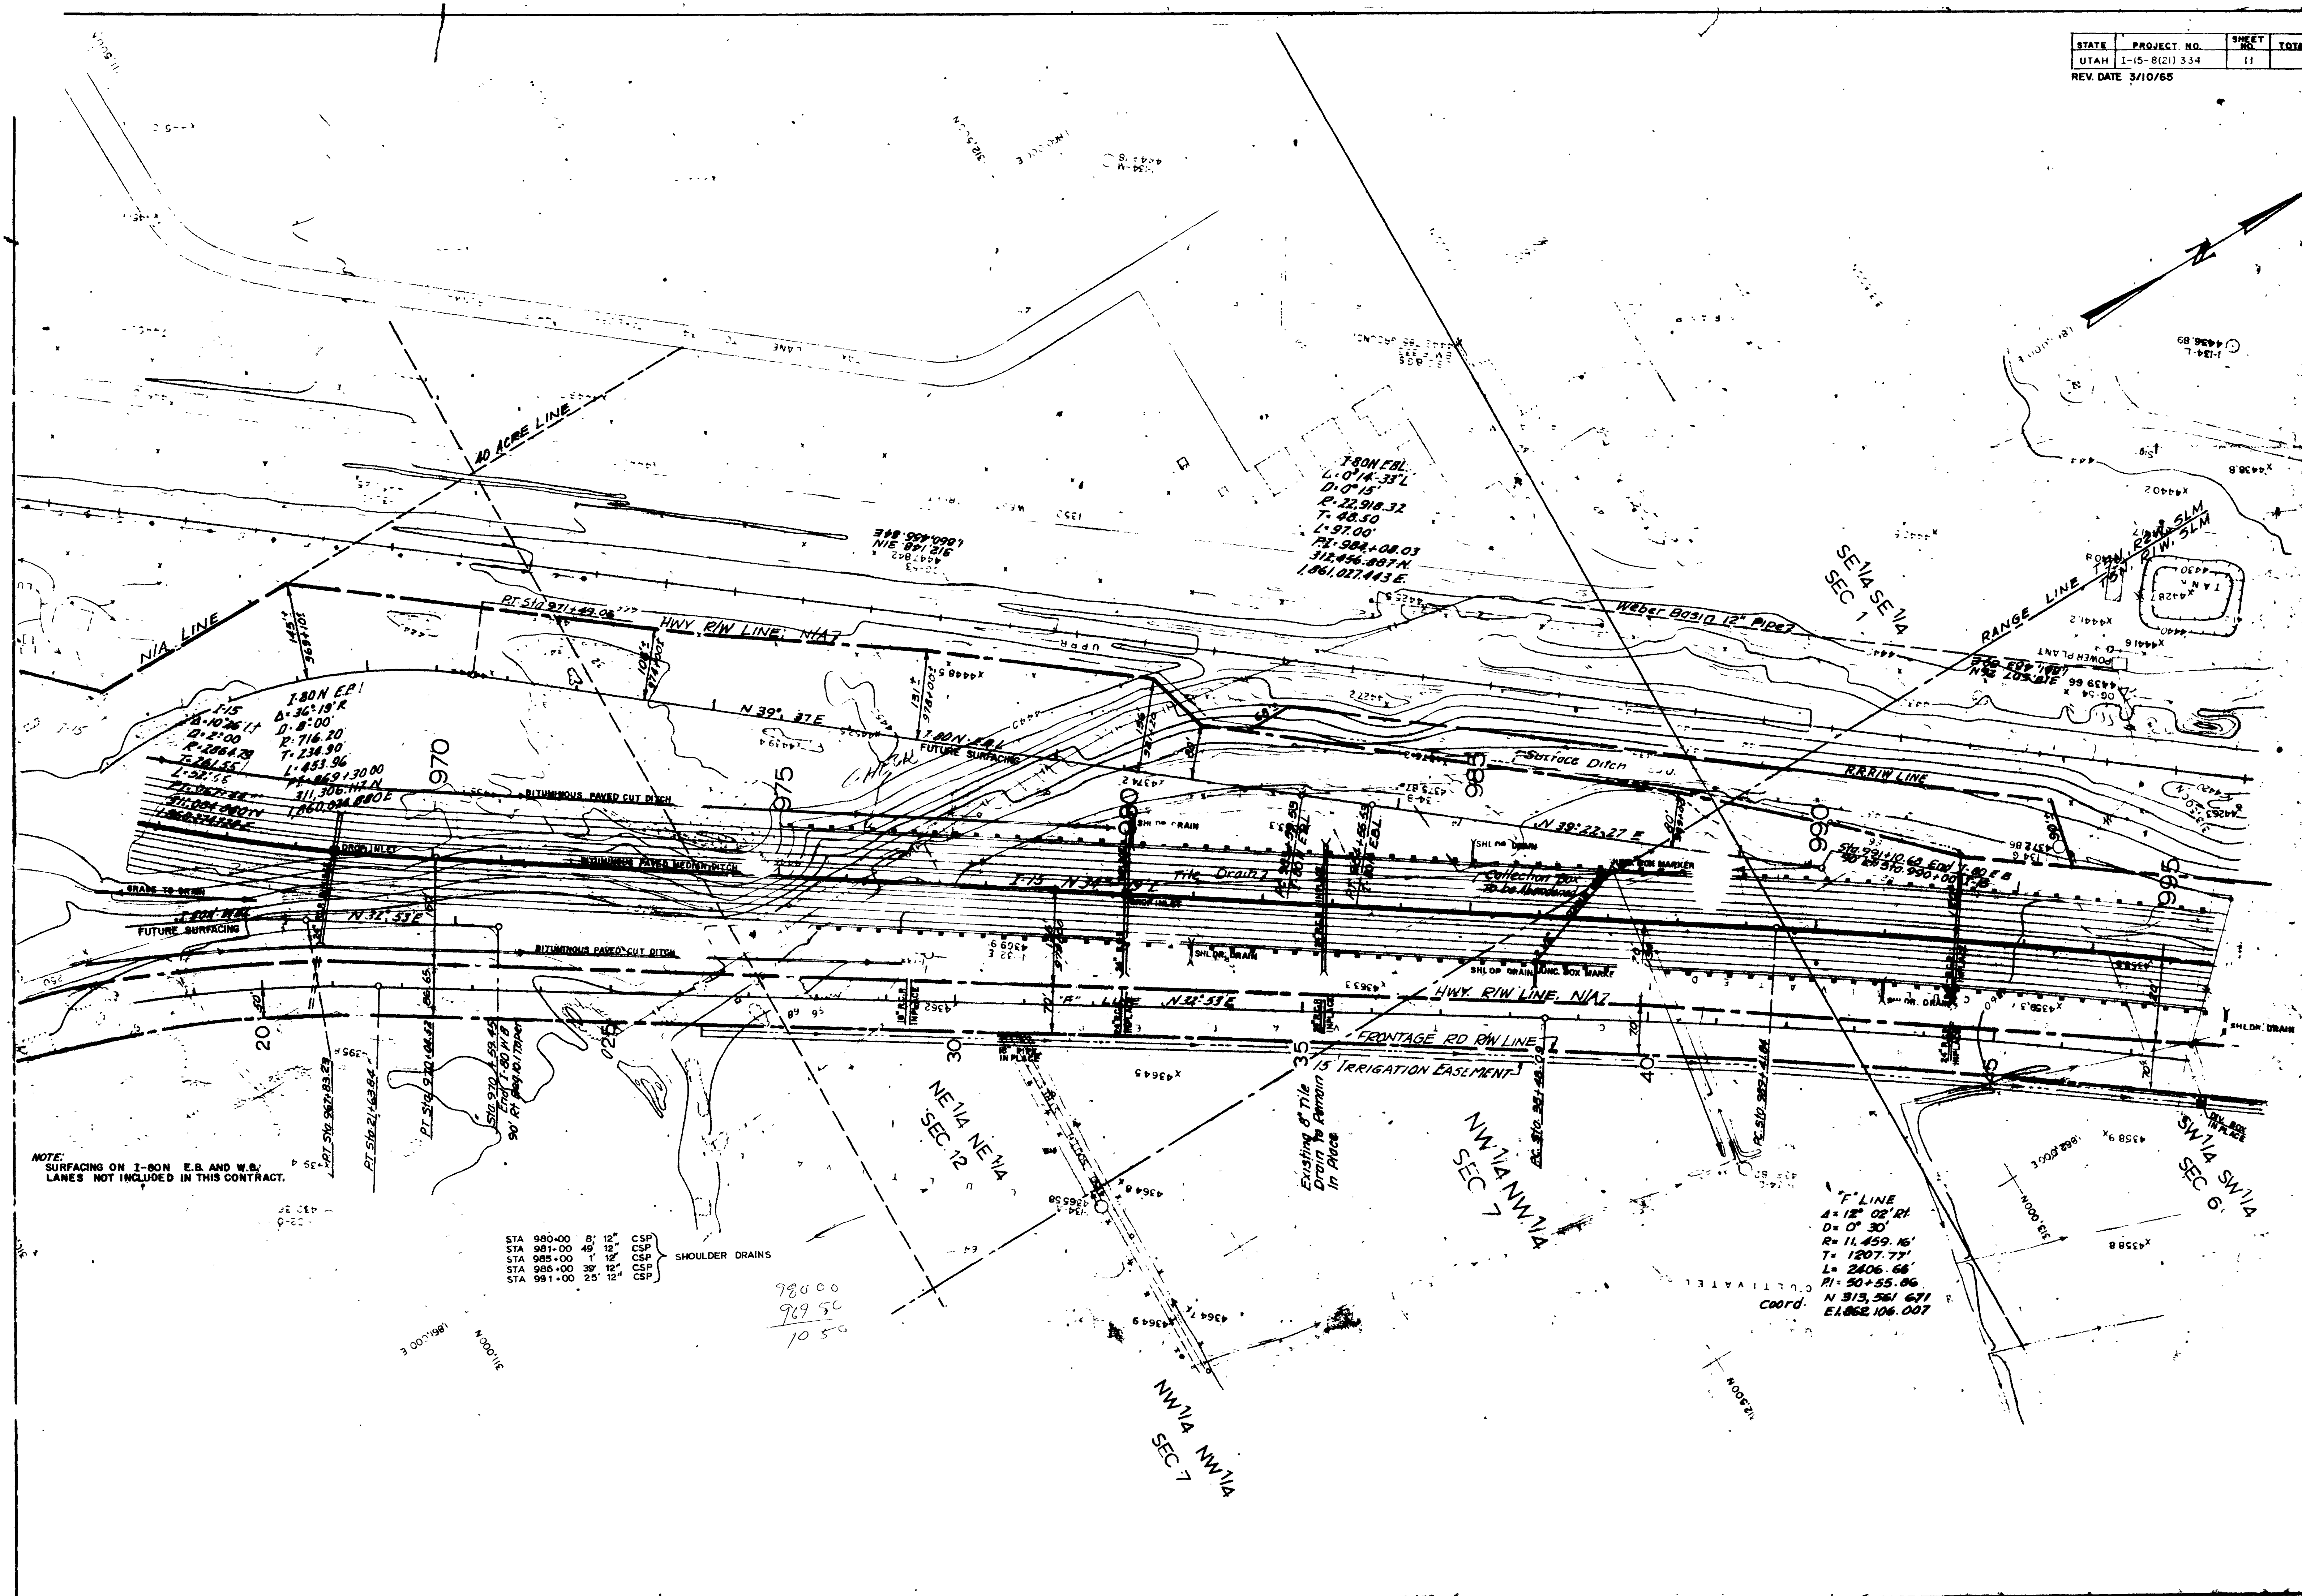


NOTE:
SURFACING ON I-80N E.B. AND W.B.
LANES NOT INCLUDED IN THIS CONTRACT.

STA 980+00	8' 12"	CSP
STA 981+00	49' 12"	CSP
STA 985+00	1' 12"	CSP
STA 986+00	39' 18"	CSP
STA 991+00	25' 12"	CSP

SHOULDER DRAINS


980 00
989 50
10 50

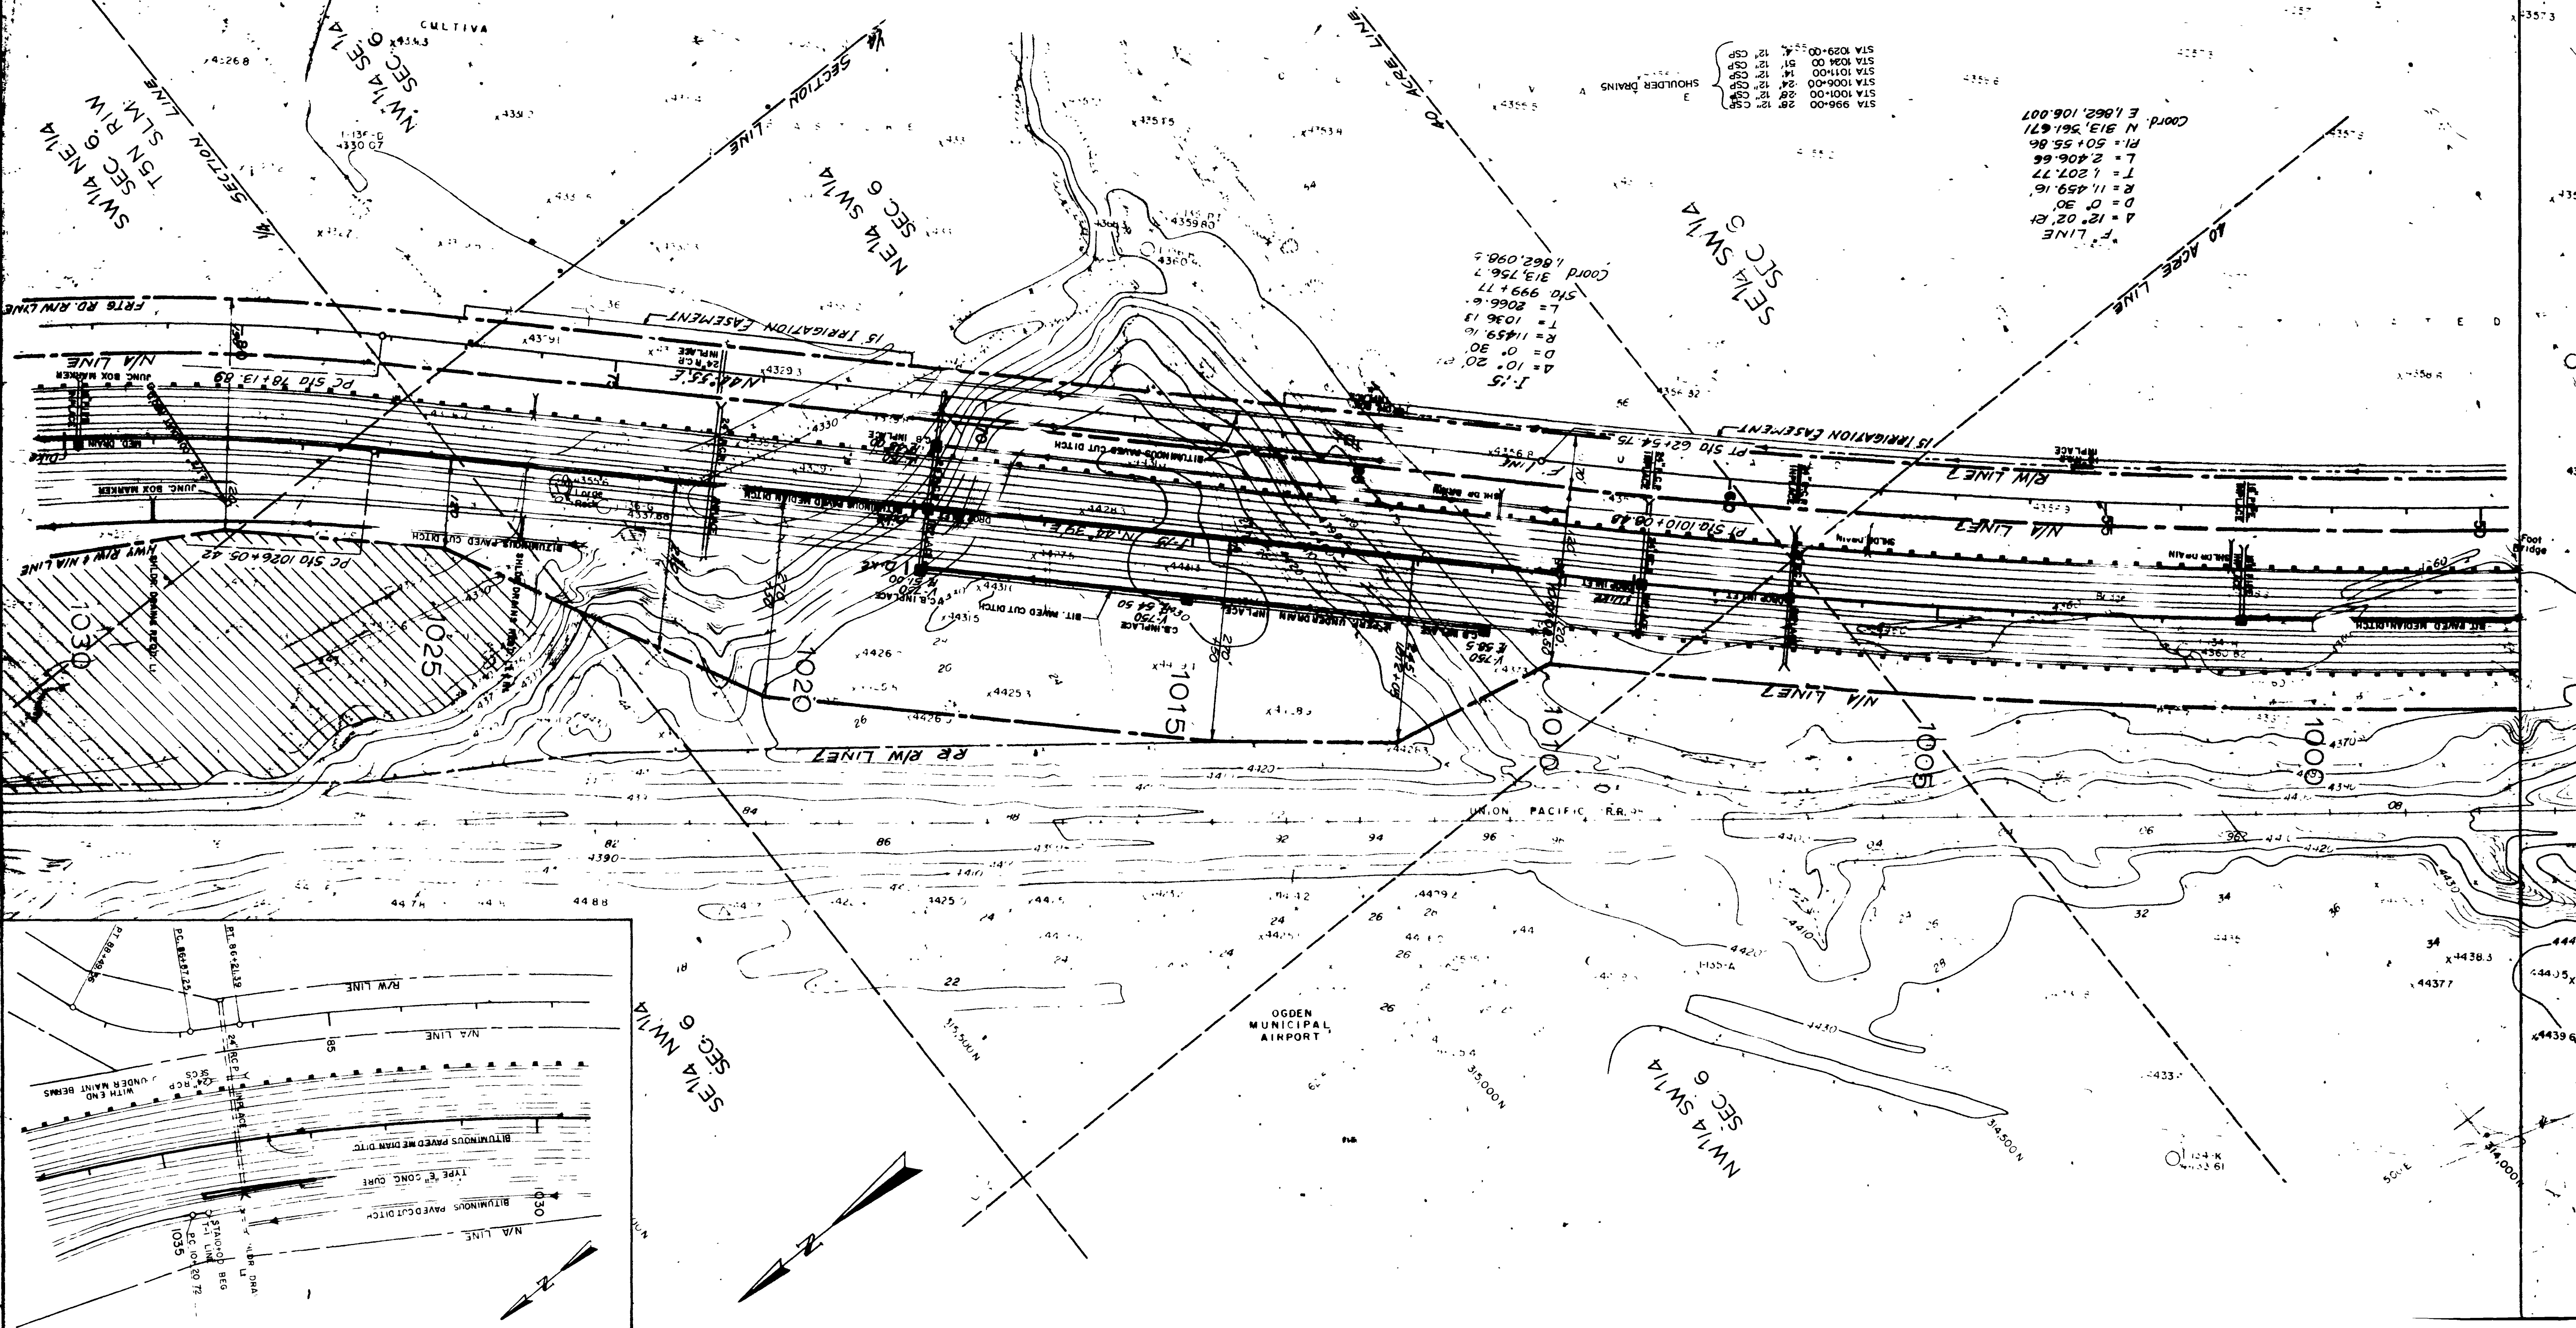



F. LINE
 A = 12° 02' 24"
 D = 0° 30'
 R = 11,459.16'
 T = 1,207.77'
 L = 2,406.66'
 PI = 50+55.86'
 Coord. N 313,561.671
 E 1,862,106.007



J-15
 A = 10° 20' 24"
 D = 0° 30'
 R = 11,459.16'
 T = 1,036.13'
 L = 2,066.66'
 STK 999+77
 Coord. 313,756.7
 E 1,862,098.7



STA 996+00 28' 12" CSP
 STA 1001+00 28' 12" CSP
 STA 1006+00 24' 12" CSP
 STA 1014+00 14' 12" CSP
 STA 1029+00 52' 12" CSP
 SHOULDER DRAIN


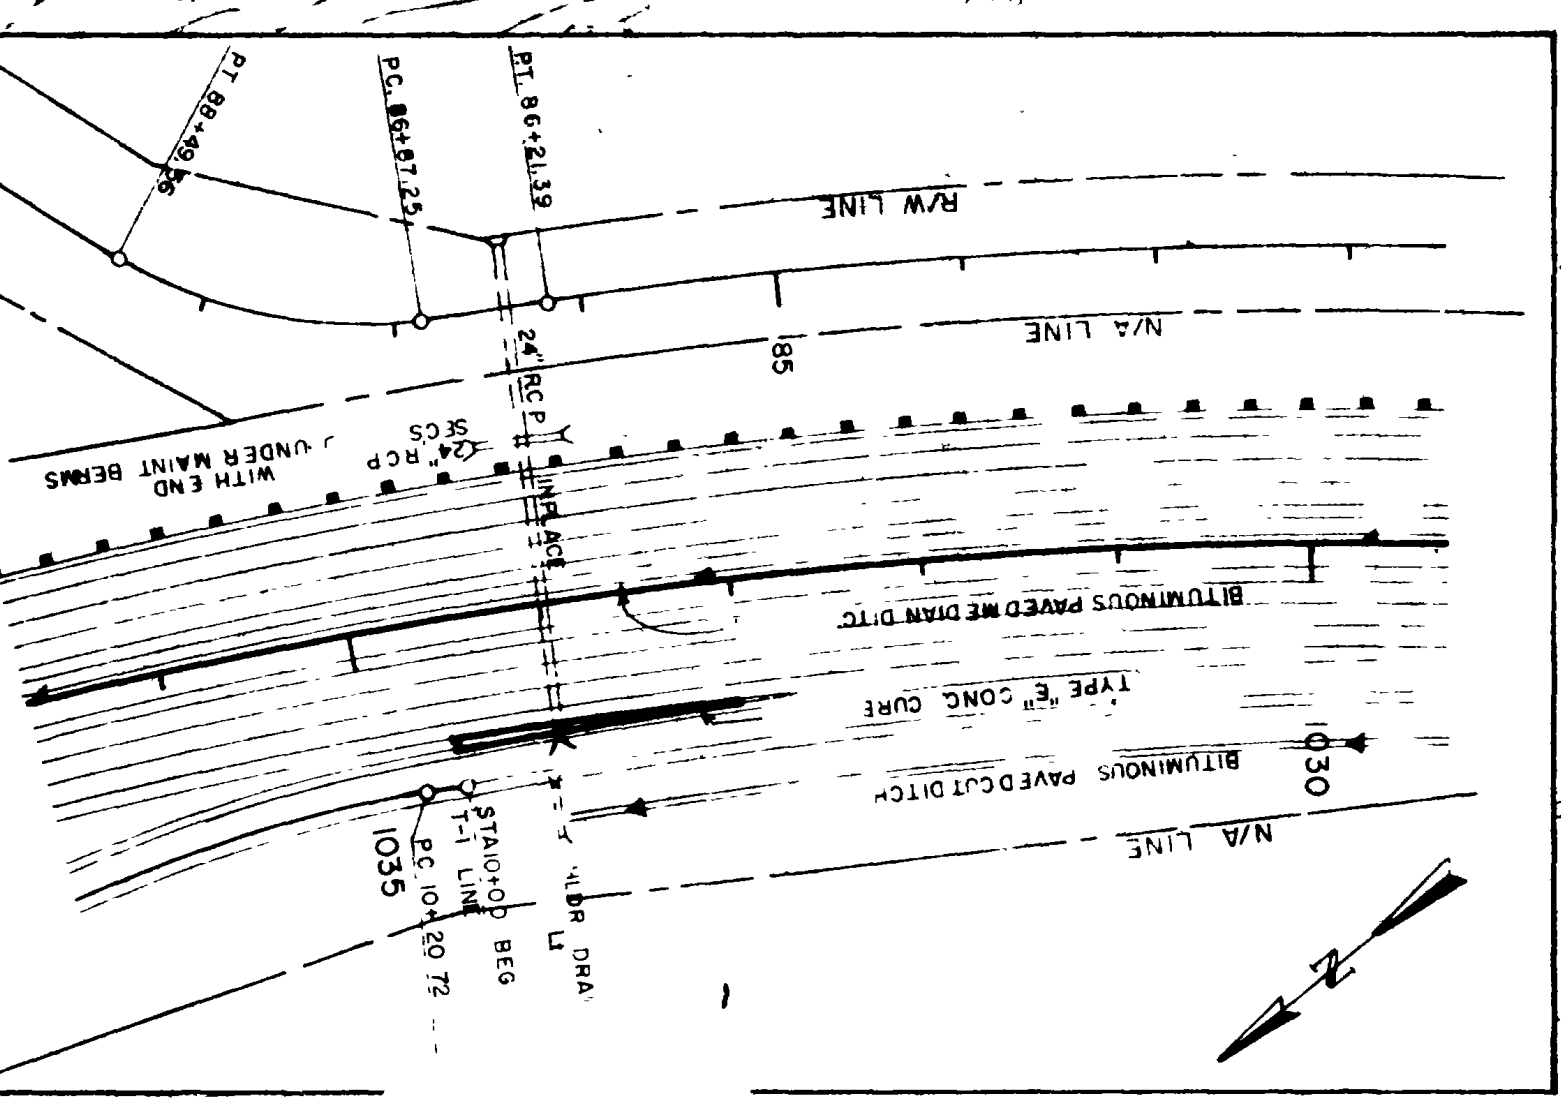




SHEET	12
NO	TOTAL

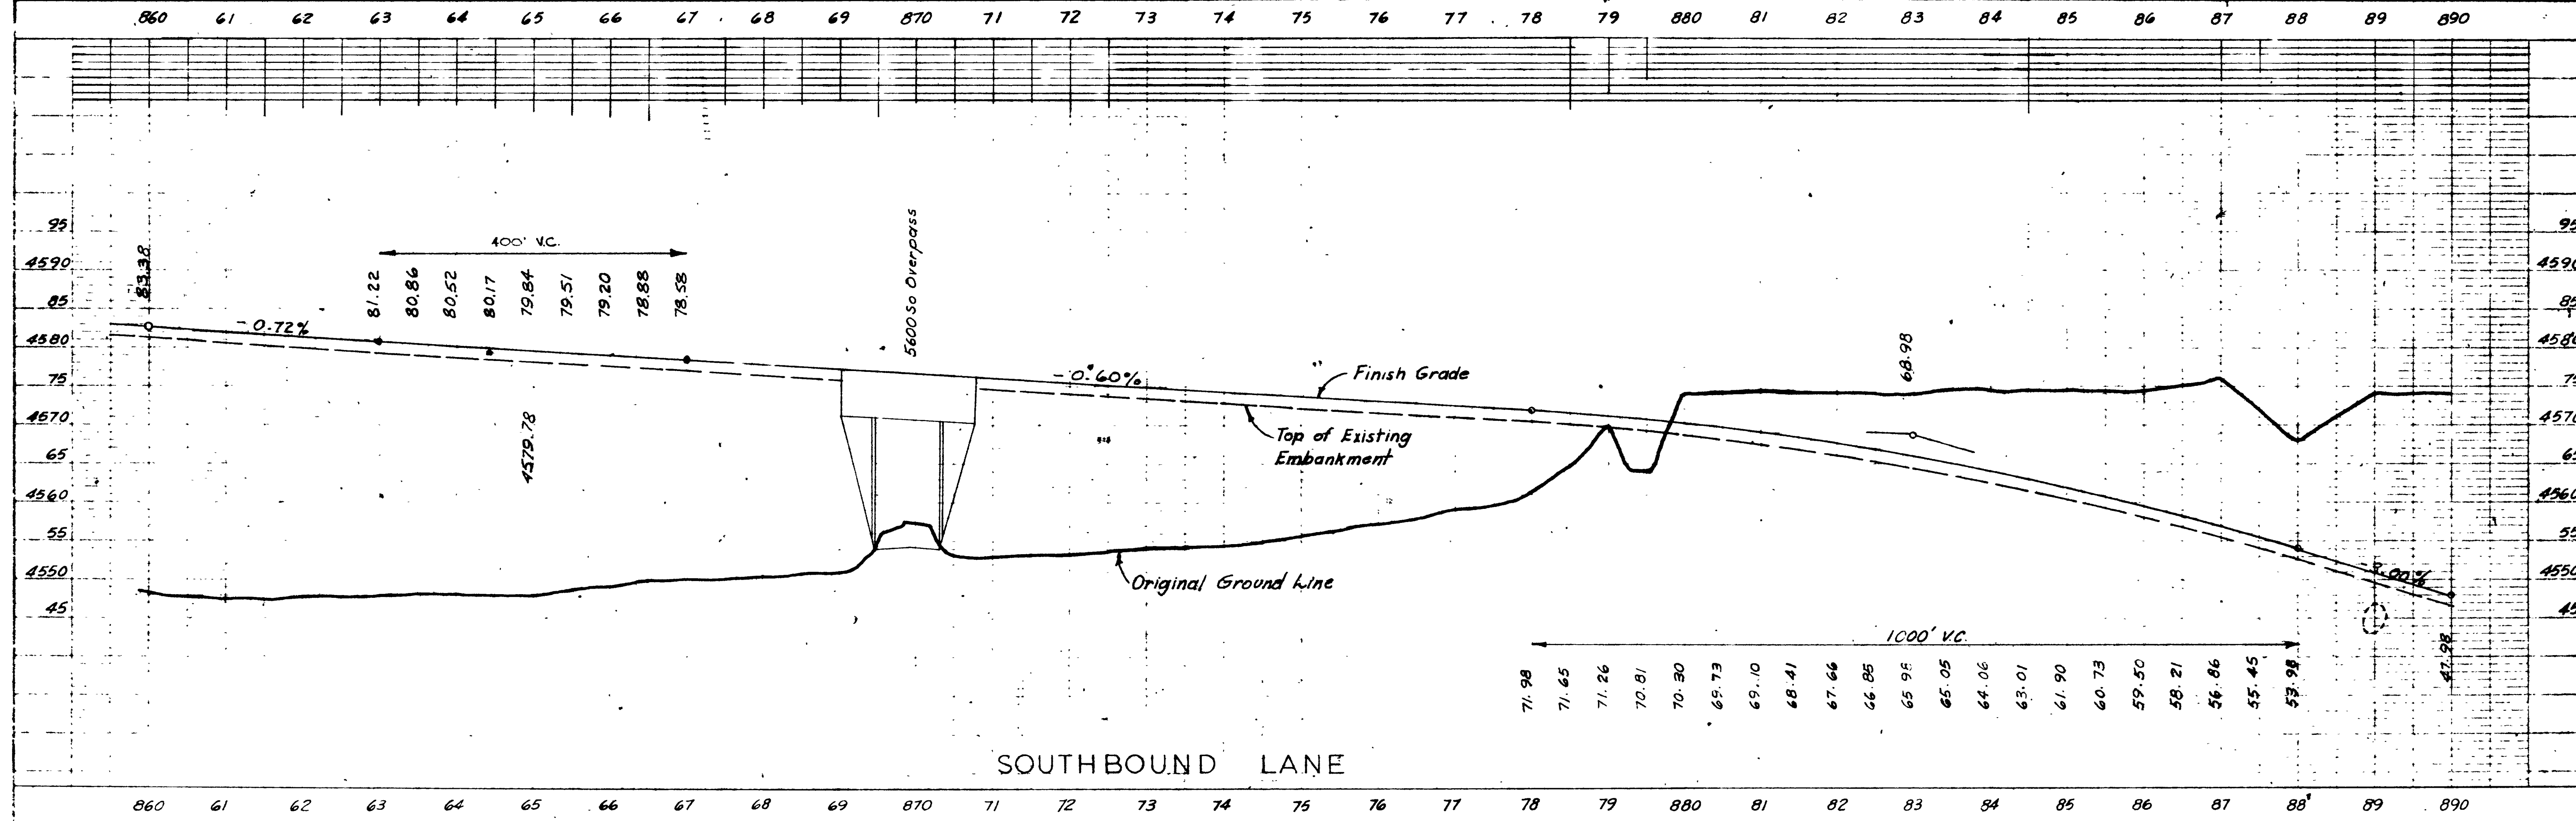
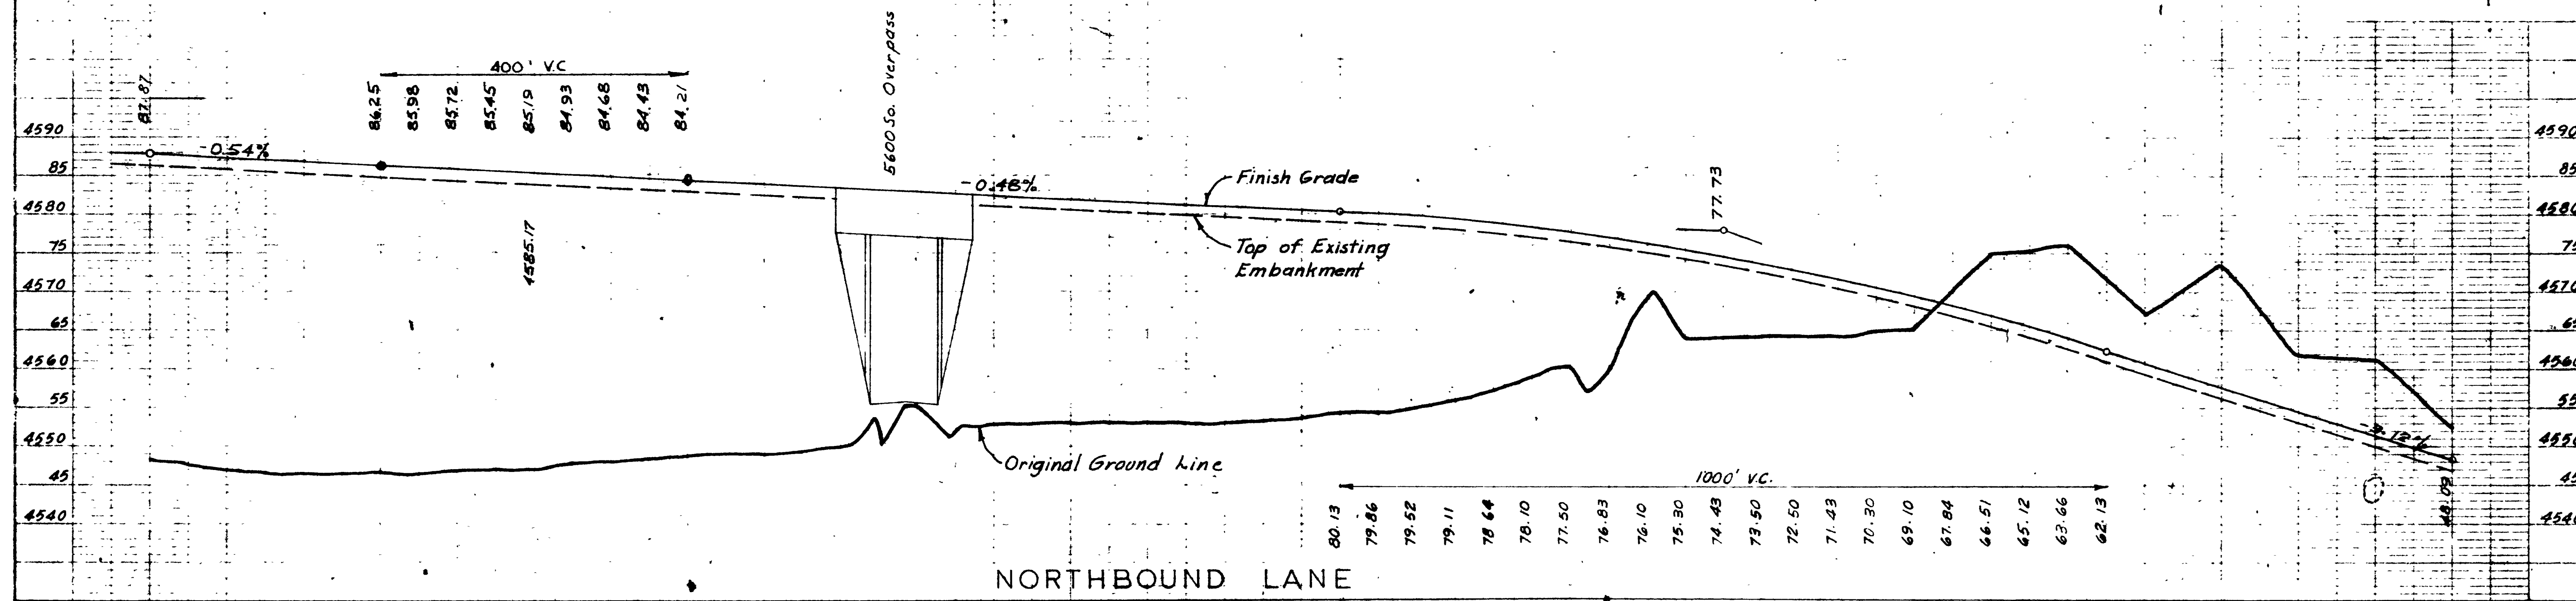


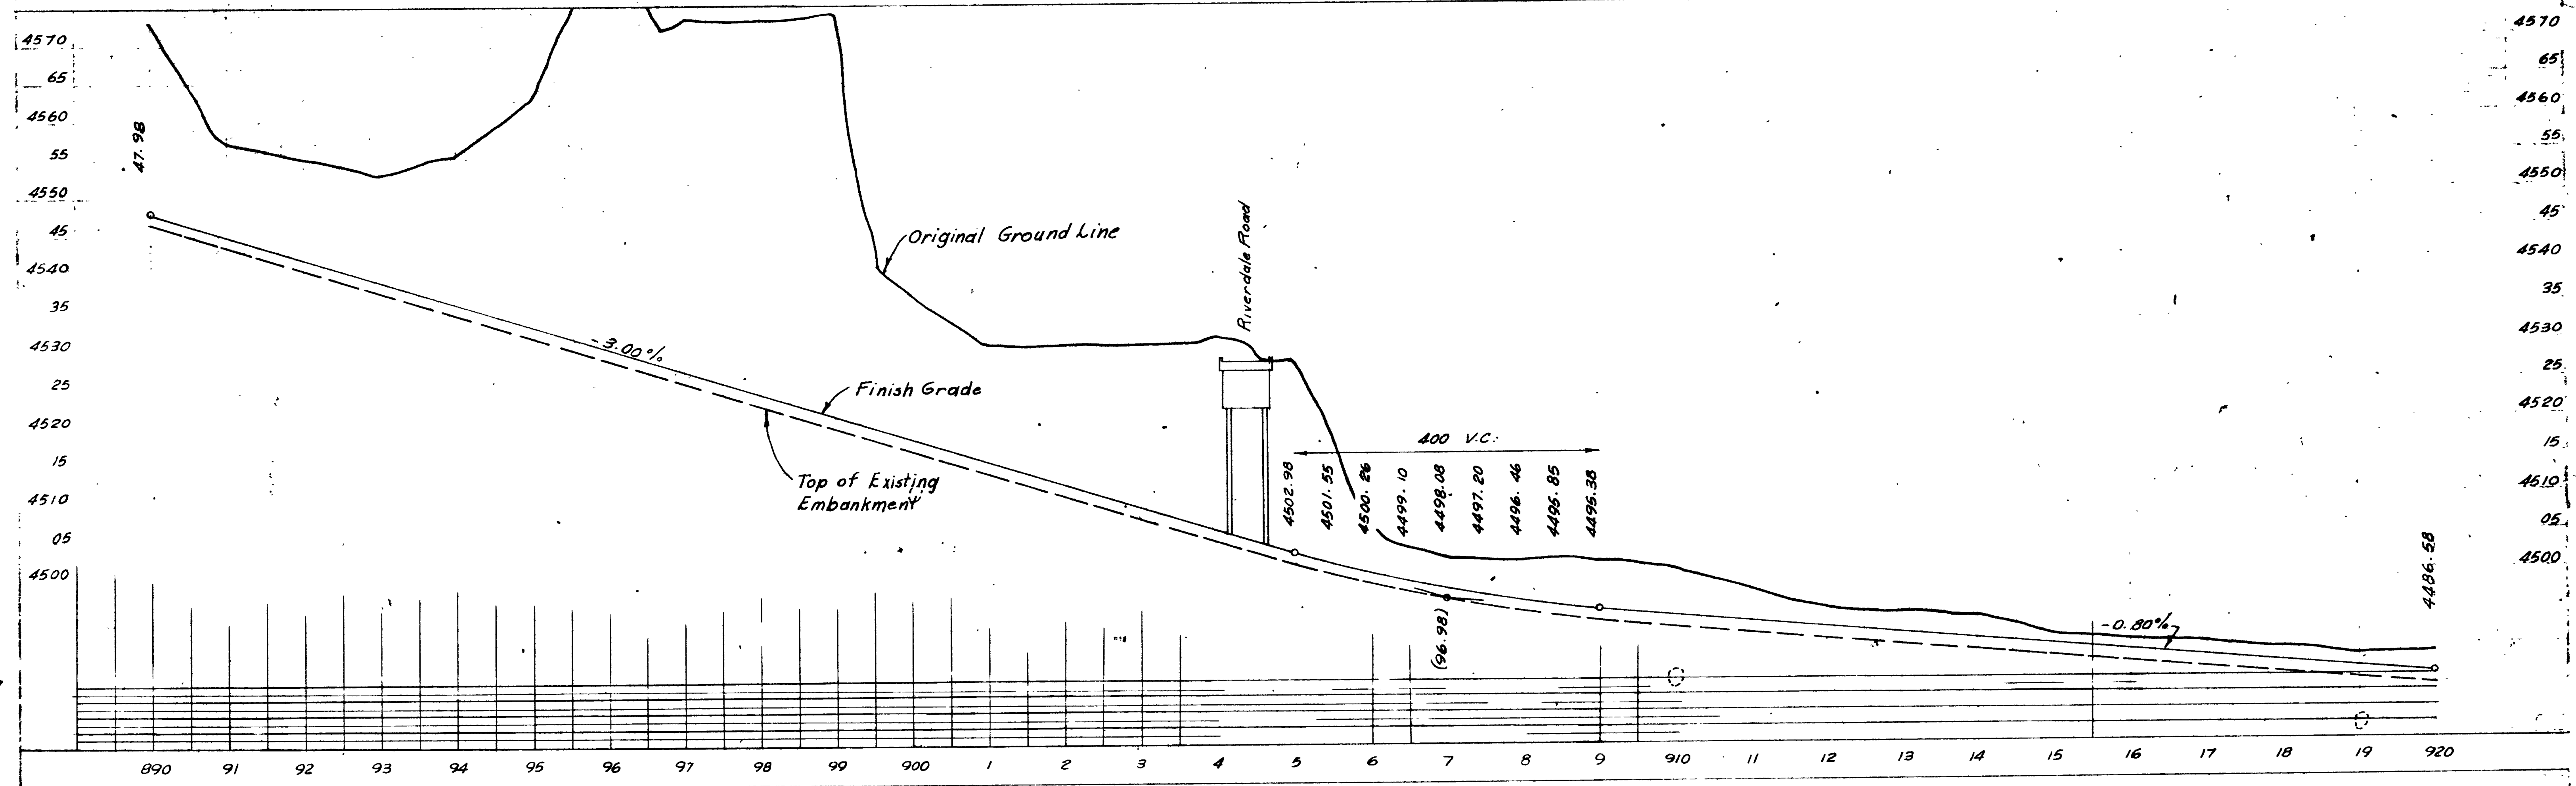
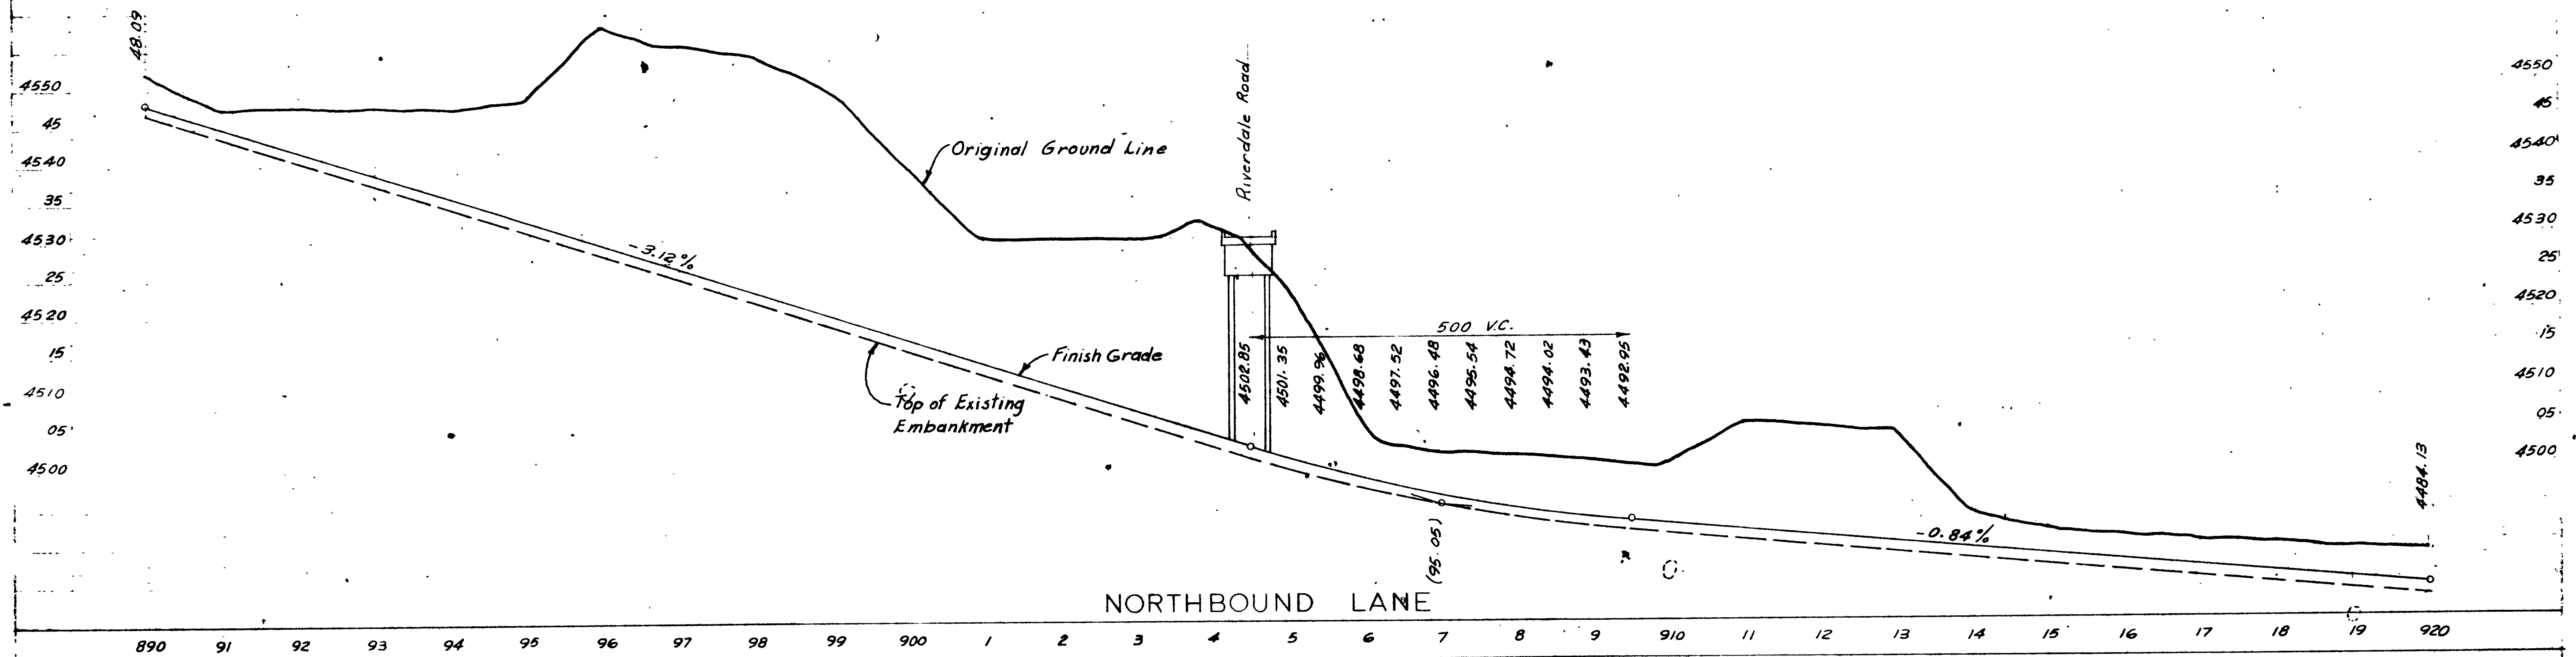


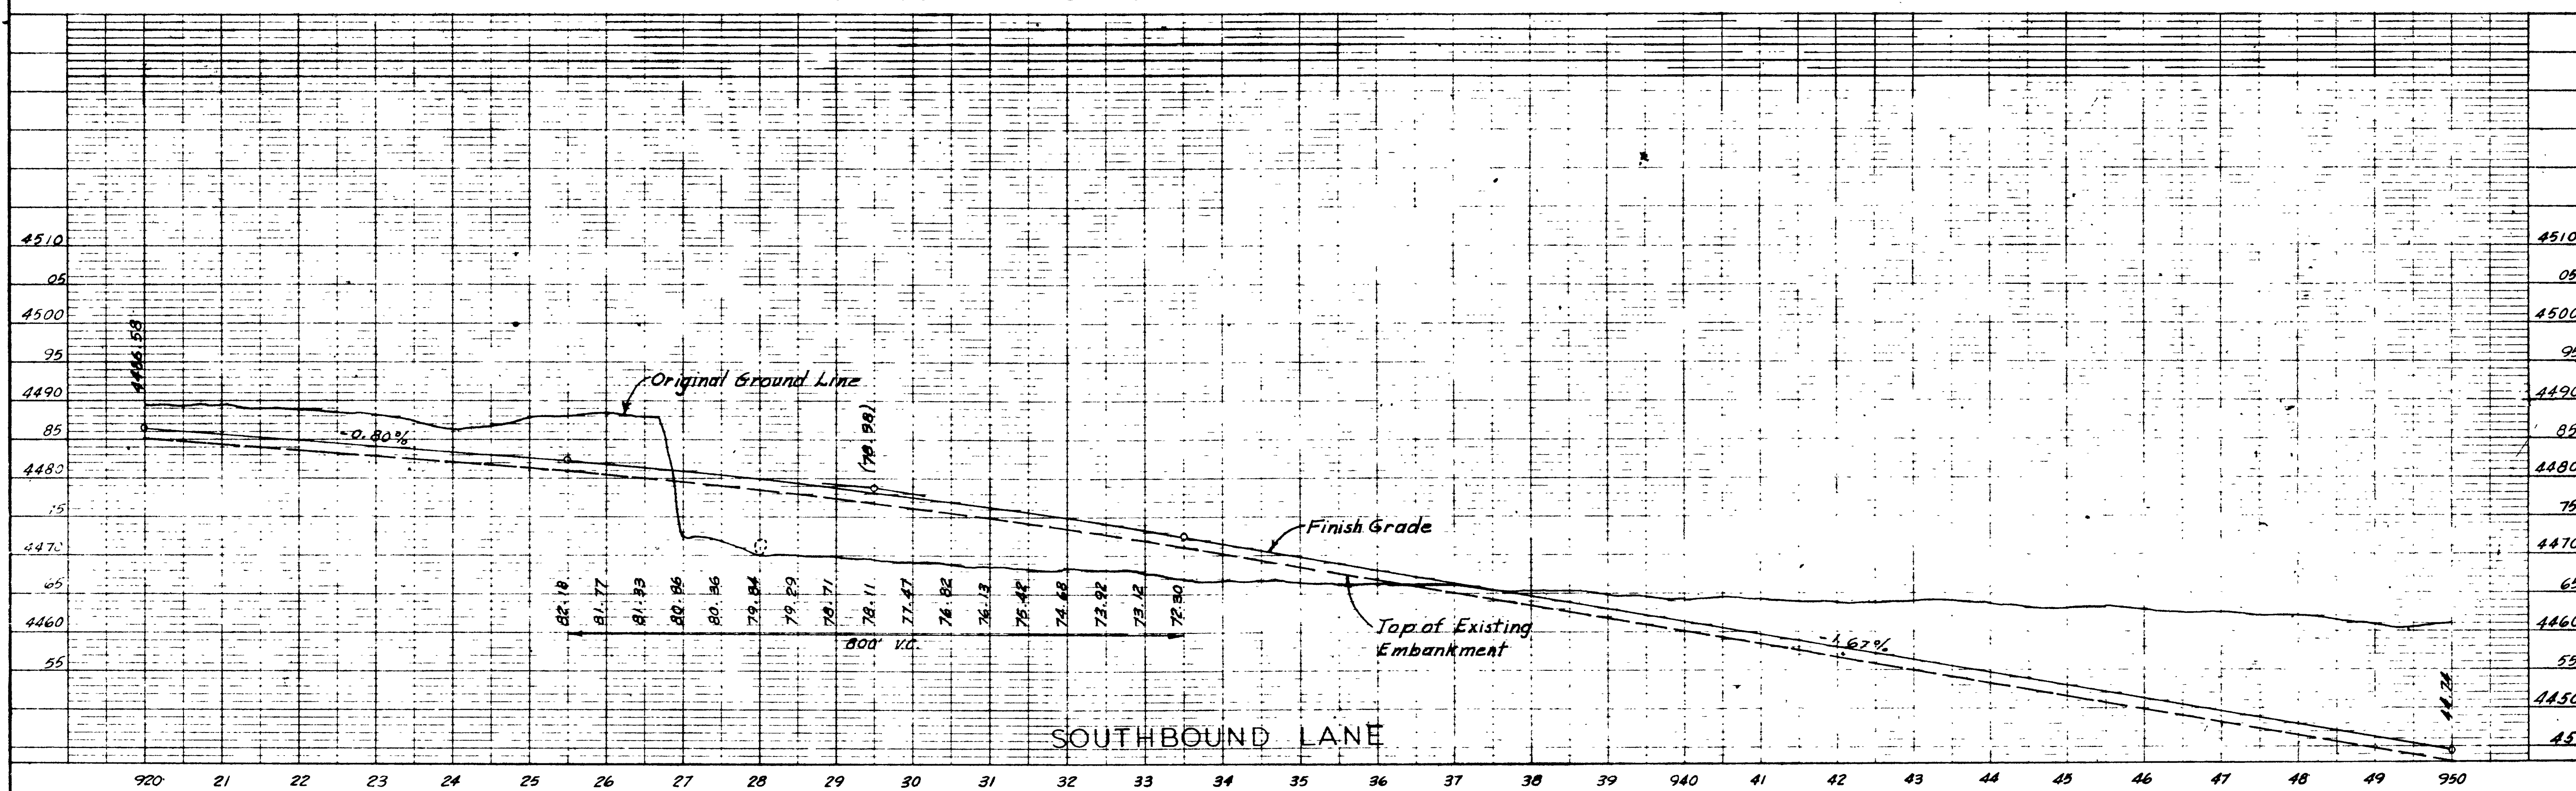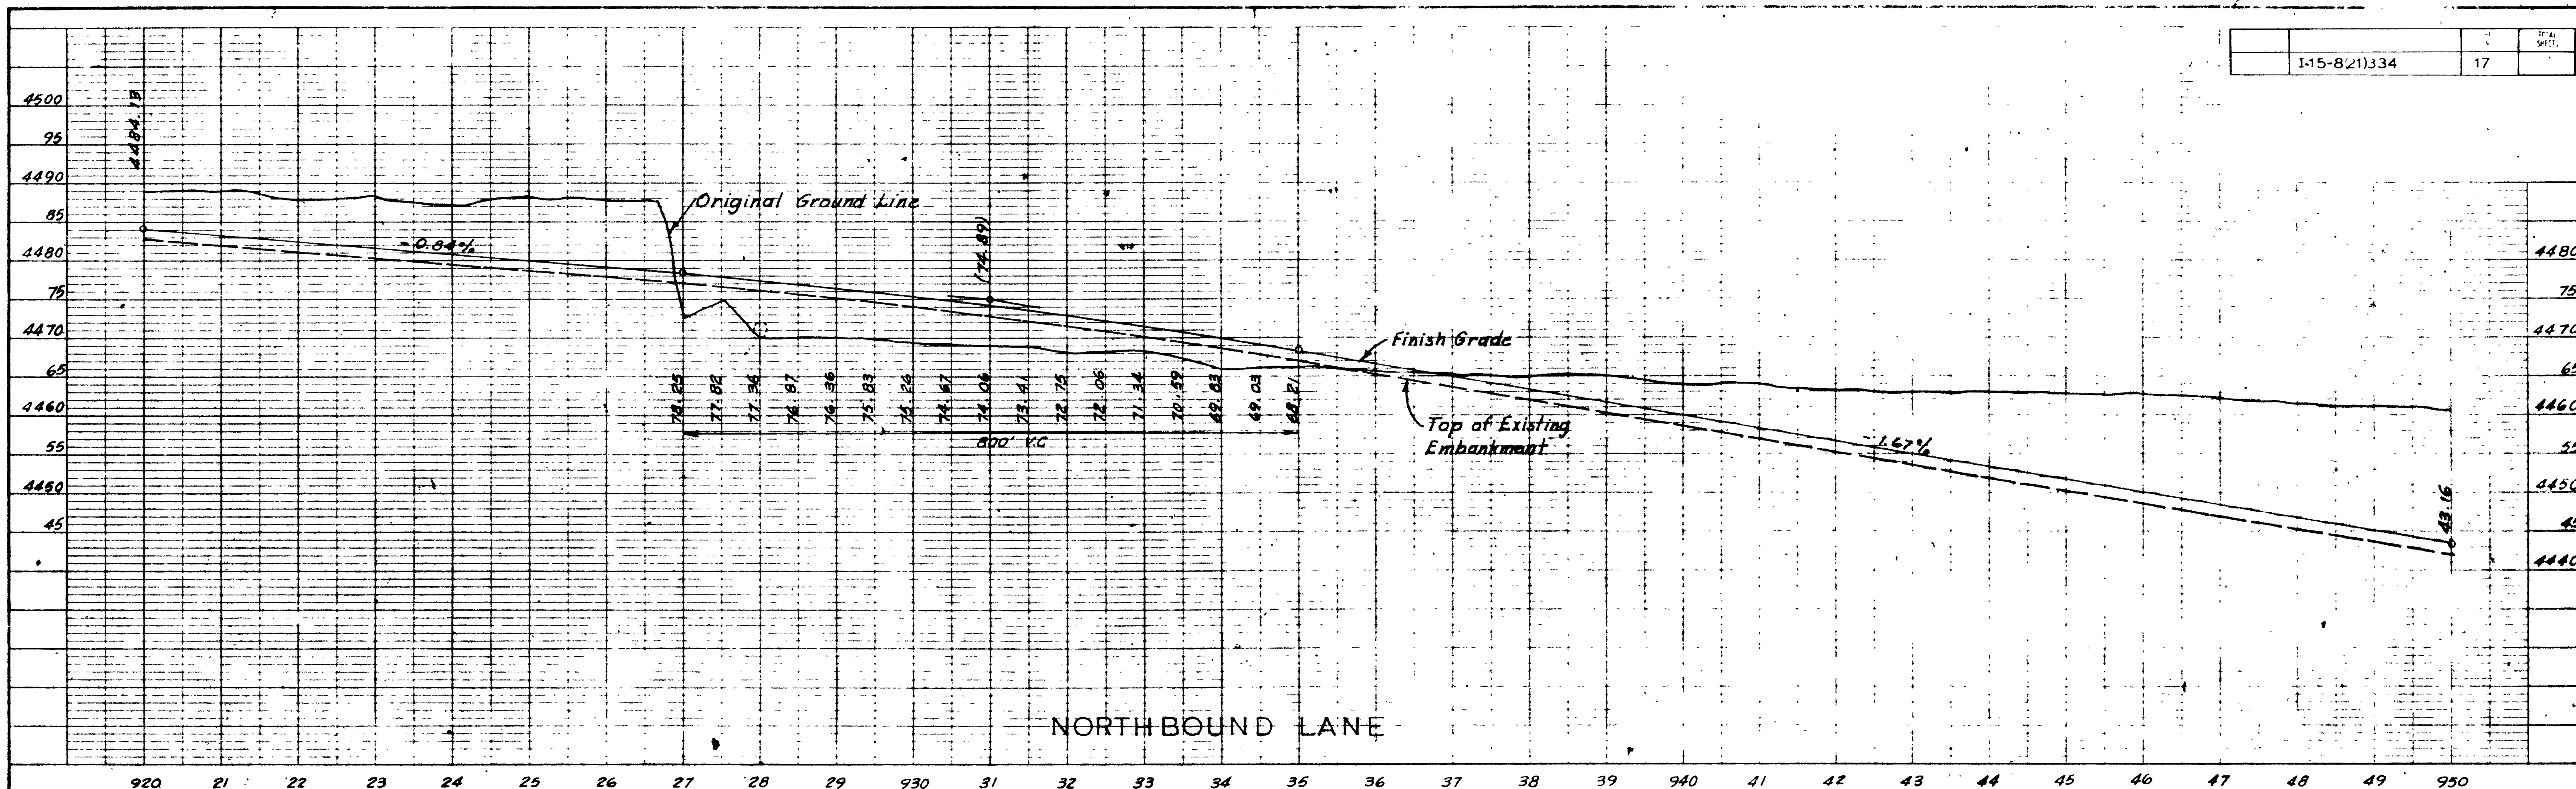


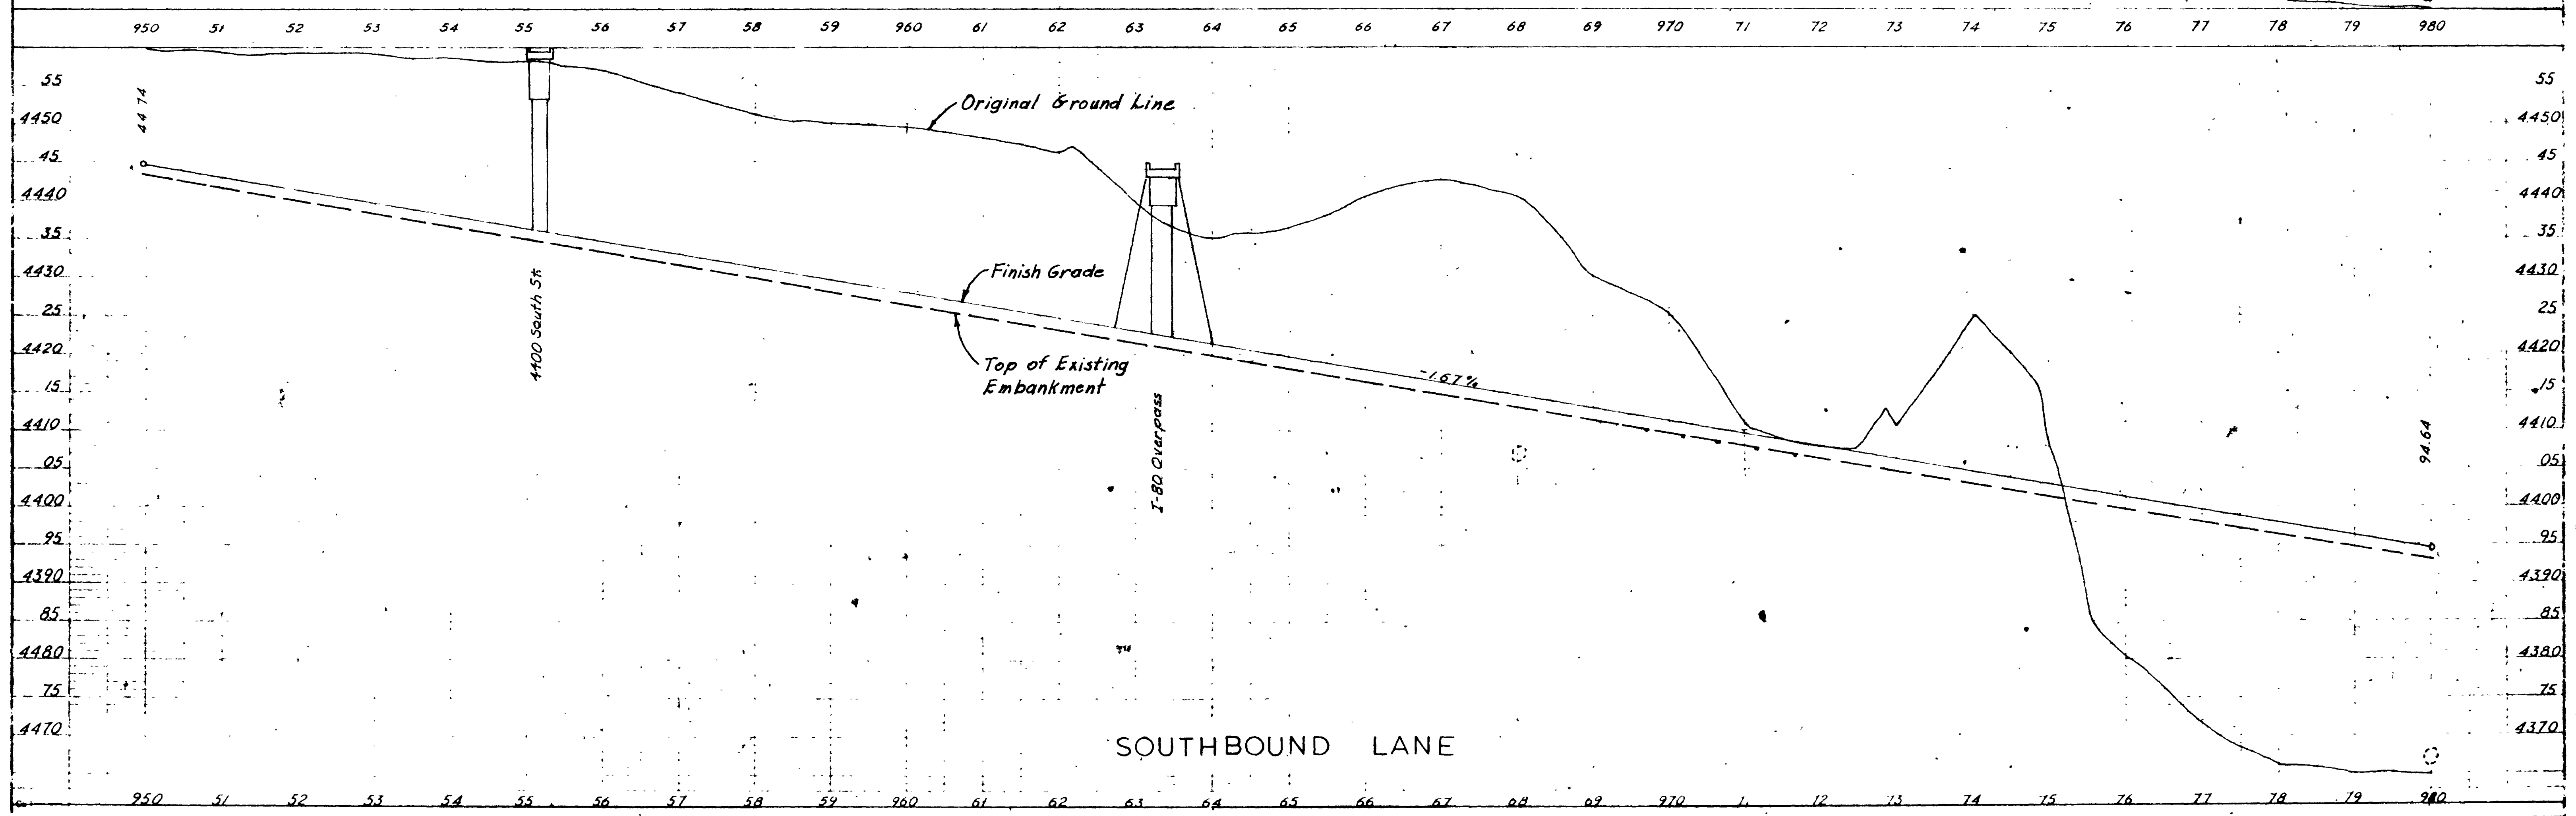
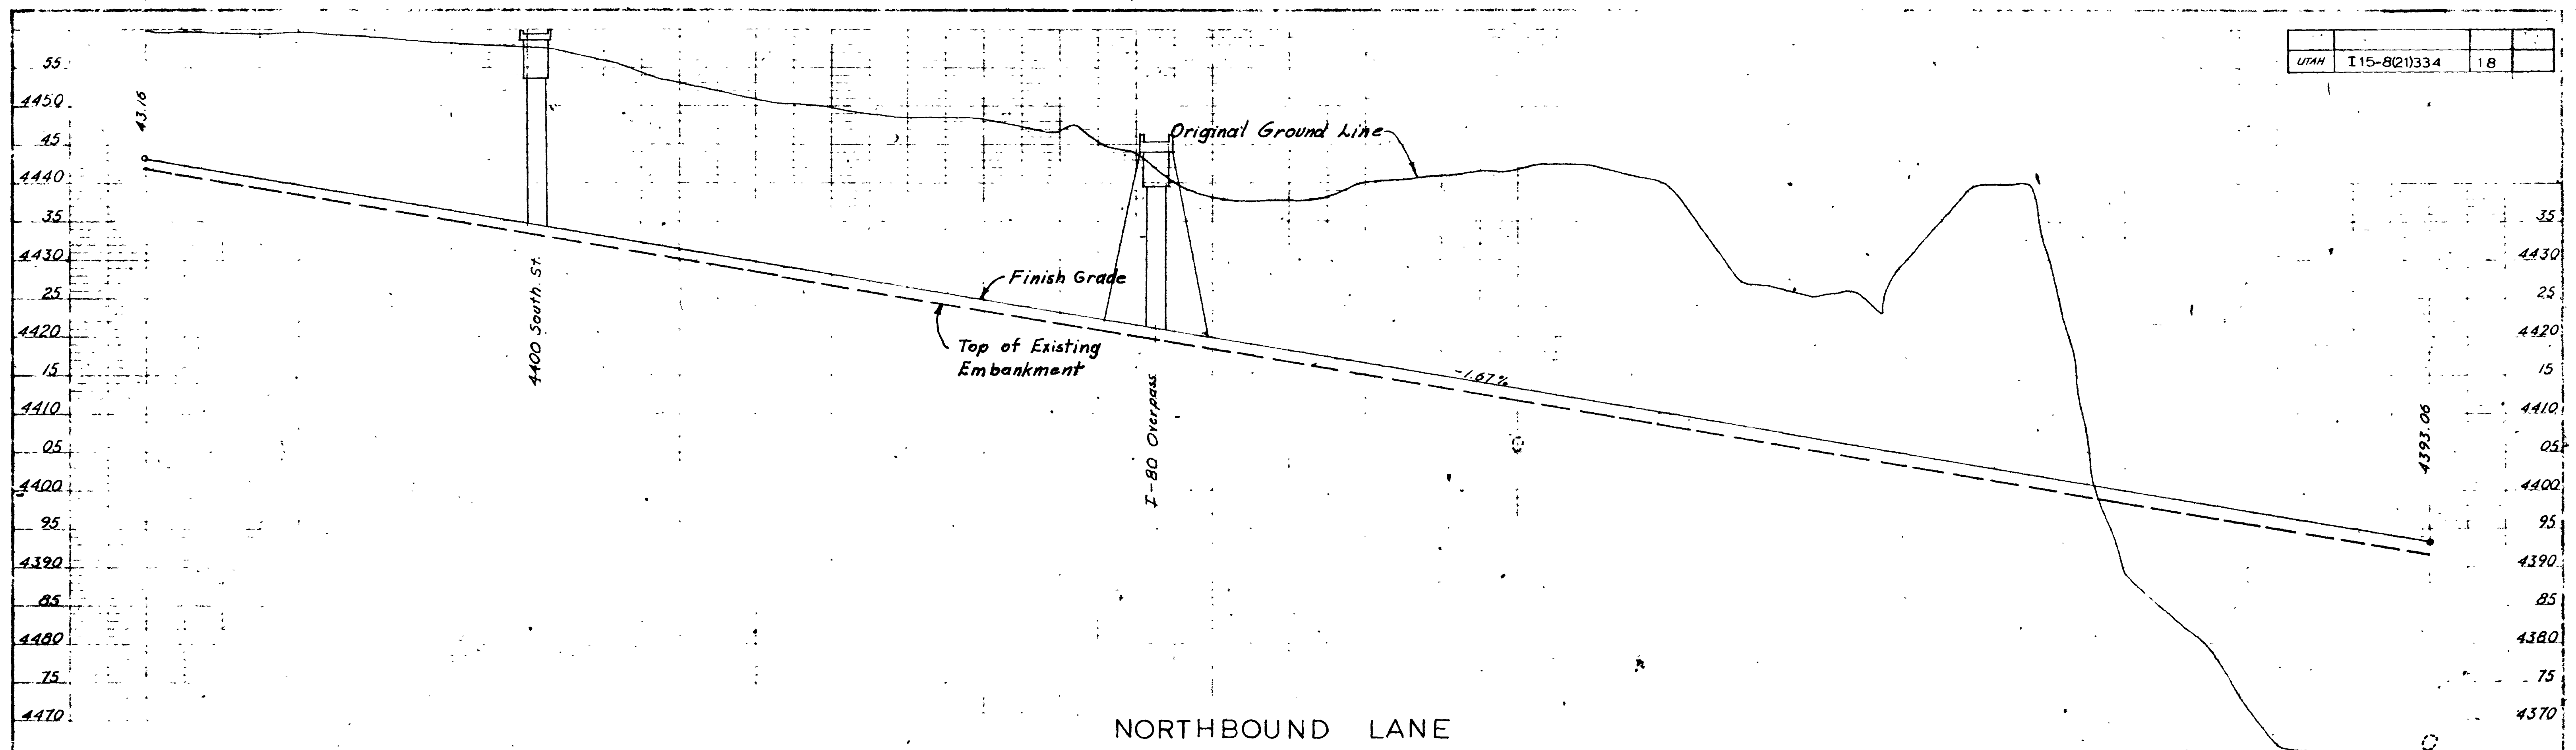


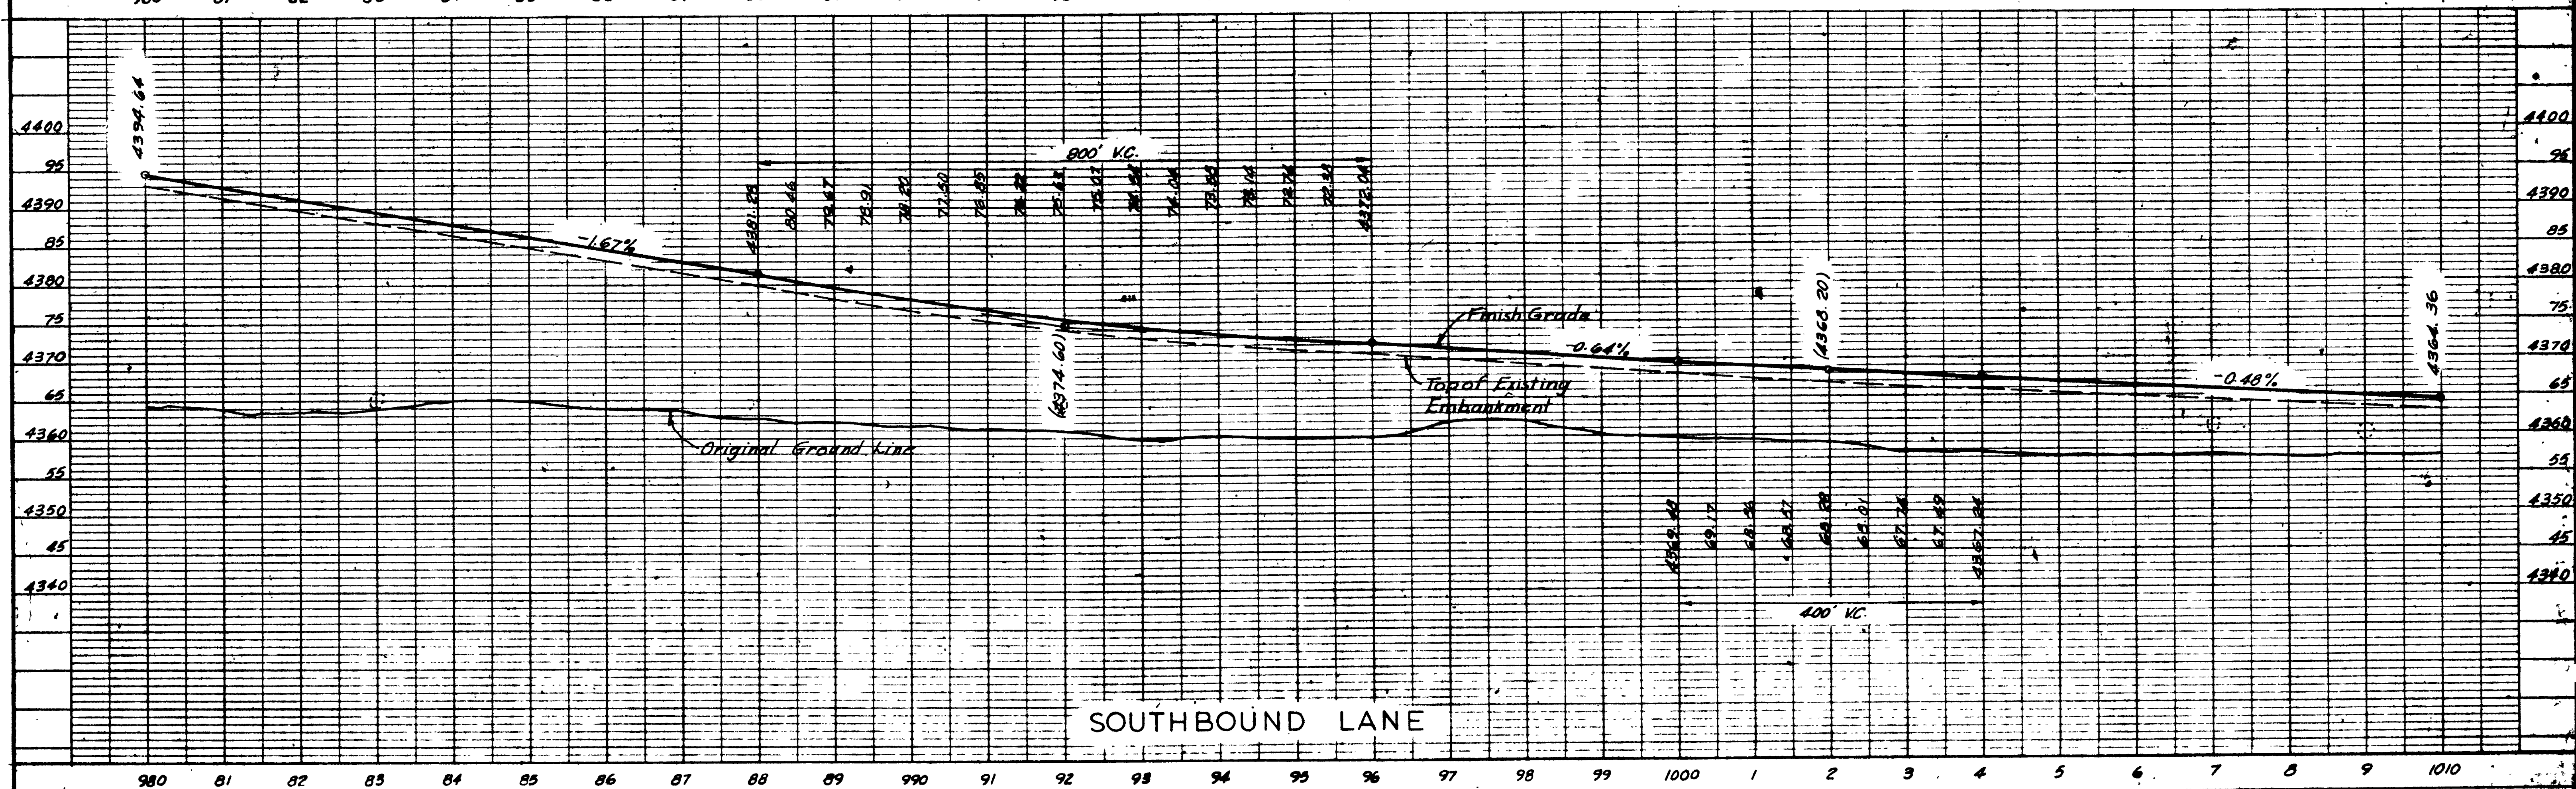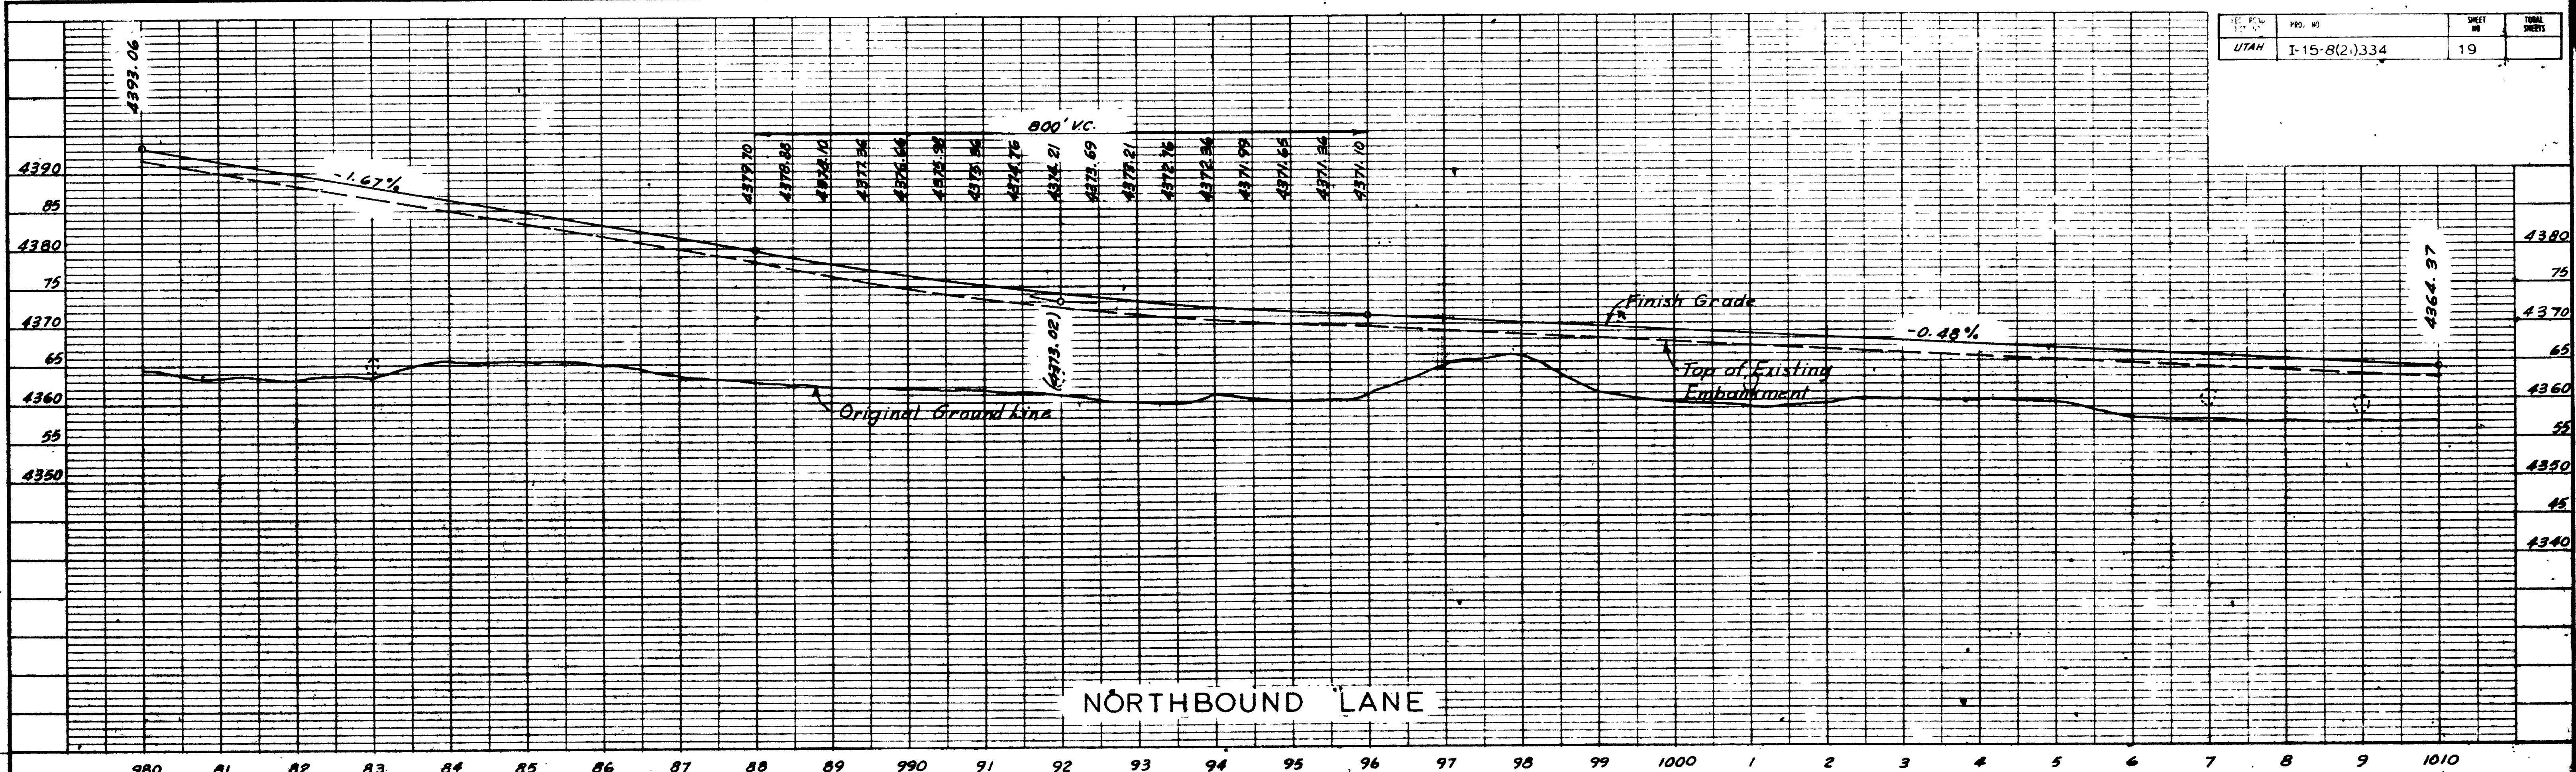

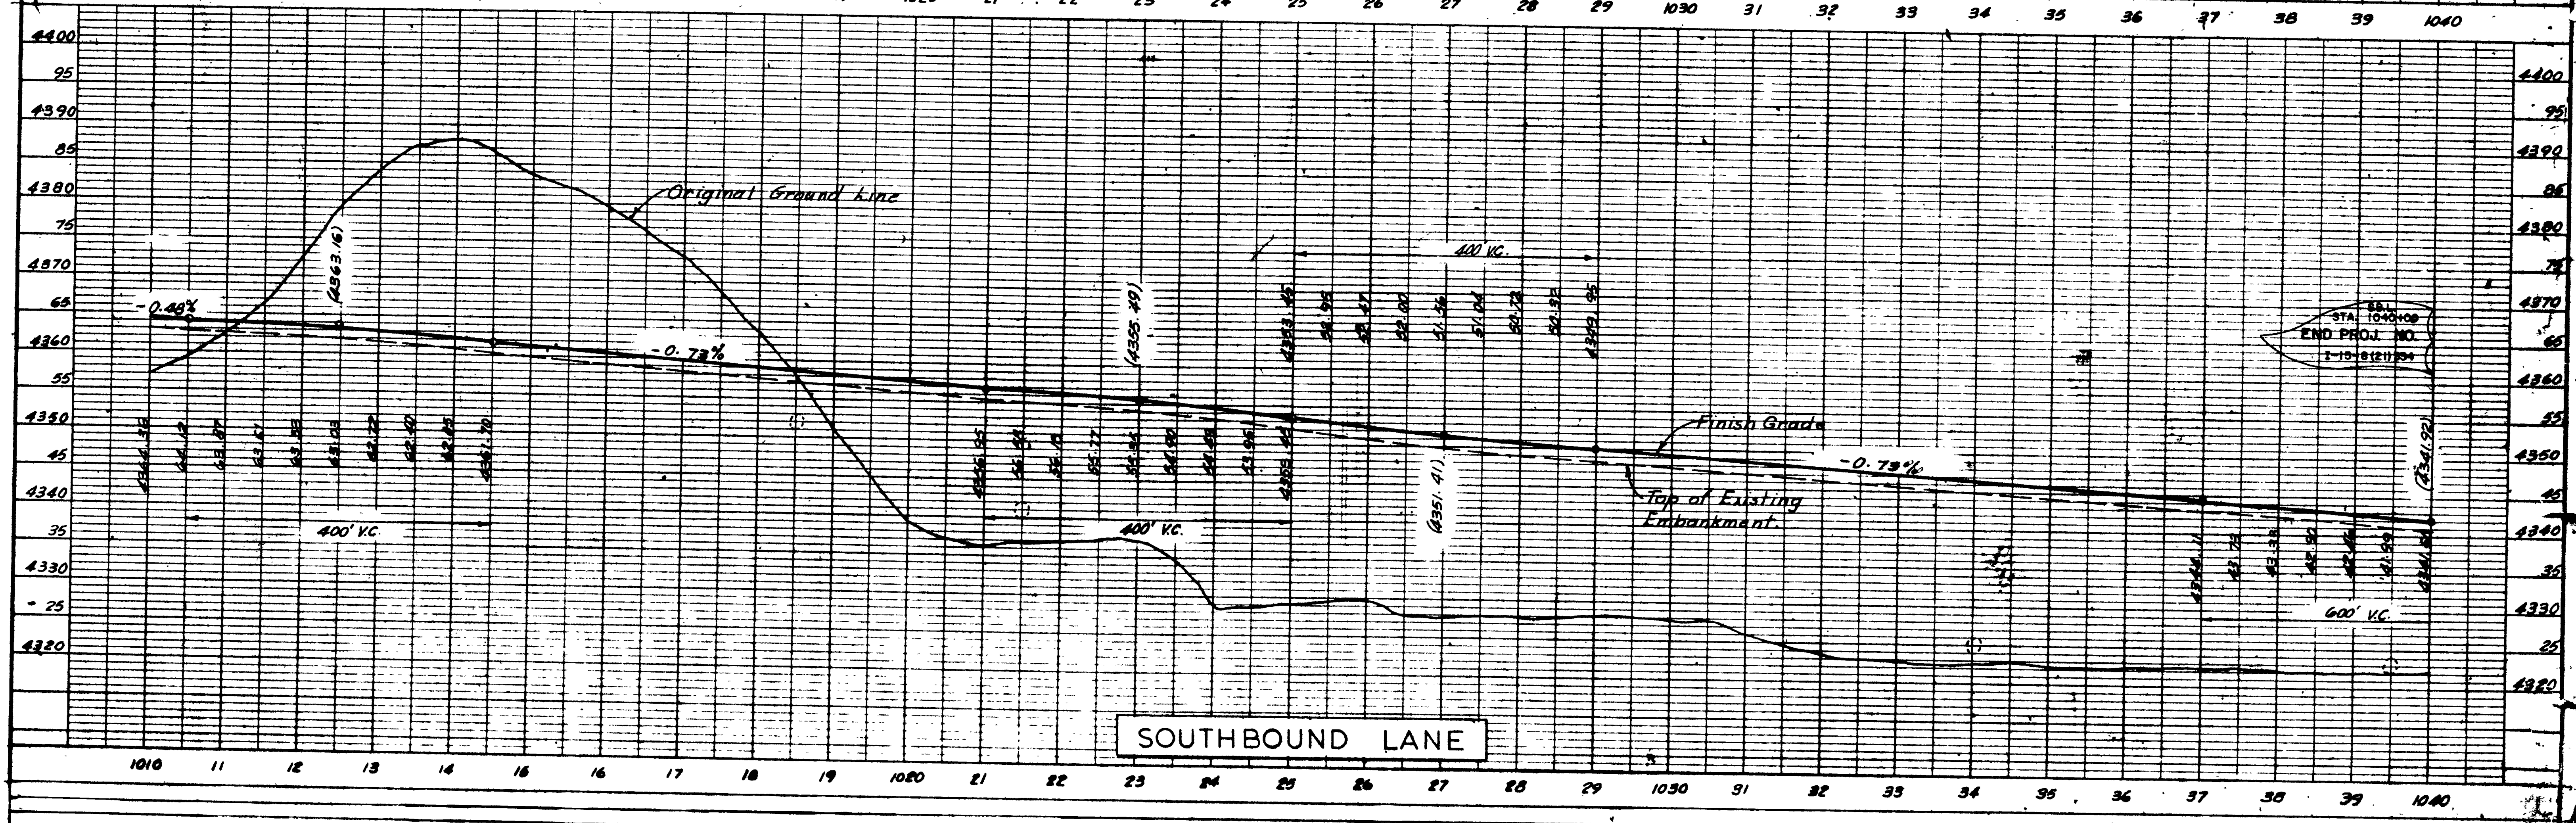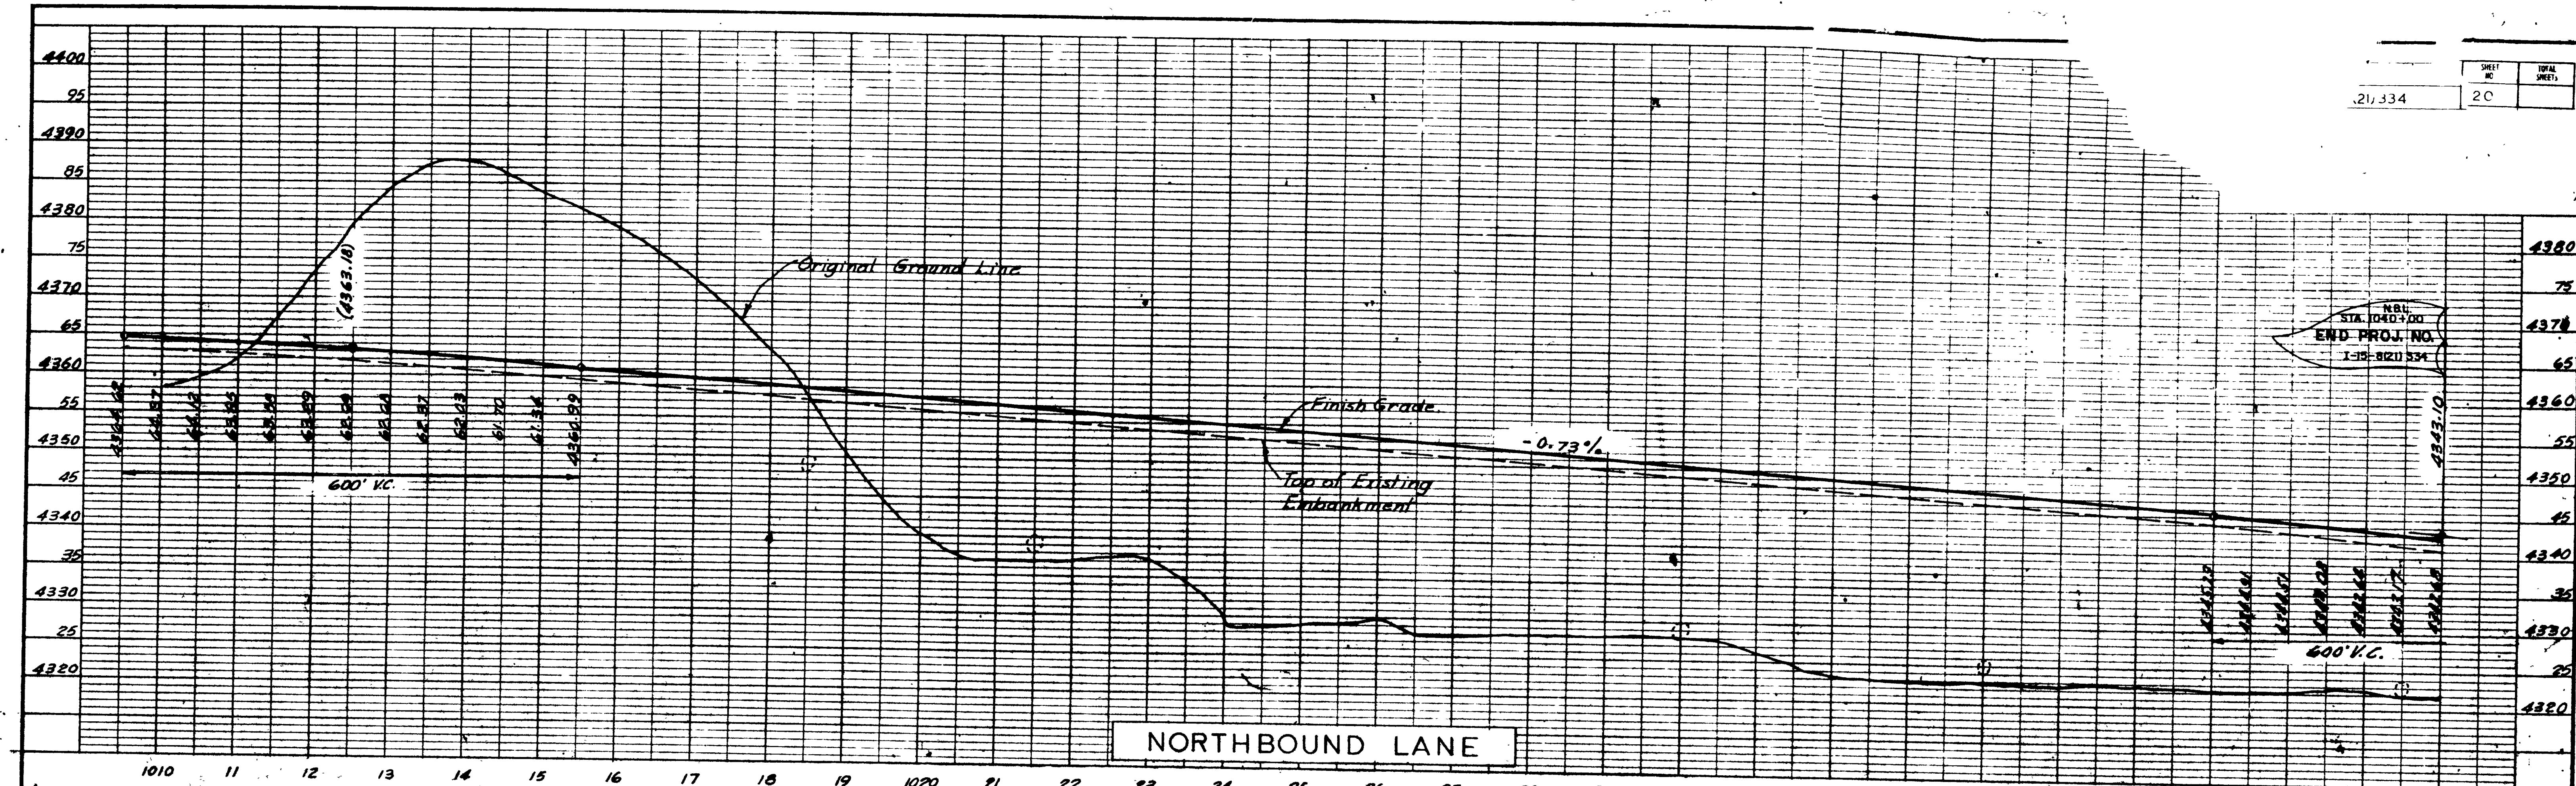

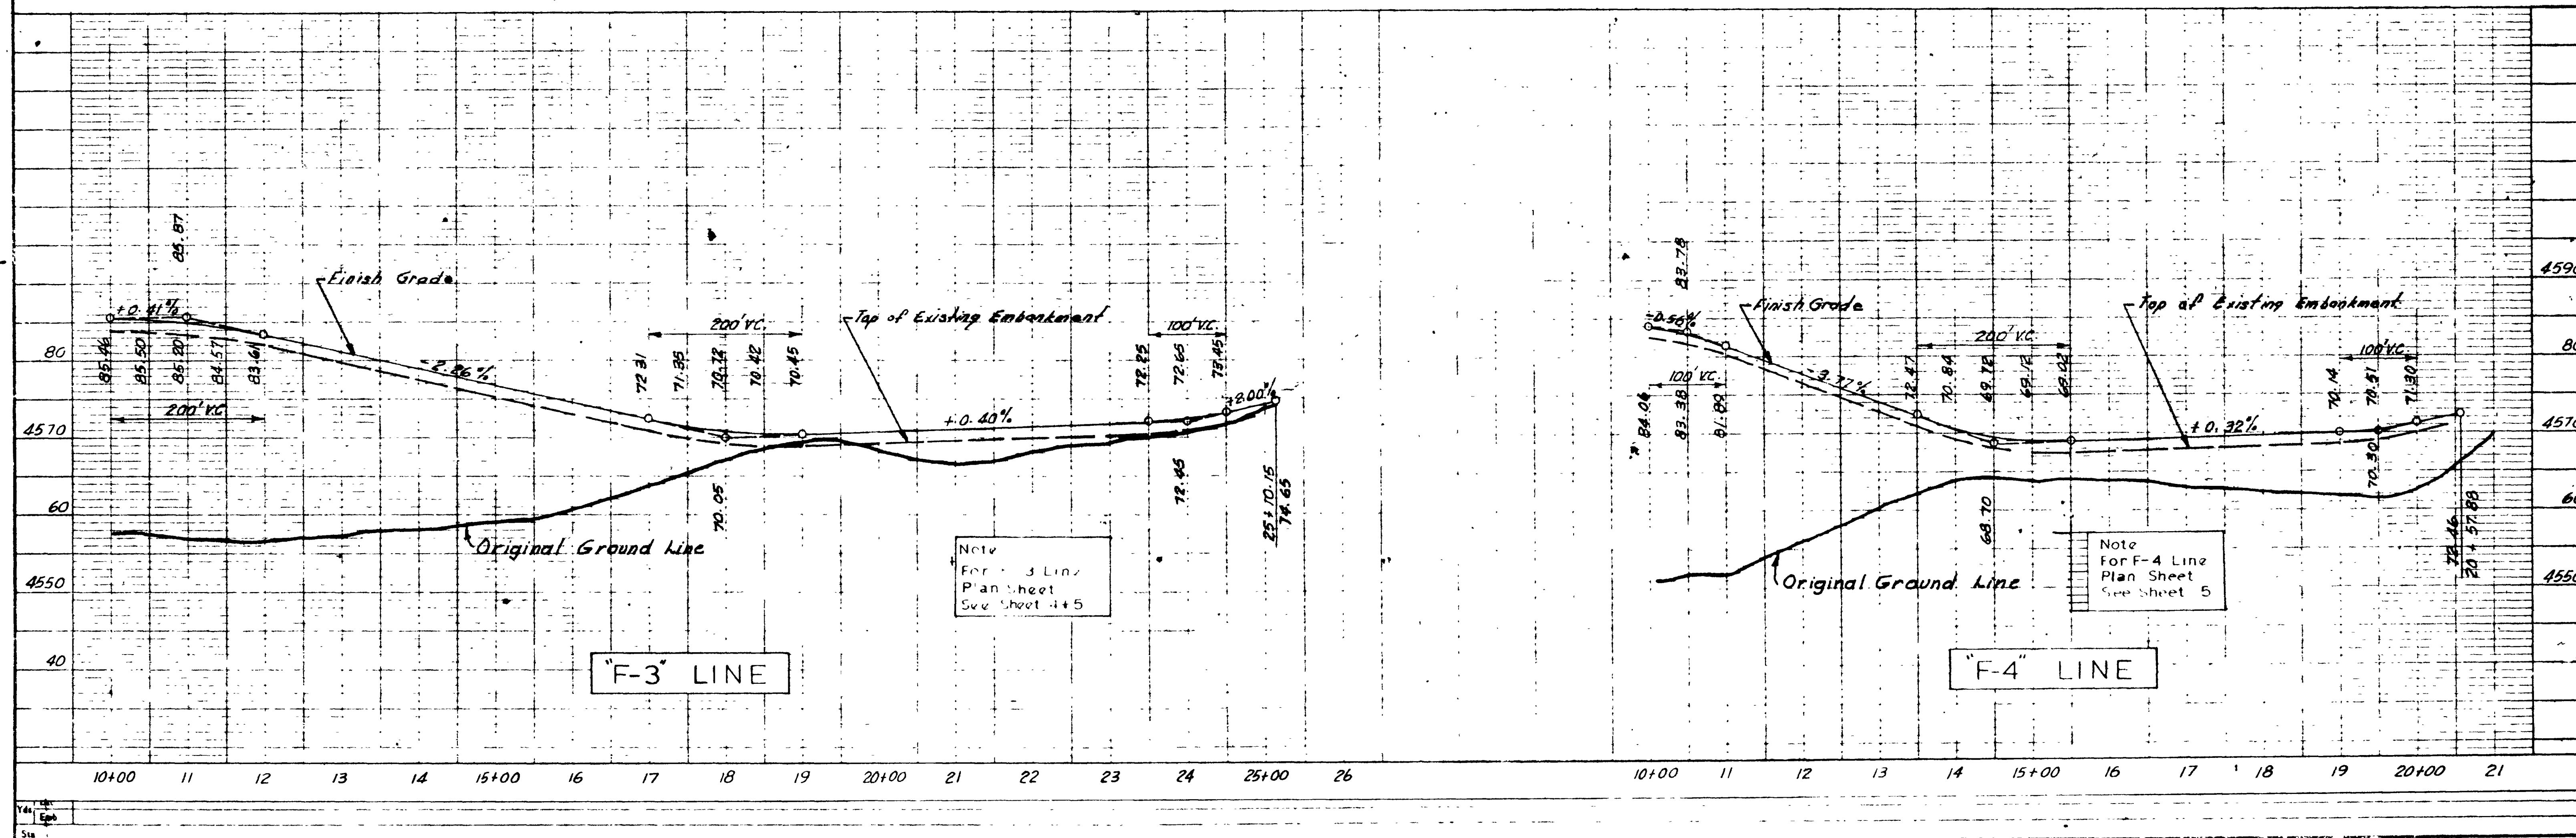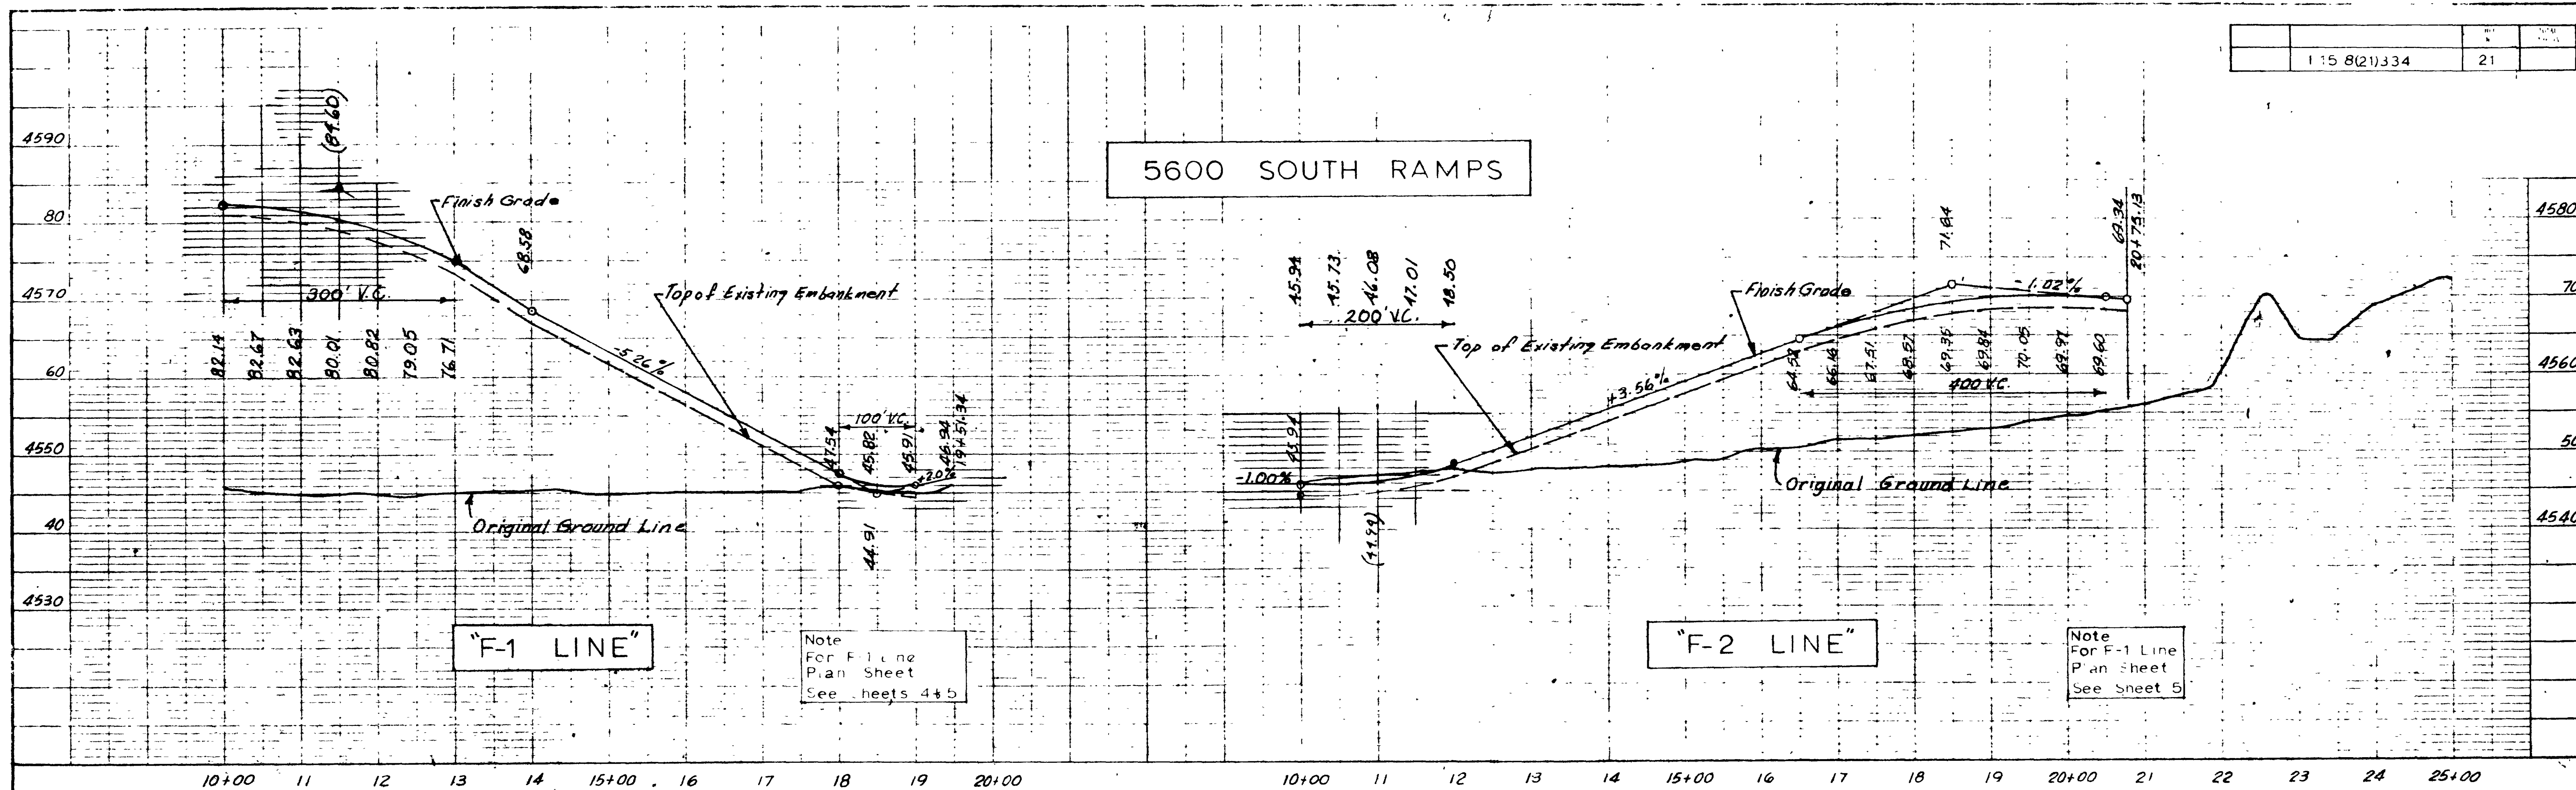


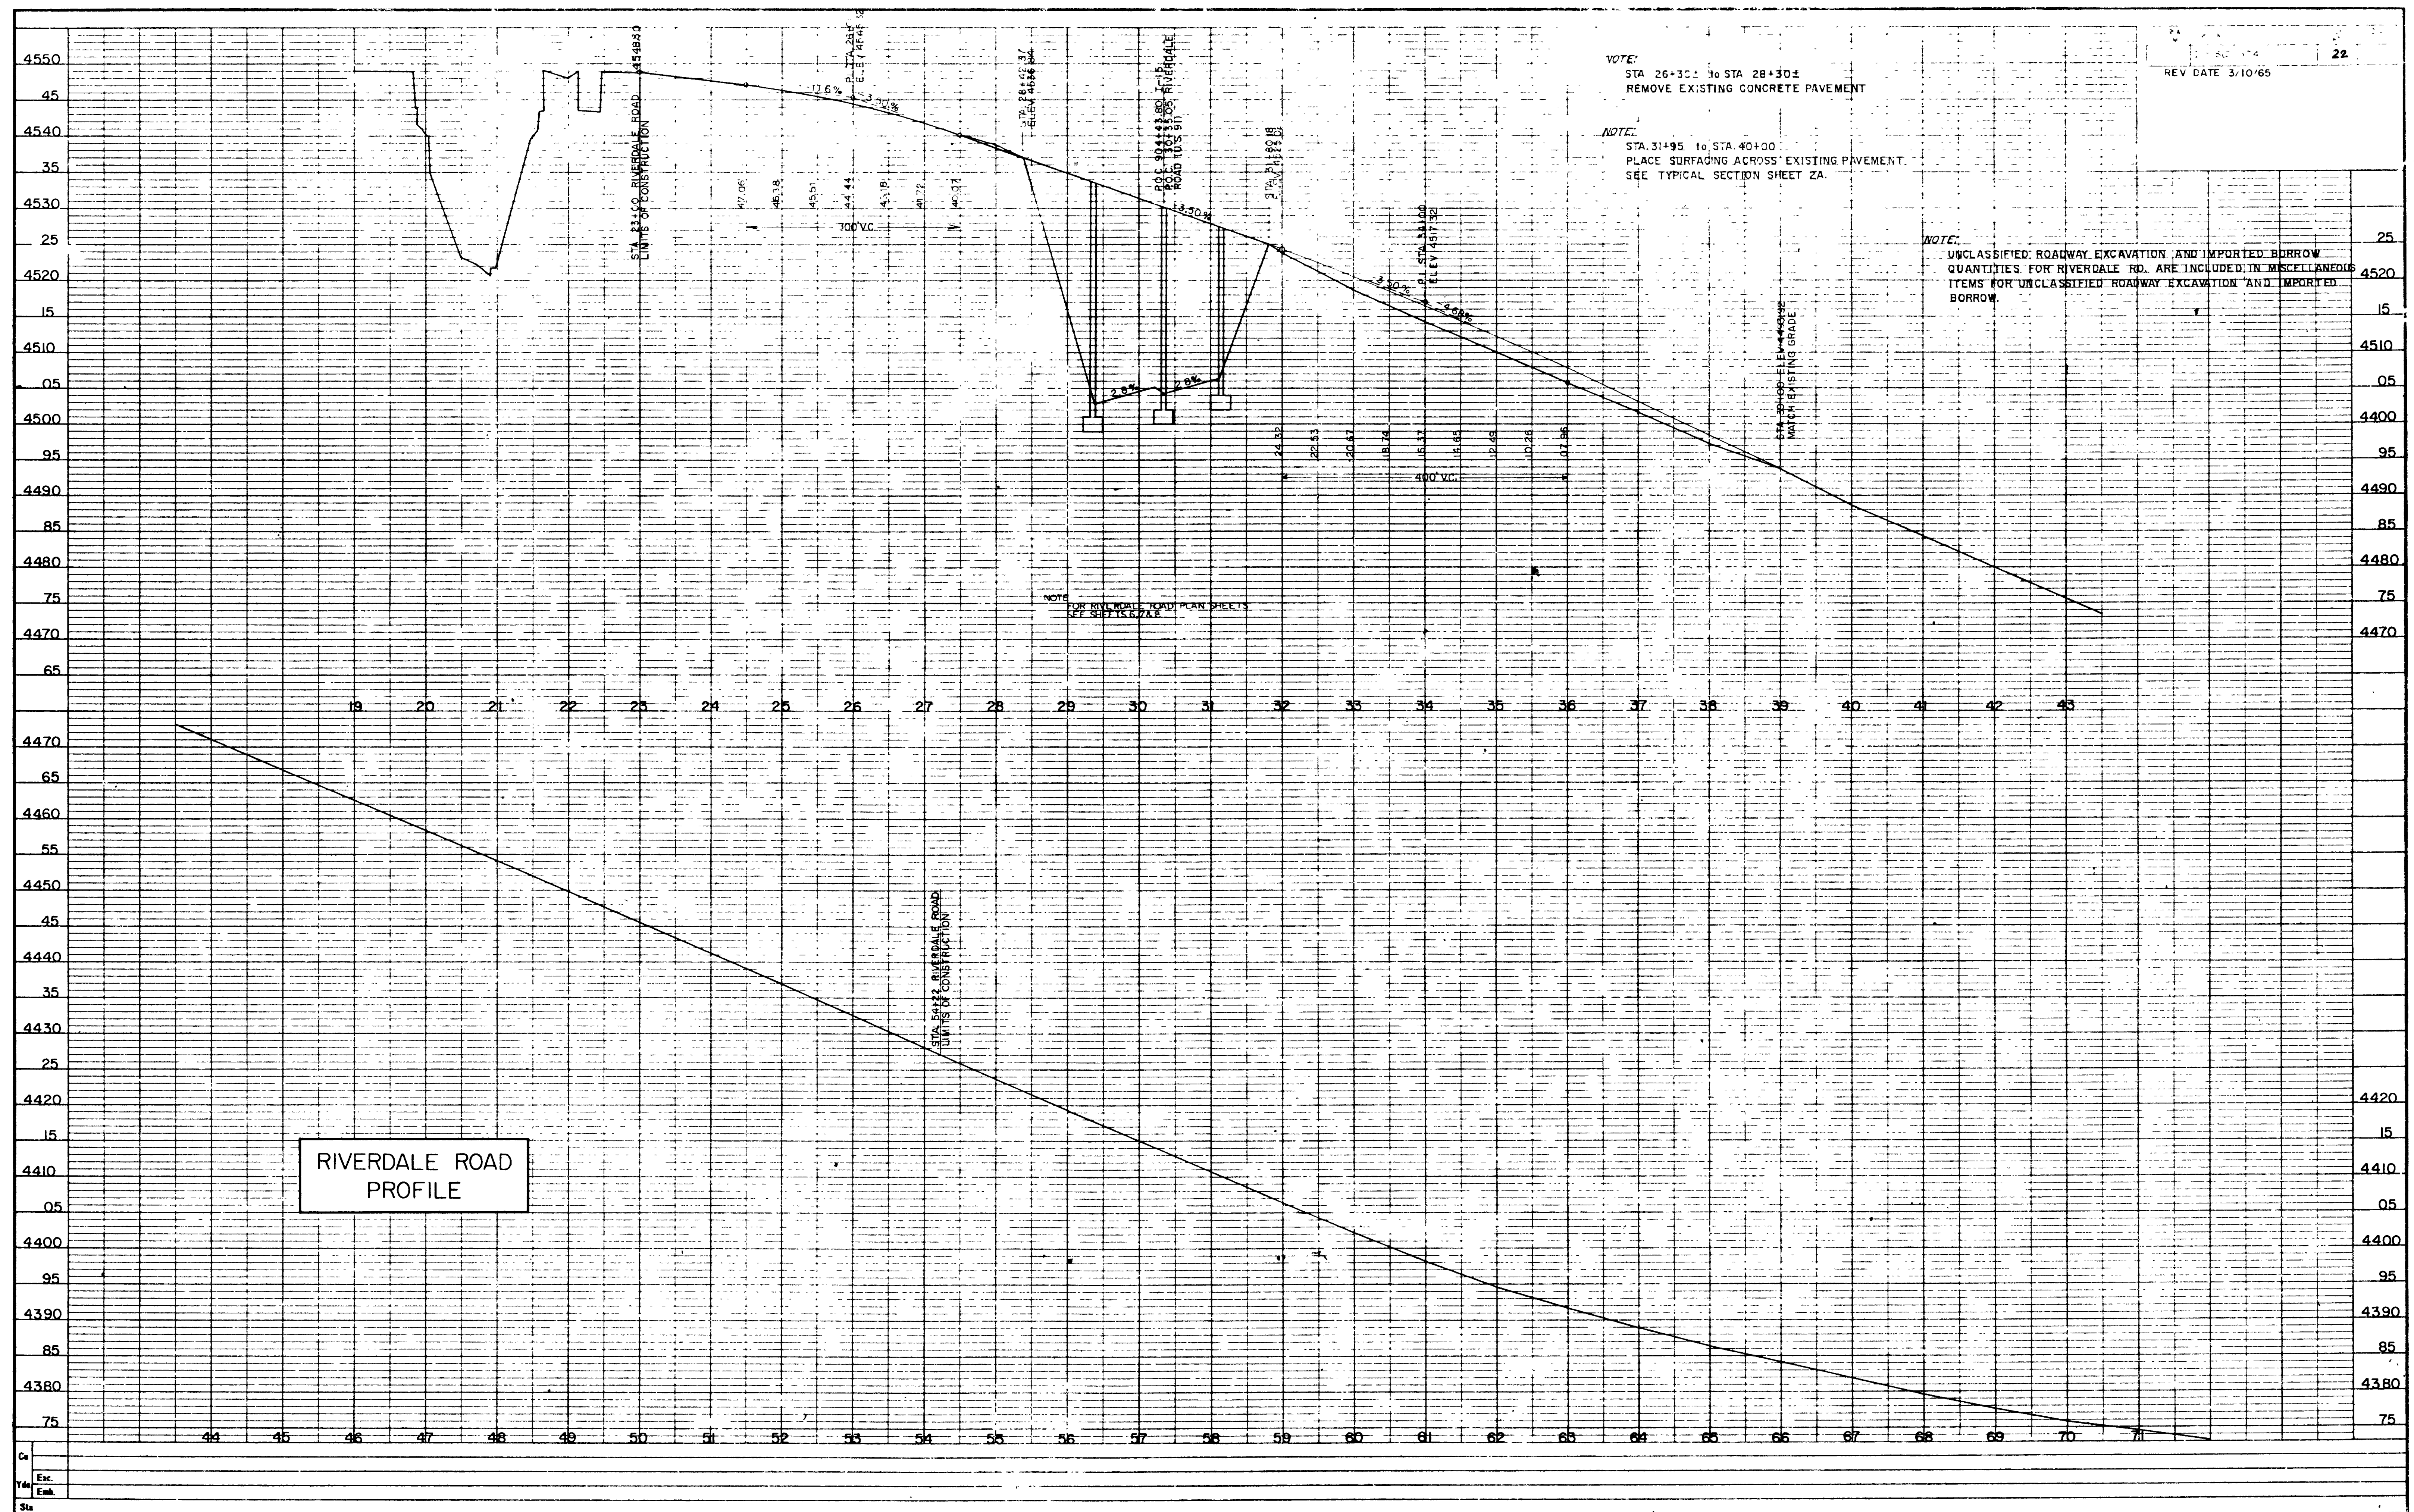

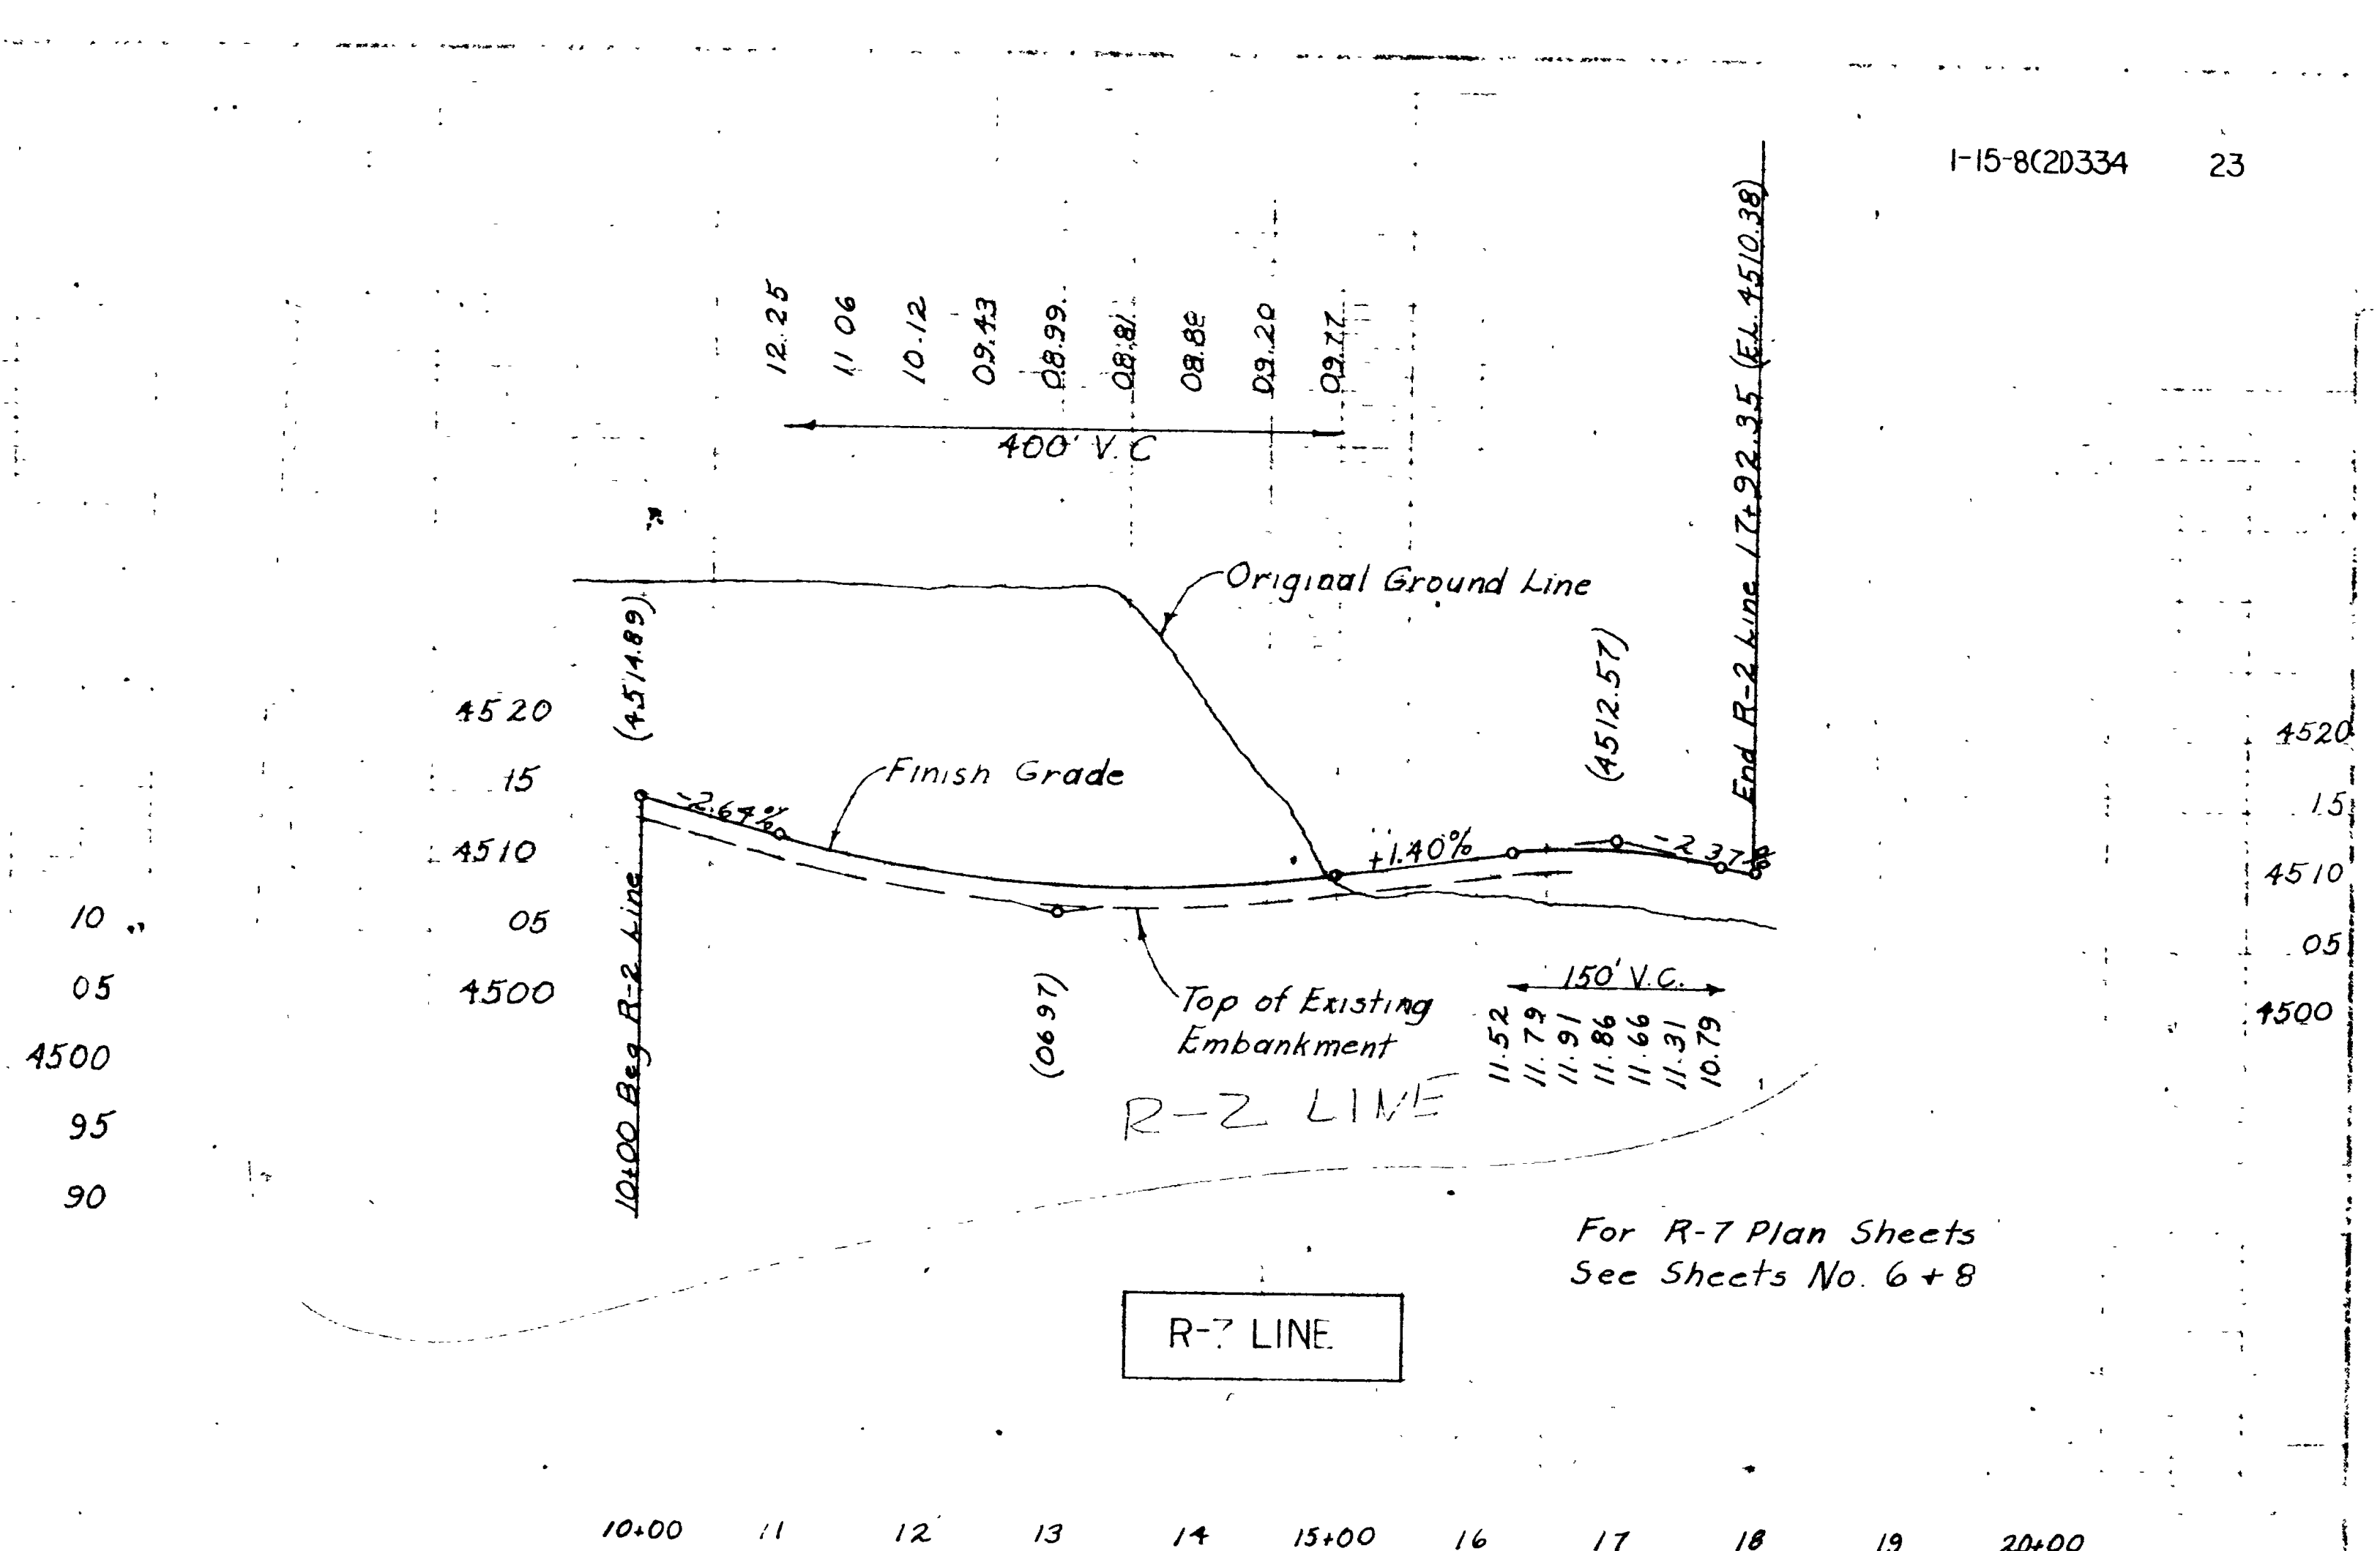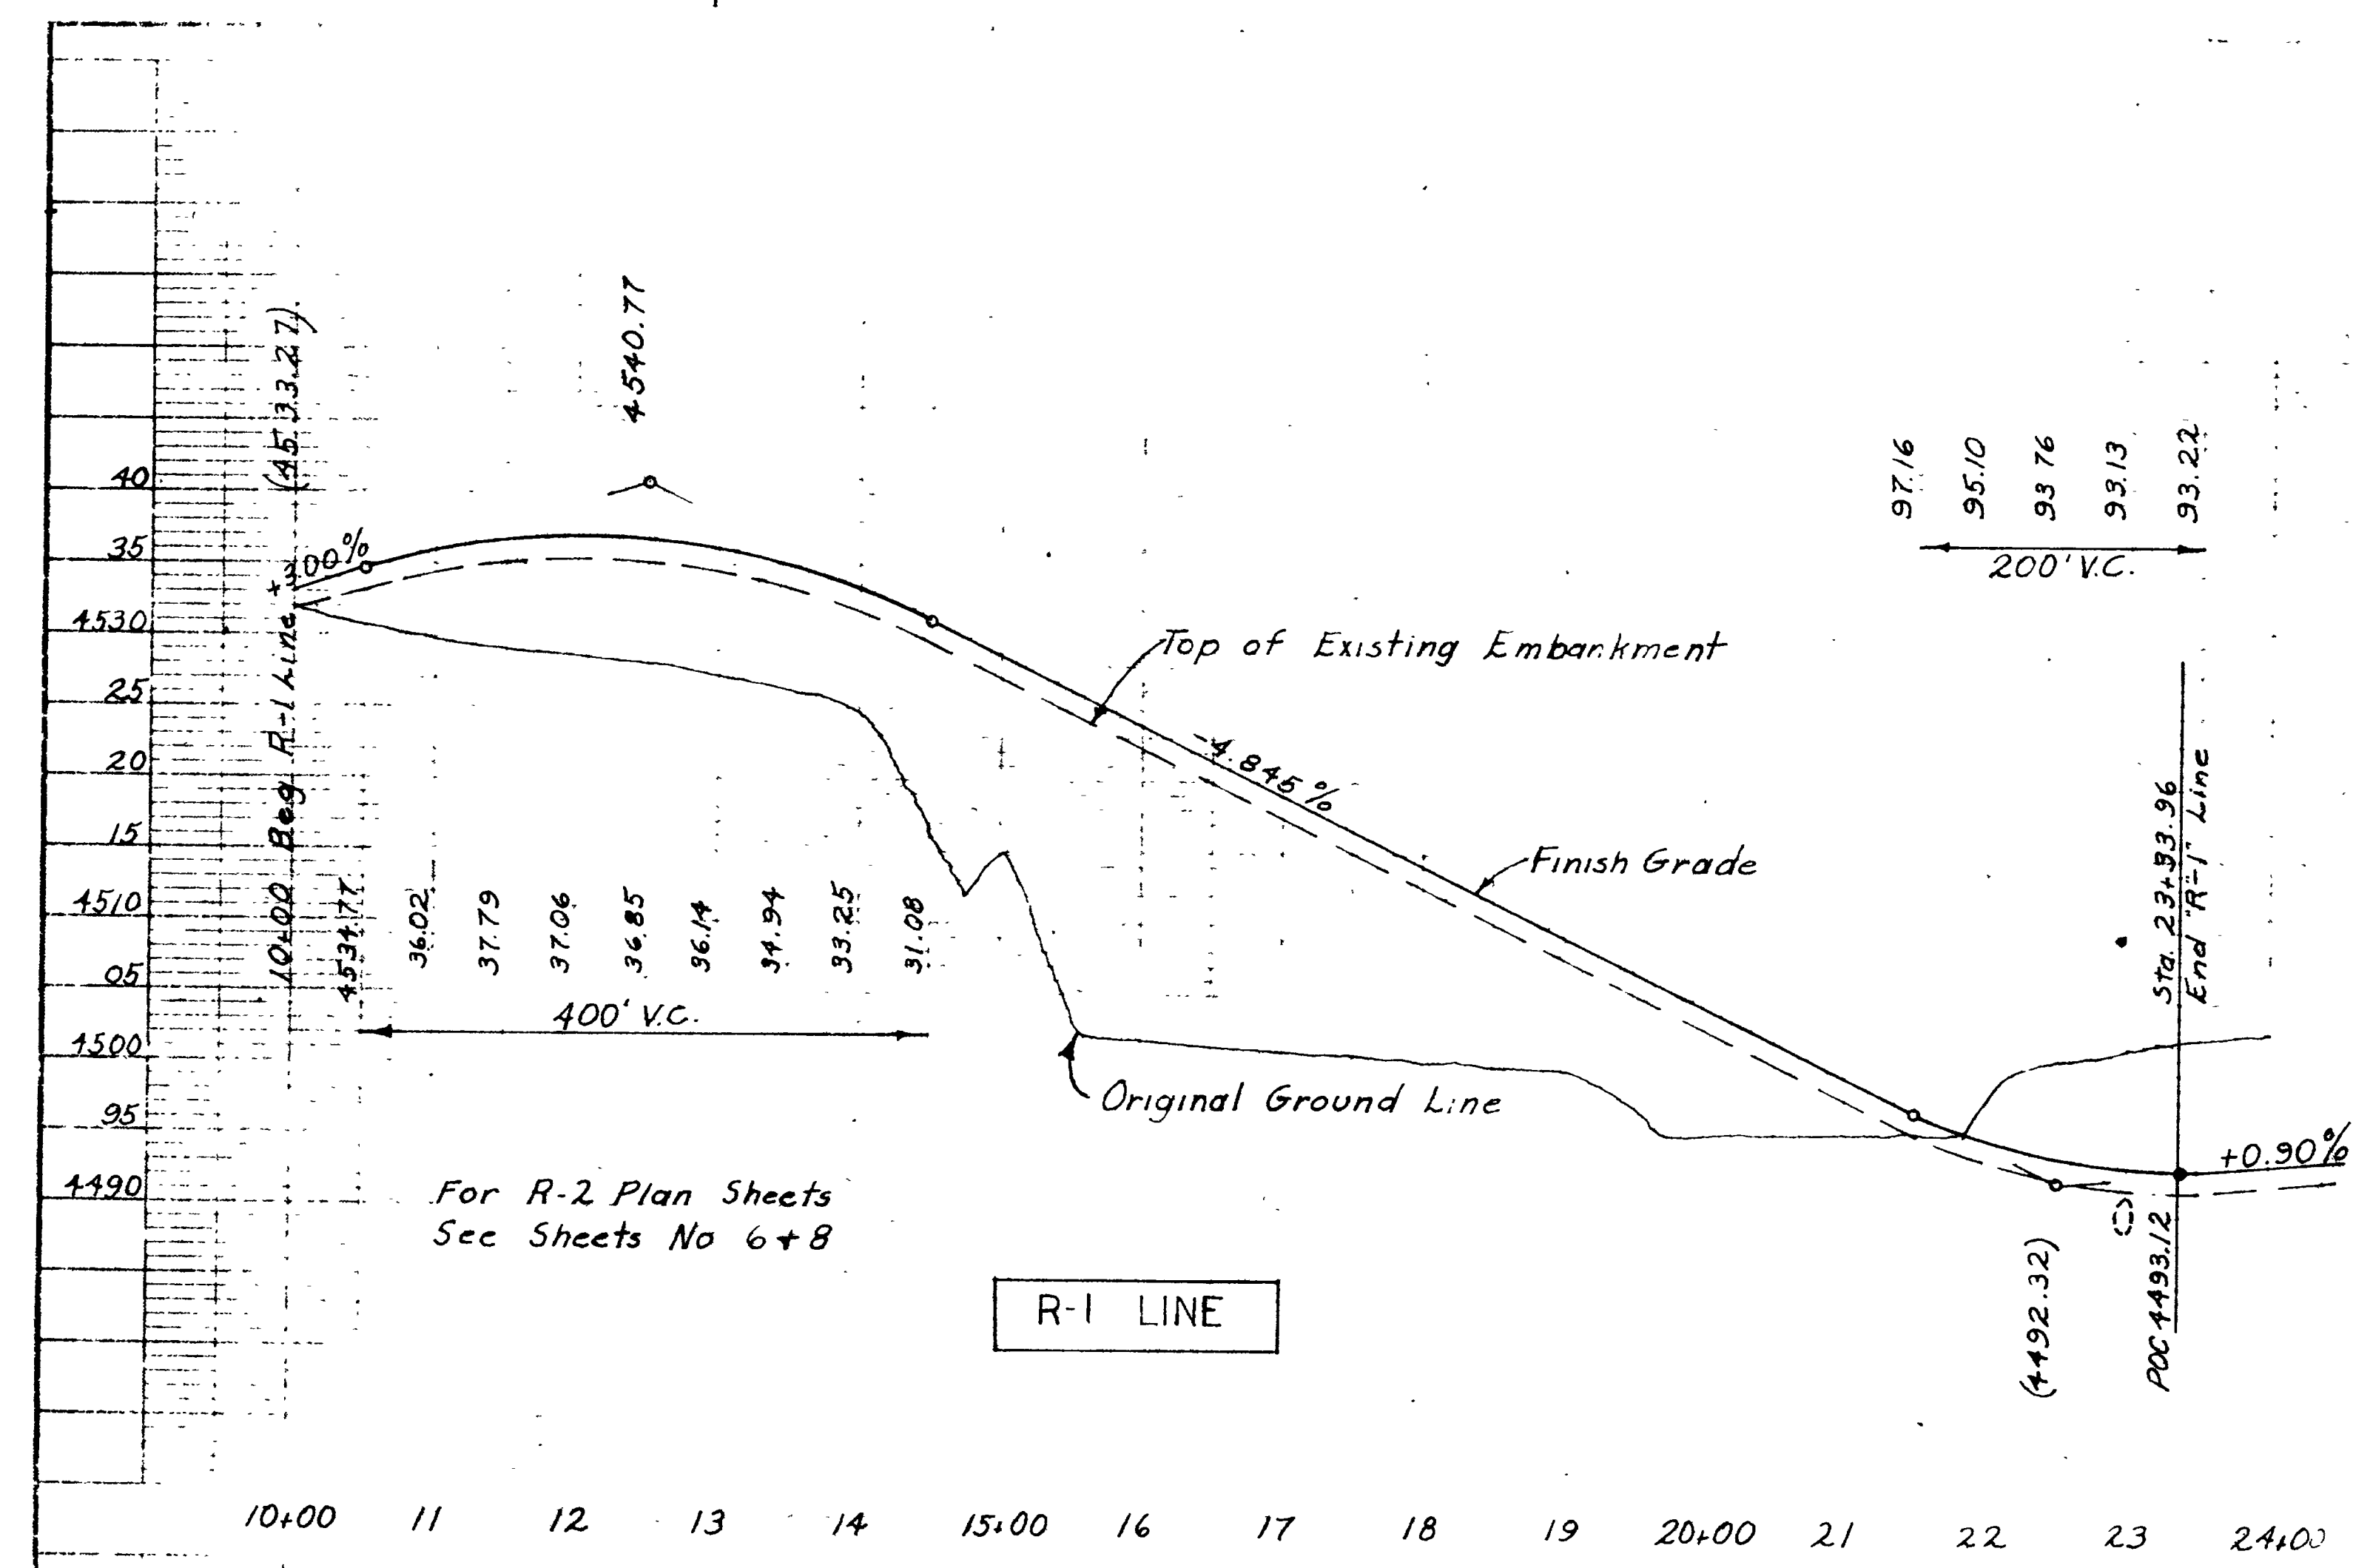

PROJ. ROAD DIST. NO.	STATE	PROJ. NO.	SHEET NO.	TOTAL SHEETS
UTAH	UTAH			



- ALL CONDUIT SHALL BE INSTALLED SO THAT TERMINATION POINTS AT POLES & JCT. BOXES ARE AS SHOWN IN VIEW A-A ON THIS SHEET. NO. 12 GAUGE GALVANIZED PULL WIRE SHALL BE INSTALLED IN ALL CONDUITS. AT LEAST 2 FEET OF PULL WIRE SHALL BE DOUBLED BACK INTO THE CONDUIT AT EACH TERMINATION. ALL CONDUIT SHALL BE CAPPED WITH STANDARD PIPE CAPS AT EACH TERMINATION.
- ALL LUMINAIRE POLE BRACKET ARMS TO BE INSTALLED 90° TO CONTROL LINE OF ROAD ALIGNMENT OR 90° TO 1/2 OF ALIGNMENT ON CURVES.
- SEE DWG. NO. T.E.C. 1117 "LIGHT POLE FEEDER ARM, ANCHOR BOLT & FOOTING ASSEMBLY DETAILS" FOR ANCHOR BOLT PROJECTIONS AND POLE FOUNDATION DETAILS.
- FOR BITUMINOUS CURB AND DRAIN DETAILS SEE UTAH DEPT. OF HIGHWAYS STD. DWG. NO. 347 "SHOULDER & MEDIAN DRAIN" & STD. DWG. NO. 200 "GEOMETRIC DESIGN STANDARDS - INTERSTATE SYSTEM (ROADWAY)".
- SEE DWG. NO. T.E.C.-1126 "JUNCTION BOX DETAILS OFF-STRUCTURES" FOR ADDITIONAL BOX & CONDUIT DETAILS.
- 4'-0" DIMENSION IS TYPICAL FOR POLES NOT ON STRUCTURES. 5'-0" DIMENSION IS TYPICAL FOR POLE FOUNDATIONS AT SHOULDER DRAINS.
- BACK FILL TO TOP SURFACE OF JUNCTION BOX.
- IF ANGLE-B IS LESS THAN 60°, ENTER JUNCTION BOX FROM END AS SHOWN. IF ANGLE-B IS GREATER THAN 60°, ENTER JUNCTION BOX FROM SIDE NEAREST ROAD. CONDUIT SIZES ARE INDICATED ON EACH LIGHTING LAYOUT SHEET.
- GROUND WIRE & ROD TO BE INSTALLED ON ALL POLES AND SHALL BE CONNECTED THROUGH UNDERGROUND JCT. BOXES & CONDUIT AS SHOWN IN VIEW A-A, WHEN ELECTRICAL CIRCUITS ARE INSTALLED.

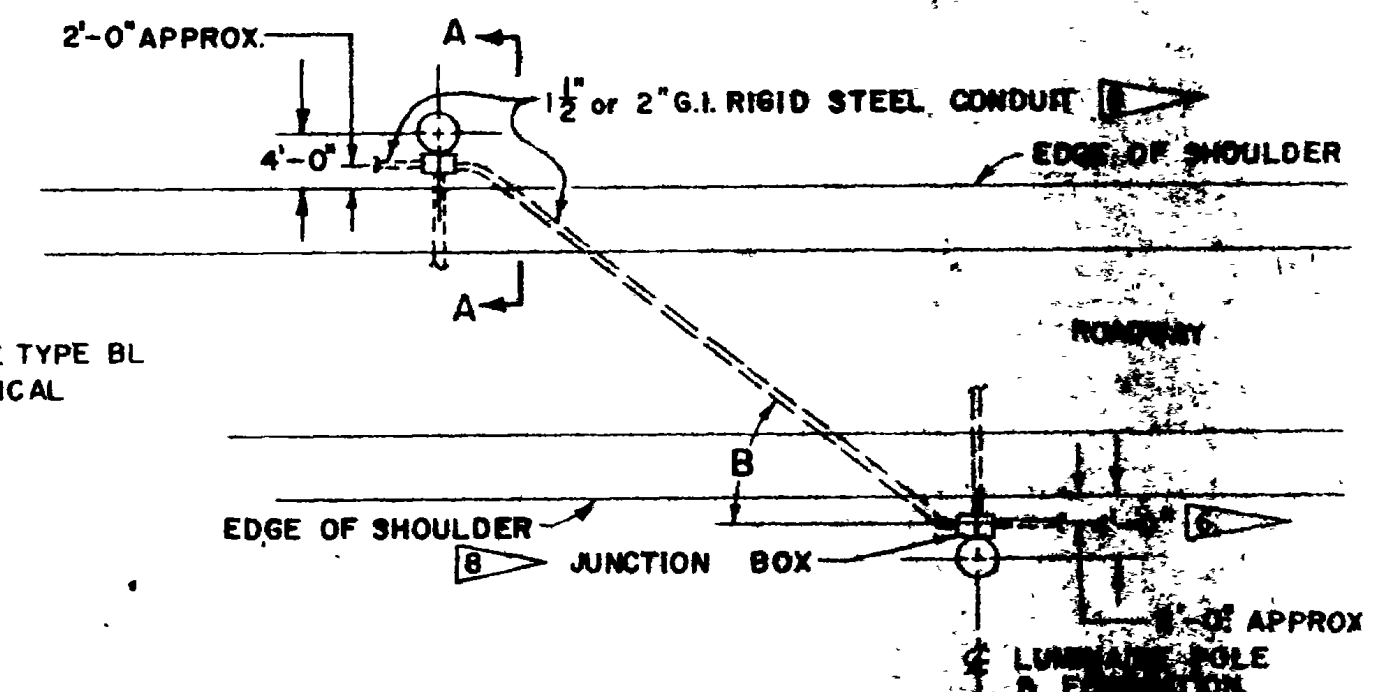

PLAN OF POLE FOUNDATION & JUNCTION BOX AT CIRCUIT CROSSOVER


POLE DIA.	"P"
8"	6 5/8"
8 1/2"	6 3/4"
9"	7"
11"	7 5/8"

DETAIL-POLE FOUNDATION & JUNCTION BOX SECTION AT CIRCUIT CROSSOVER VIEW A-A WITH SECTIONS

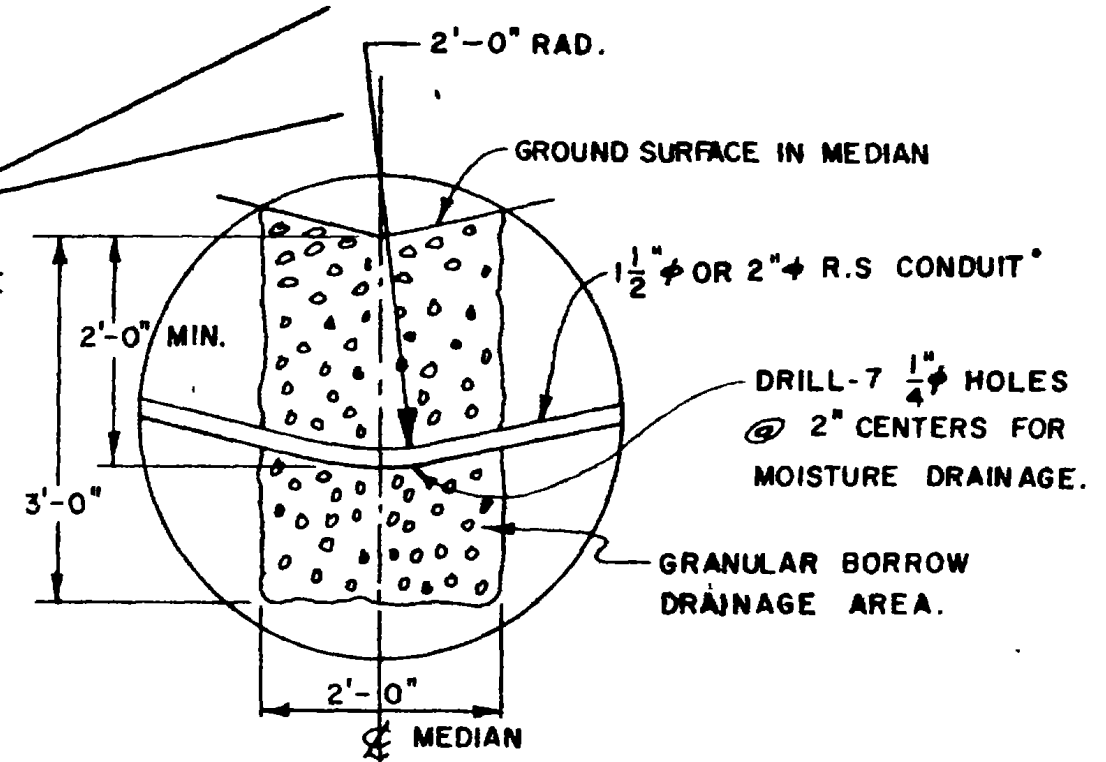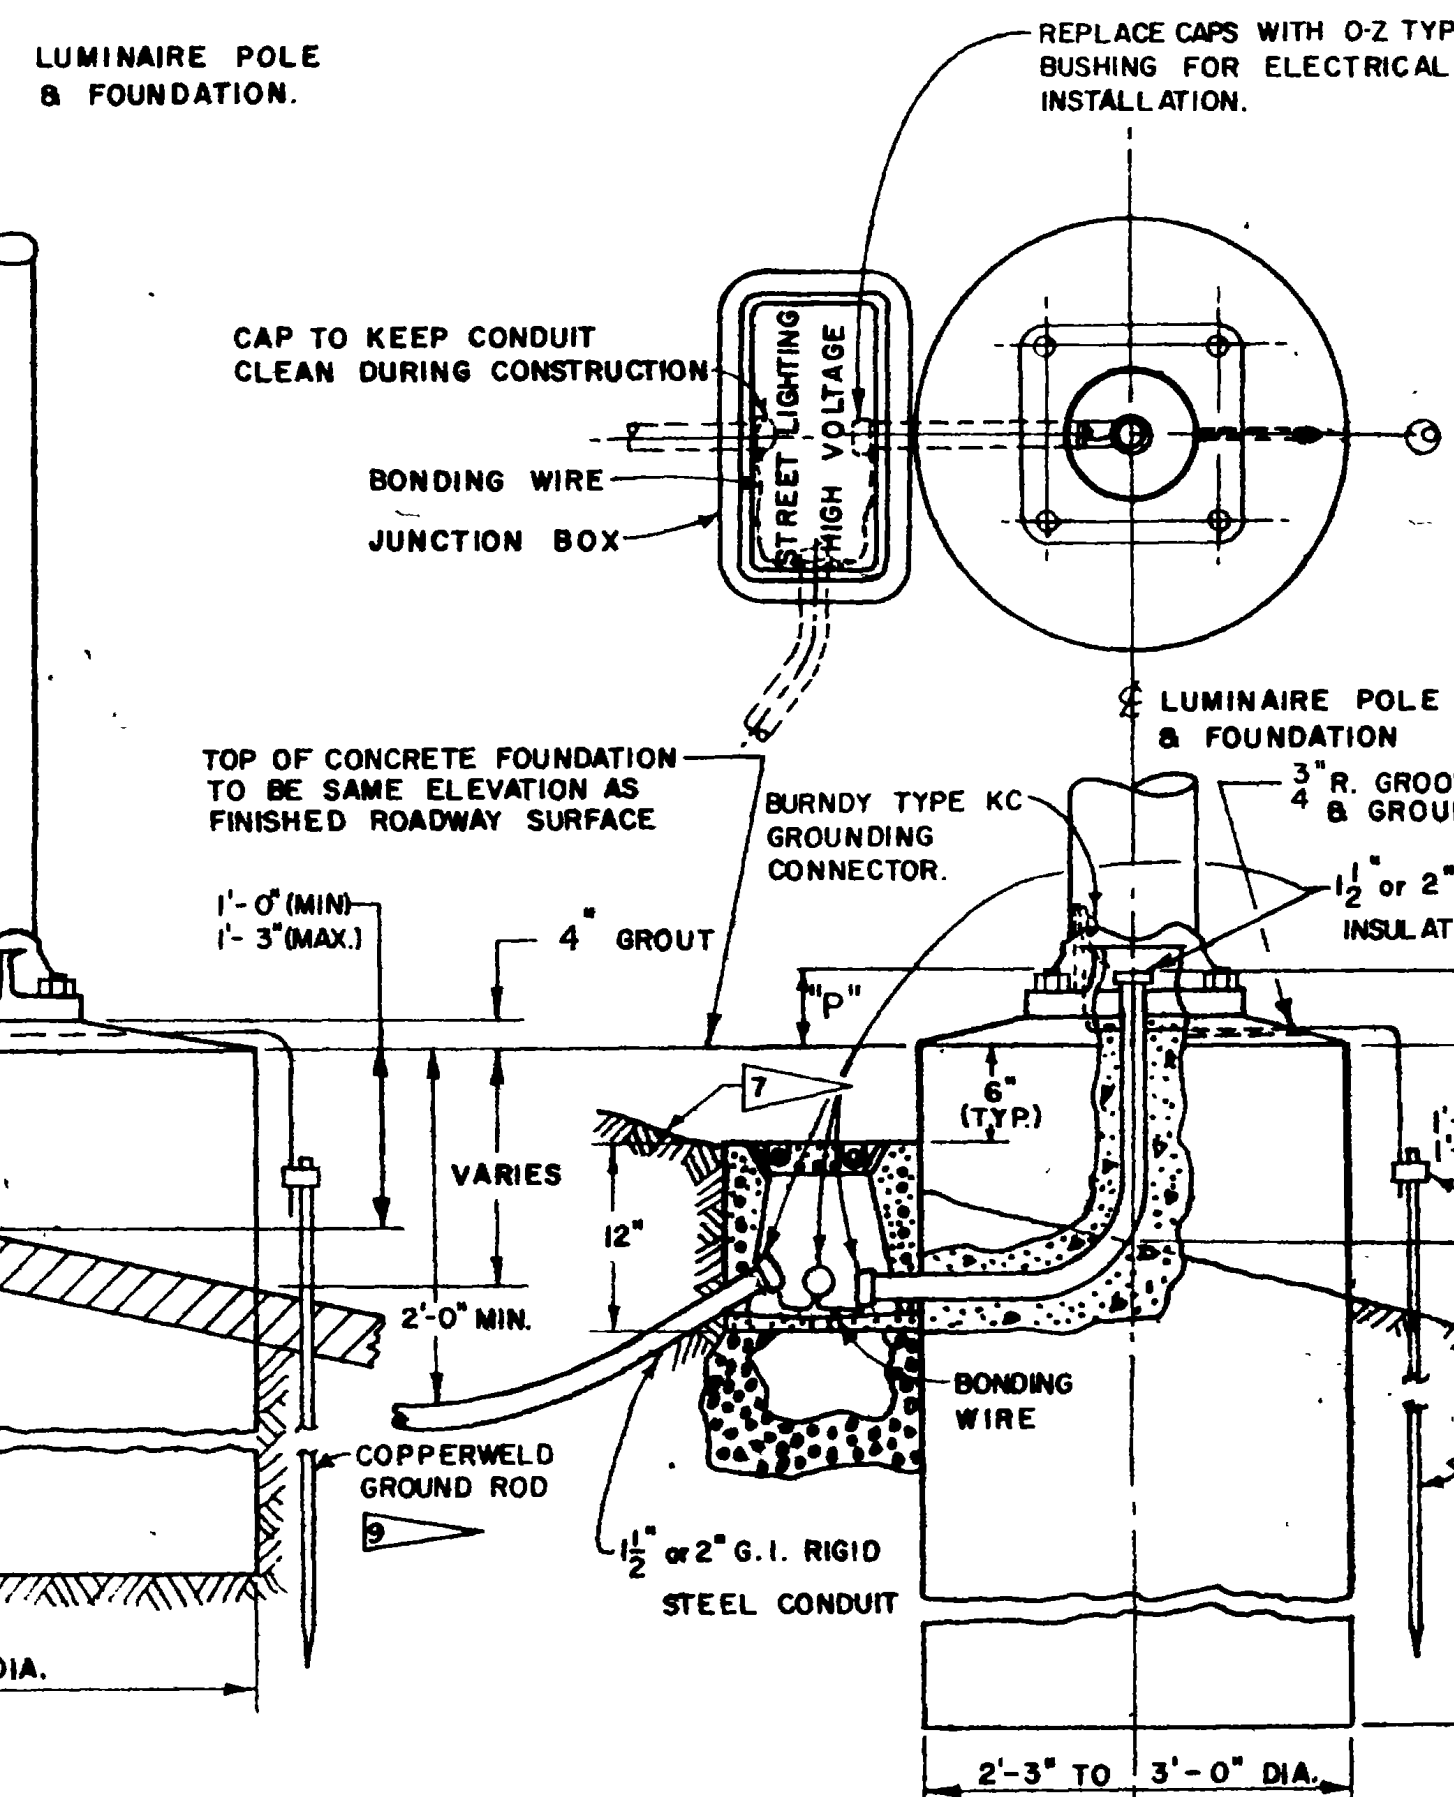

DETAIL - "B" TYPICAL DRAINAGE AREA FOR UNDERGROUND CONDUIT MULTI-LANE, TWO LANE, & RAMP

CONDUIT DRAINAGE AREAS TO BE USED IN LOCATIONS WHERE THERE IS GOOD DRAINAGE WHERE LOCATIONS ARE SWAMPY OR THE SUB-SURFACE WATER TABLE IS HIGHER THAN THE PROPOSED PIPE DRAINAGE AREA, NO DRAINAGE AREA CAN BE USED. EXTRA CARE SHOULD BE TAKEN THAT NO MOISTURE GETS INTO THESE CONDUIT SYSTEMS.

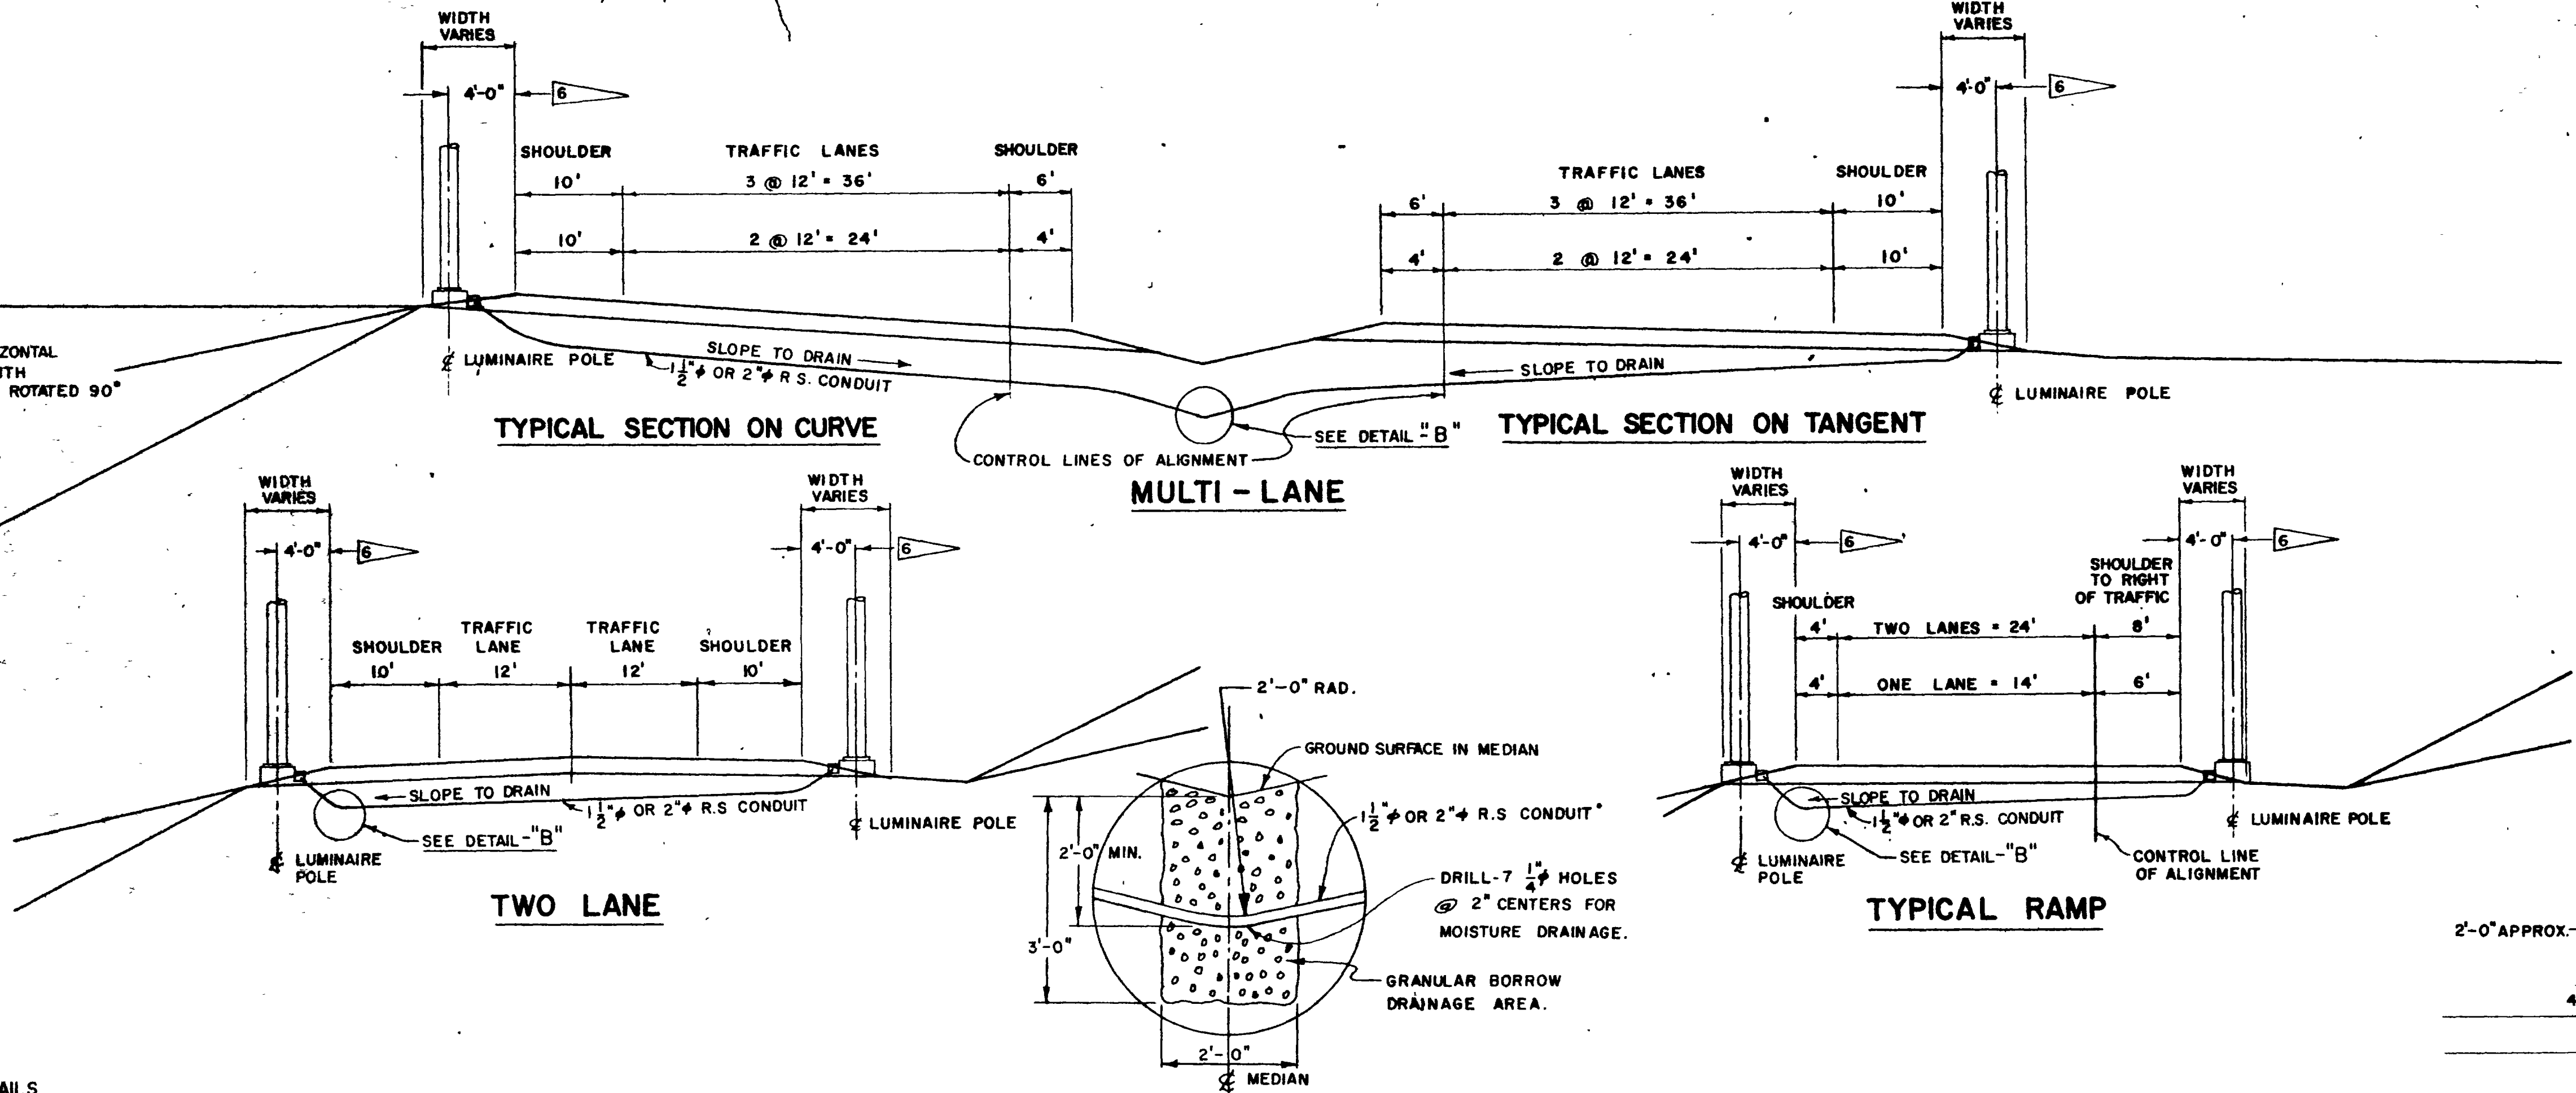


TYPICAL SECTION ON CURVE

TYPICAL SECTION ON TANGENT


MULTI - LANE

TWO LANE

TYPICAL RAMP

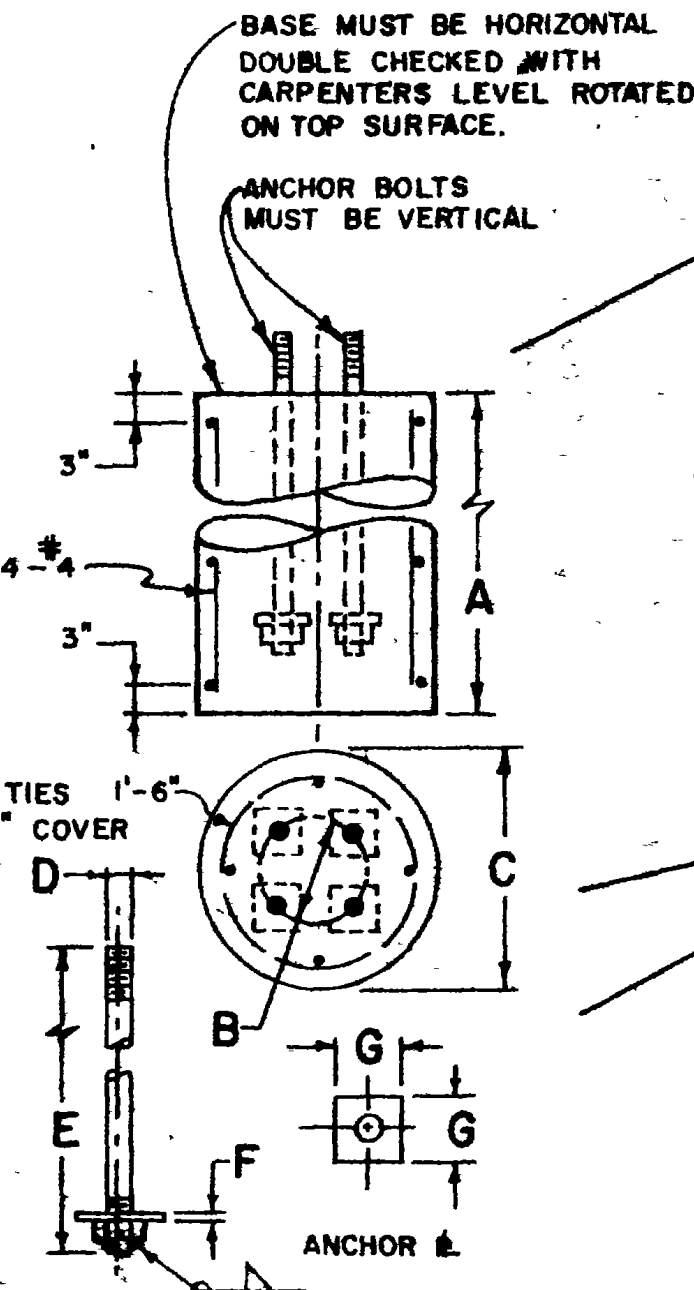


FOOTING AND ANCHOR BOLT DETAILS FOR LIGHT POLE ASSEMBLY

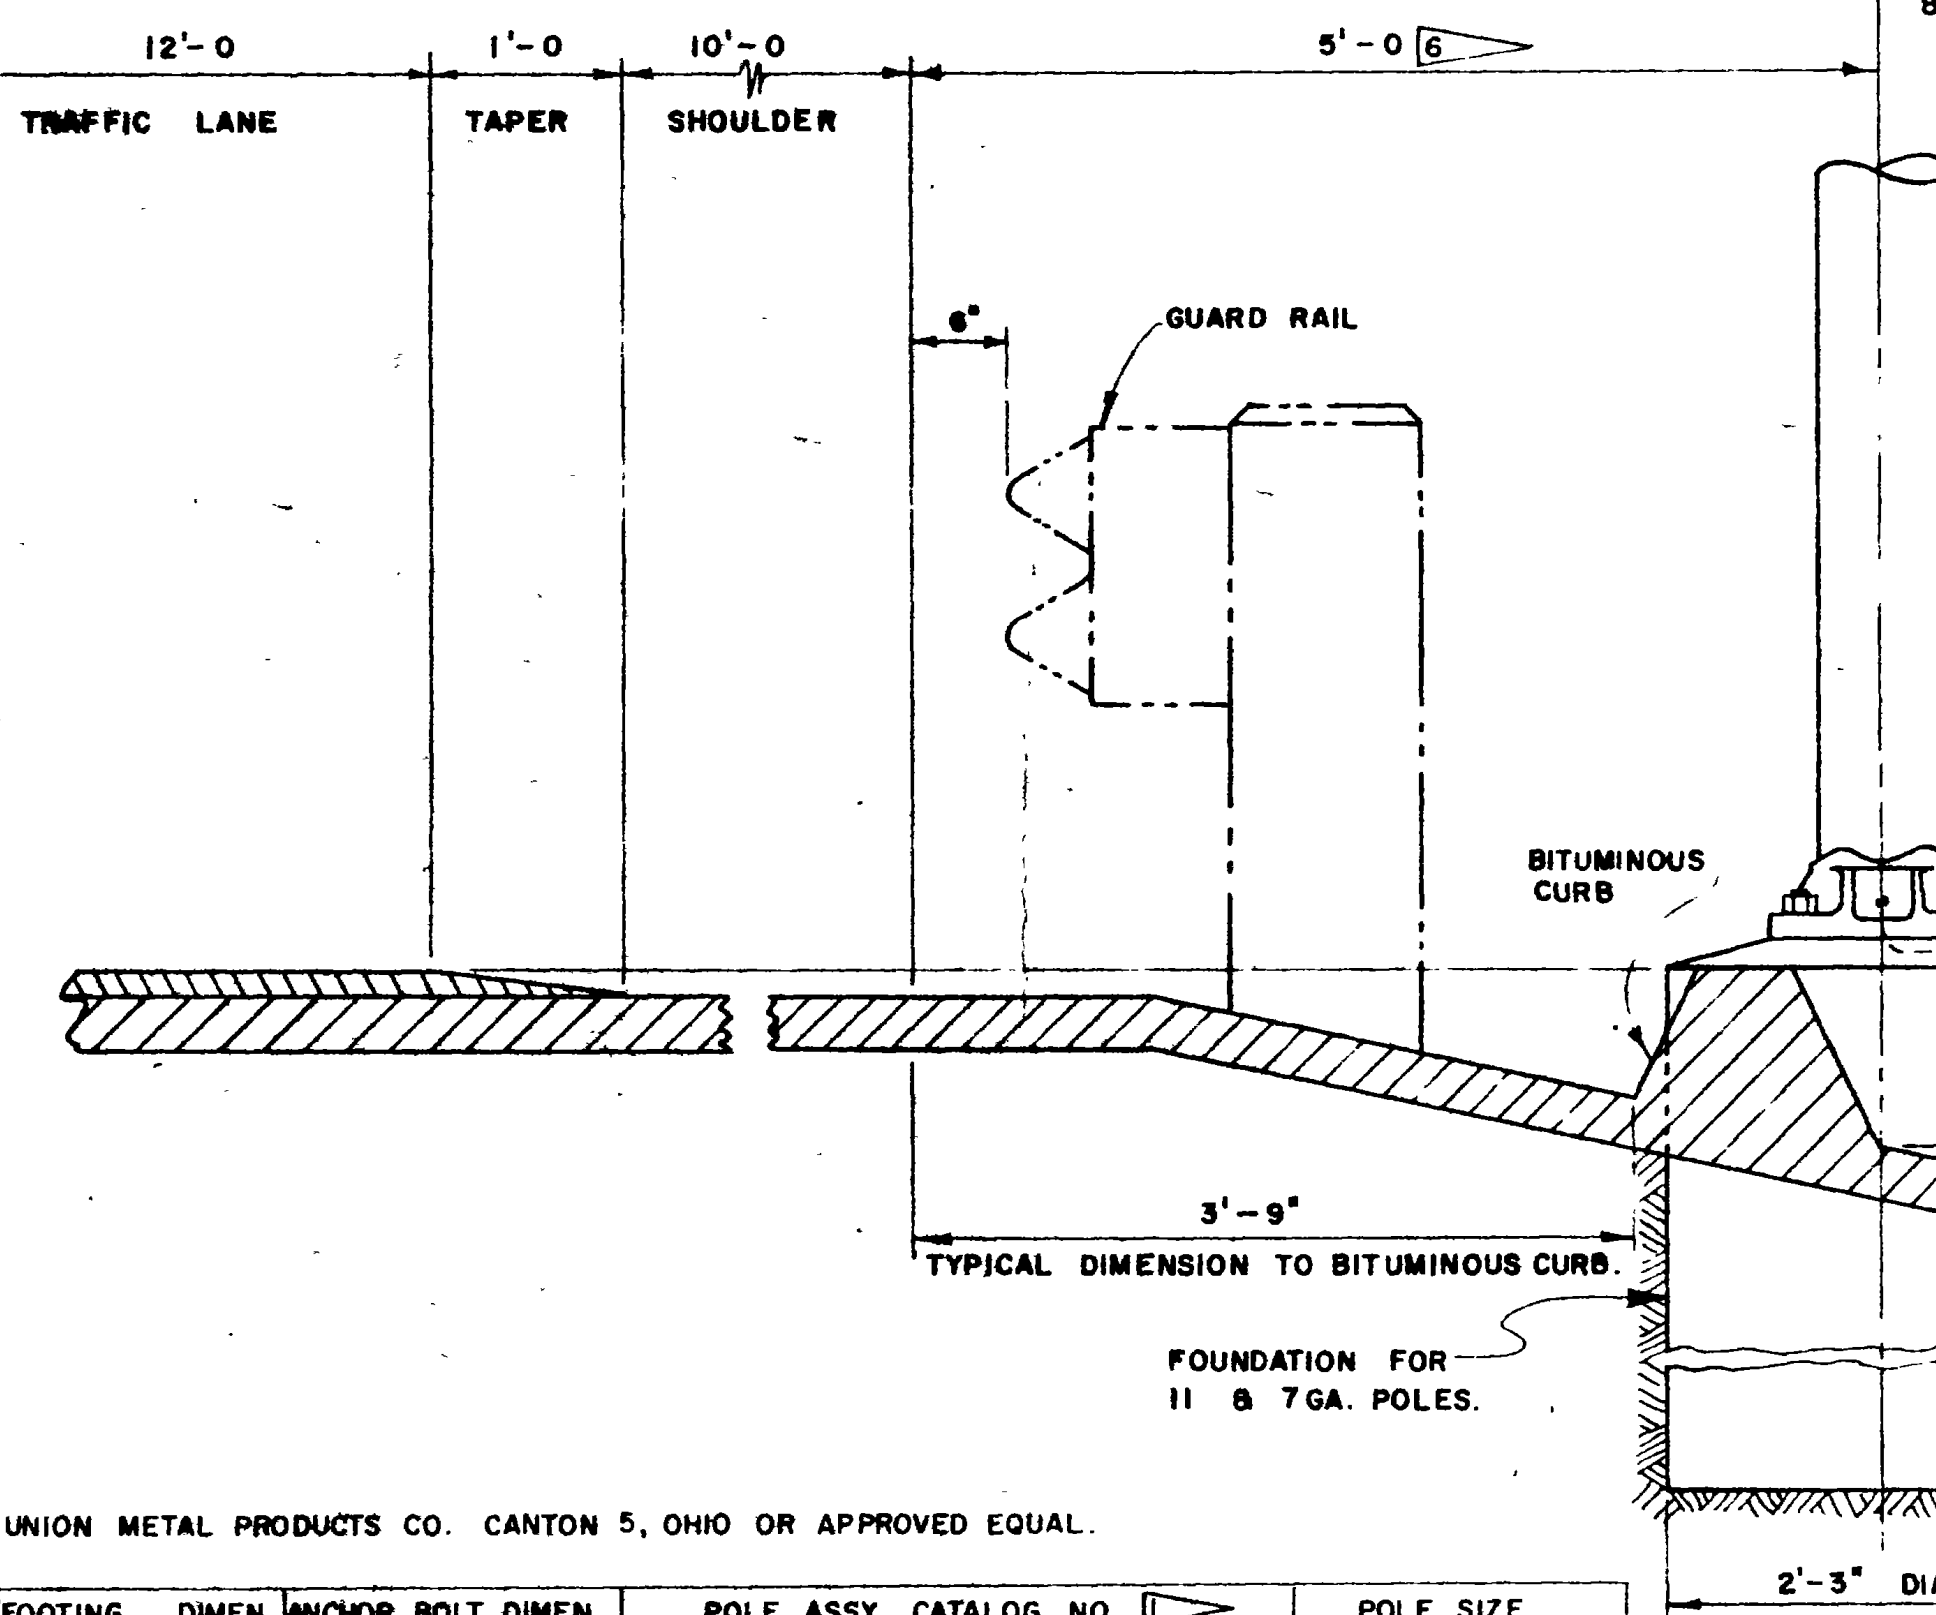

TYPICAL INSTALLATION OF LUMINAIRE POLE FOUNDATIONS AT SHOULDER DRAINS

POLE GAUGE	FOOTING DIMEN.			ANCHOR BOLT DIMEN.			POLE ASSY. CATALOG NO. WITHOUT BRACKET (T.B. TRANSFORMER BASE)	POLE SIZE DIA. X LENGTH
	A	B	C	D	E	F		
11	6'-0"	11"	2'-3"	1"	60"	3/8"	440A-J270	8 1/2" x 4 7/8" x 27'-0"
11	7'-0"	15"	3'-0"	"	"	"	442A-J270	T.B. 8 1/2" x 5" x 25'-0"
7	6'-0"	11"	2'-3"	1 1/4"	60"	7/16"	440A-7J270	8 1/2" x 4 7/8" x 27'-0"
7	7'-0"	15"	3'-0"	"	"	"	442A-7J270	T.B. 8 1/2" x 5" x 25'-0"
3	7'-0"	15"	3'-0"	1 3/4"	72"	1/2"	440A-3N270	11" x 7.22" x 27'-0"
3	7'-0"	17 1/4"	3'-0"	"	"	"	442A-3N270	T.B. 11" x 7.22" x 25'-0"

UTAH STATE ROAD COMMISSION
TRAFFIC & RESEARCH DEPARTMENT
TRAFFIC ENGINEERING BRANCH
POLE FOUNDATION ALIGNMENT AND CONDUIT CROSSINGS
DESIGNED BY: R.S.T. SCALE: NONE
DRAWN BY: V.W.W.
CHECKED BY: [blank]
DRG. NO. T.E.C. 1133

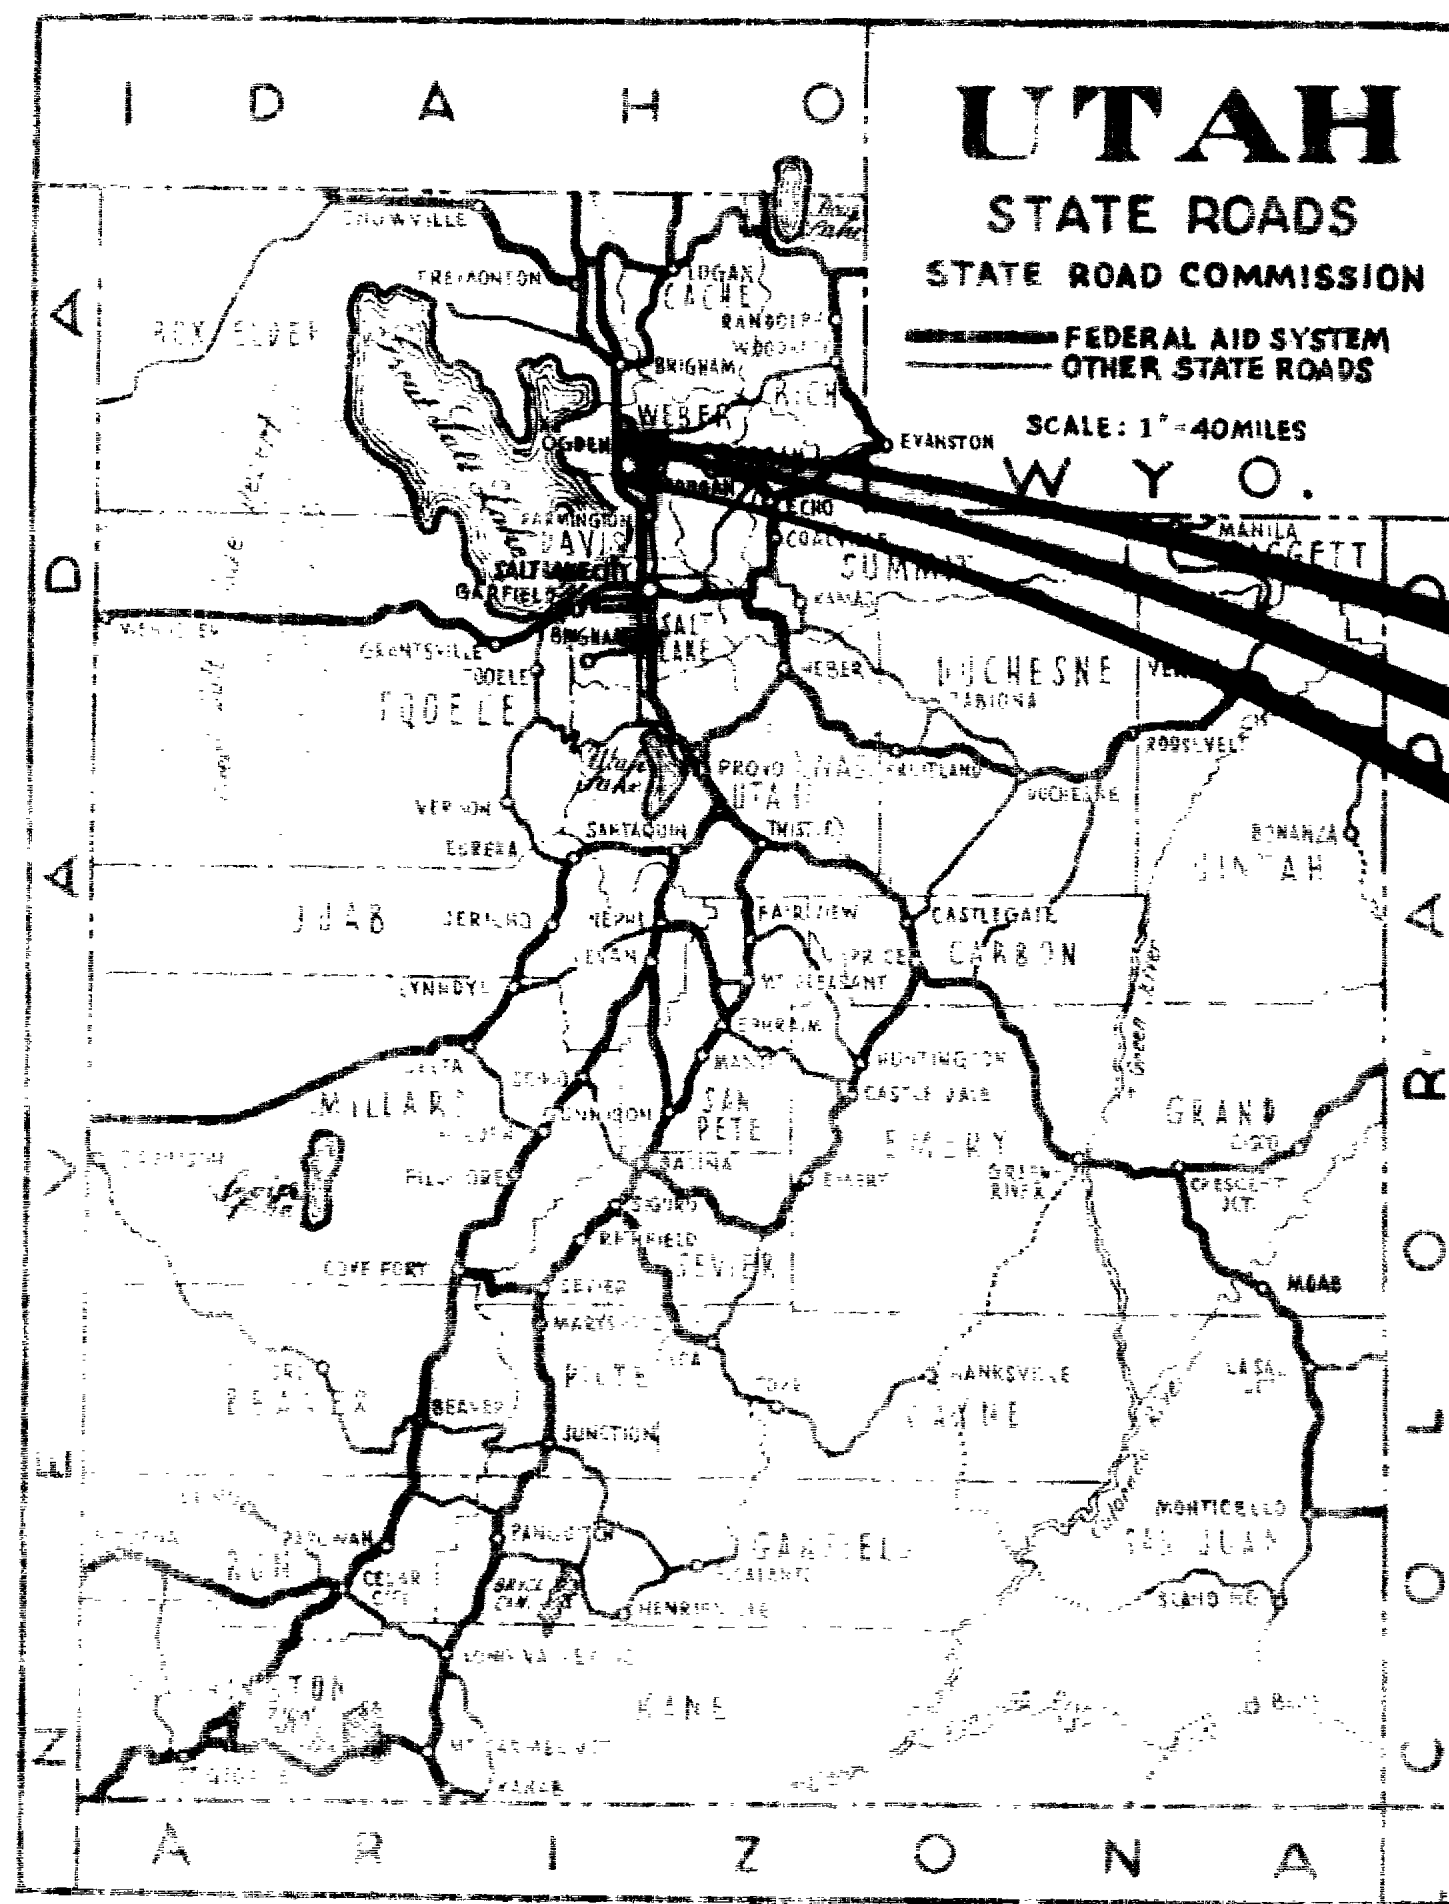

STATE OF UTAH STATE ROAD COMMISSION


PLANS OF PROPOSED STATE ROAD

FEDERAL AID PROJECT

I-15-8(21)334 FOURTH CONTRACT
31st STREET INTERCHANGE
WEBER COUNTY
LENGTH 1.988 MILE

I-80N-6(19)45
I-80N FROM RIVERDALE ROAD
TO I-15 CONNECTION
WEBER COUNTY
LENGTH 0.814 MILE

I-15-7(69)326 FIFTH CONTRACT
SYRACUSE ROAD ("M" LINE)
DAVIS COUNTY
LENGTH 0.303 MILE

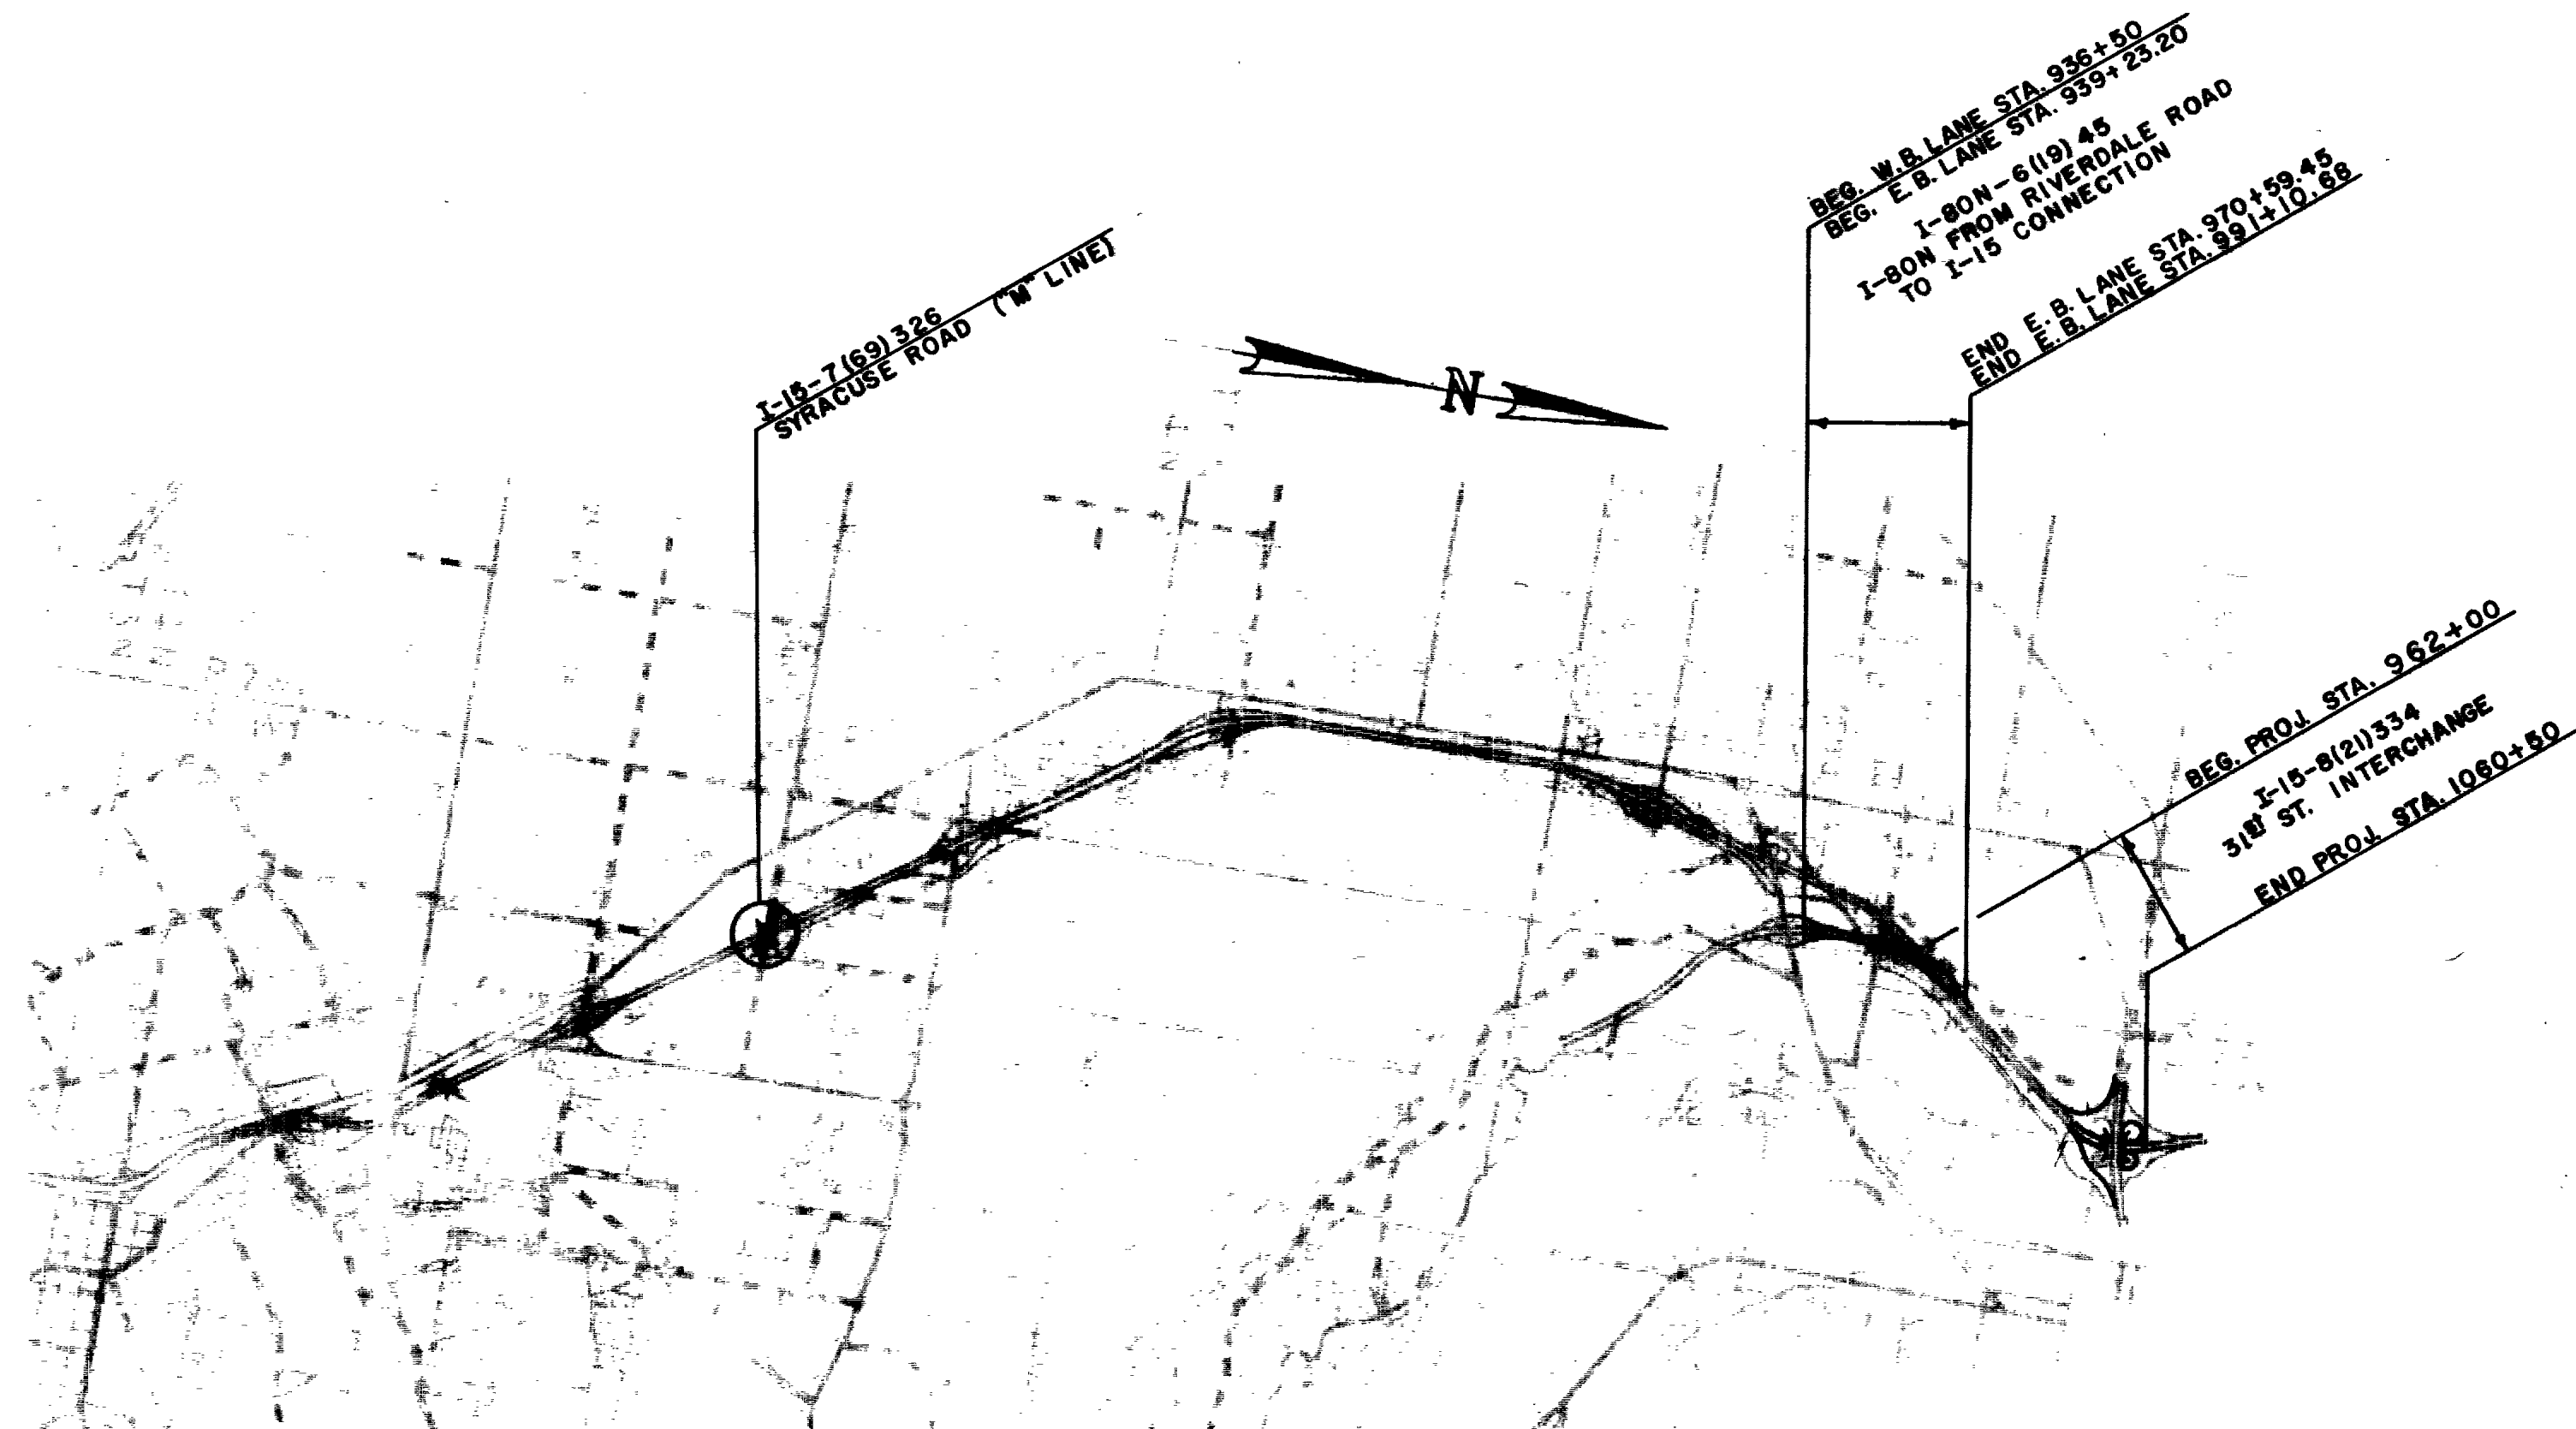

FED. RD. DIST. NO.	STATE	PROJ. NO.	SHEET NO.	TOTAL SHEETS
UTAH	UTAH	I-15-8(21)334	I	1
REVISION DATE 6/10/66				

INDEX TO SHEETS NO. I-15-8(21)334 4TH CONT.

SHEET NO.	DESCRIPTION	DRAWING NO.	STATION
1	TITLE SHEET		
2-2C	TYPICAL SECTIONS - MAT'L'S. SHT.		
3-3B	SUMMARY SHEETS		
4-14	PLAN AND PROFILE		
15	STANDARD CATCH BASIN	V-750	
16	STANDARD CATCH BASIN	V-755	
17	STD. C.O.B. & CATCH BASIN-48" PIPE	V-755	
18	STD. C.O.B. & CATCH BASIN-42" PIPE	V-813	
19-20	SUPERELEVATION AND WIDENING	203(1-2)	
21	Entrance & Exit Ramp Geometries	207	
22	CONCRETE CURB & GUTTER	220	
23	GUARD RAIL INSTALL. & LOCATION	231	
24	CORRUGATED METAL PIPE CULVERT	300	
25	METAL CULVERT END SECTIONS	302	
26	REINFORCED CONCRETE CULVERTS	320	
27	REINFORCED CONC. CULV. END SECT.	322	
28	DIPSTONE INLET AND OUTLET	351	
29-34	CONSTRUCTION SIGNING	500(1-6)	
35	CONSTRUCTION IDENT. SIGNS	504	
36	TYPICAL PAVEMENT MARKINGS	507	
37	STD. CATCH BASIN 36" PIPE	V-754	
38	DEEP BEAM HWY. GUARD RAIL	230-1	
39	GUARD RAIL APP. ELEMENT INSTALL.	230-2	

INDEX TO SHEETS NO. I-80N-6(19)45

SHEET NO.	DESCRIPTION	DRAWING NO.	STATION
1	TITLE SHEET		
2-2C	TYPICAL SECTIONS - MAT'L'S. SHT.		
3	SUMMARY SHEET		
4-11	PLAN AND PROFILE		
12-13	SUPERELEVATION AND WIDENING	203(1-2)	
14	Entrance & Exit Ramp Geometries	207	
15	CONCRETE CURB AND GUTTER	220	
16	GUARD RAIL INSTALL. & LOCATION	231	
17	CORRUGATED METAL PIPE CULVERT	300	
18	METAL CULVERT END SECTION	302	
19	DIPSTONE INLET AND OUTLET	351	
20-24	CONSTRUCTION SIGNING	500(1-5)	
25	CONSTRUCTION IDENT. SIGNS	504	
26	TYPICAL PAVEMENT MARKINGS	507	
27	DEEP BEAM HWY. GUARD RAIL	230-1	
28	GUARD RAIL APP. ELEMENT INSTALL.	230-2	

INDEX TO SHEETS NO. I-15-7(69)326 5TH CONT.

SHEET NO.	DESCRIPTION	DRAWING NO.	STATION
1	TITLE SHEET		
2-2B	TYPICAL SECTIONS - MAT'L'S. SHT.		
3	SUMMARY SHEET		
4-6	PLAN AND PROFILE		
7	CONCRETE CURB AND GUTTER	220	
8	GUARD RAIL INSTALL. & LOCATION	231	
9	CORRUGATED METAL PIPE CULV.	300	
10	METAL CULVERT END SECTIONS	302	
11	DIPSTONE INLET AND OUTLET	351	
12-14	CONSTRUCTION SIGNING	500(1-3)	
15	CONSTRUCTION IDENT. SIGNS	504	
16	TYPICAL PAVEMENT MARKINGS	507	
17	DEEP BEAM HWY. GUARD RAIL	230-1	
18	GUARD RAIL APP. ELEMENT INSTALL.	230-2	

UTAH STATE DEPARTMENT OF HIGHWAYS

RECOMMENDED FOR APPROVAL MAY - 1966

ENGINEER OF ROADWAY DESIGN

RECOMMENDED FOR APPROVAL MAY - 1966

ENGINEER OF PLANS AND CONTRACTS

APPROVED MAY - 1966

STATE HIGHWAY ENGINEER

DEPARTMENT OF COMMERCE

BUREAU OF PUBLIC ROADS


APPROVED

DIRECTOR ENGINEER

FED. ROAD DIST. NO.	STATE	PROJ. NO.	FISCAL YEAR	SHEET NO.	TOTAL SHEETS
UTAH	UTAH	I-15-7(69) 326	1966	2-A	



STRUCTURE END DRAIN

SEE PLAN SHEET NO. 4

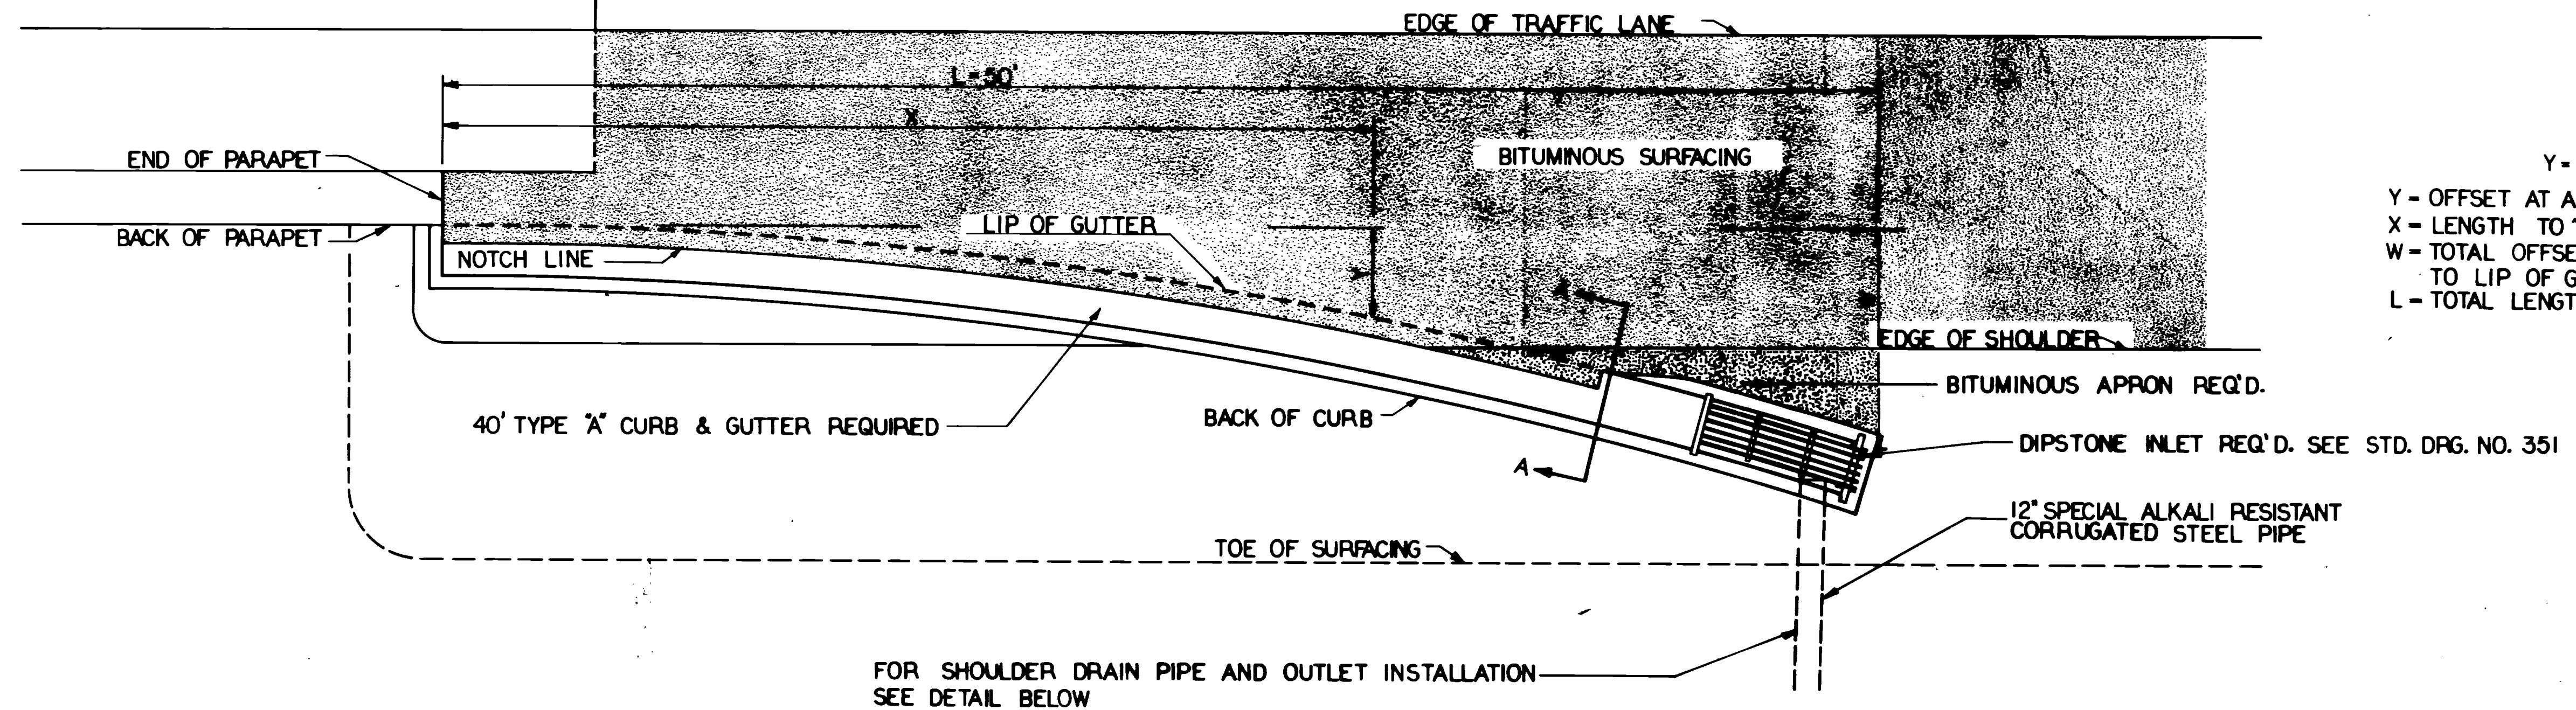

$$Y = W \frac{X^2}{L^2}$$


Y - OFFSET AT ANY POINT
X - LENGTH TO "Y" FROM END OF PARAPET
W - TOTAL OFFSET FROM BACK OF PARAPET TO LIP OF GUTTER
L - TOTAL LENGTH OF END DRAIN

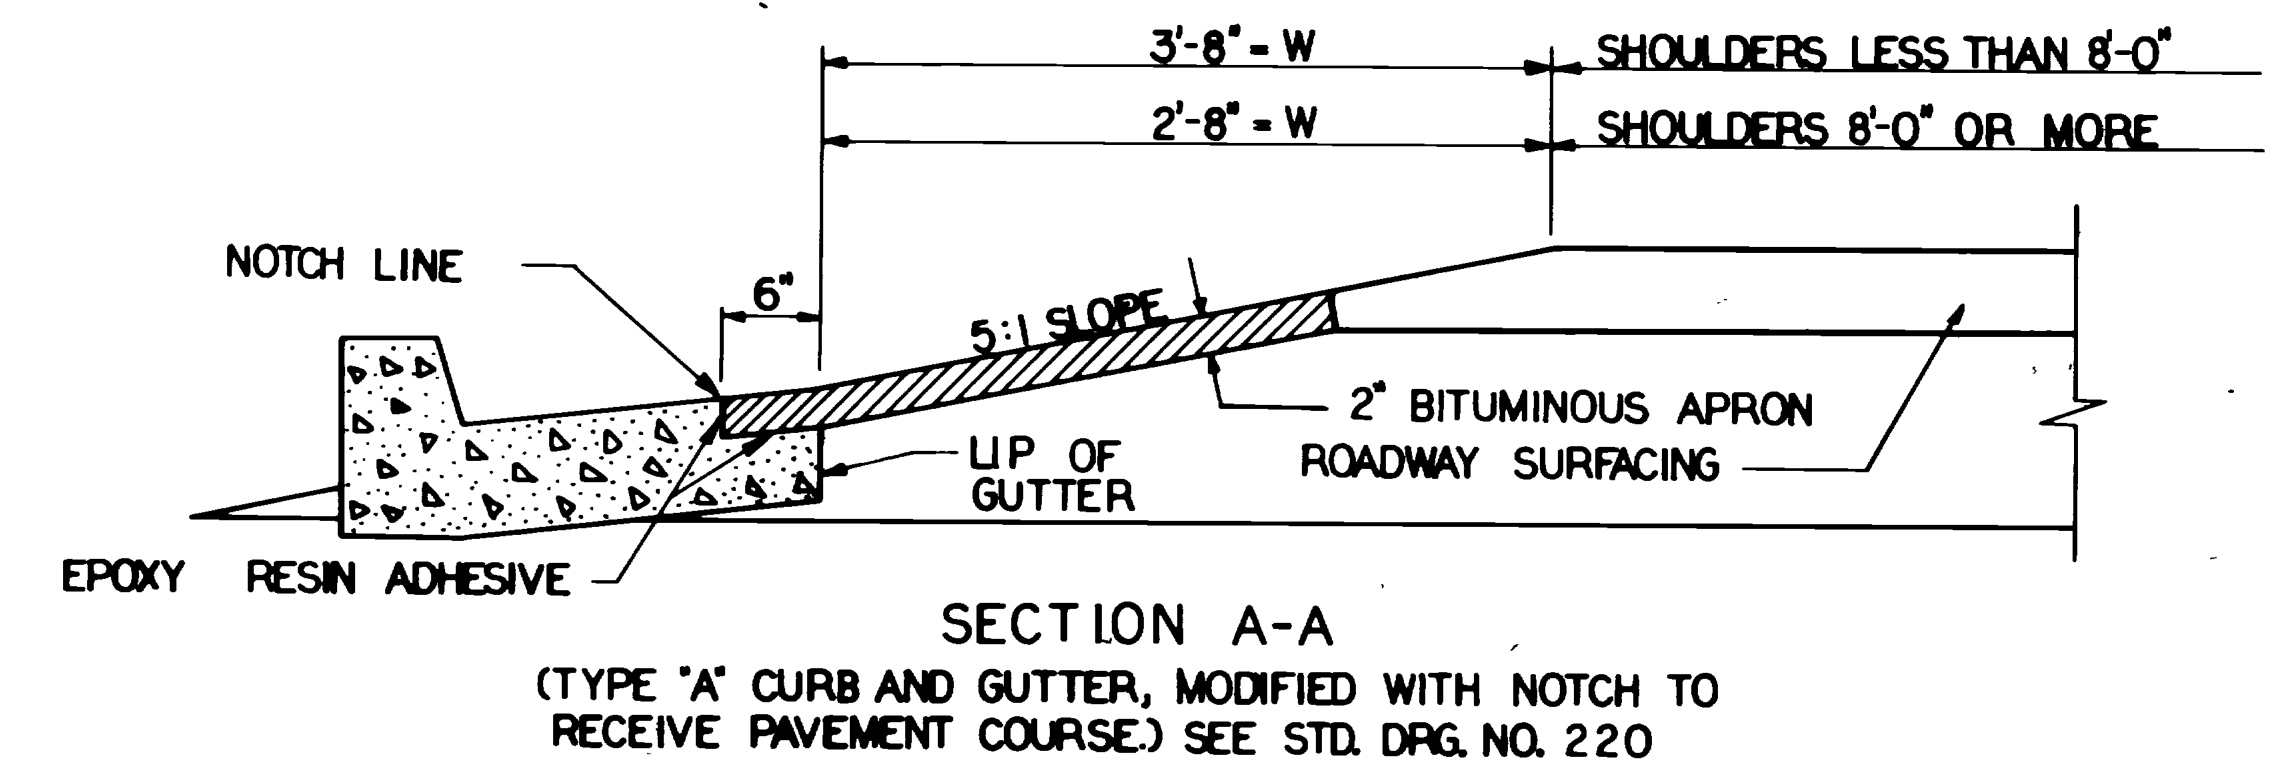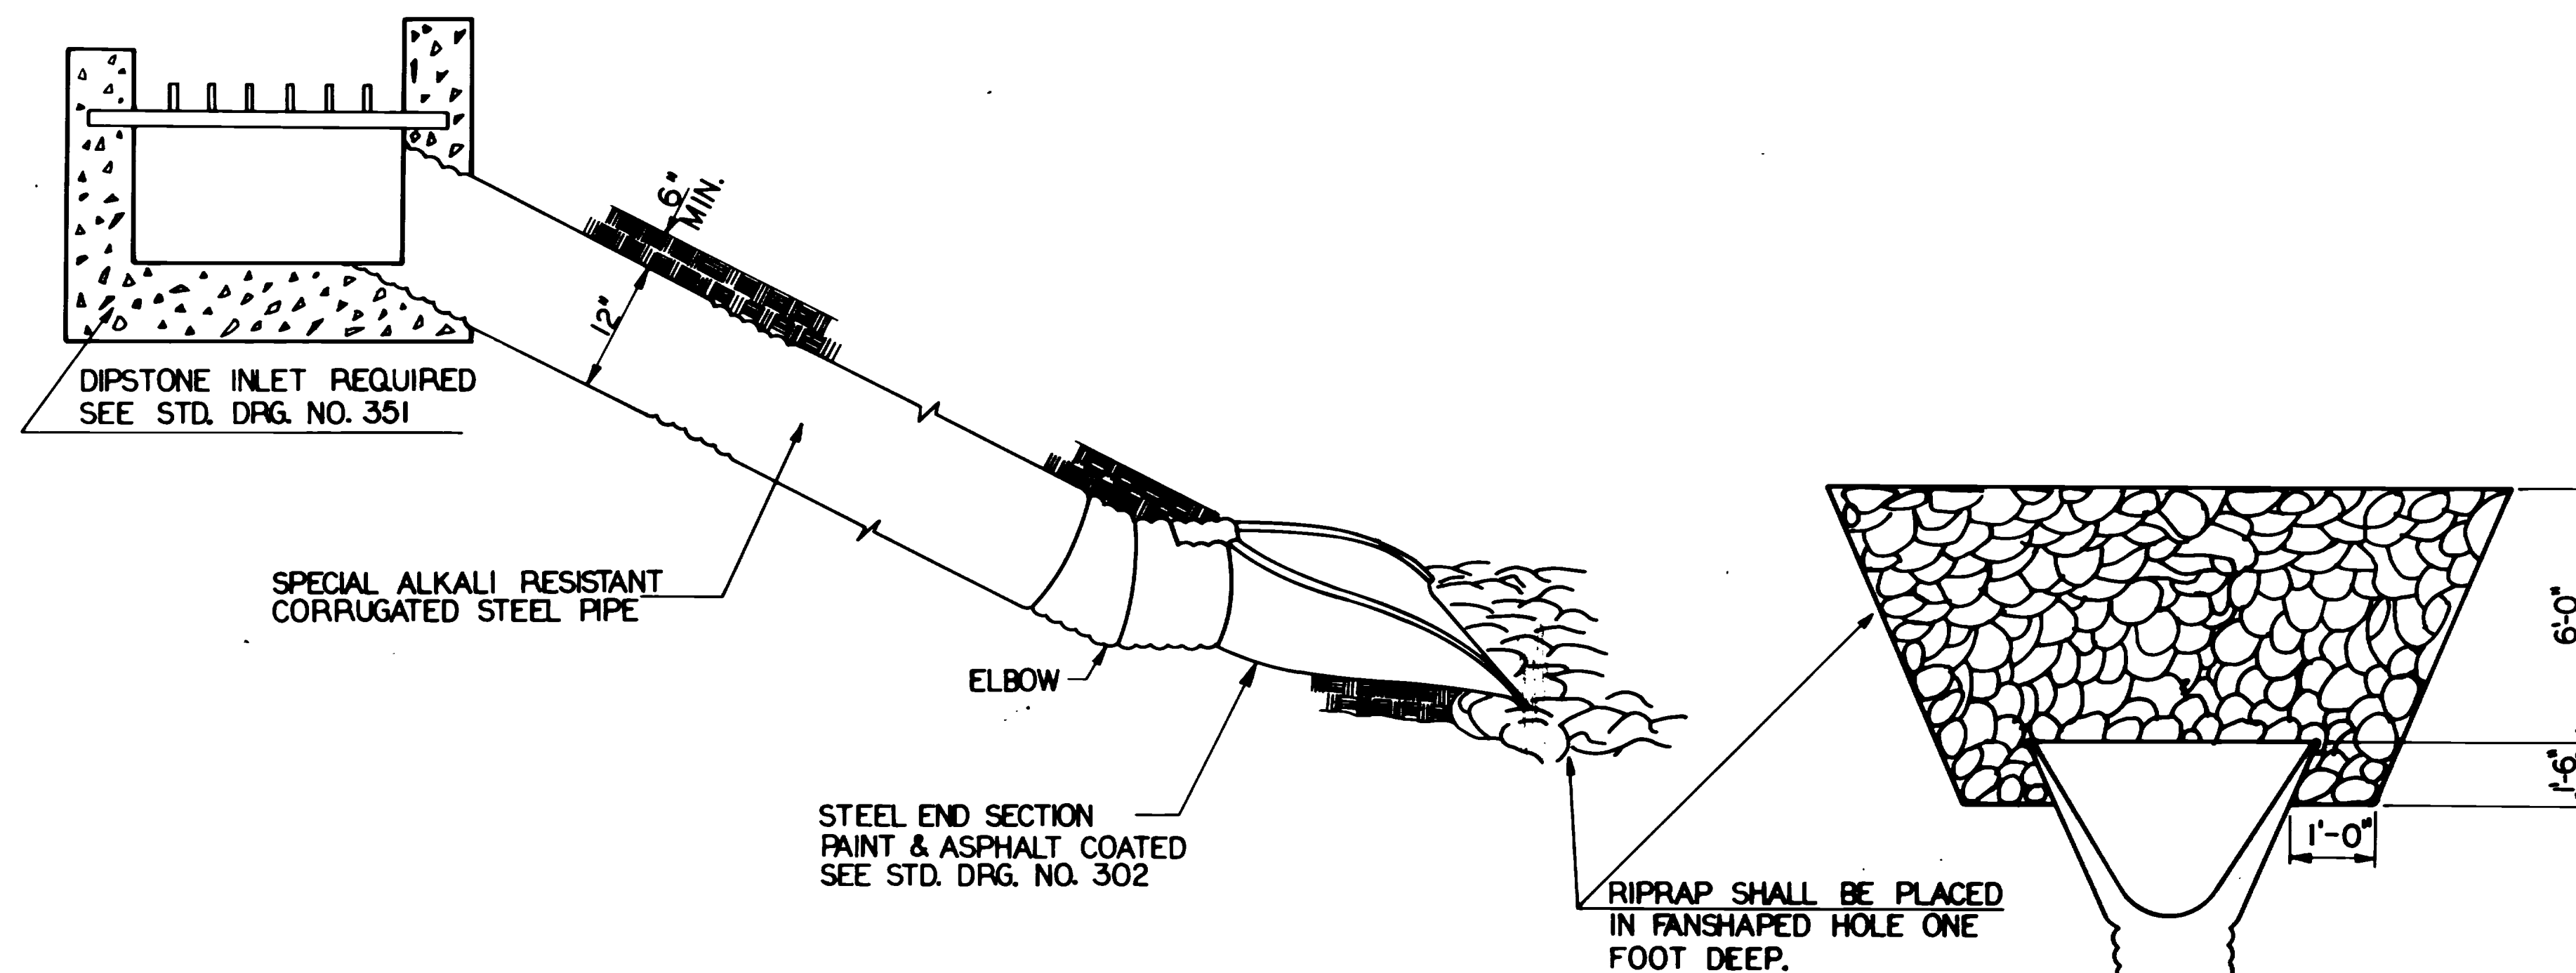

SHOULDER DRAIN PIPE & OUTLET INSTALLATION DETAIL

FED. ROAD DIST. NO.	STATE	PROJ. NO.	FISCAL YEAR	SHEET NO.	TOTAL SHEETS
UTAH	UTAH	1-15-6 (21) 334	1966	2-A	

FTHC

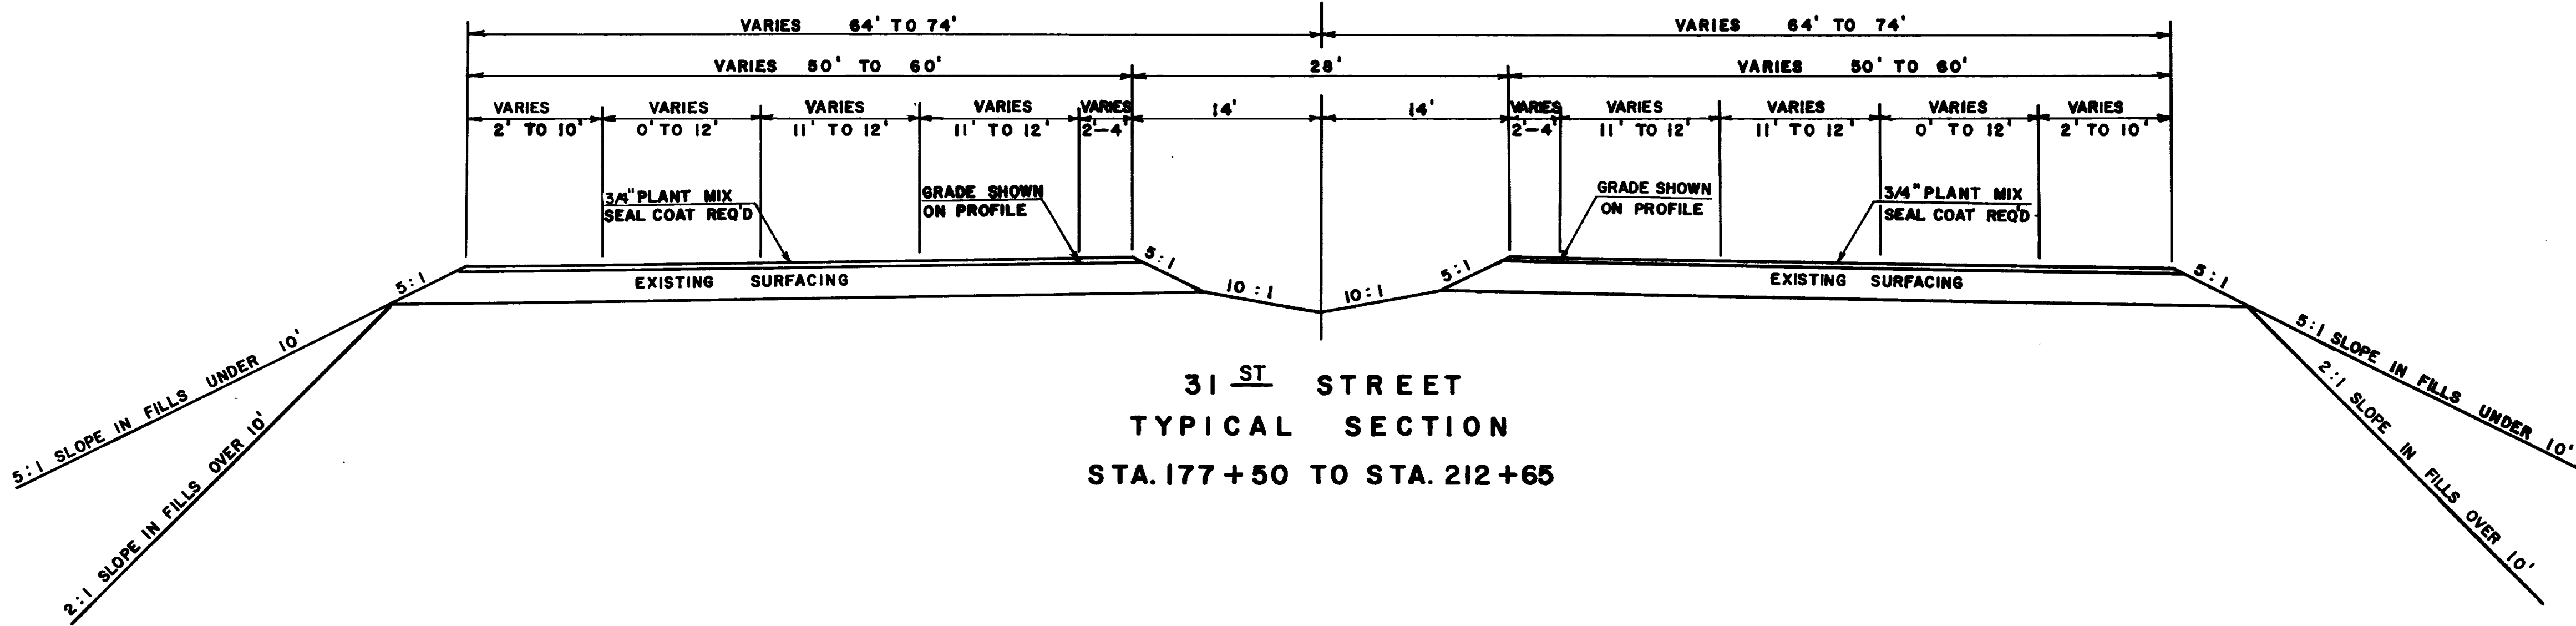


FED. ROAD DIST. NO.	STATE	PROJ. NO.	FISCAL YEAR	SHEET NO.	TOTAL SHEETS
UTAH	UTAH	I-15-8(2)334	1966	2-B	

9THC



STRUCTURE END DRAIN

SEE PLAN SHEET NO. 4

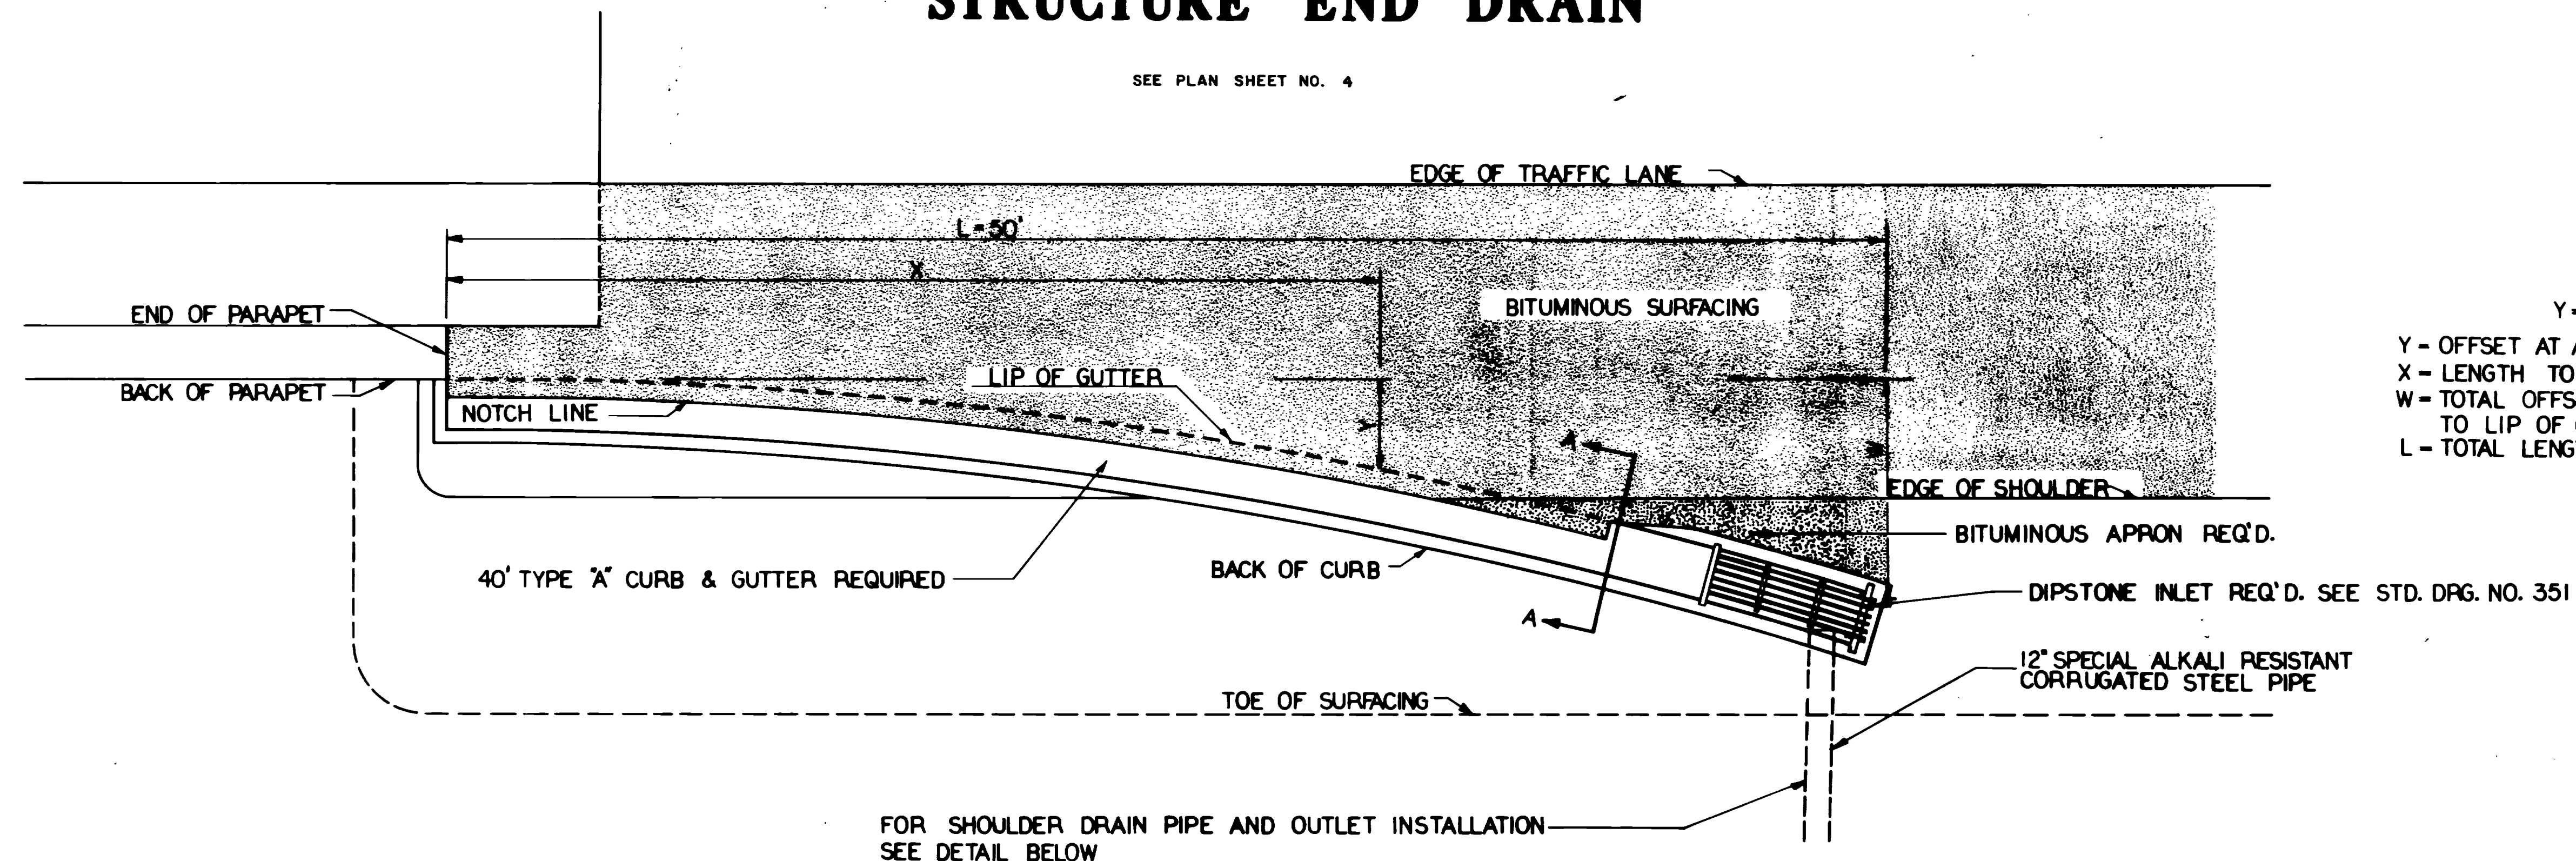

$$Y = W \frac{X^2}{L^2}$$

Y - OFFSET AT ANY POINT
X - LENGTH TO "Y" FROM END OF PARAPET
W - TOTAL OFFSET FROM BACK OF PARAPET TO LIP OF GUTTER
L - TOTAL LENGTH OF END DRAIN

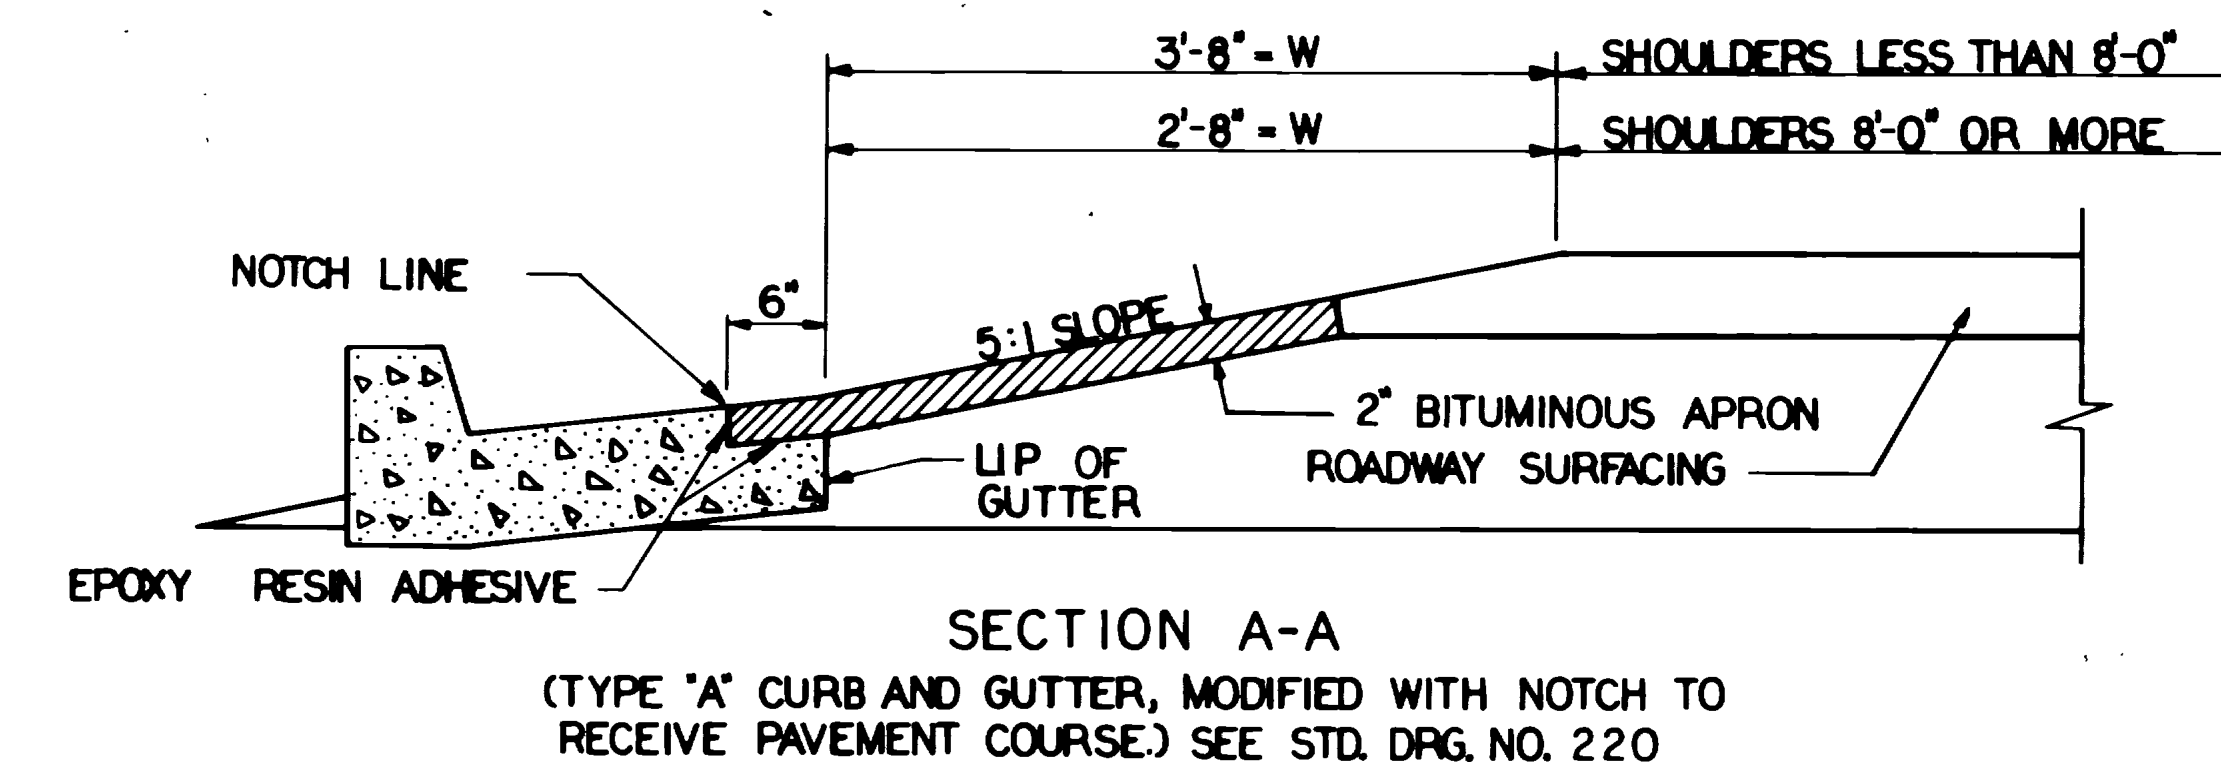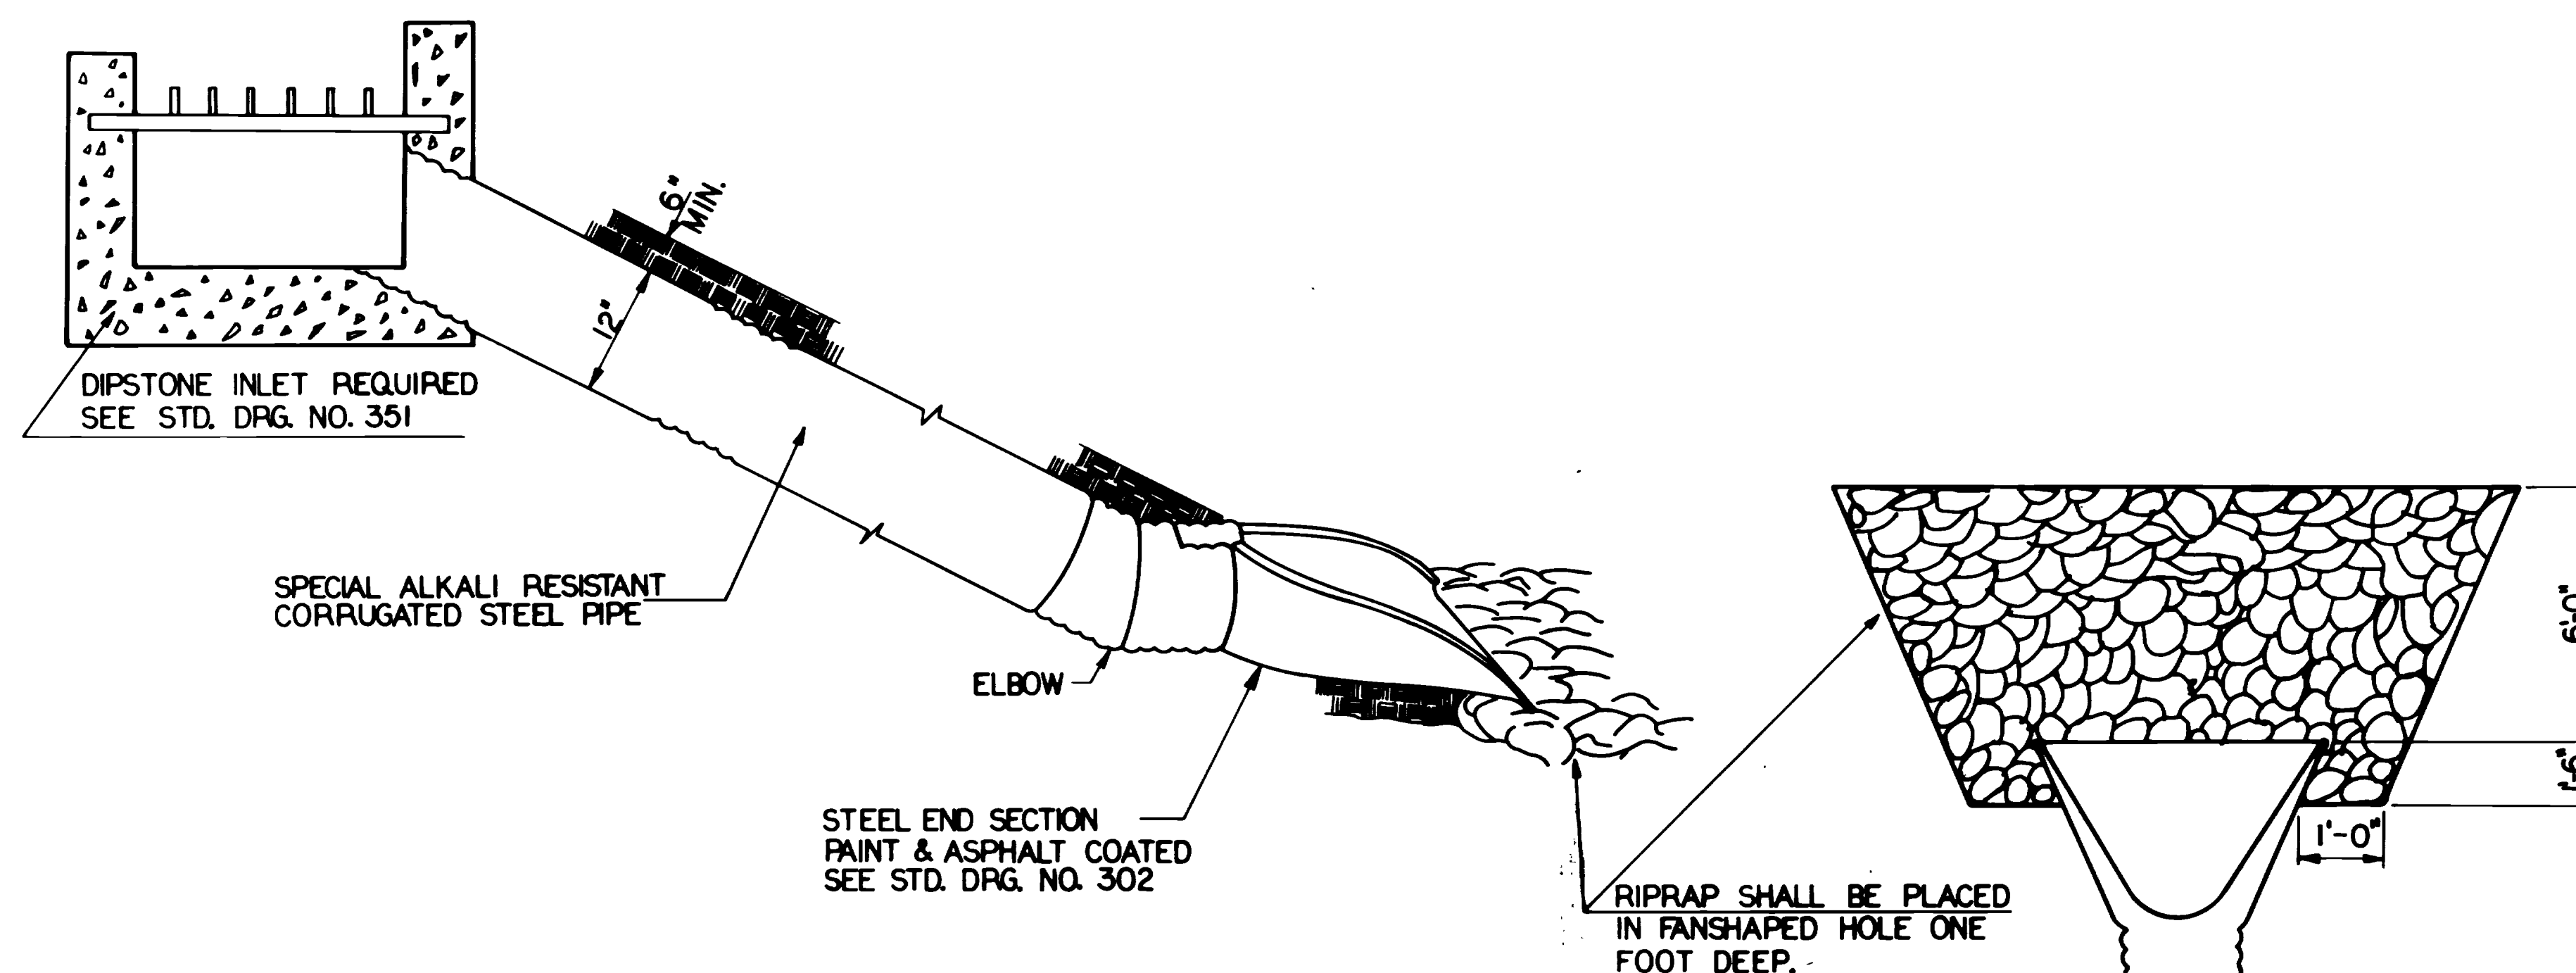

SECTION A-A
(TYPE 'A' CURB AND GUTTER, MODIFIED WITH NOTCH TO RECEIVE PAVEMENT COURSE.) SEE STD. DRG. NO. 220

SHOULDER DRAIN PIPE & OUTLET INSTALLATION DETAIL

The information on these materials prospects shall in no way be construed so as to conflict with "Division I, Section 1-6.2 of Designated Local Materials Sources of the State of Utah Standard Specifications, 1960 Edition and Supplements,"

Ground Water Table (G.W.T.) = , = Test Hole

Bottom of Test Hole = * , = Section No.

Section Line (S) = _____

1/4 Section Line = _____

1/16 Section Line = _____

℄ Proposed Highway = _____

Prospect Boundary = _____ . _____ . _____ .


Property Boundary =








Topsoil or Fill *Clay* *Silt* *Sand* *Gravel & Boulders* *Solid Rock*

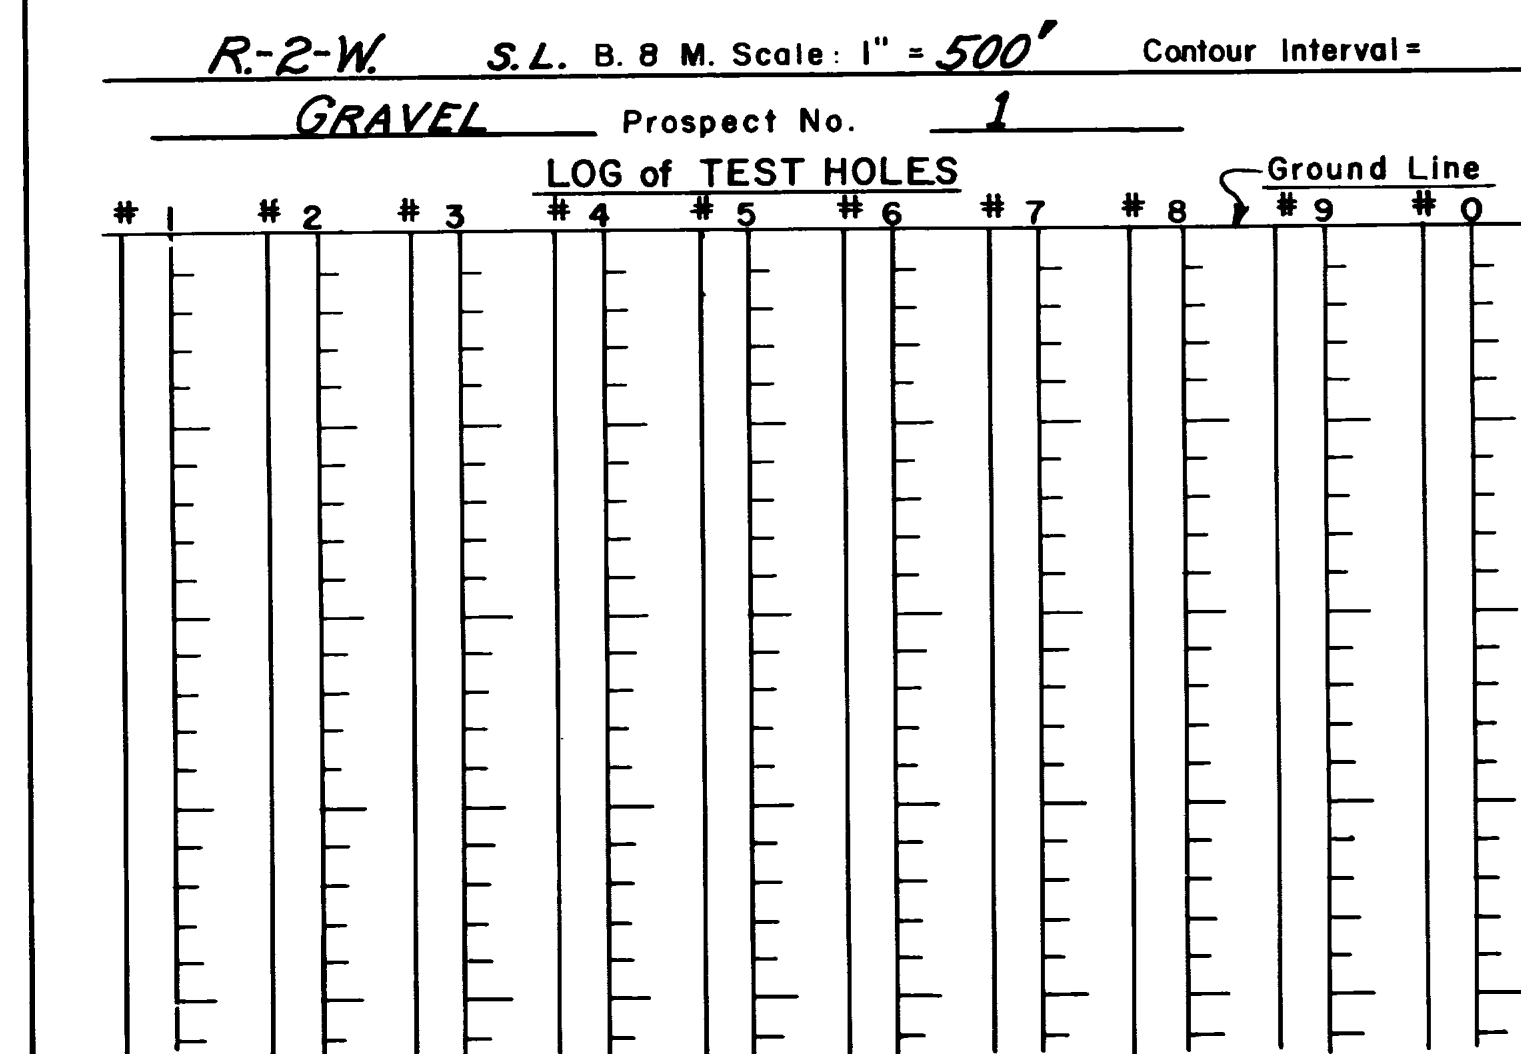[illegible][illegible]

B. & M. Scale: 1" = _____ Contour Interval = _____

Prospect No. _____

LOG of TEST HOLES

1 # 2 # 3 # 4 # 5 # 6 # 7 # 8 # 9 # 0

Ground Line

* 12" CORRUGATED PERFORATED STEEL PIPE UNDERDRAIN
 * * SPECIAL ALKALI RESISTANT
 TOTAL USED 10801440 1591 371 343 514

TOTAL USED	361.3	9895	1451	81.8	22.8
------------	-------	------	------	------	------


12" CORRUGATED PERFORATED STEEL PIPE UNDERDRAIN
SPECIAL ALKALI RESISTANT

LINE OR LANE	GRAVEL BASE COURSE	ROLLING 1800 SQ.YD./HR.
	SQ. YD.	HOURL
T-1	6919.15	3.84
T-4	5987.25	3.33
T-6	4537.50	2.52
T-7	3310.69	1.84
T-1 DECEL	544.00	0.30
I-15 - N.B.	5800.08	3.22
I-15 - N.B.	691.20	0.38
I-15 - N.B.	2625.00	1.46
I-15 - N.B.	3395.14	2.22
I-15 - N.B.	884.30	0.49
I-15 - S.B.	3194.44	1.77
I-15 - S.B.	2601.18	1.45
I-15 - S.B.	3565.73	1.98
I-15 - S.B.	4089.19	2.27
I-15 - S.B.	715.89	0.40
	Total	27.49
	USE	30.00


FED. ROAD DIST. NO.	FED. AID. PROJ. NO.	FISCAL YEAR	SHEET NO.	TOTAL SHEETS
UTAH	I-15-2(1)334	1966	4	

Rev. Date 6/10/66 JTH

1-2+0 S 8

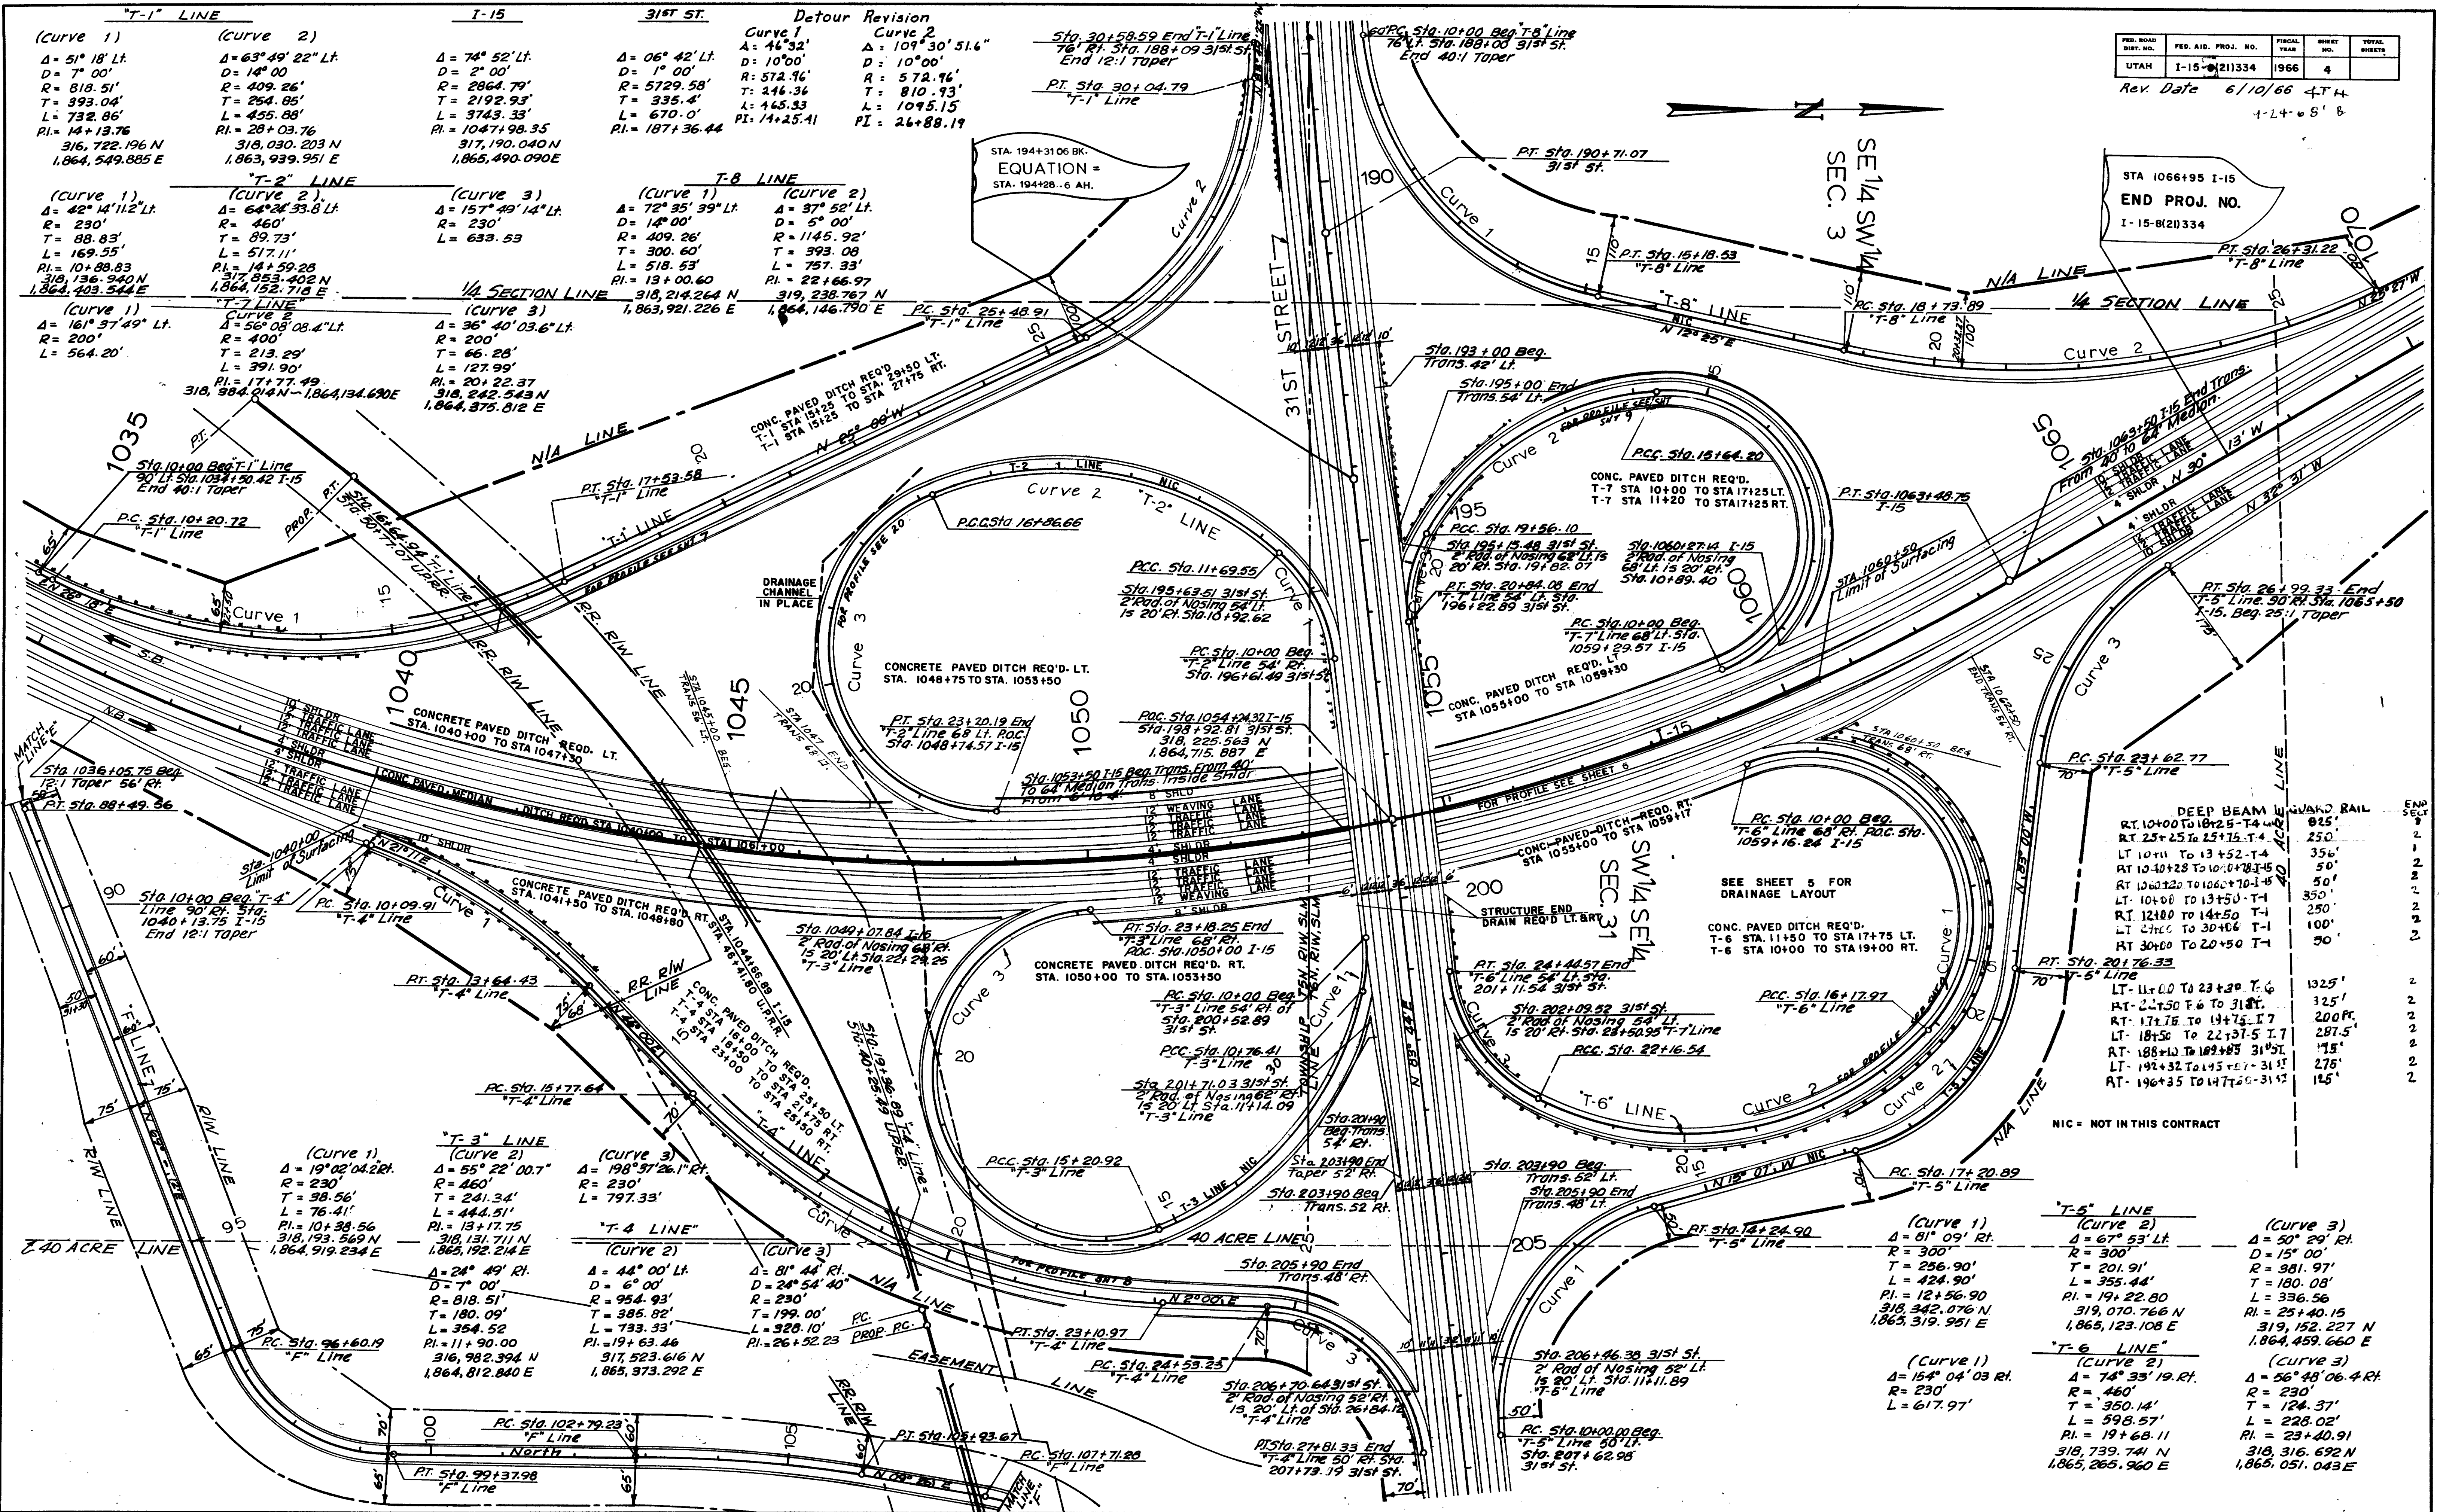

FILE NO.	STATE	CR NO.	FILE NO.	STATE
UTAH	UTAH			
I-15-8(21)334		1966		5
REV. DATE		6/10/66		4TH

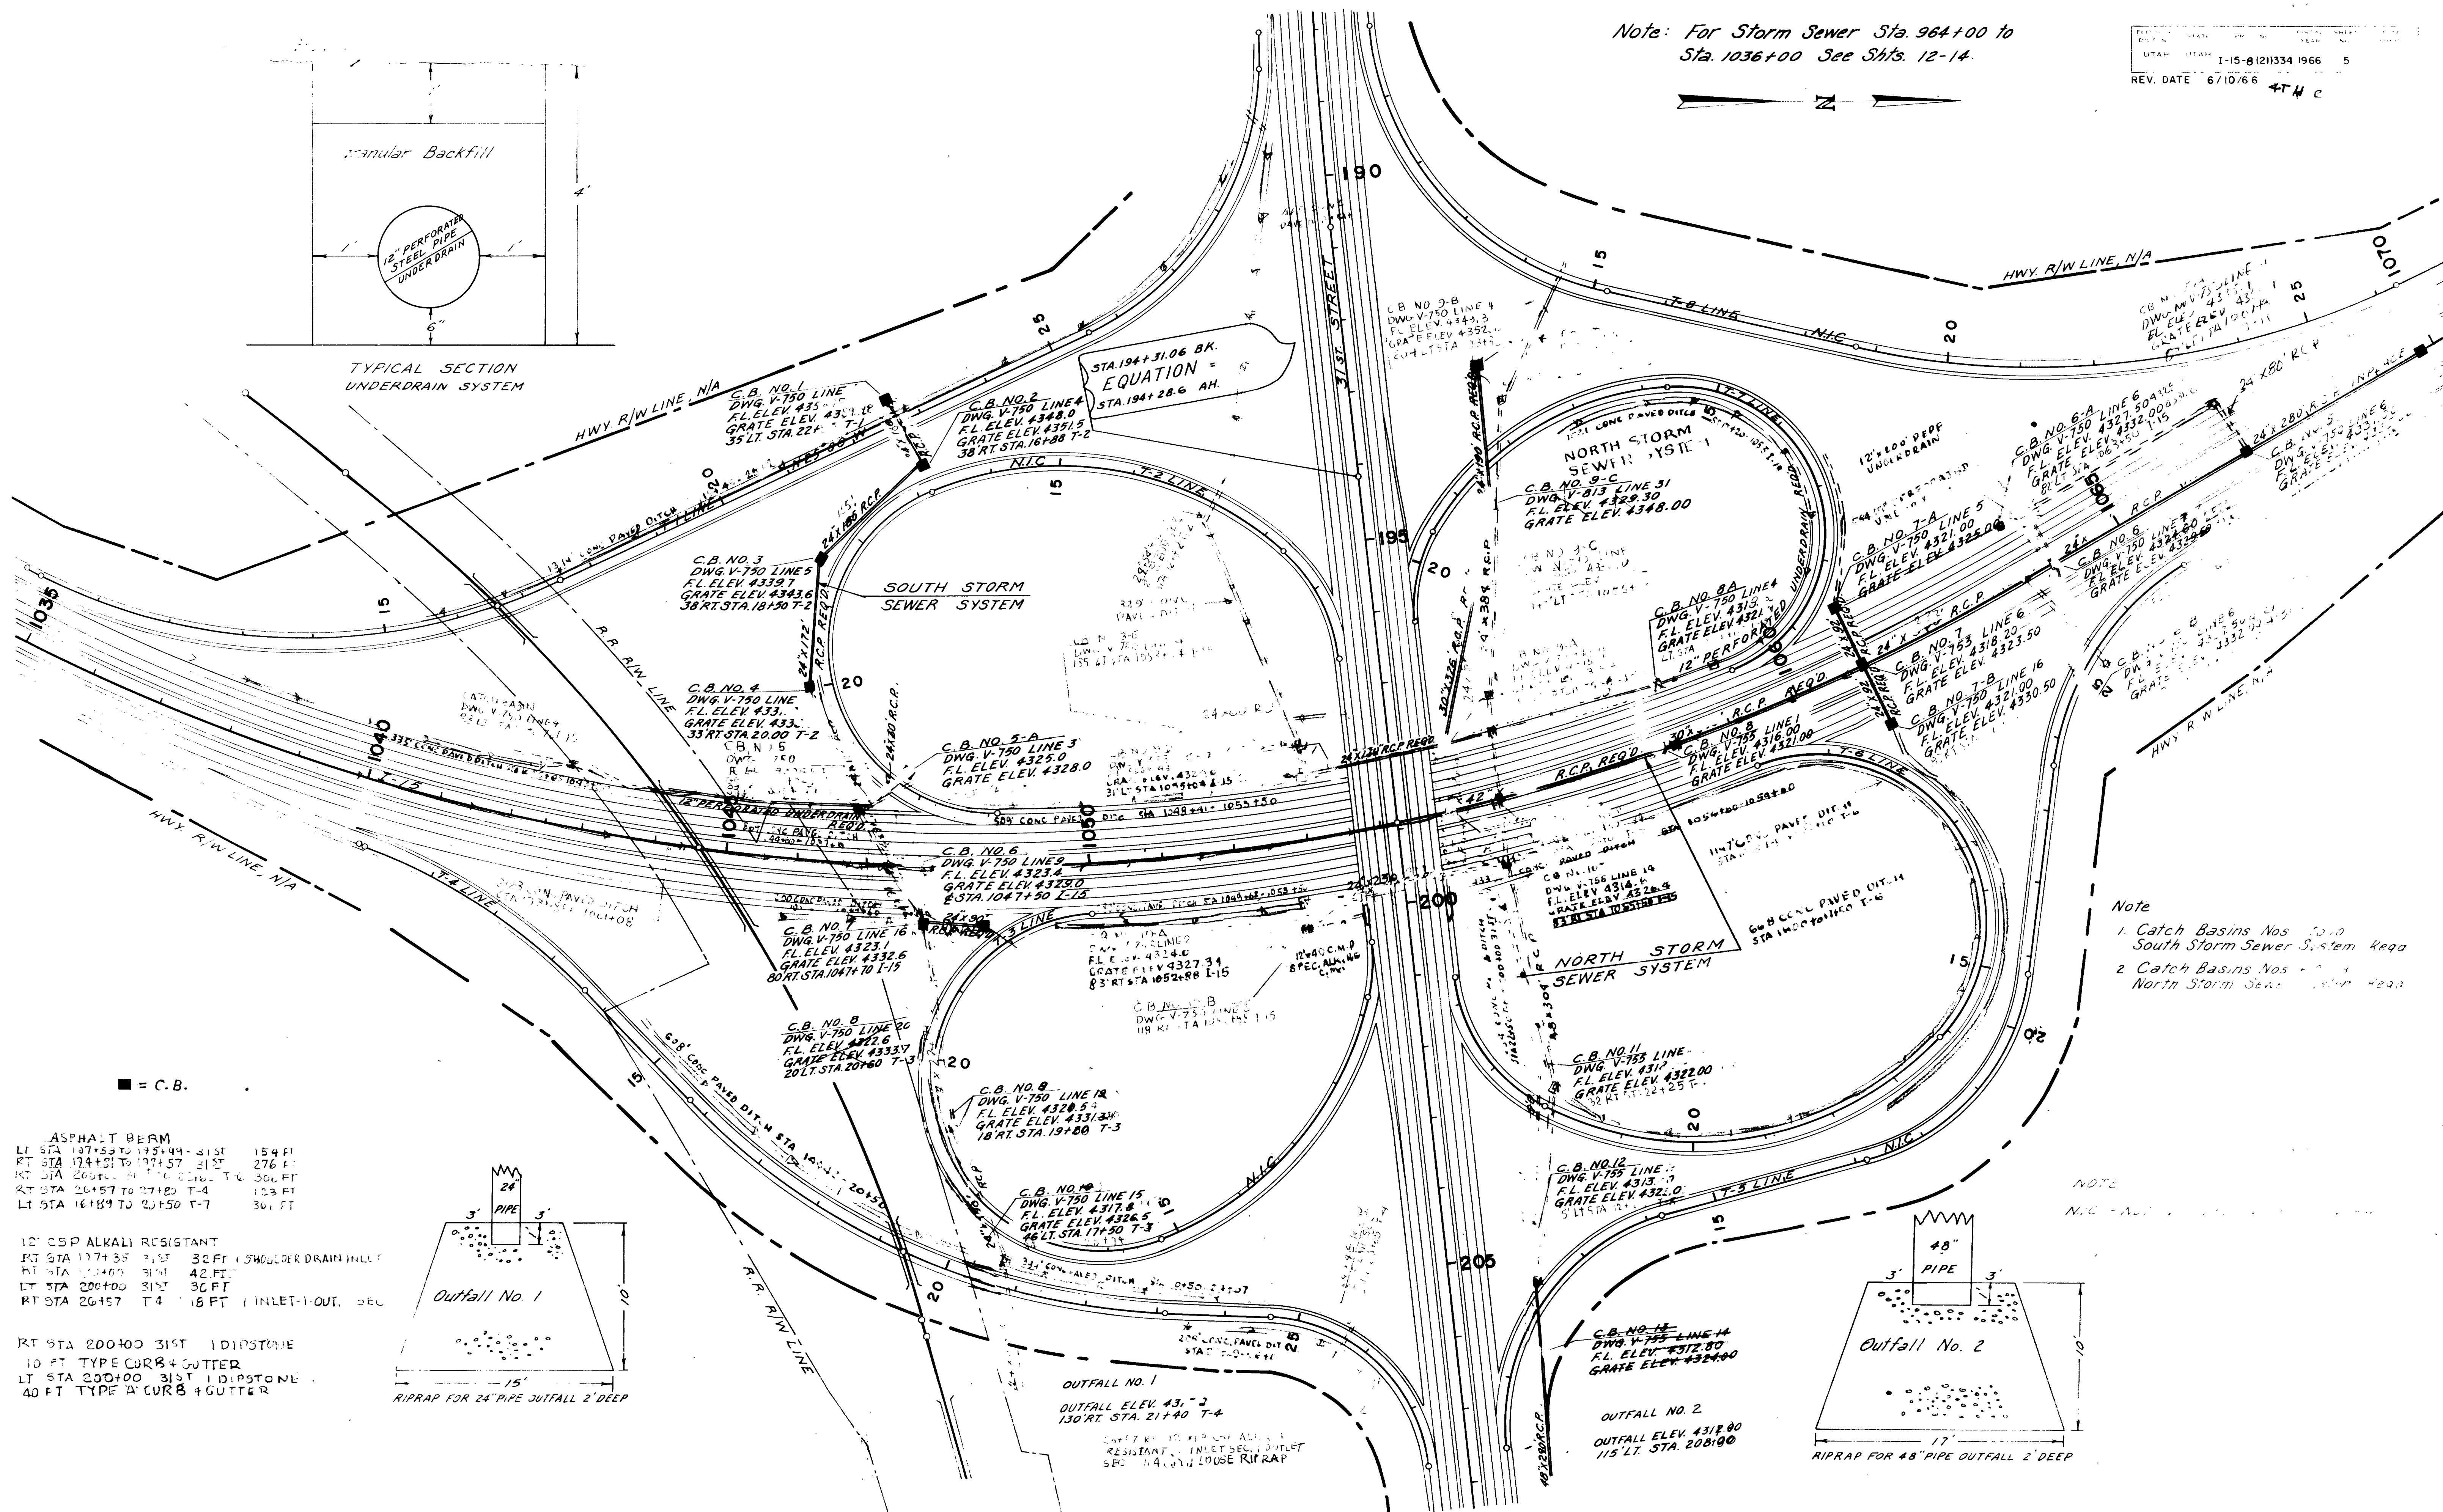



[illegible]



*ALL QUANTITIES ON THIS
SUMMARY ARE SQUARE YARDS


TEST PLOT SUMMARY*

UFE	TOTAL	1	2	3	100
1	2	3	100		

FOR AS CONSTRUCTED SUMMARY SEE D-3147C D-3148

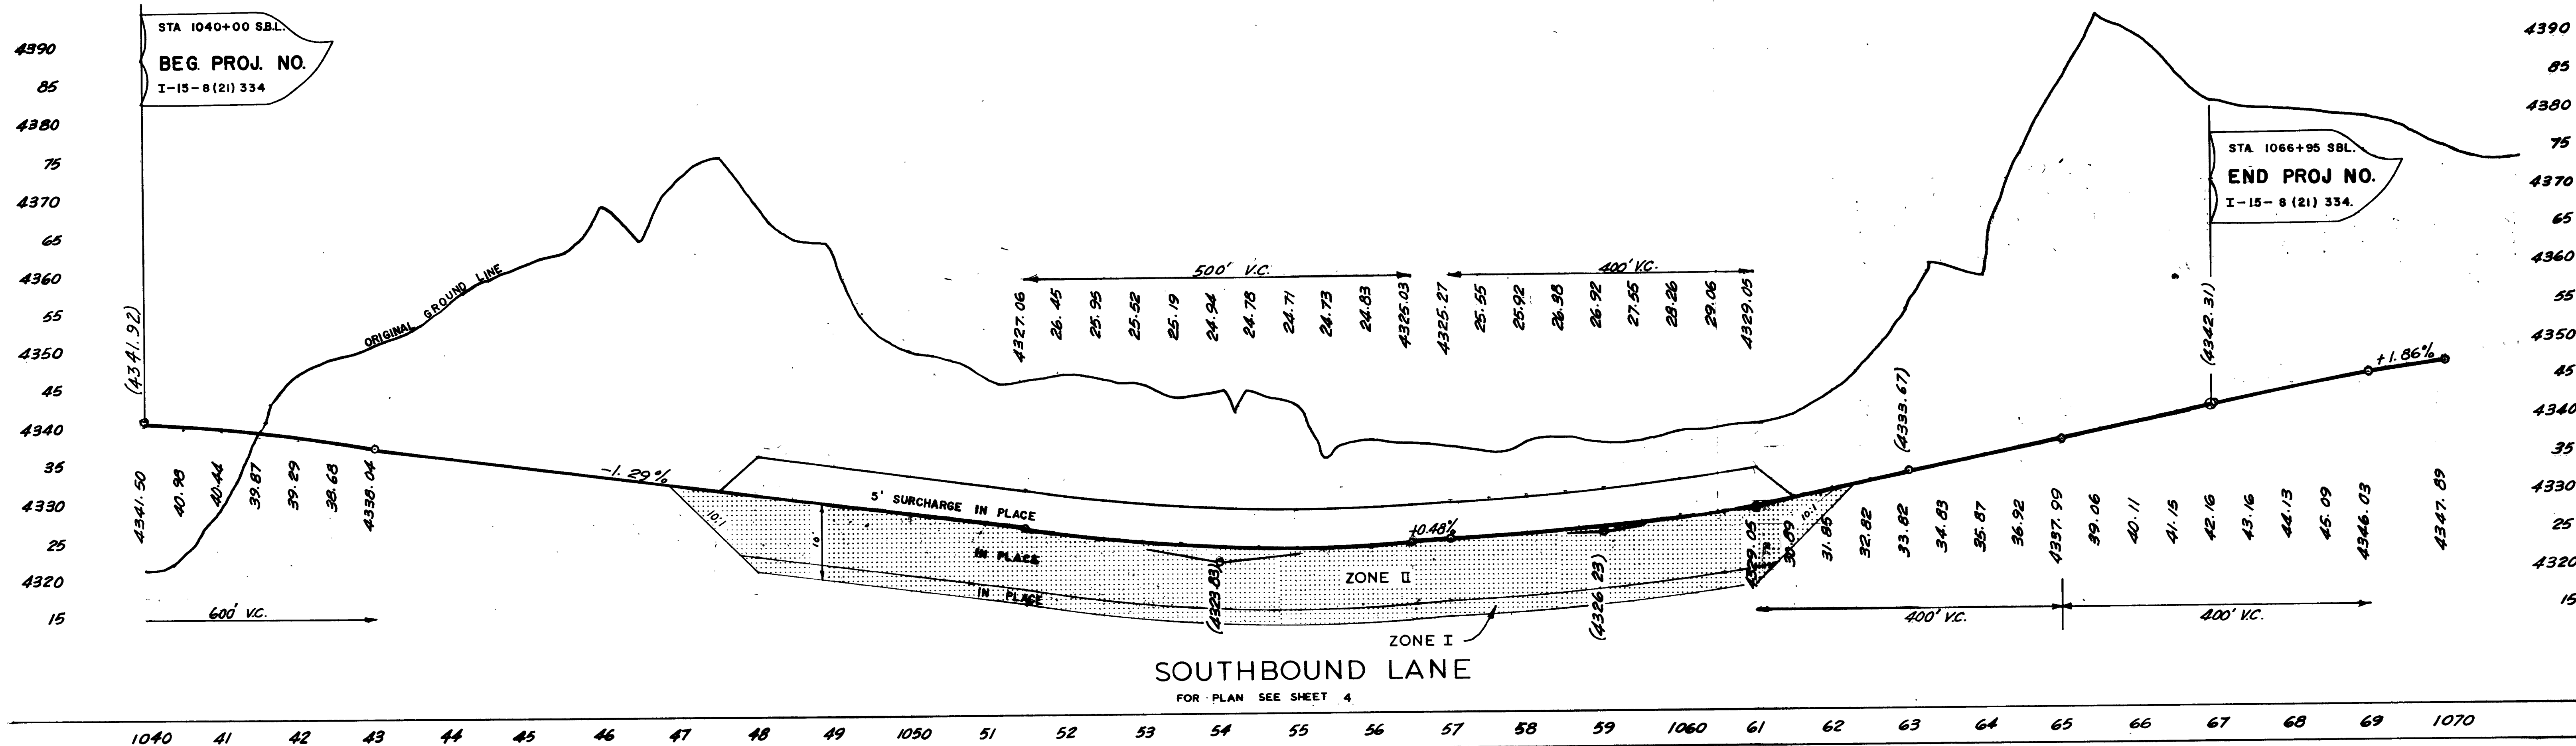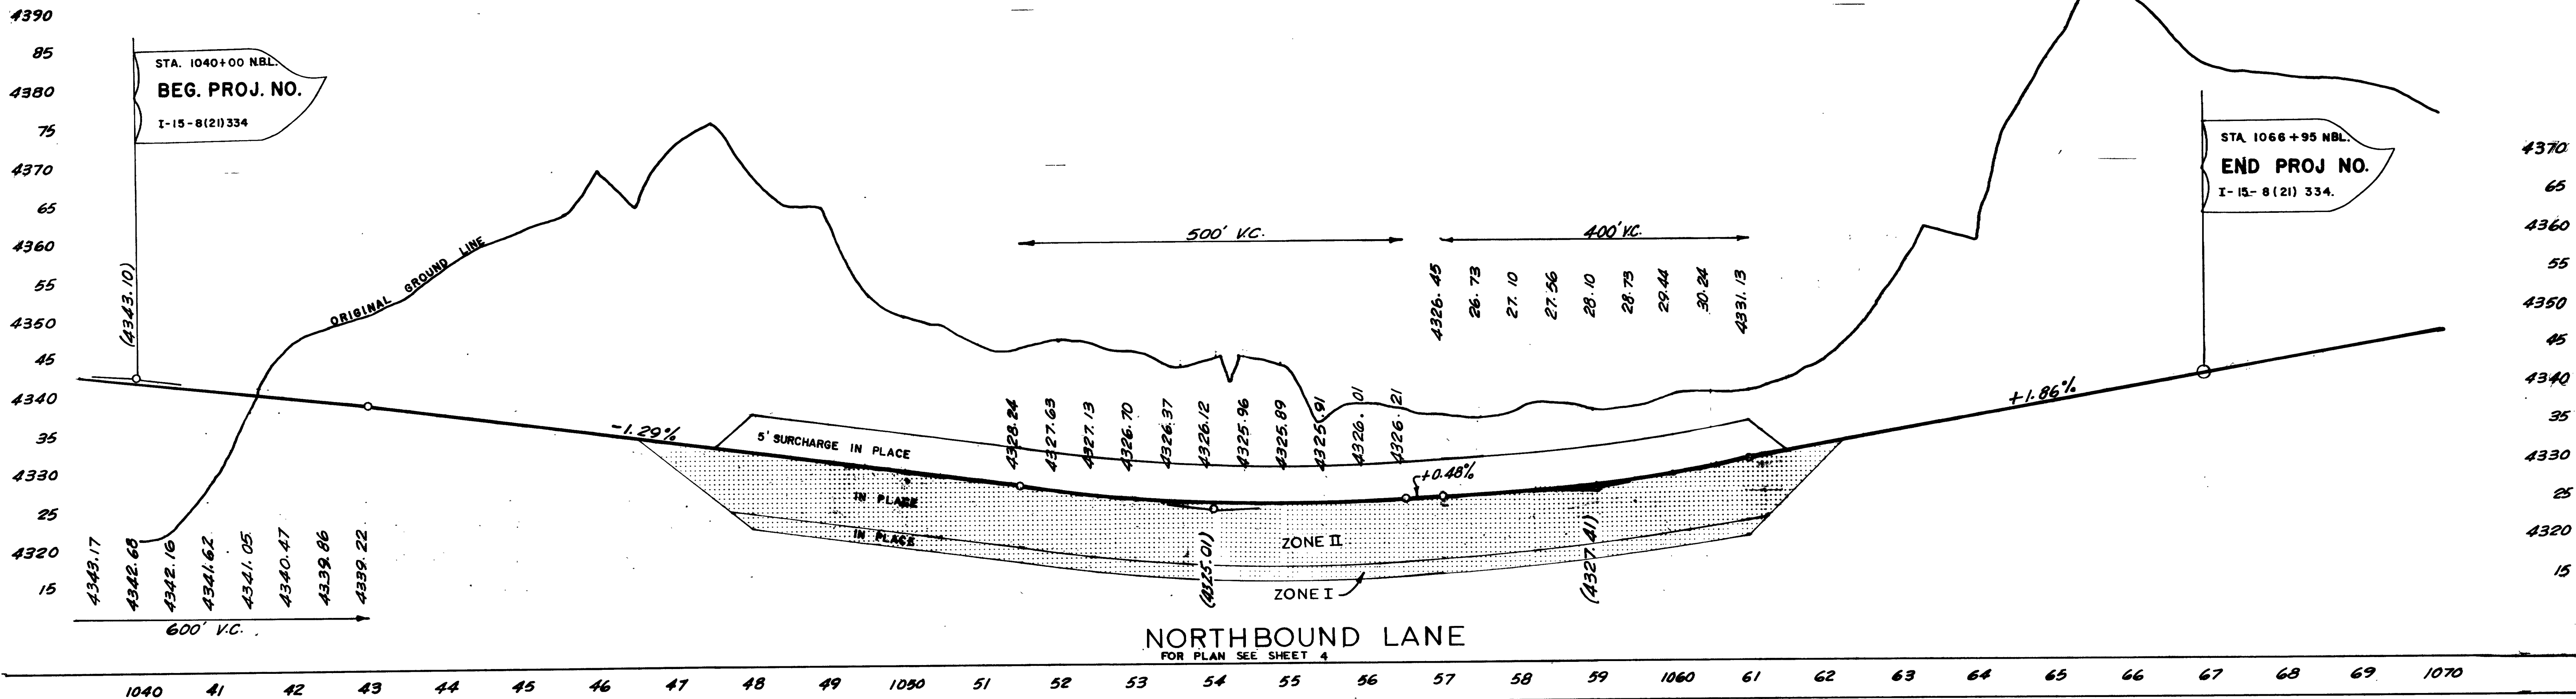

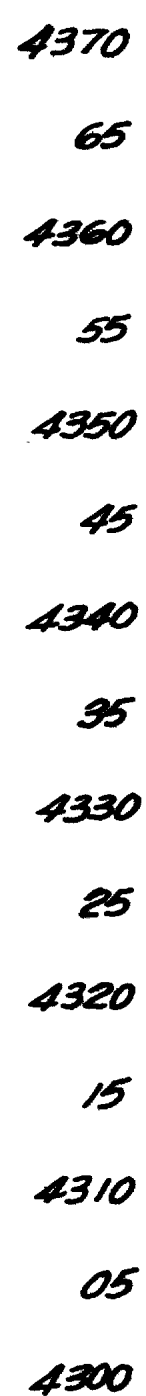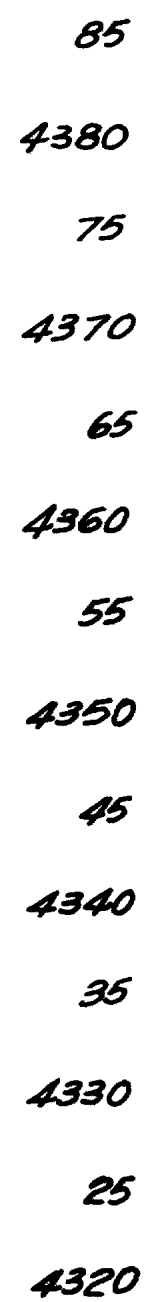


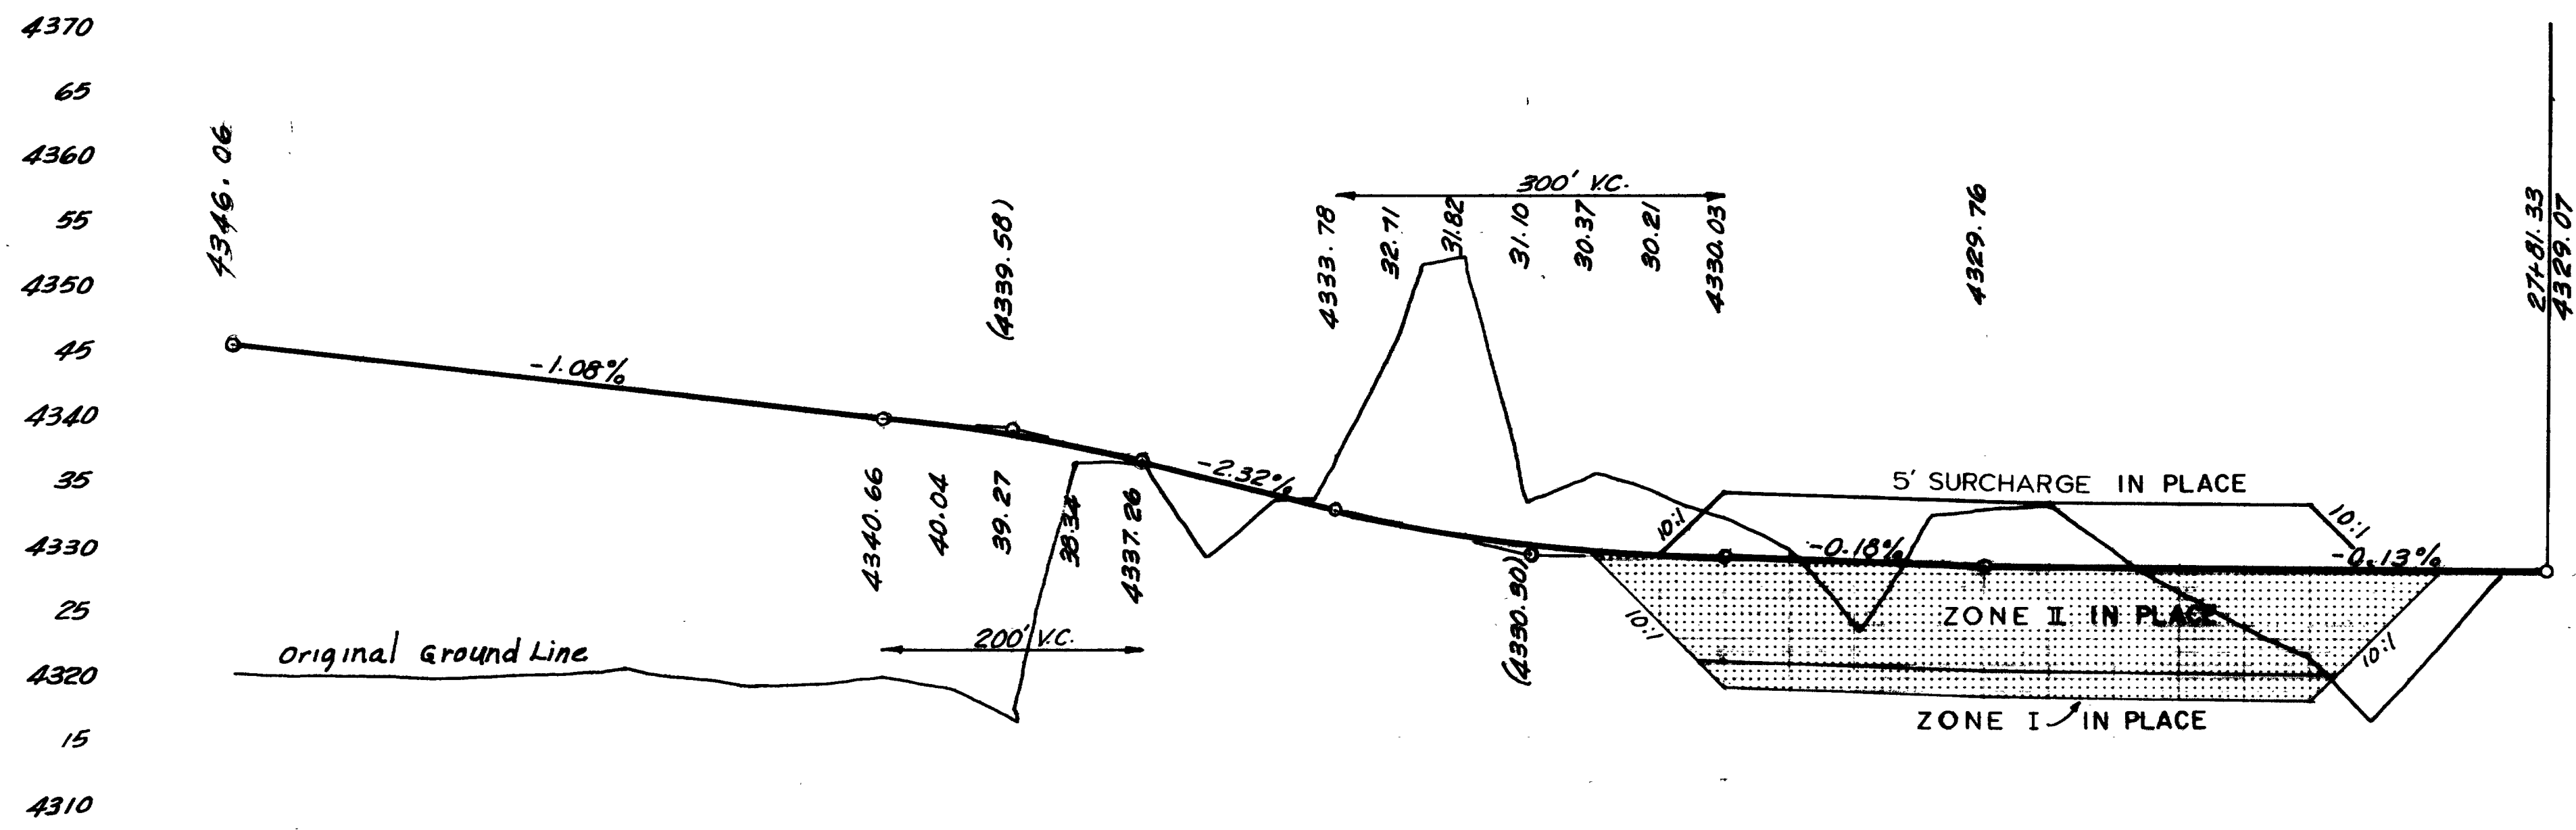

FOR PLAN SHT 4

T-4 LINE



10 11 12 13 14 15 16 17 18 19 20 21 22 23 24 25 26 27 28 29 30

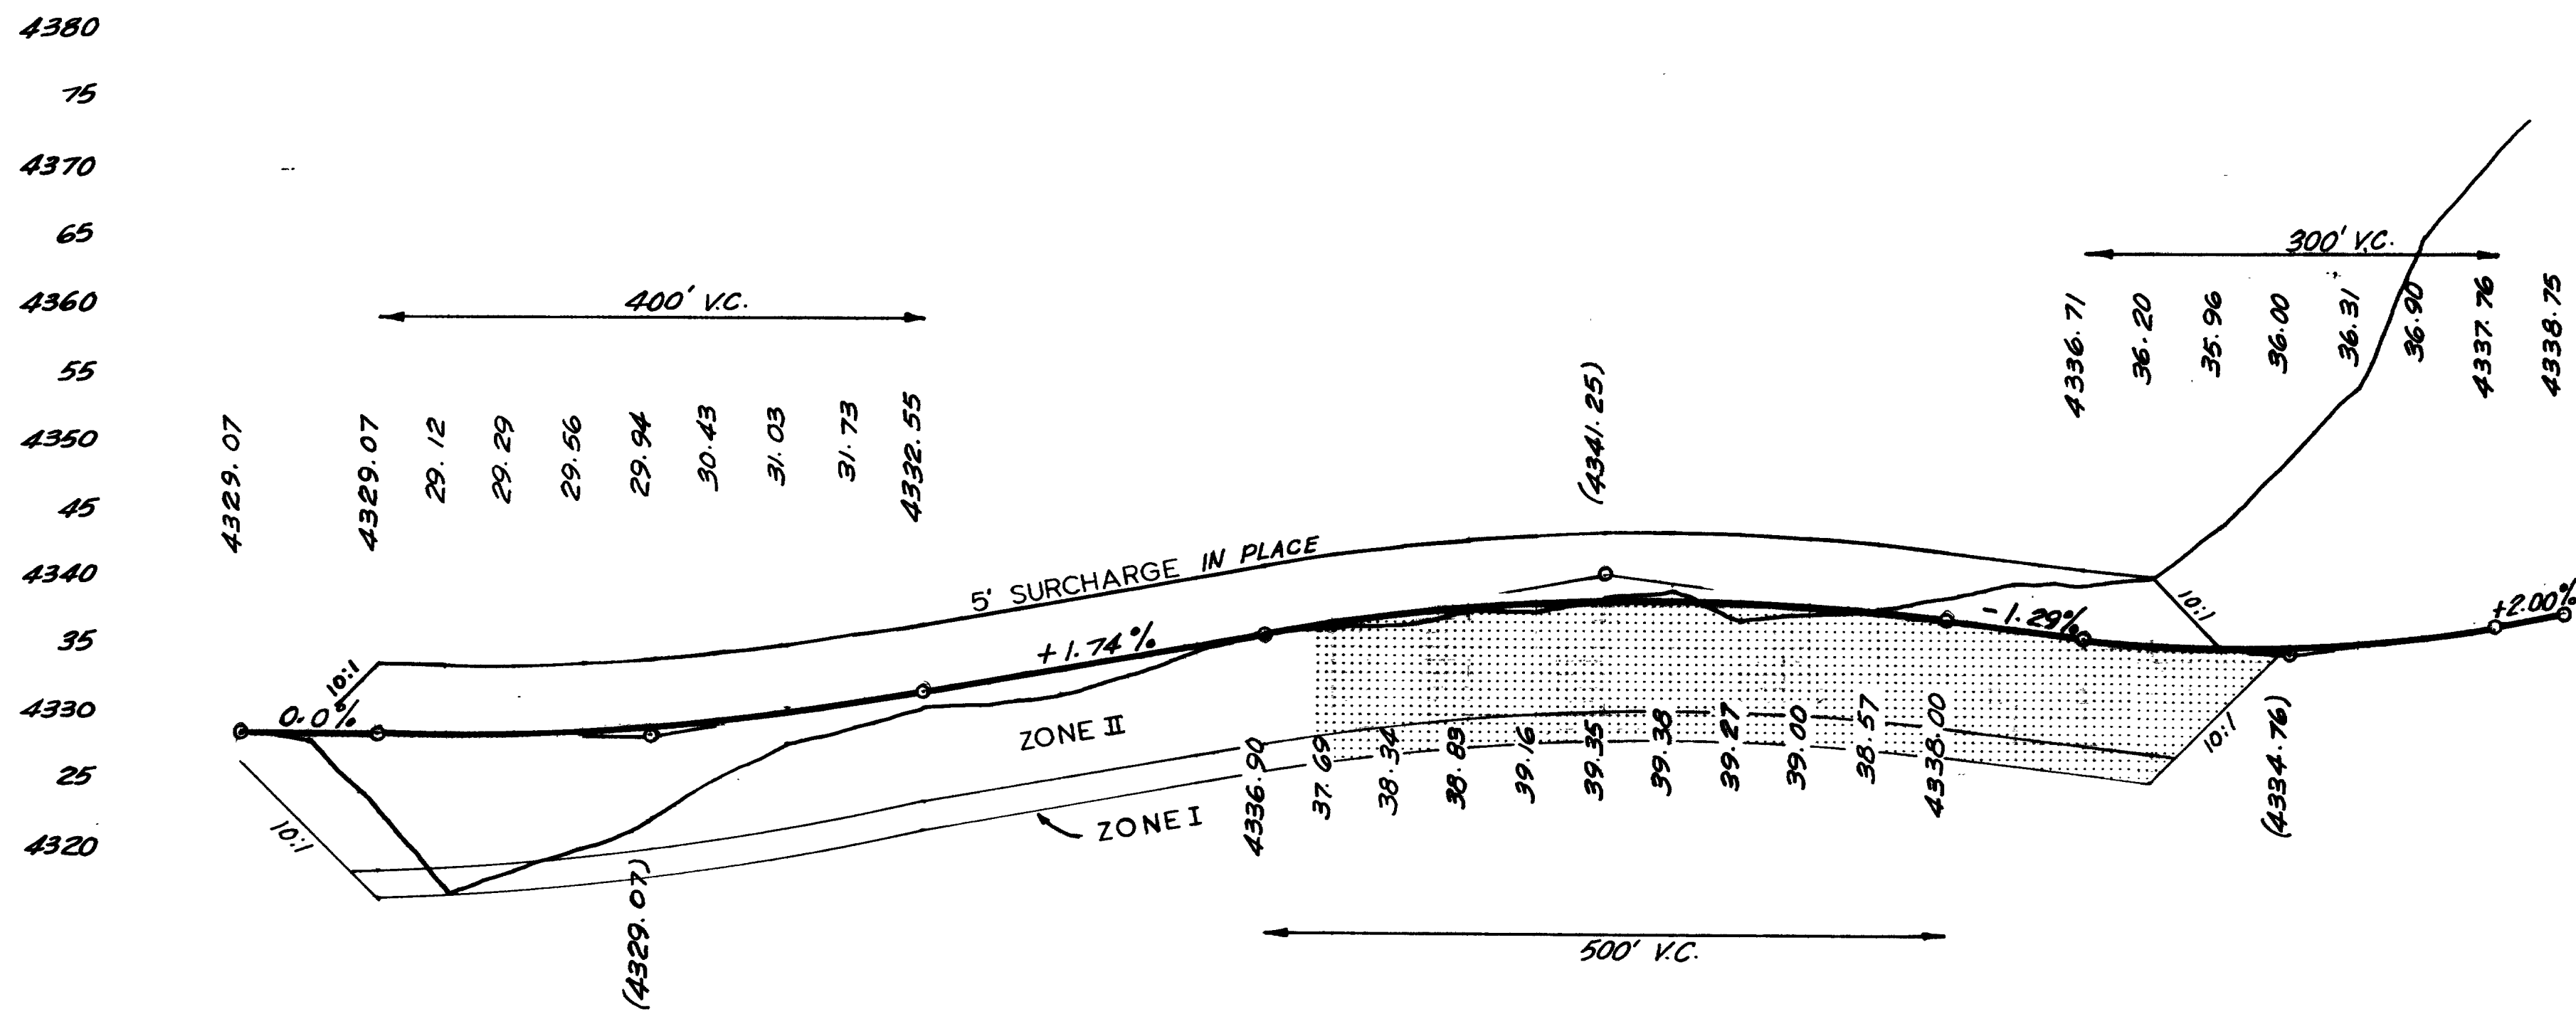

NOT IN CONTRACT

T-5 LINE


10 11 12 13 14 15 16 17 18 19 20 21 22 23 24 25 26 27 28

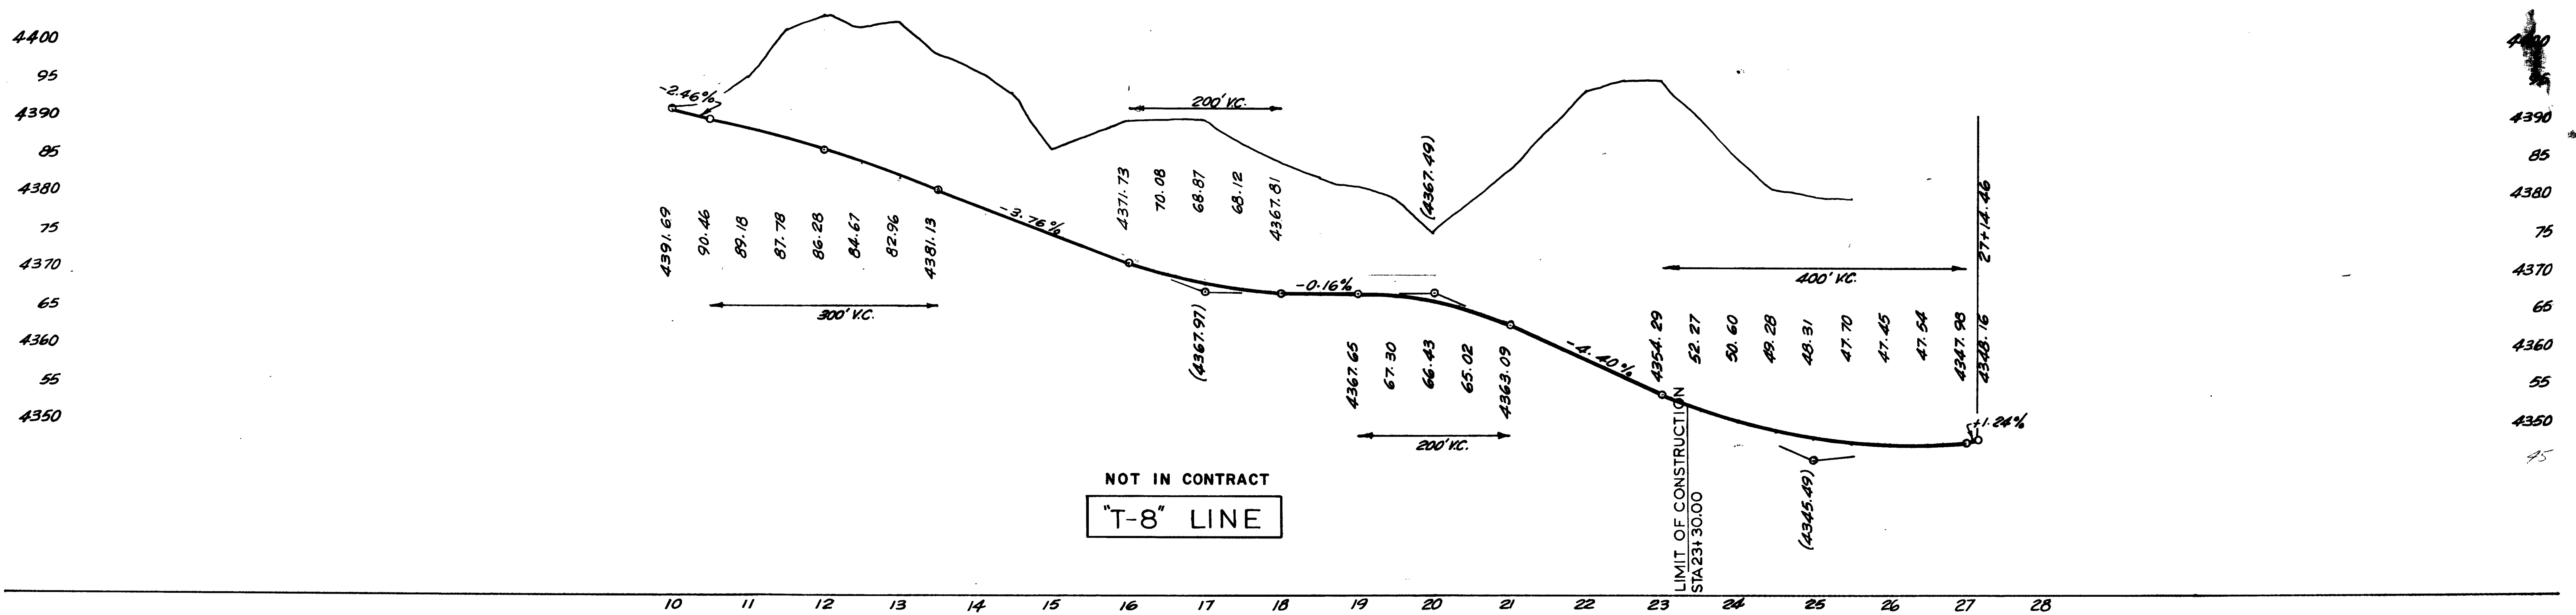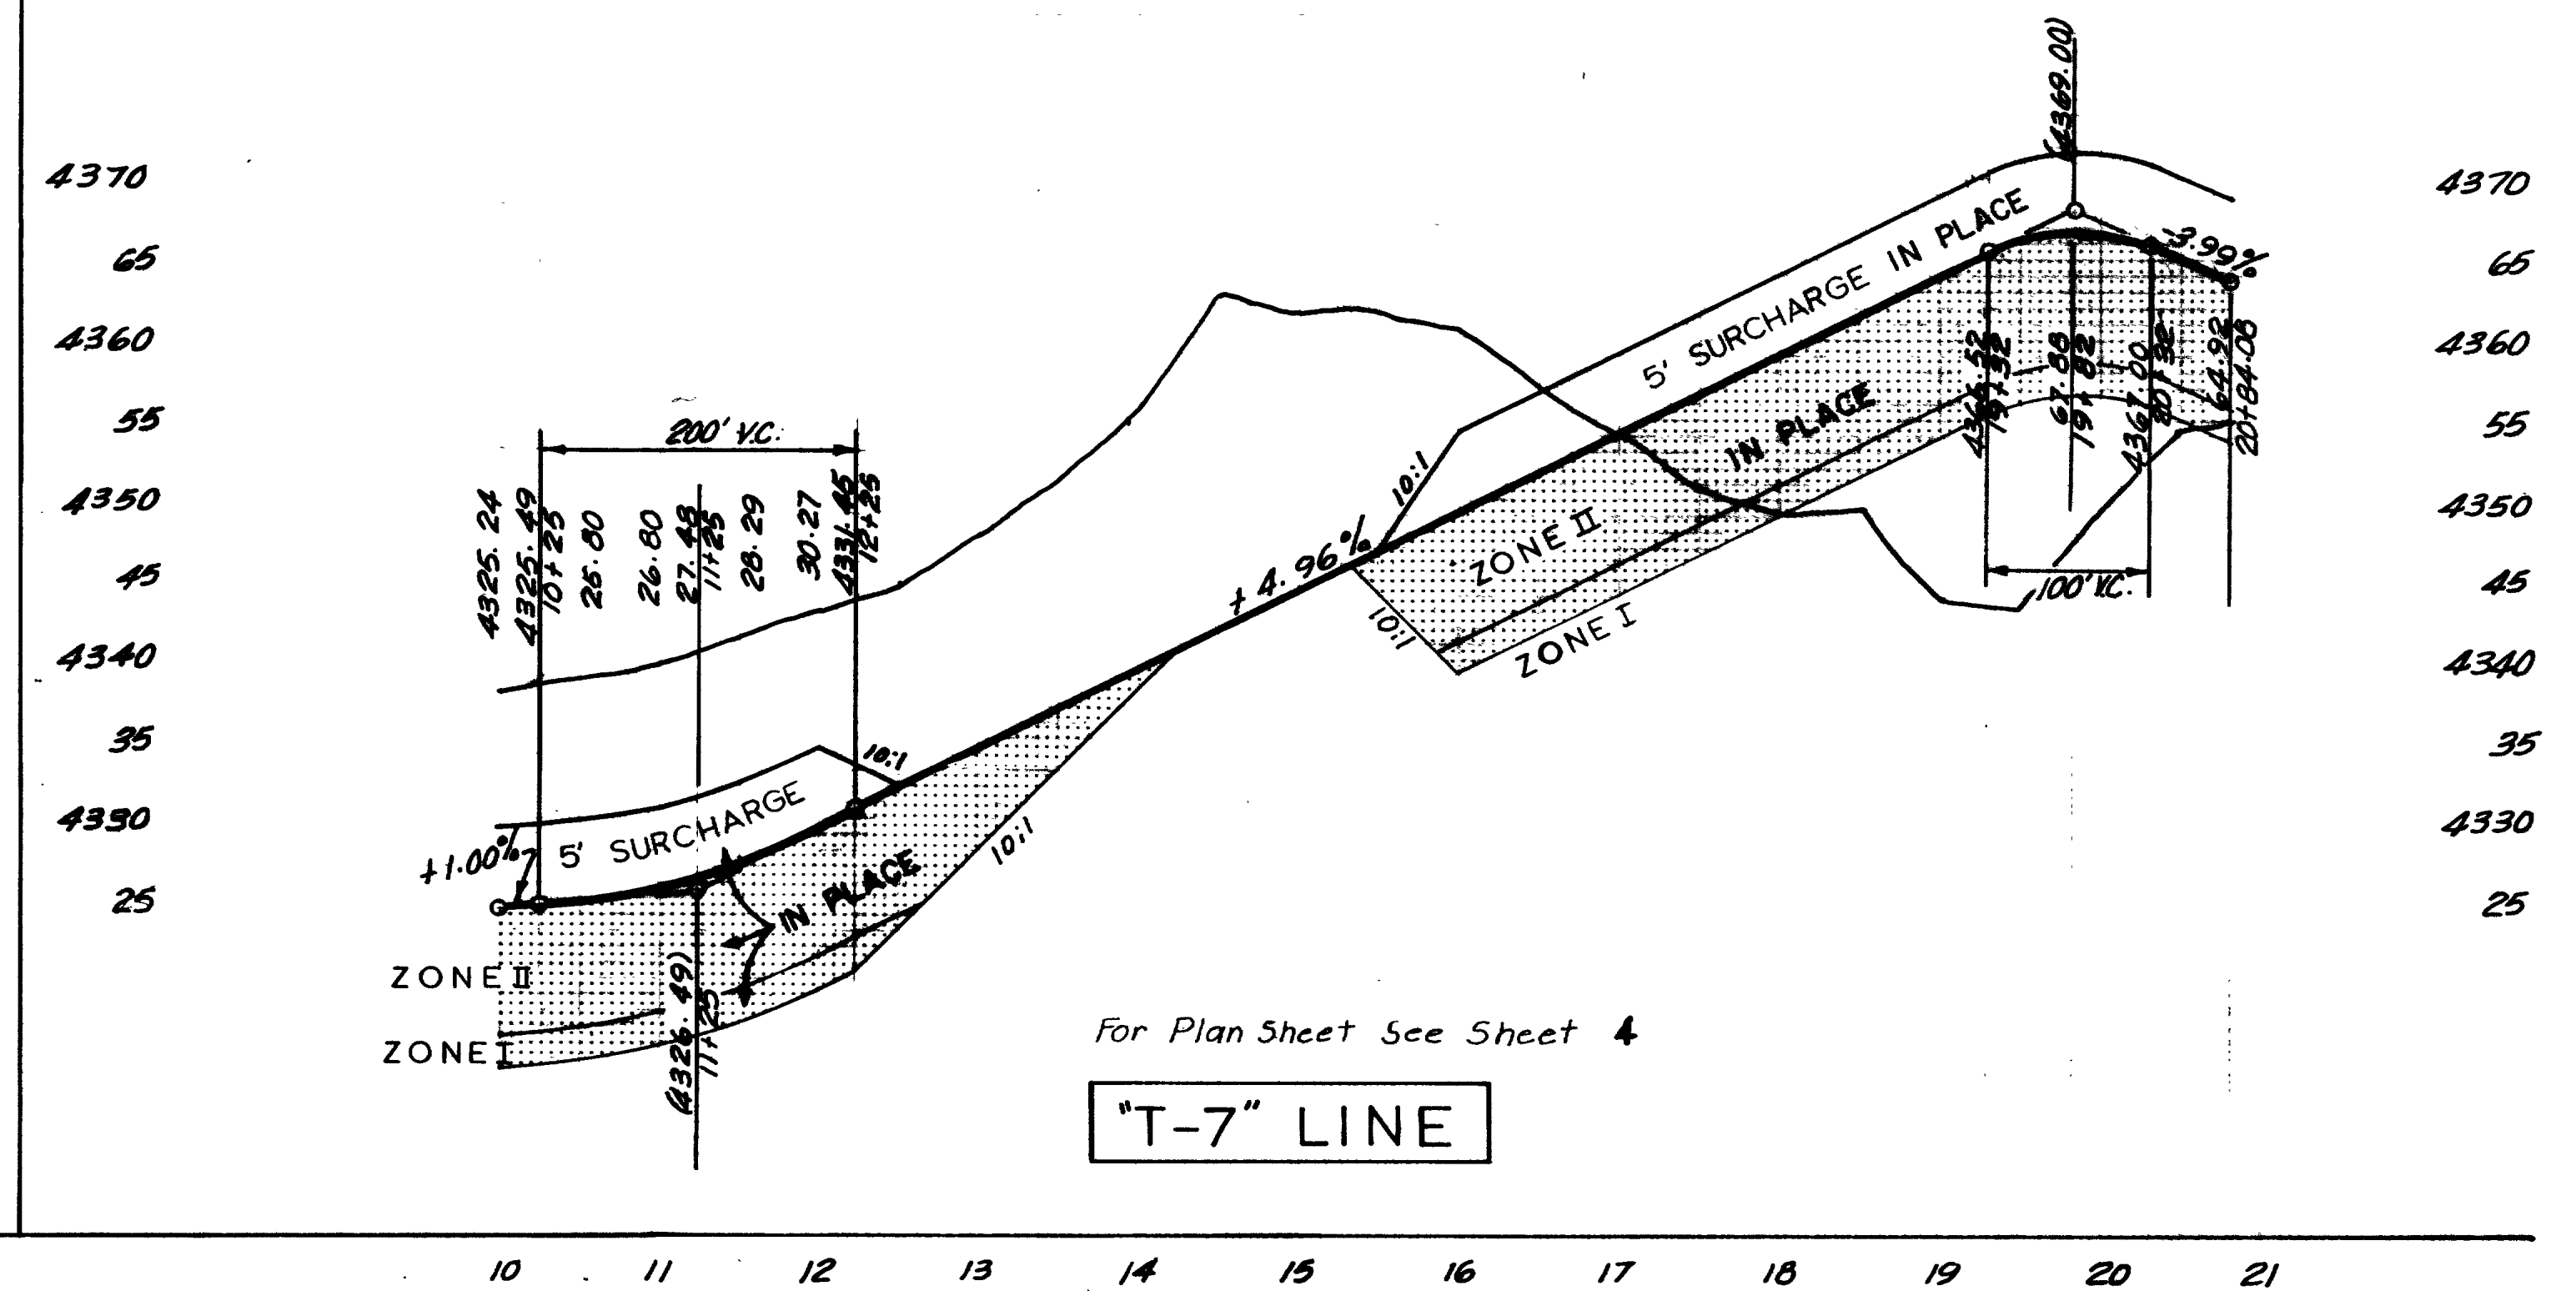




4TH C

31st STREET PROFILE

FOR PLAN SHEET NO. 4


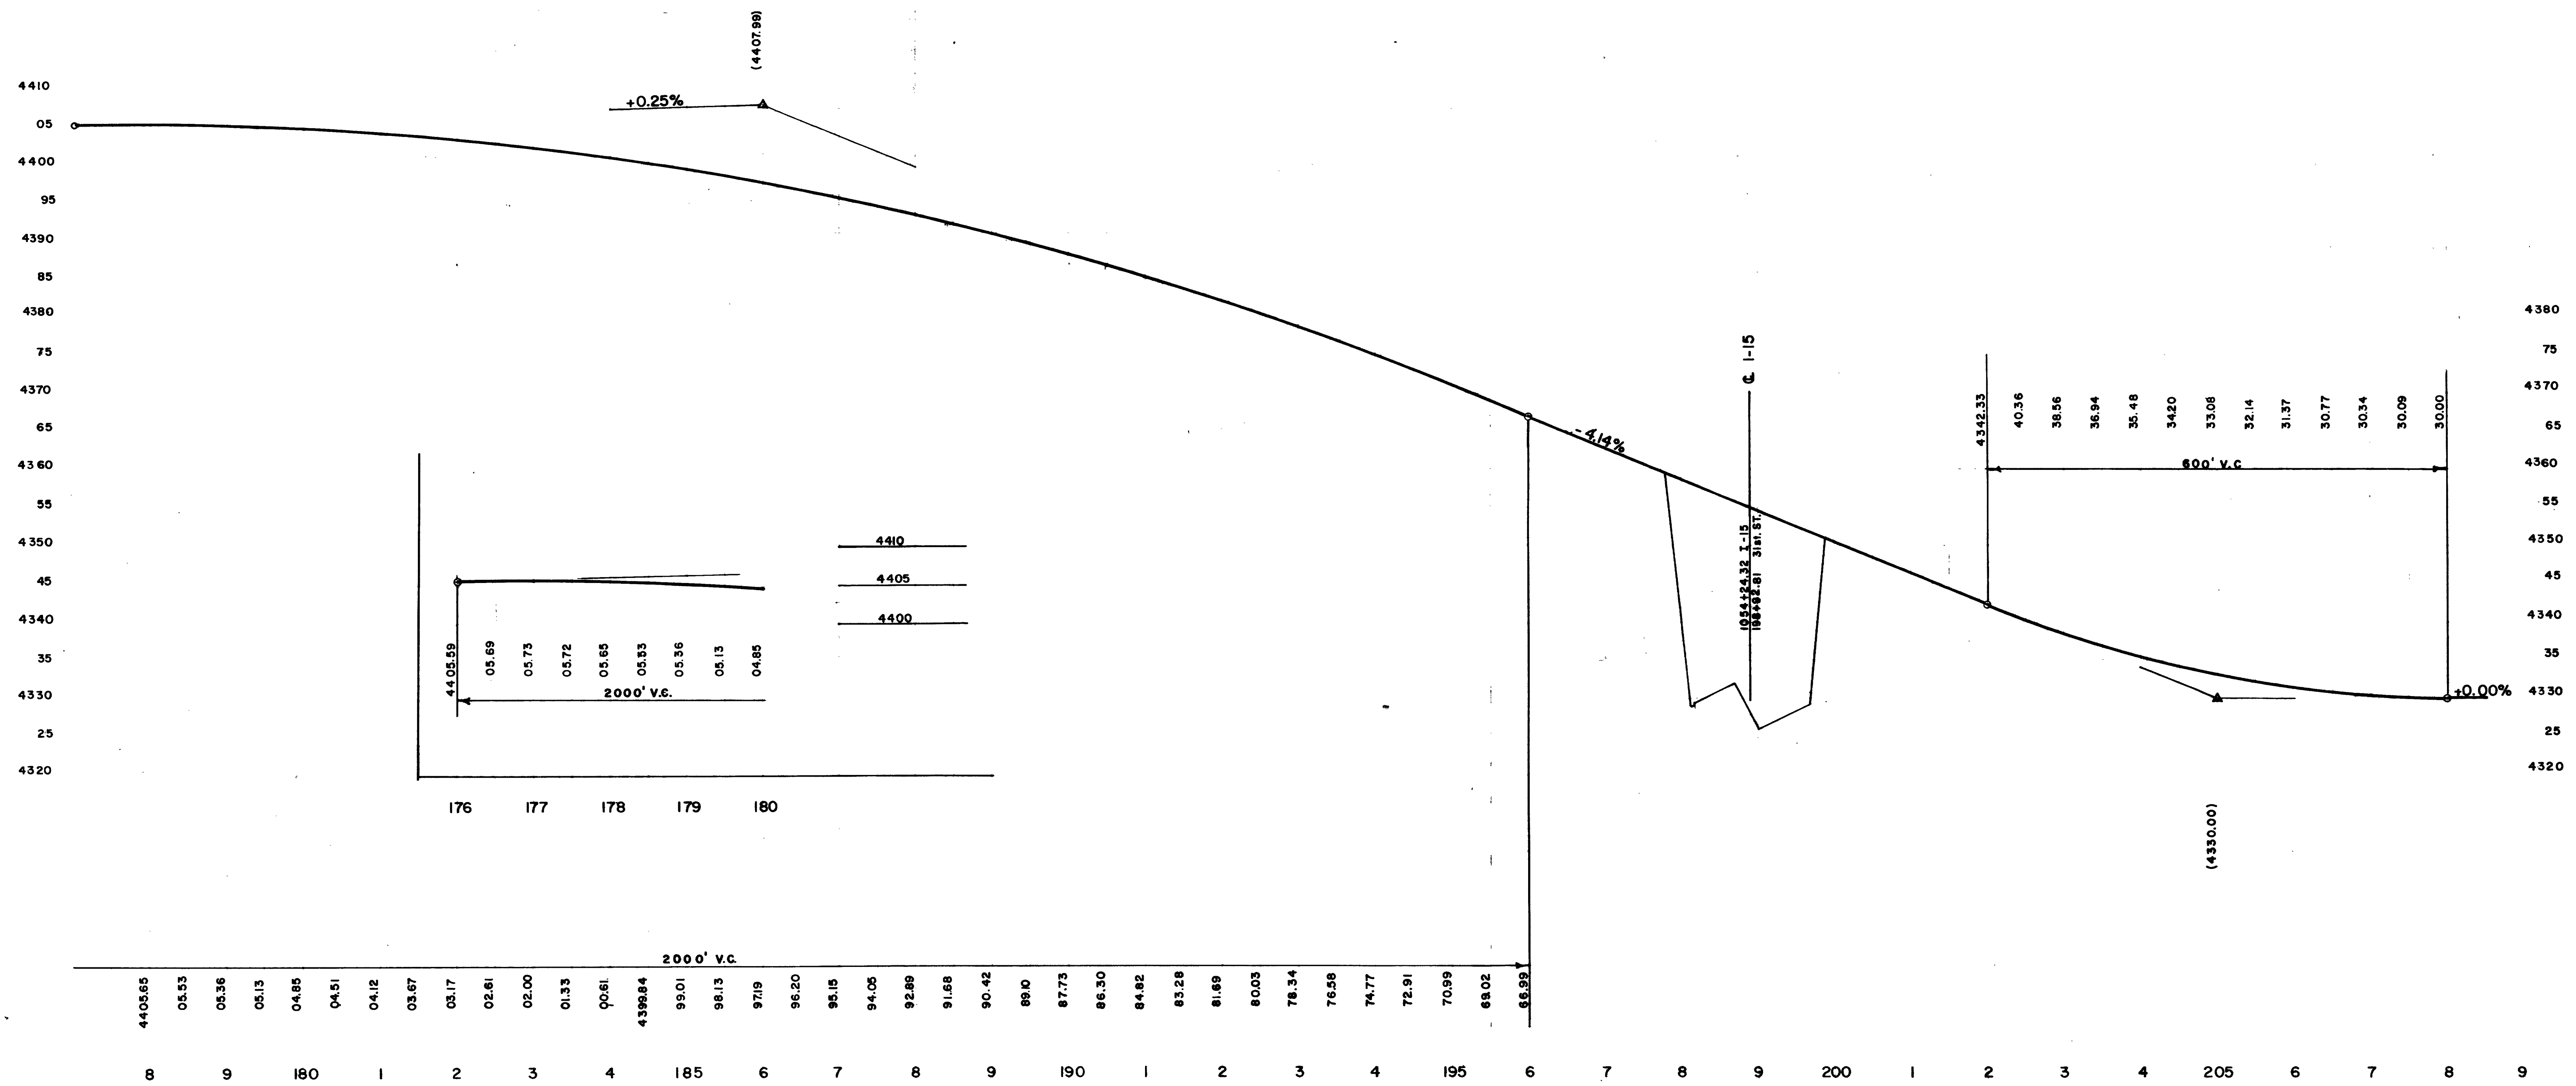



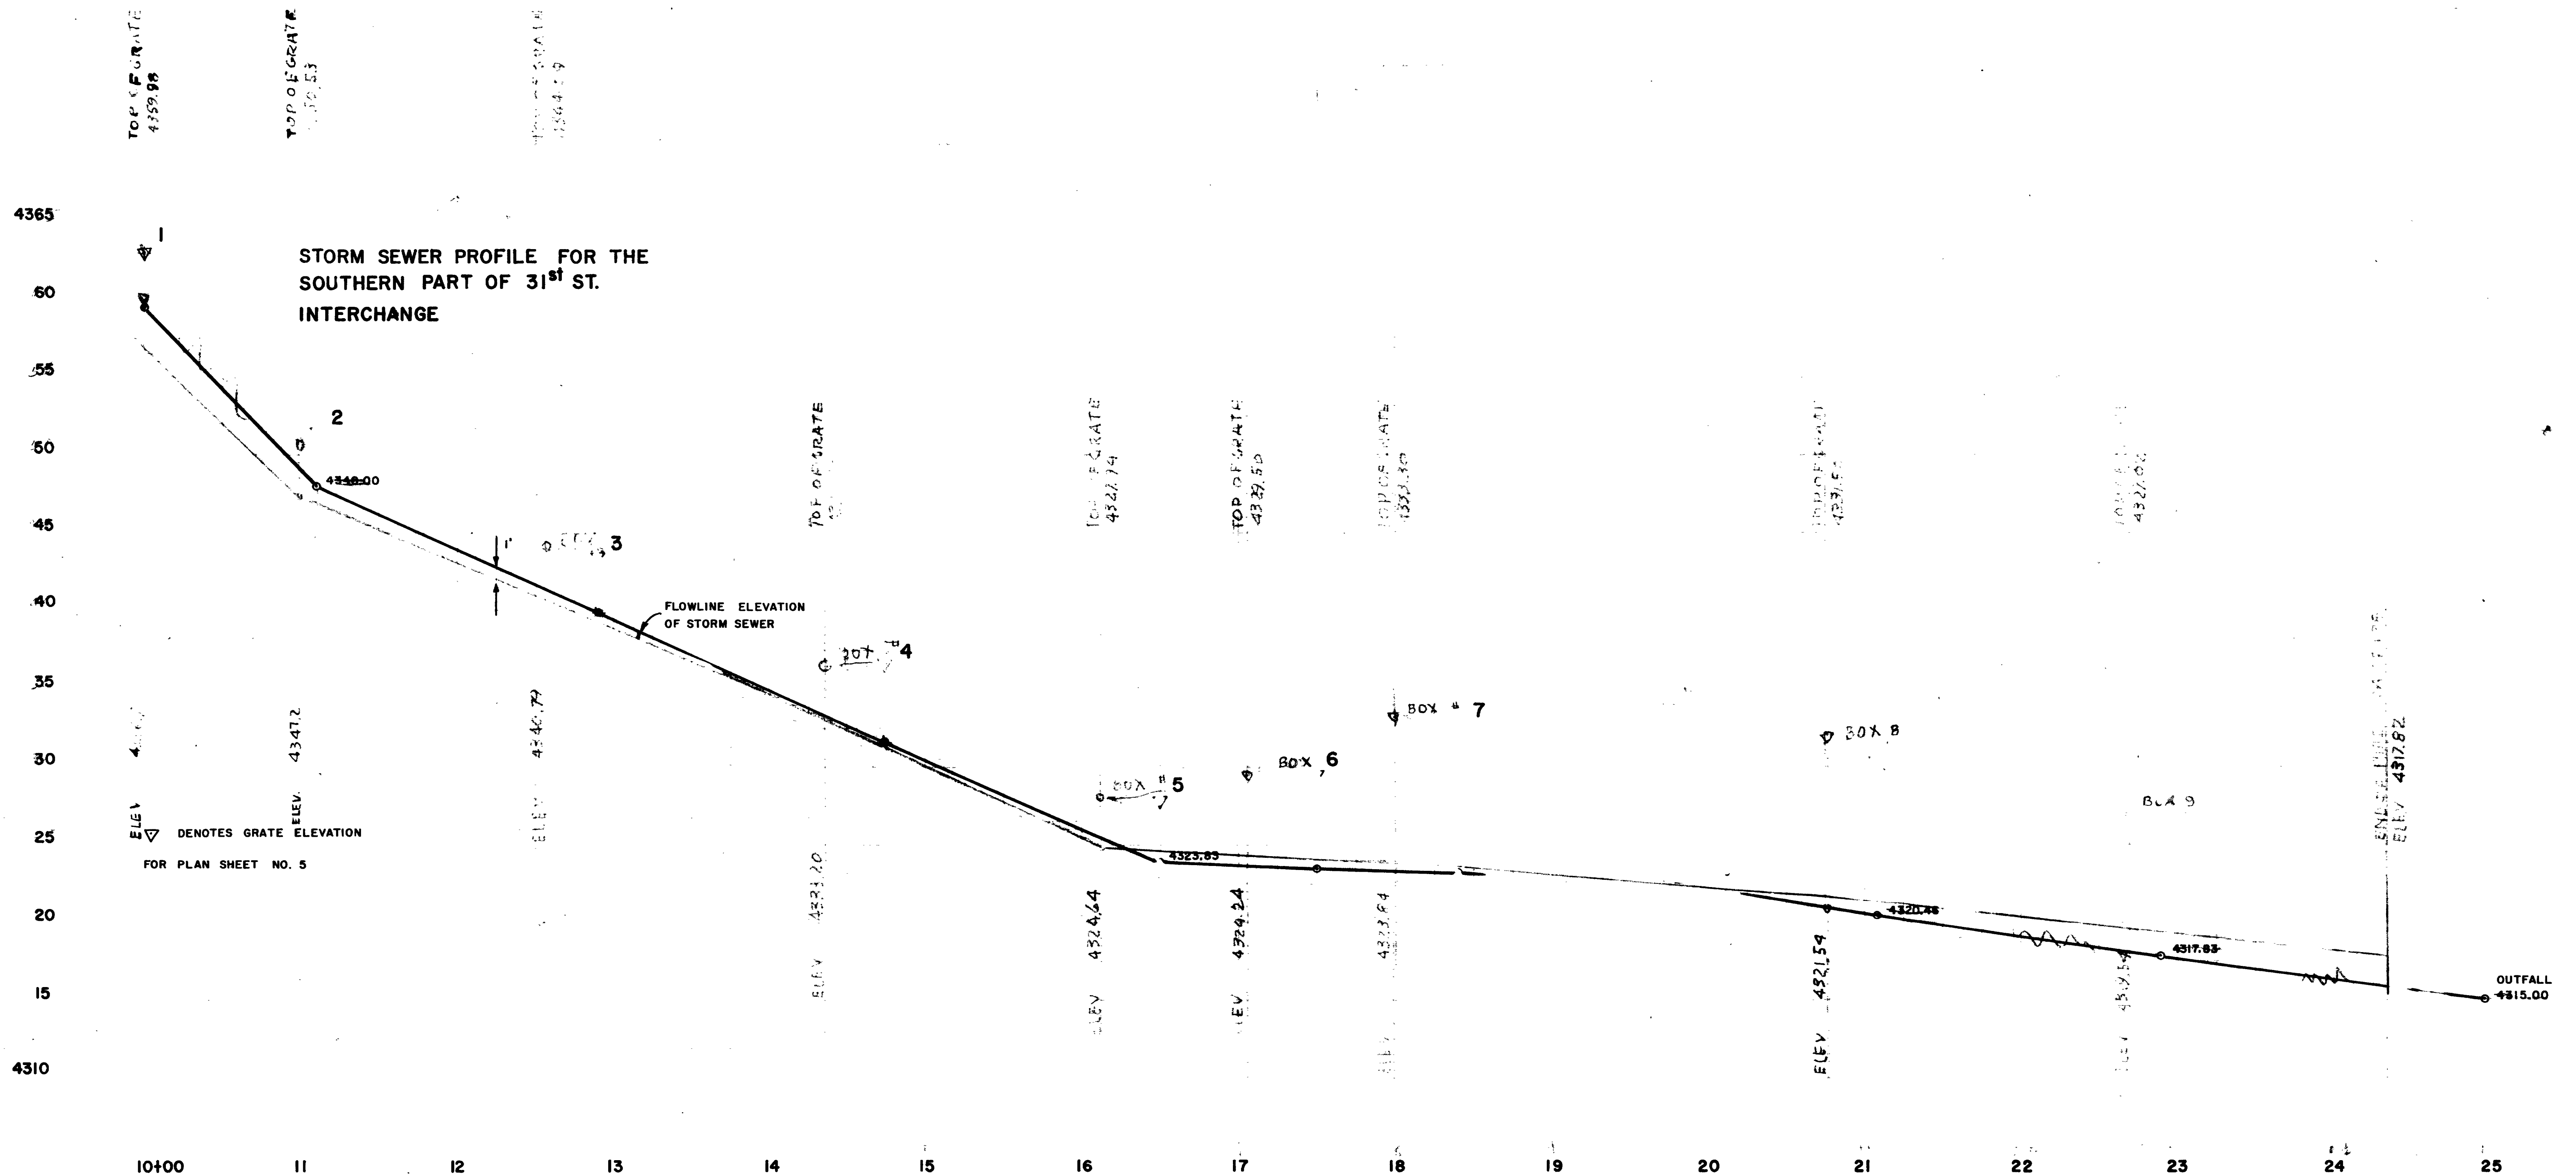


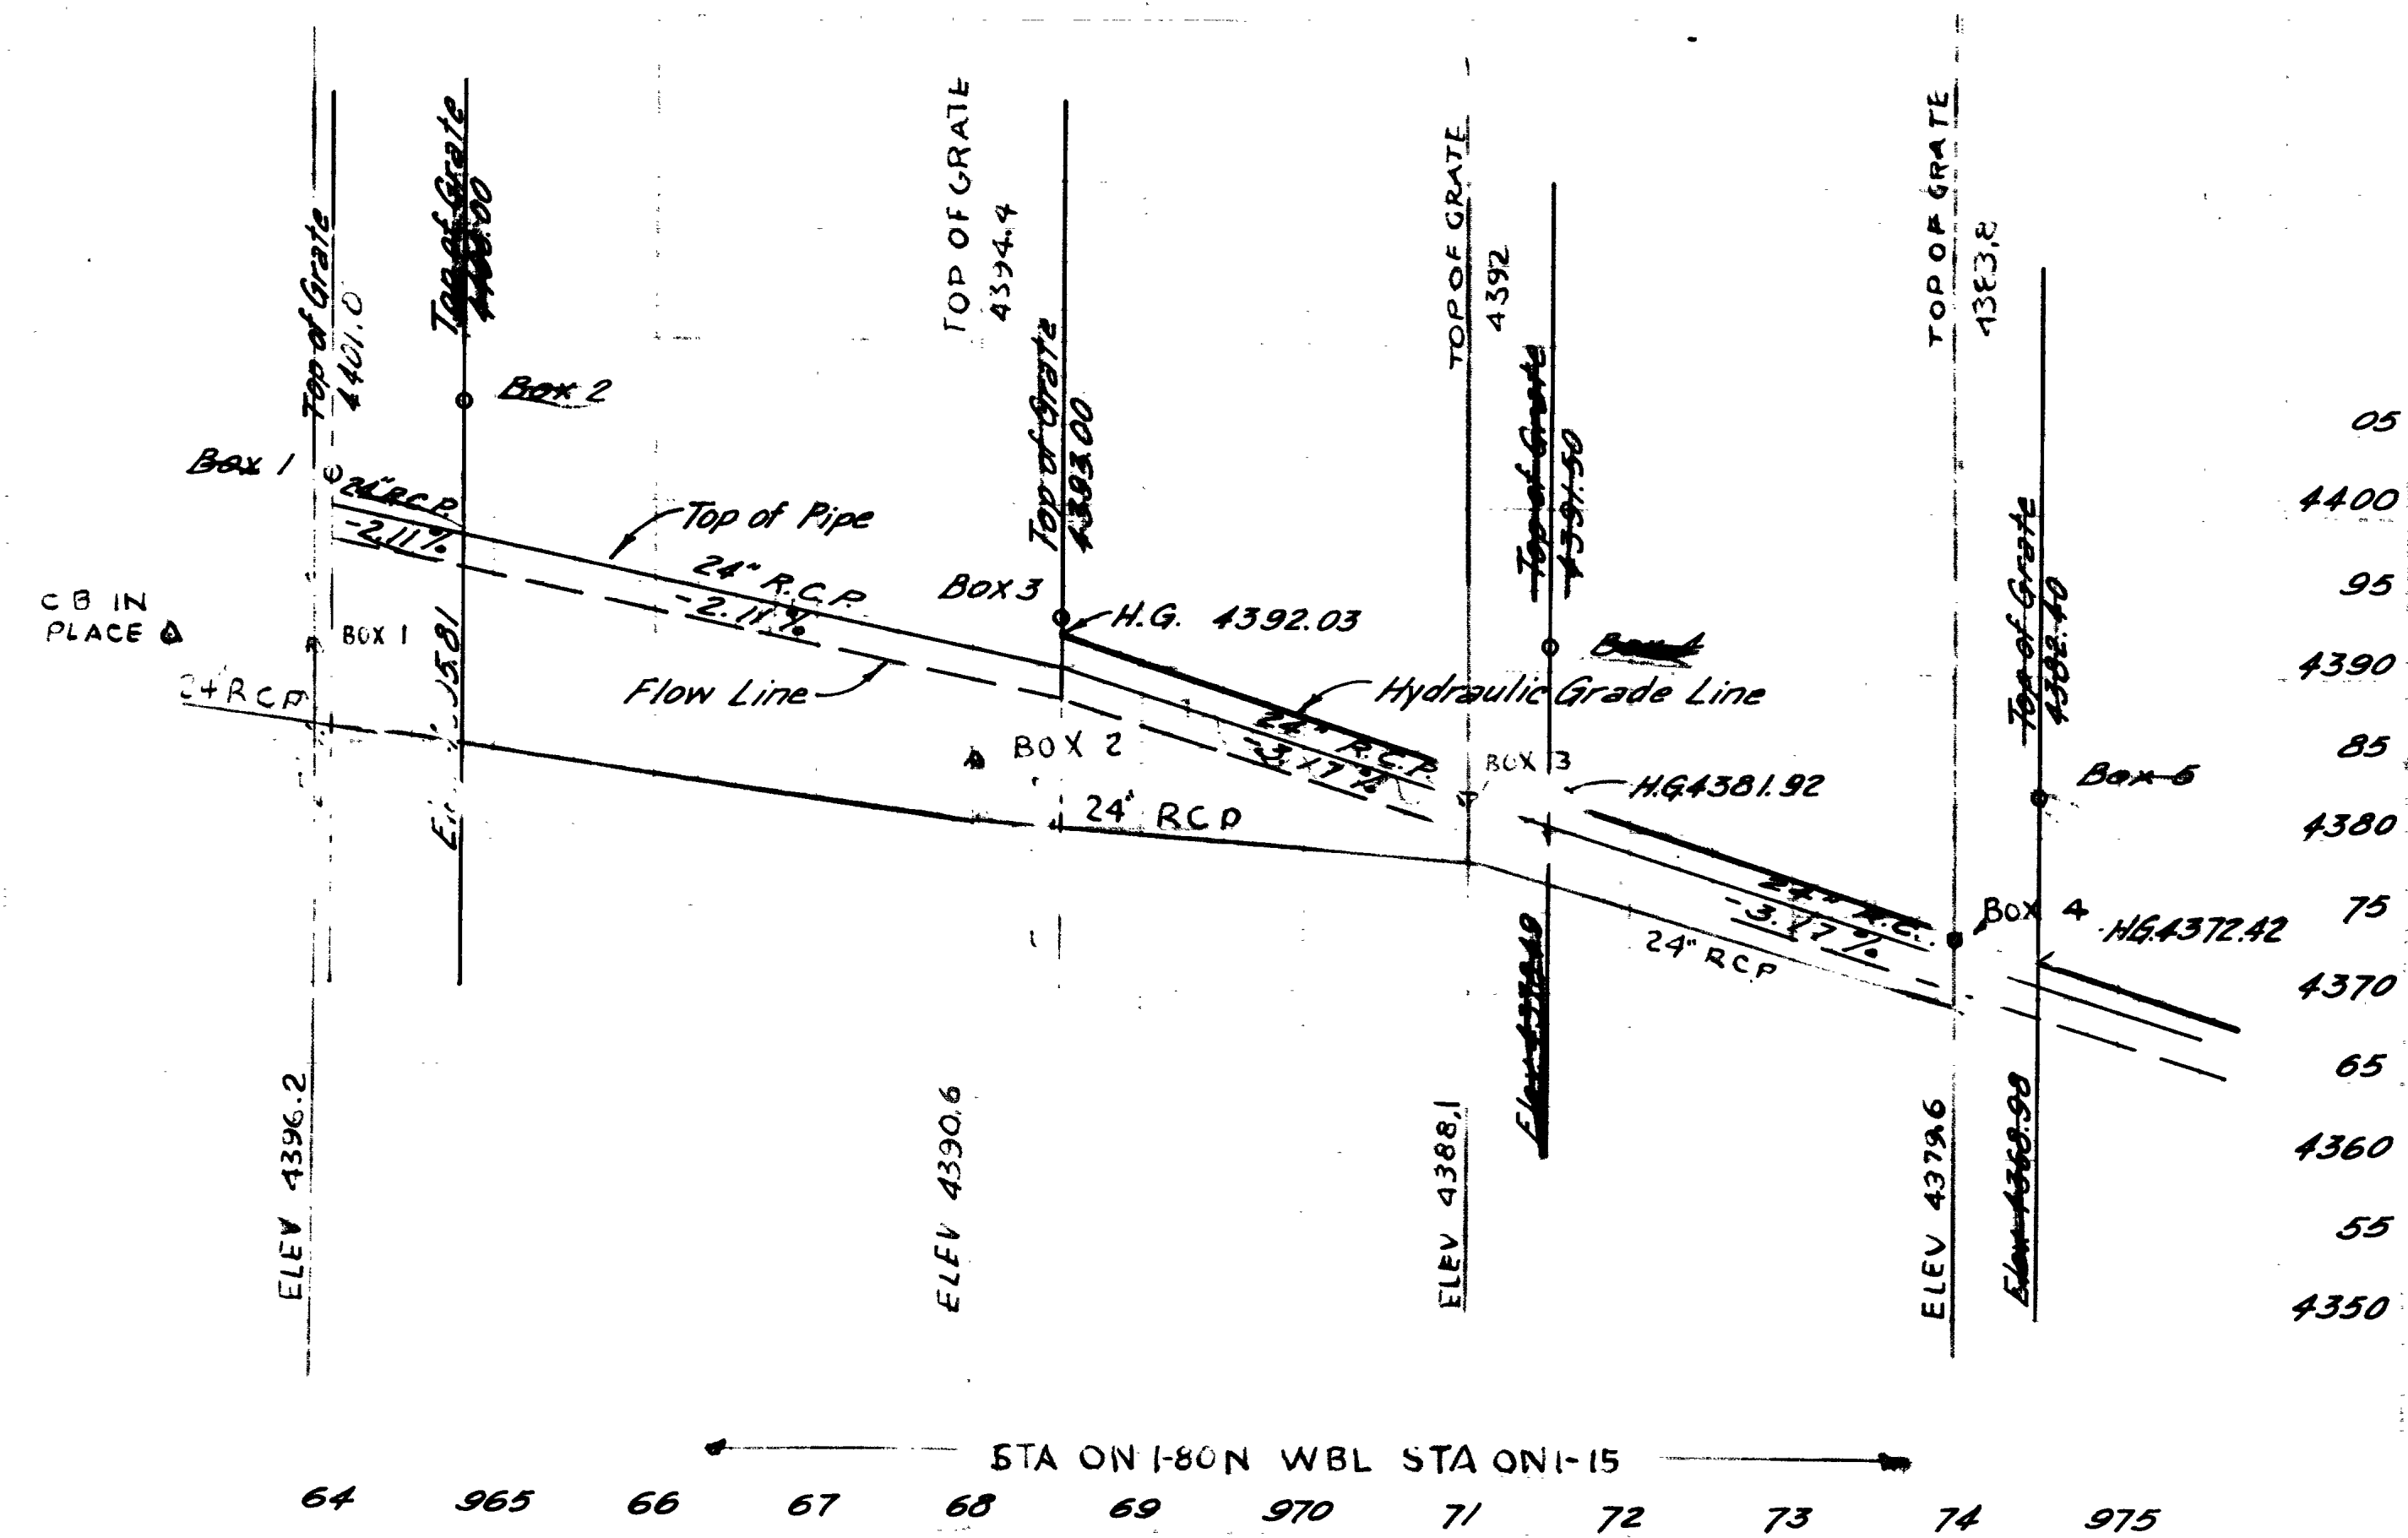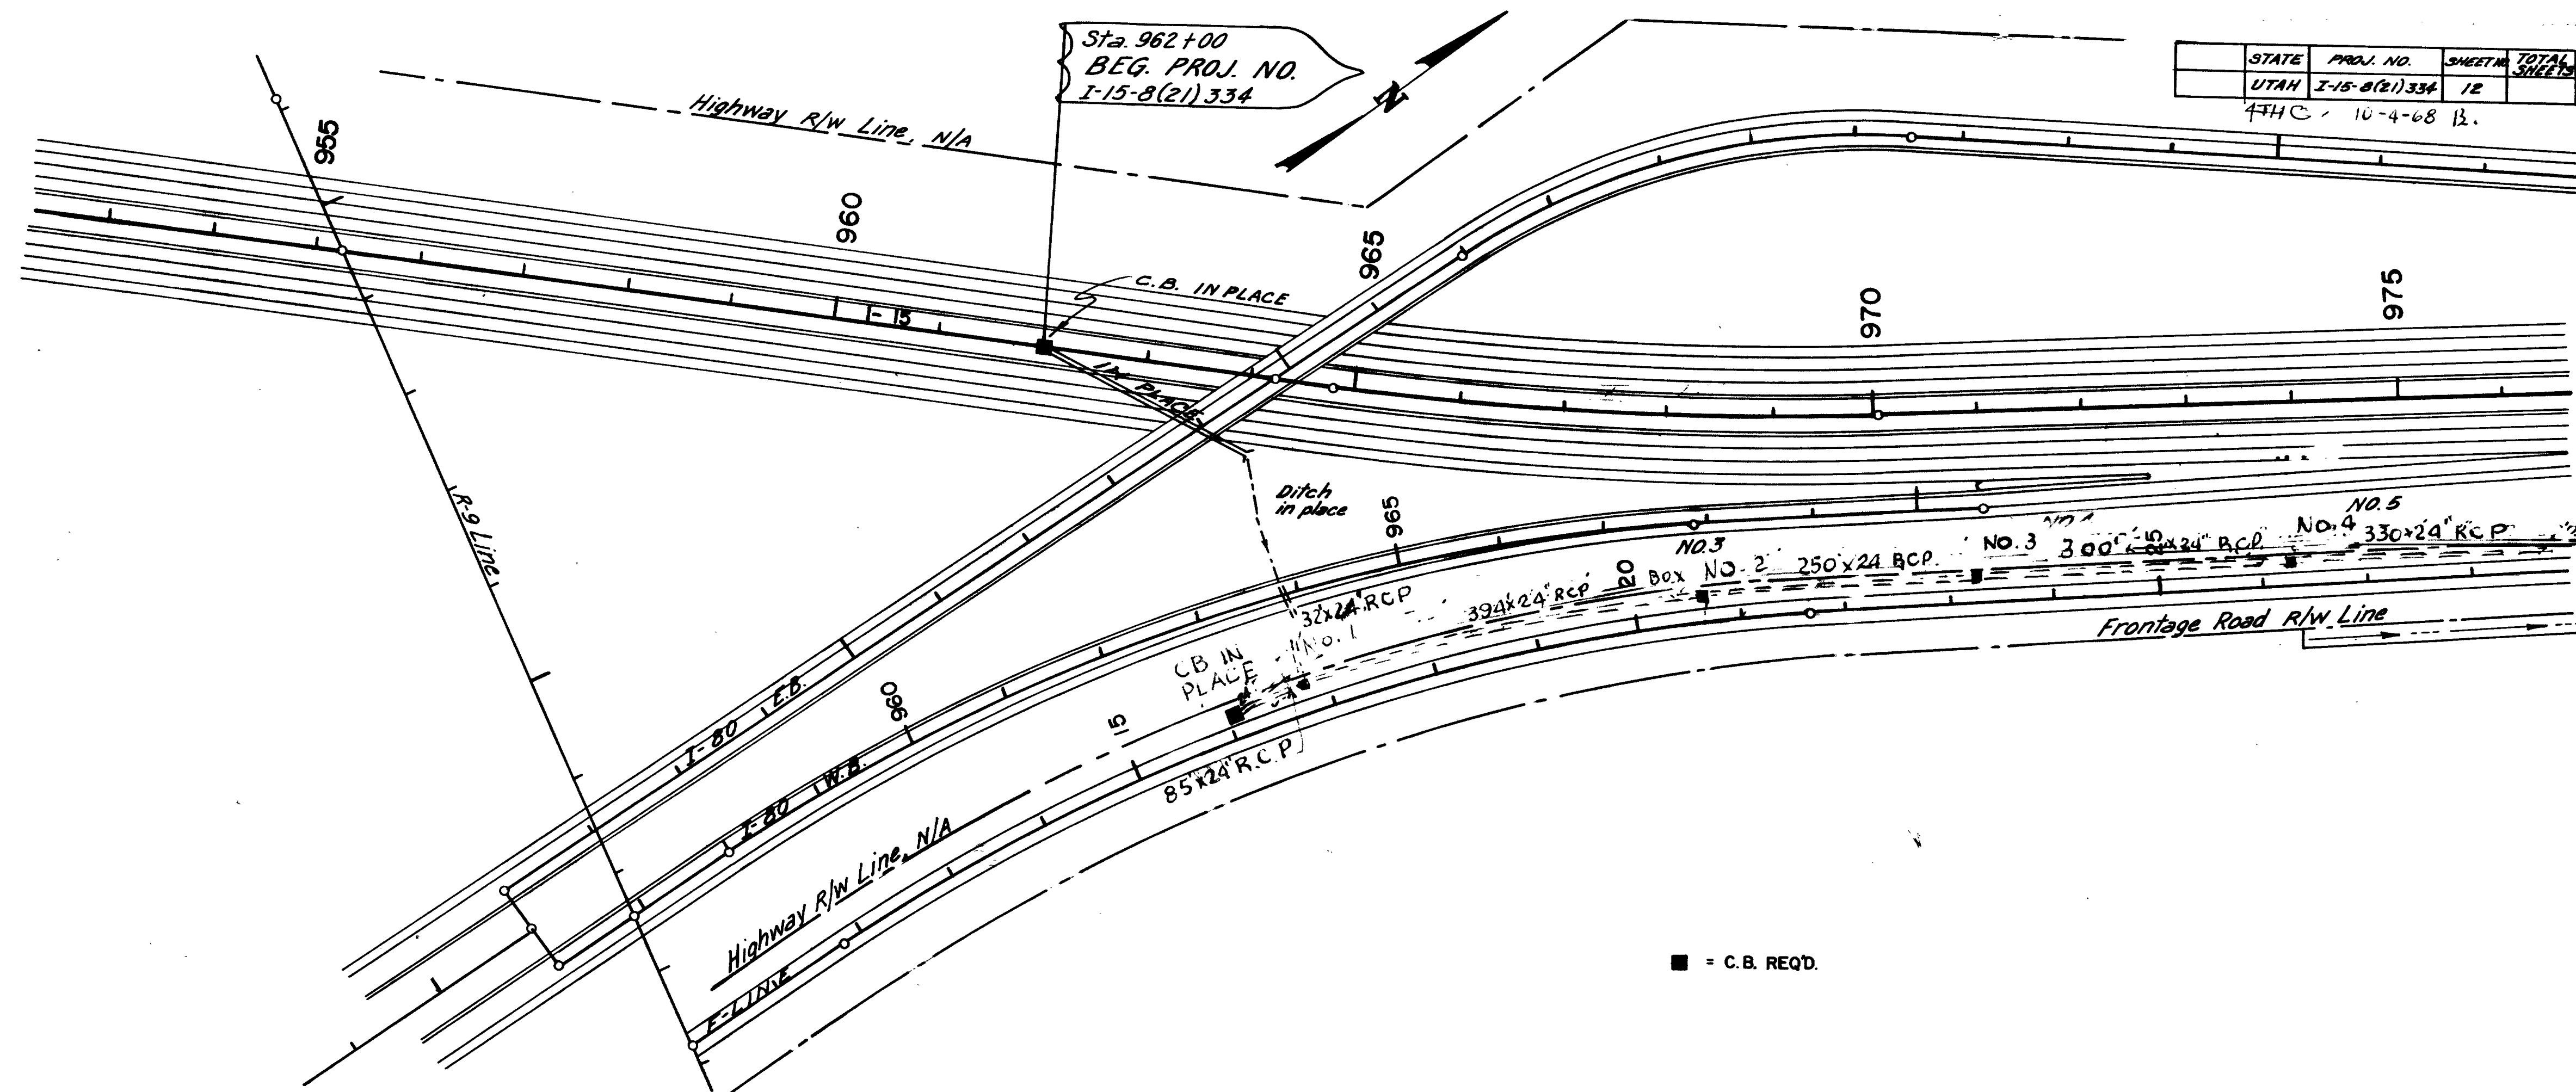

STATE	PROJ. NO.	SHEET NO.	TOTAL SHEETS
UTAH	I-15-B(2)334	13	

4TH G. REV. 1.1-1-6 F

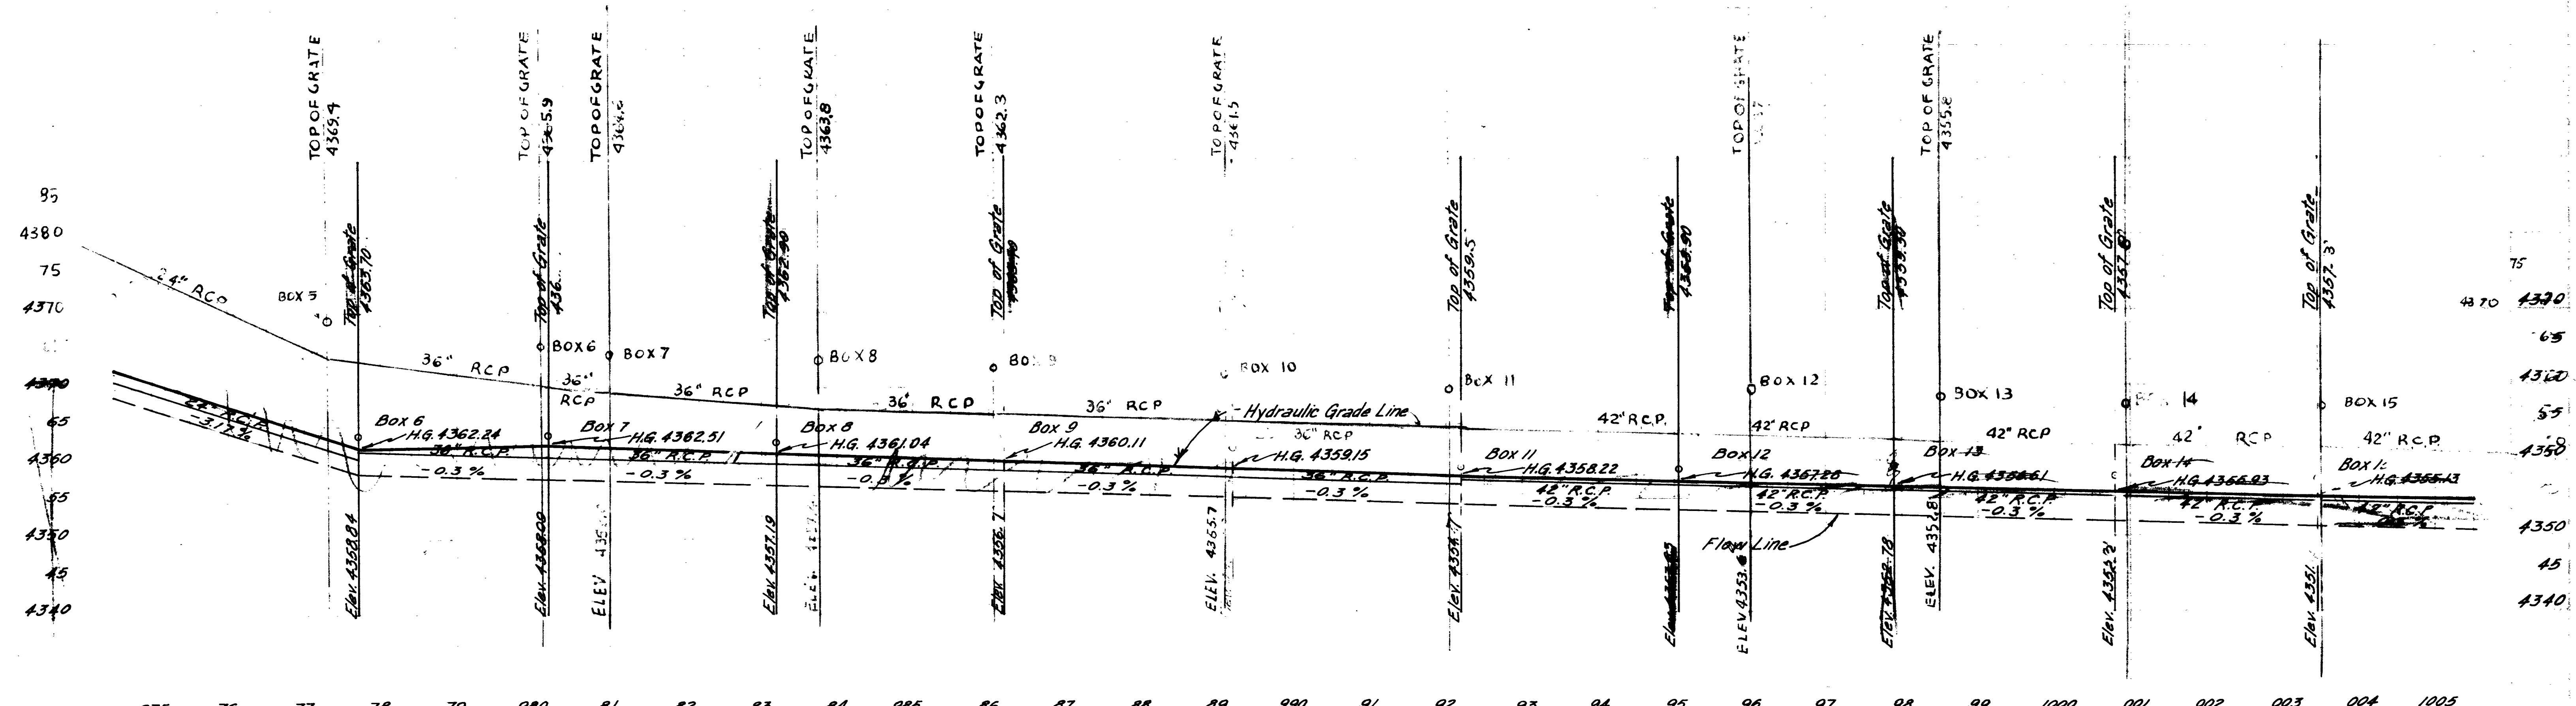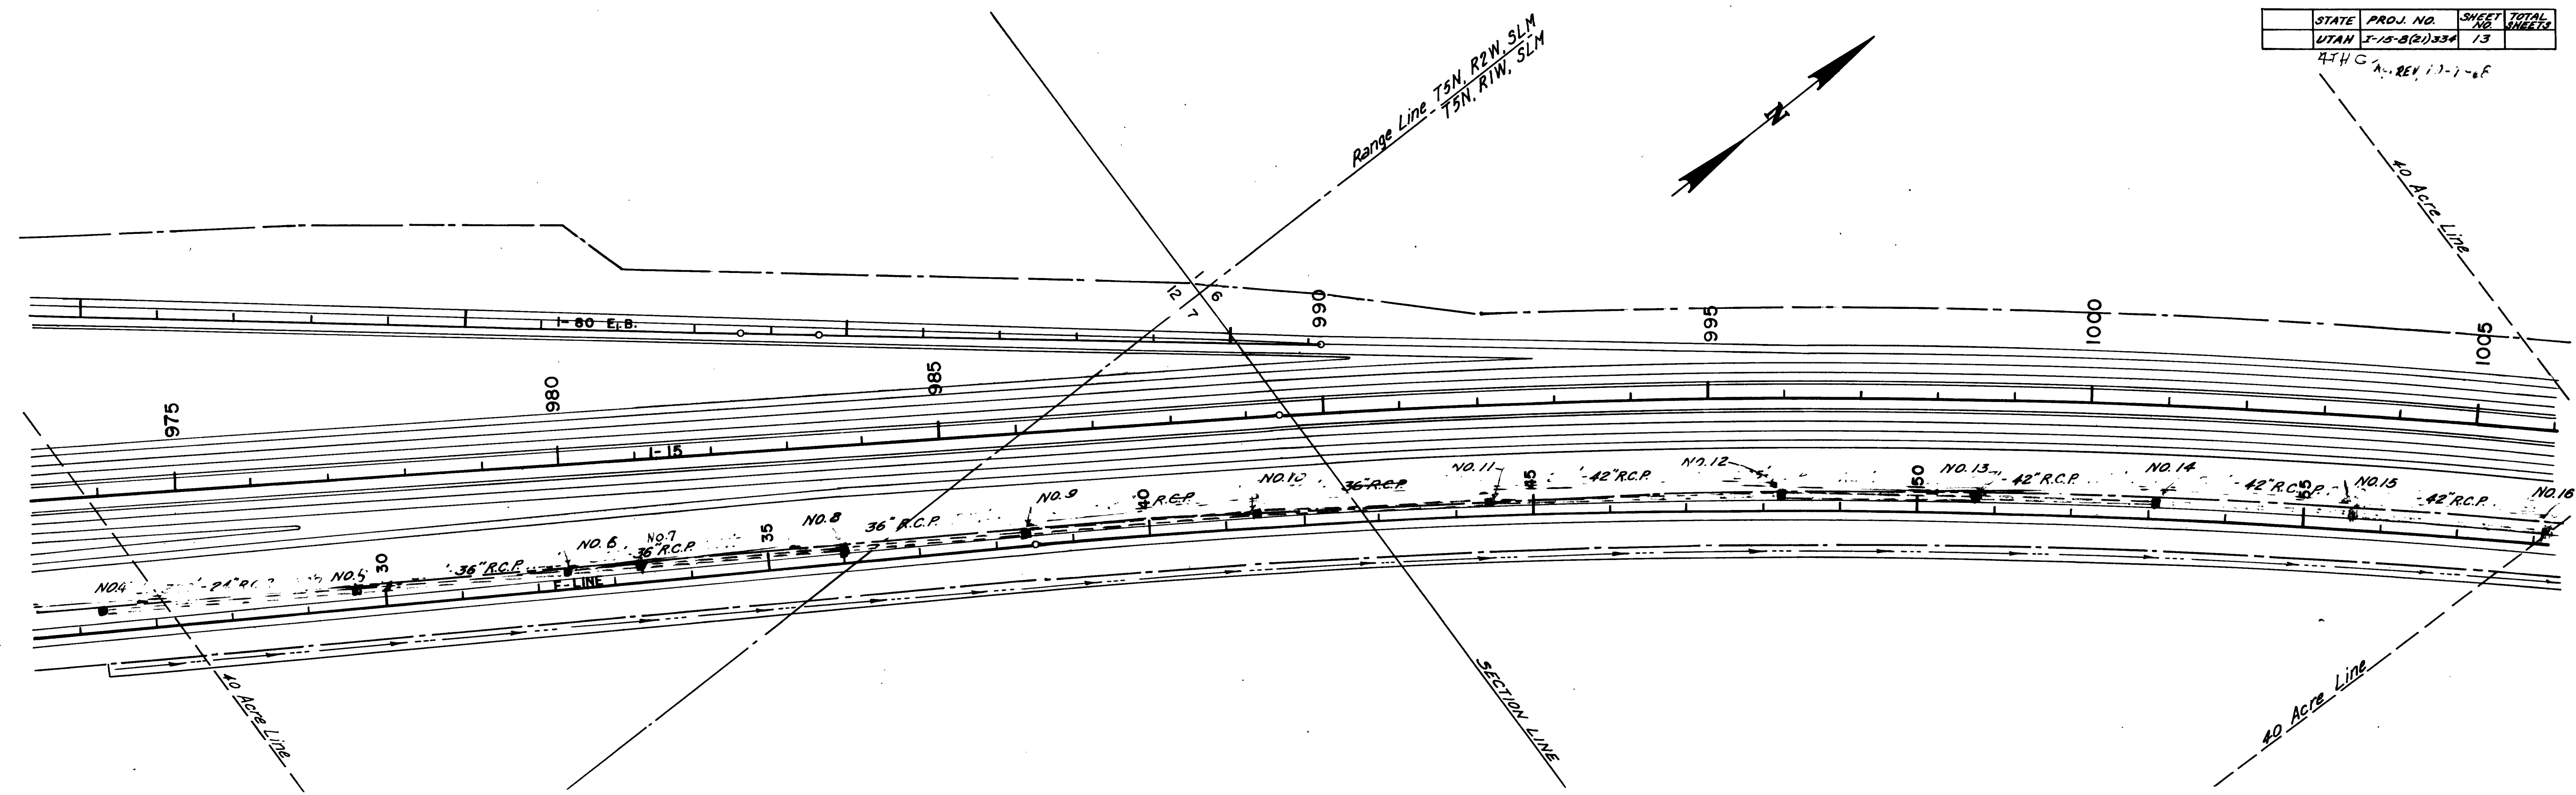

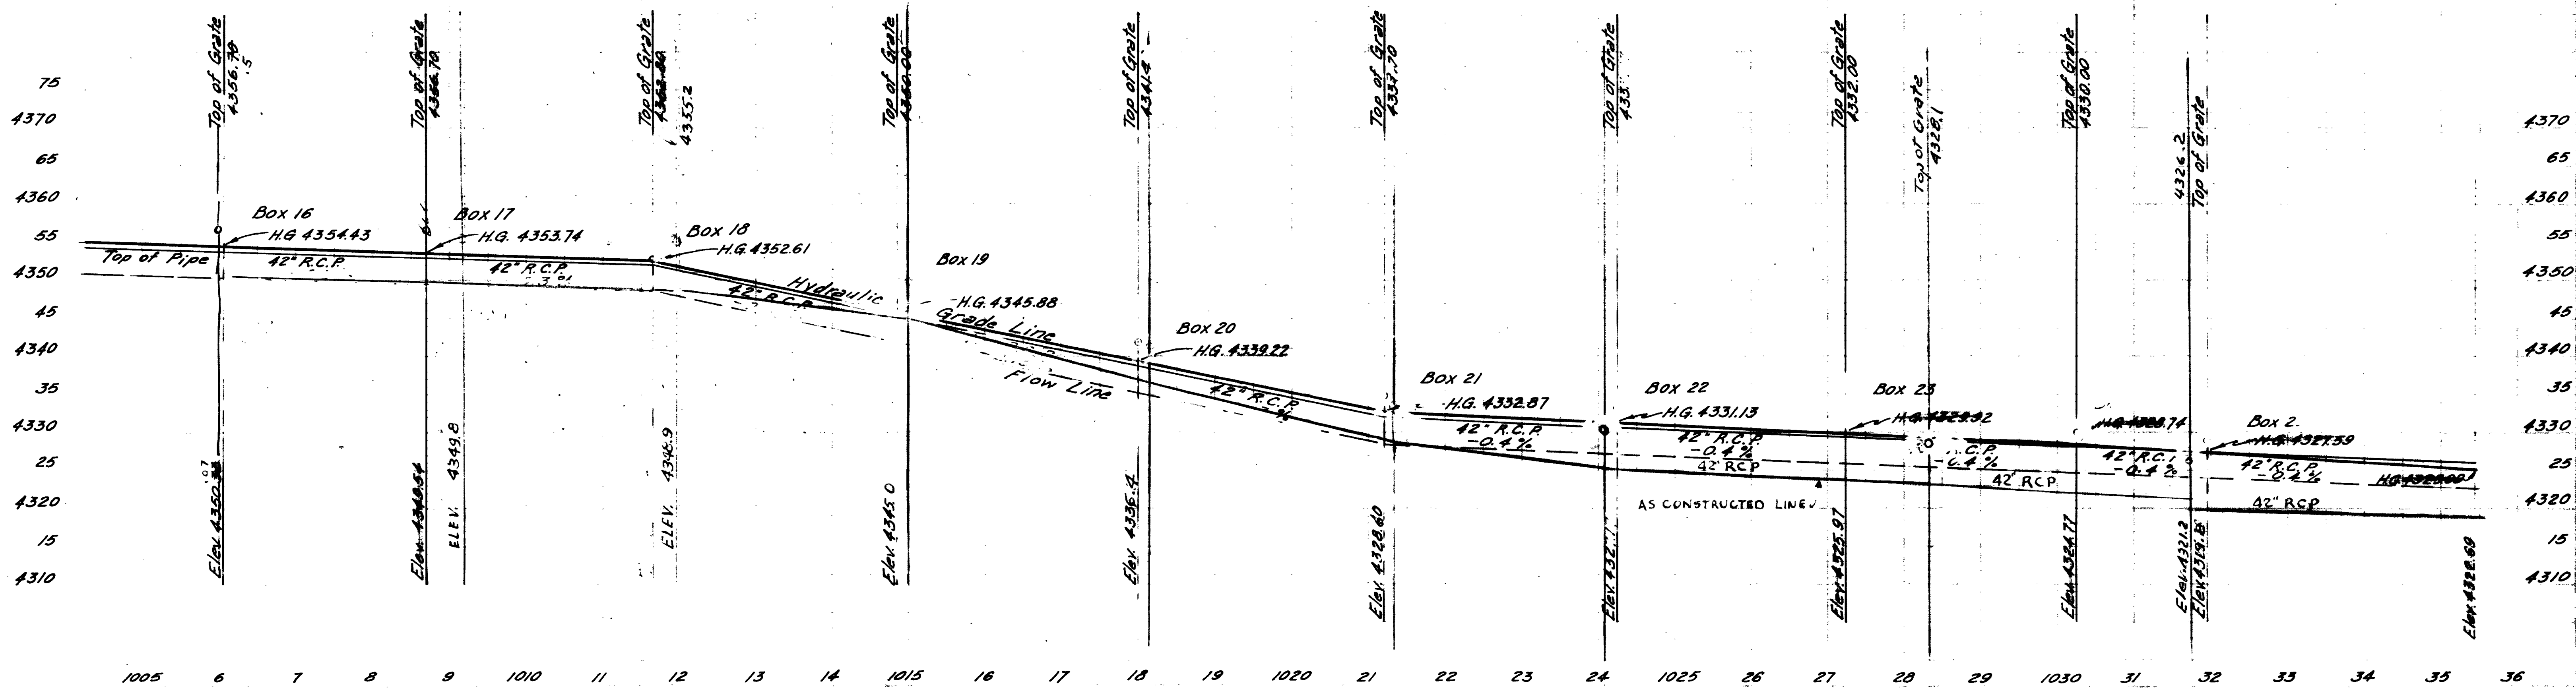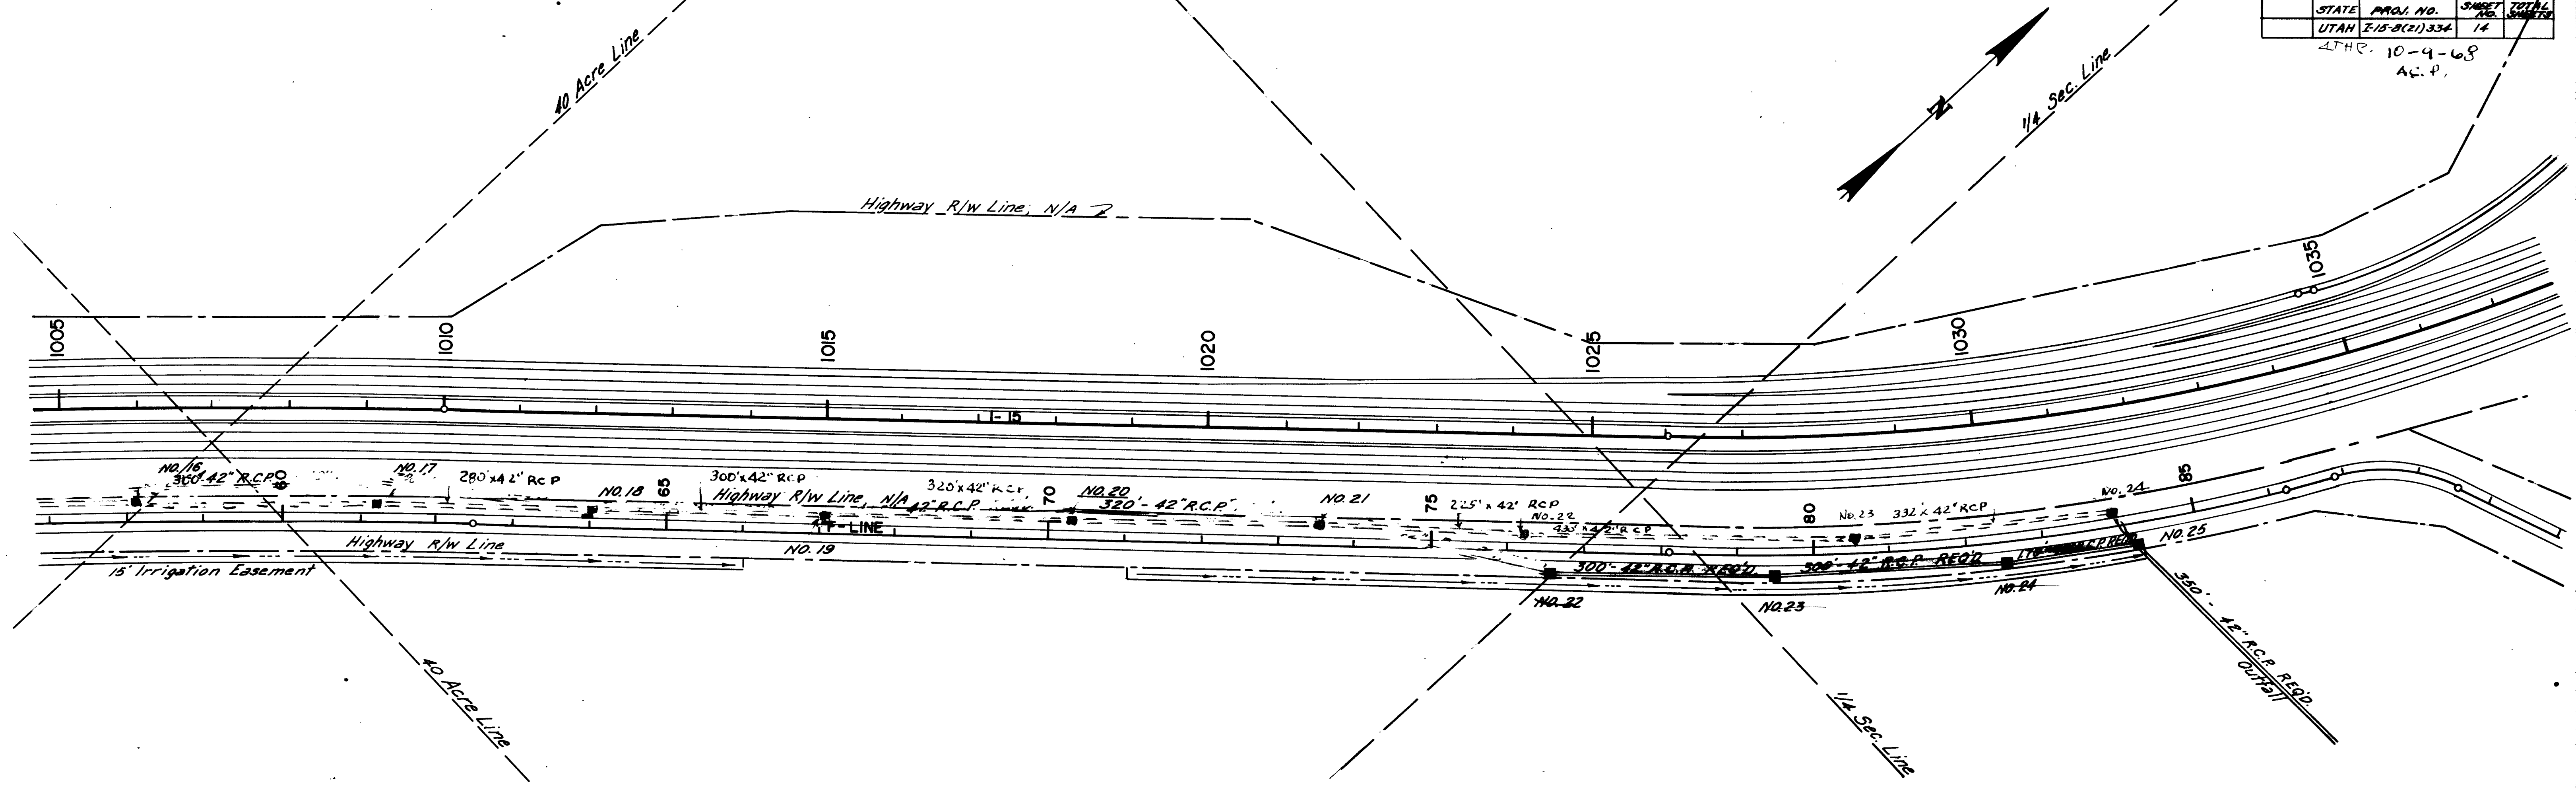


FED. ROAD DIST. NO.	STATE	PROJ. NO.	FISCAL YEAR	SHEET NO.	TOTAL SHEETS
HATU	HATU	I-17-B(51) 334	12		

REVISED			
DATE	BY	DATE	BY

PROJ. NO.	STATE	DATE	BY	CHECKED	APPROVED
1-12-1(5)324	IL	1/1	1/1	1/1	1/1
1/1	1/1	1/1	1/1	1/1	1/1


SECOND CONTROL
1/1

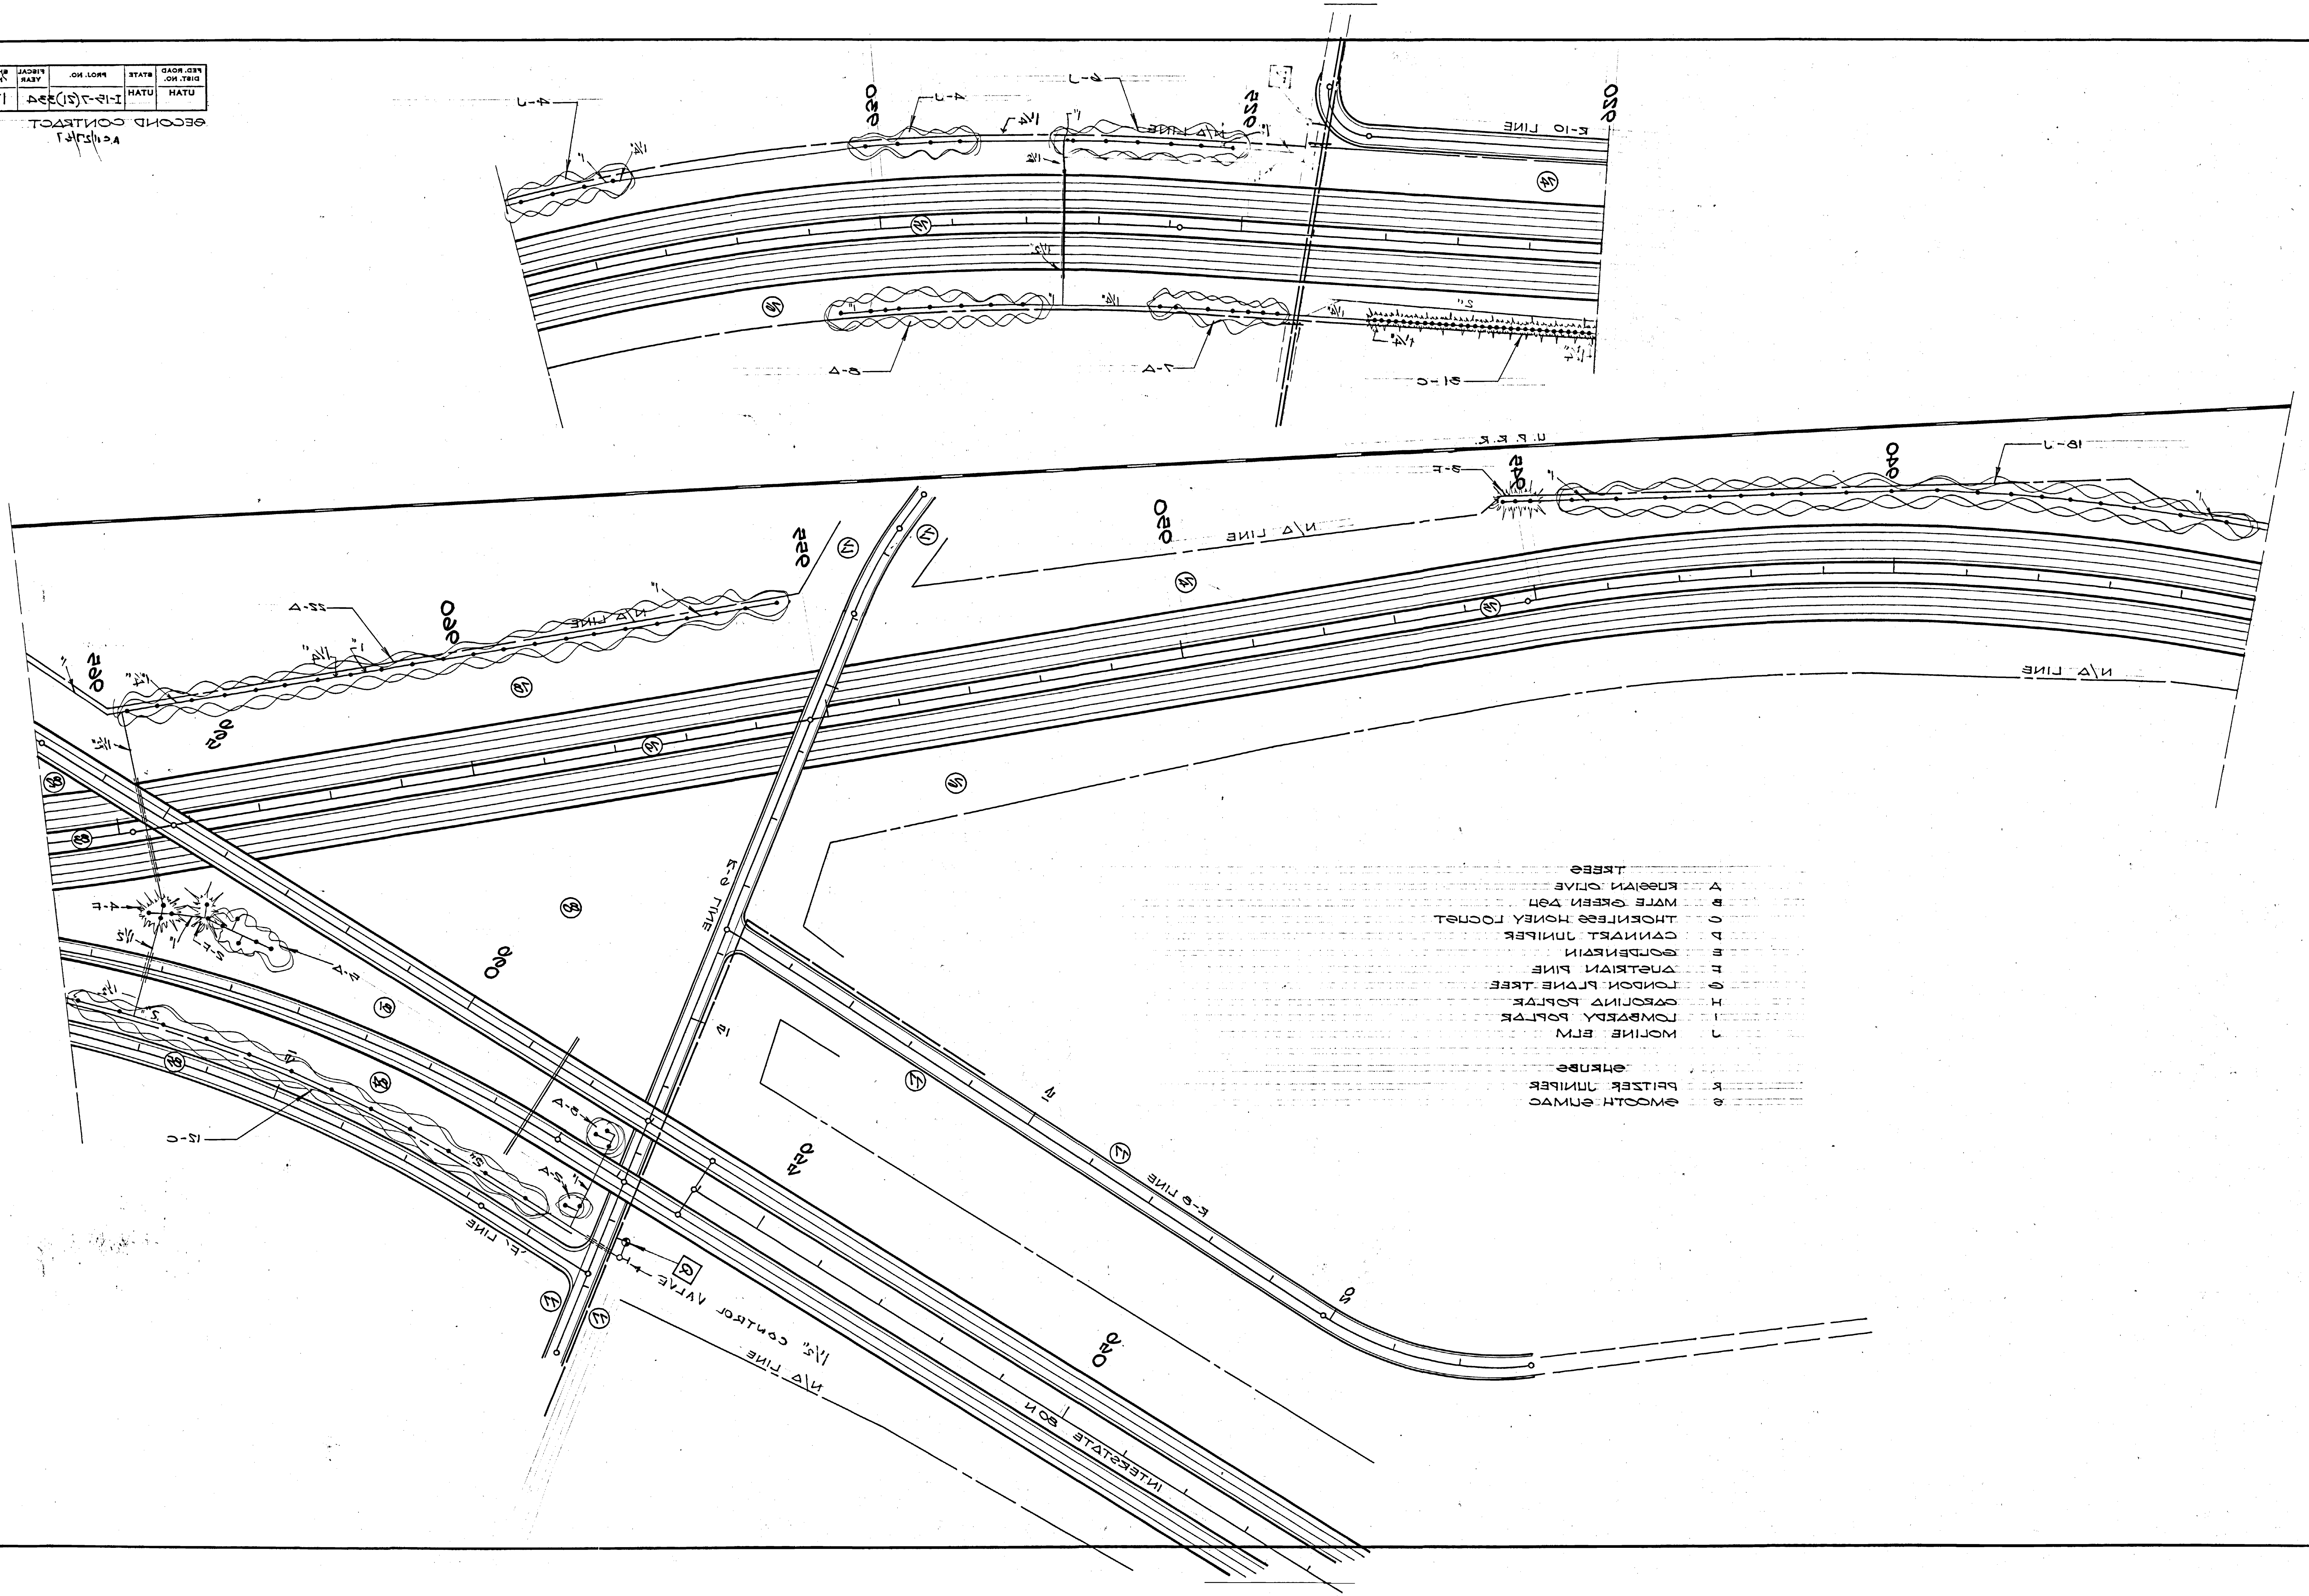


- SMOOTH SHINING
R. BRITZER JUNIOR
SHRUBS
J. MOBILE ELM
I. TOMBERY POPLAR
H. CAROLINA POPLAR
G. LONDON PLANE TREE
F. AMERICAN PINE
E. GOLDENRAIN
D. CANADIAN JUNIPER
C. THORNLESS HONEY LOCUST
B. WHITE GREEN OAK
A. RUSSIAN OLIVE
TREES

SECTION	DATE	BY	CHECKED	APPROVED
1/1	1/1	1/1	1/1	1/1
1/2	1/2	1/2	1/2	1/2



FED. ROAD DIST. NO.	STATE	PROJ. NO.	FISCAL YEAR	SHEET NO.	TOTAL SHEETS
HATU	HATU	I-75-8(15)34	84	91	

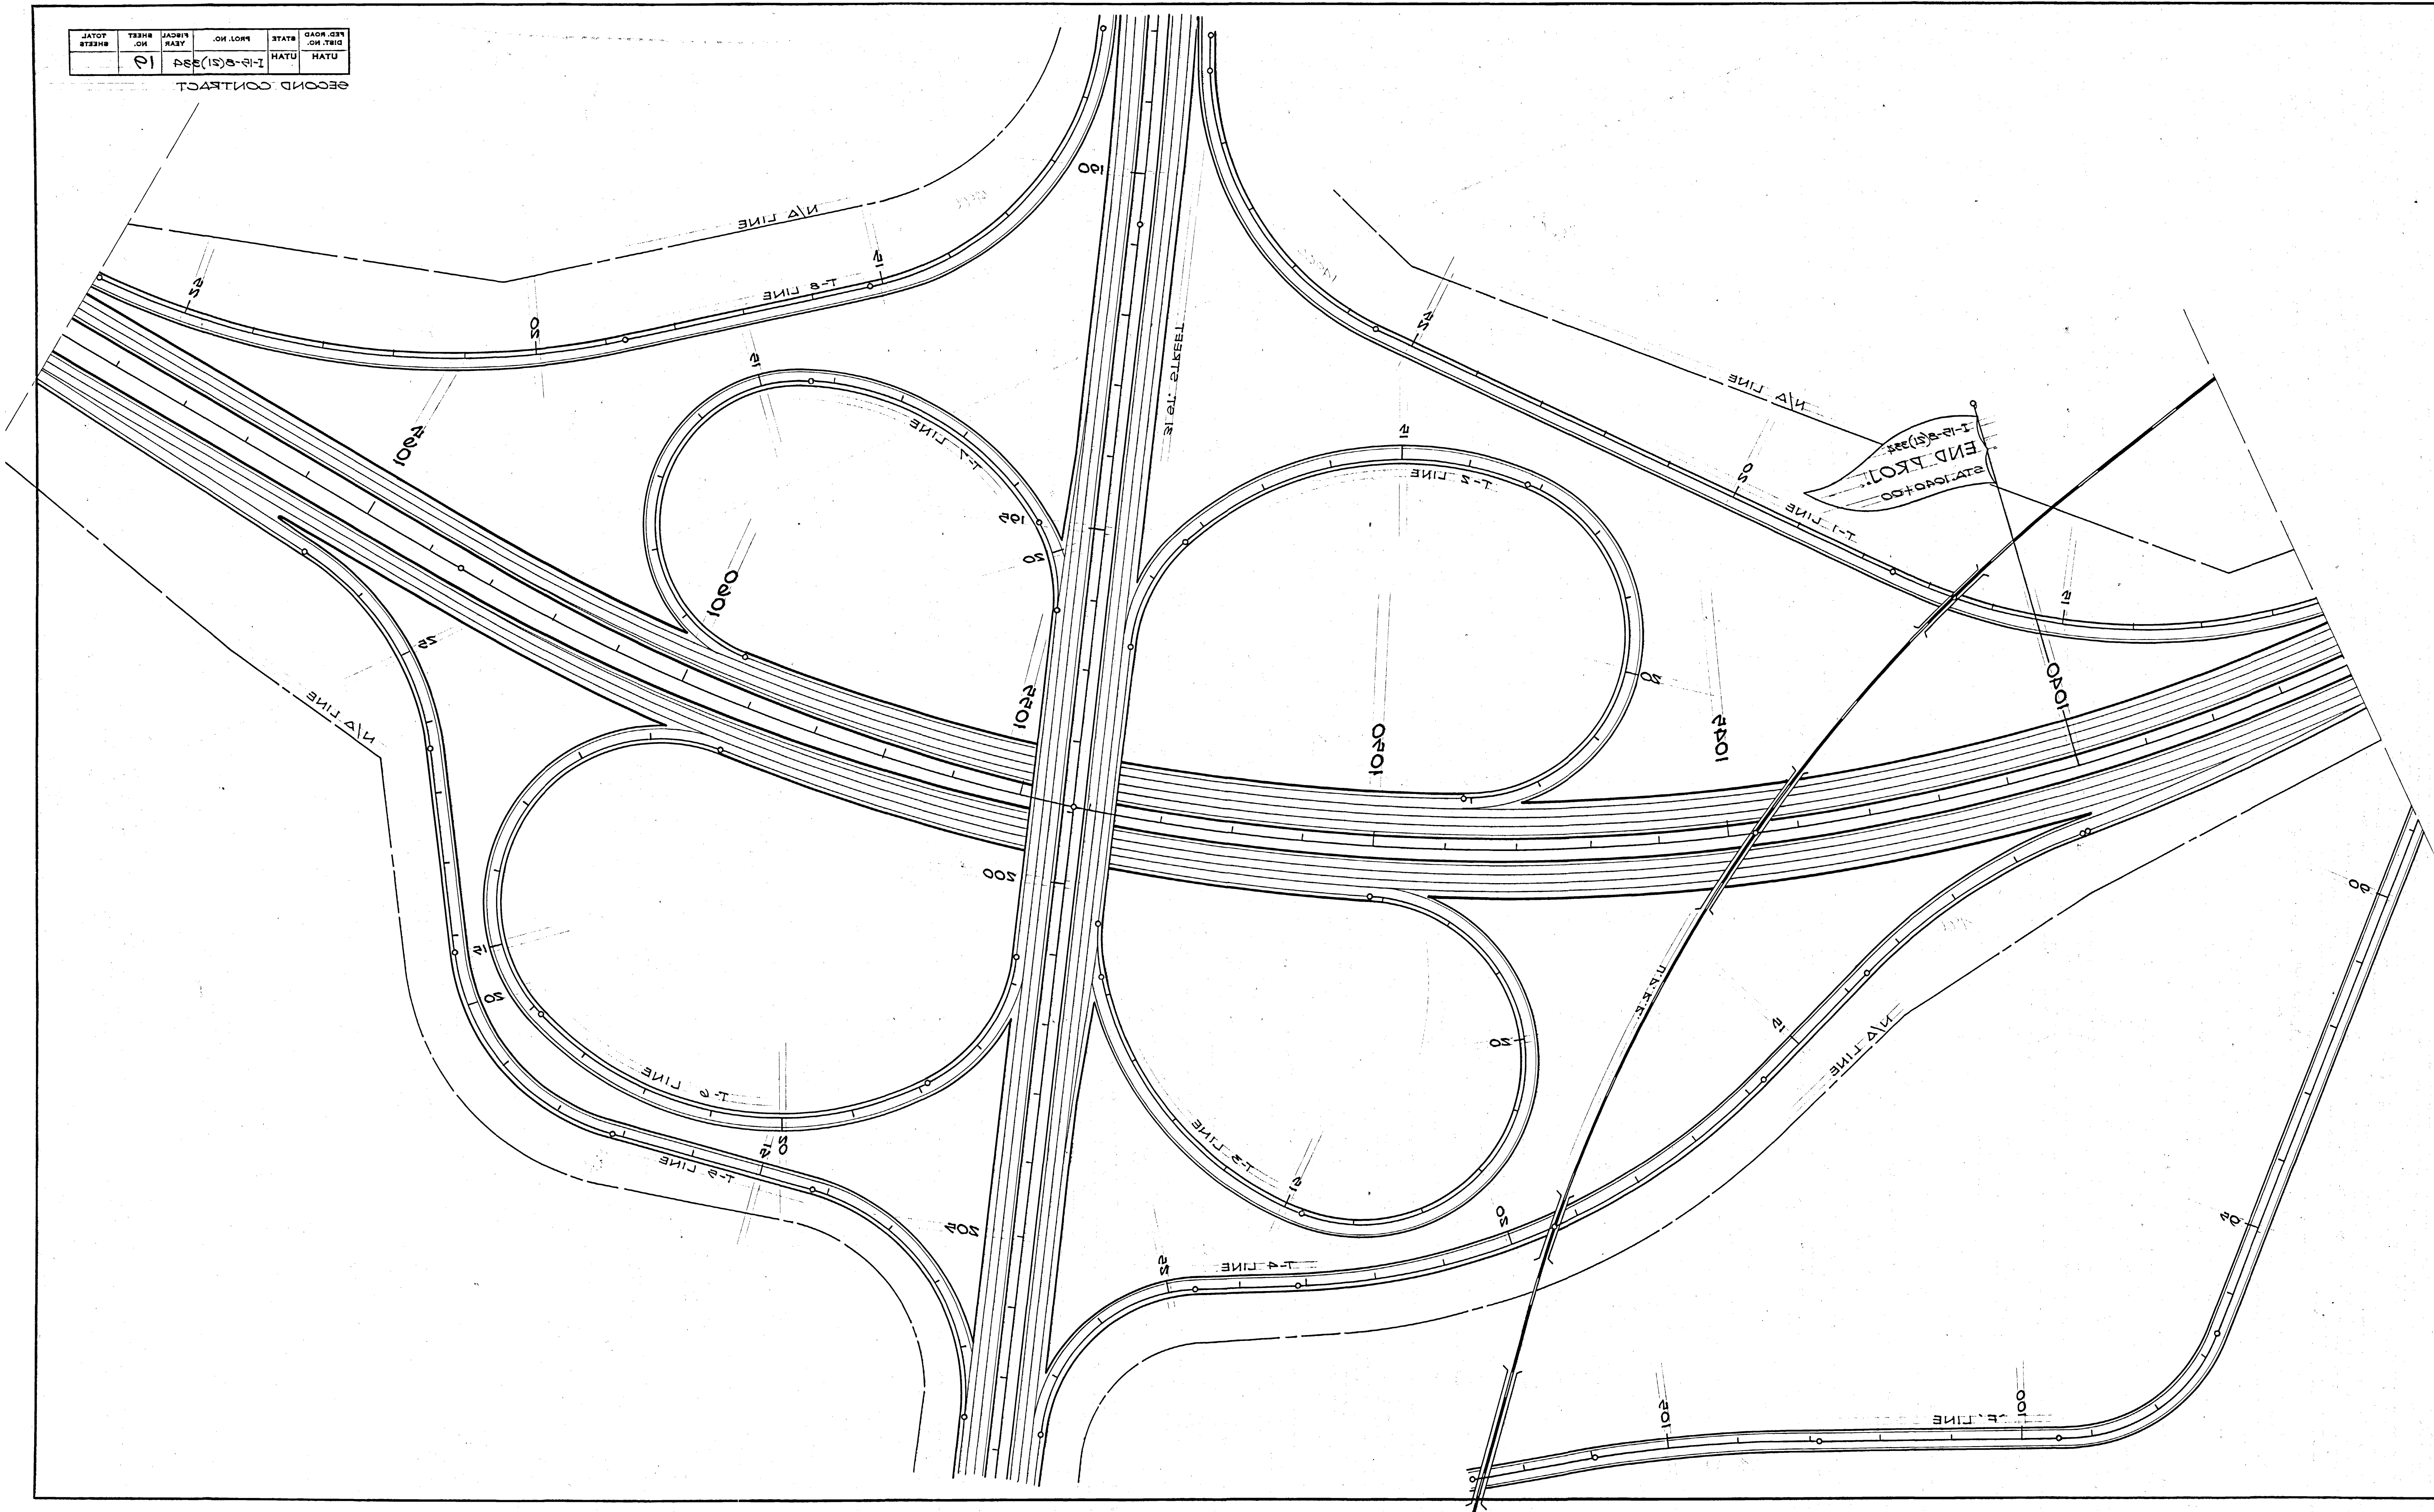

REVISIONS			
DATE	BY	DATE	BY

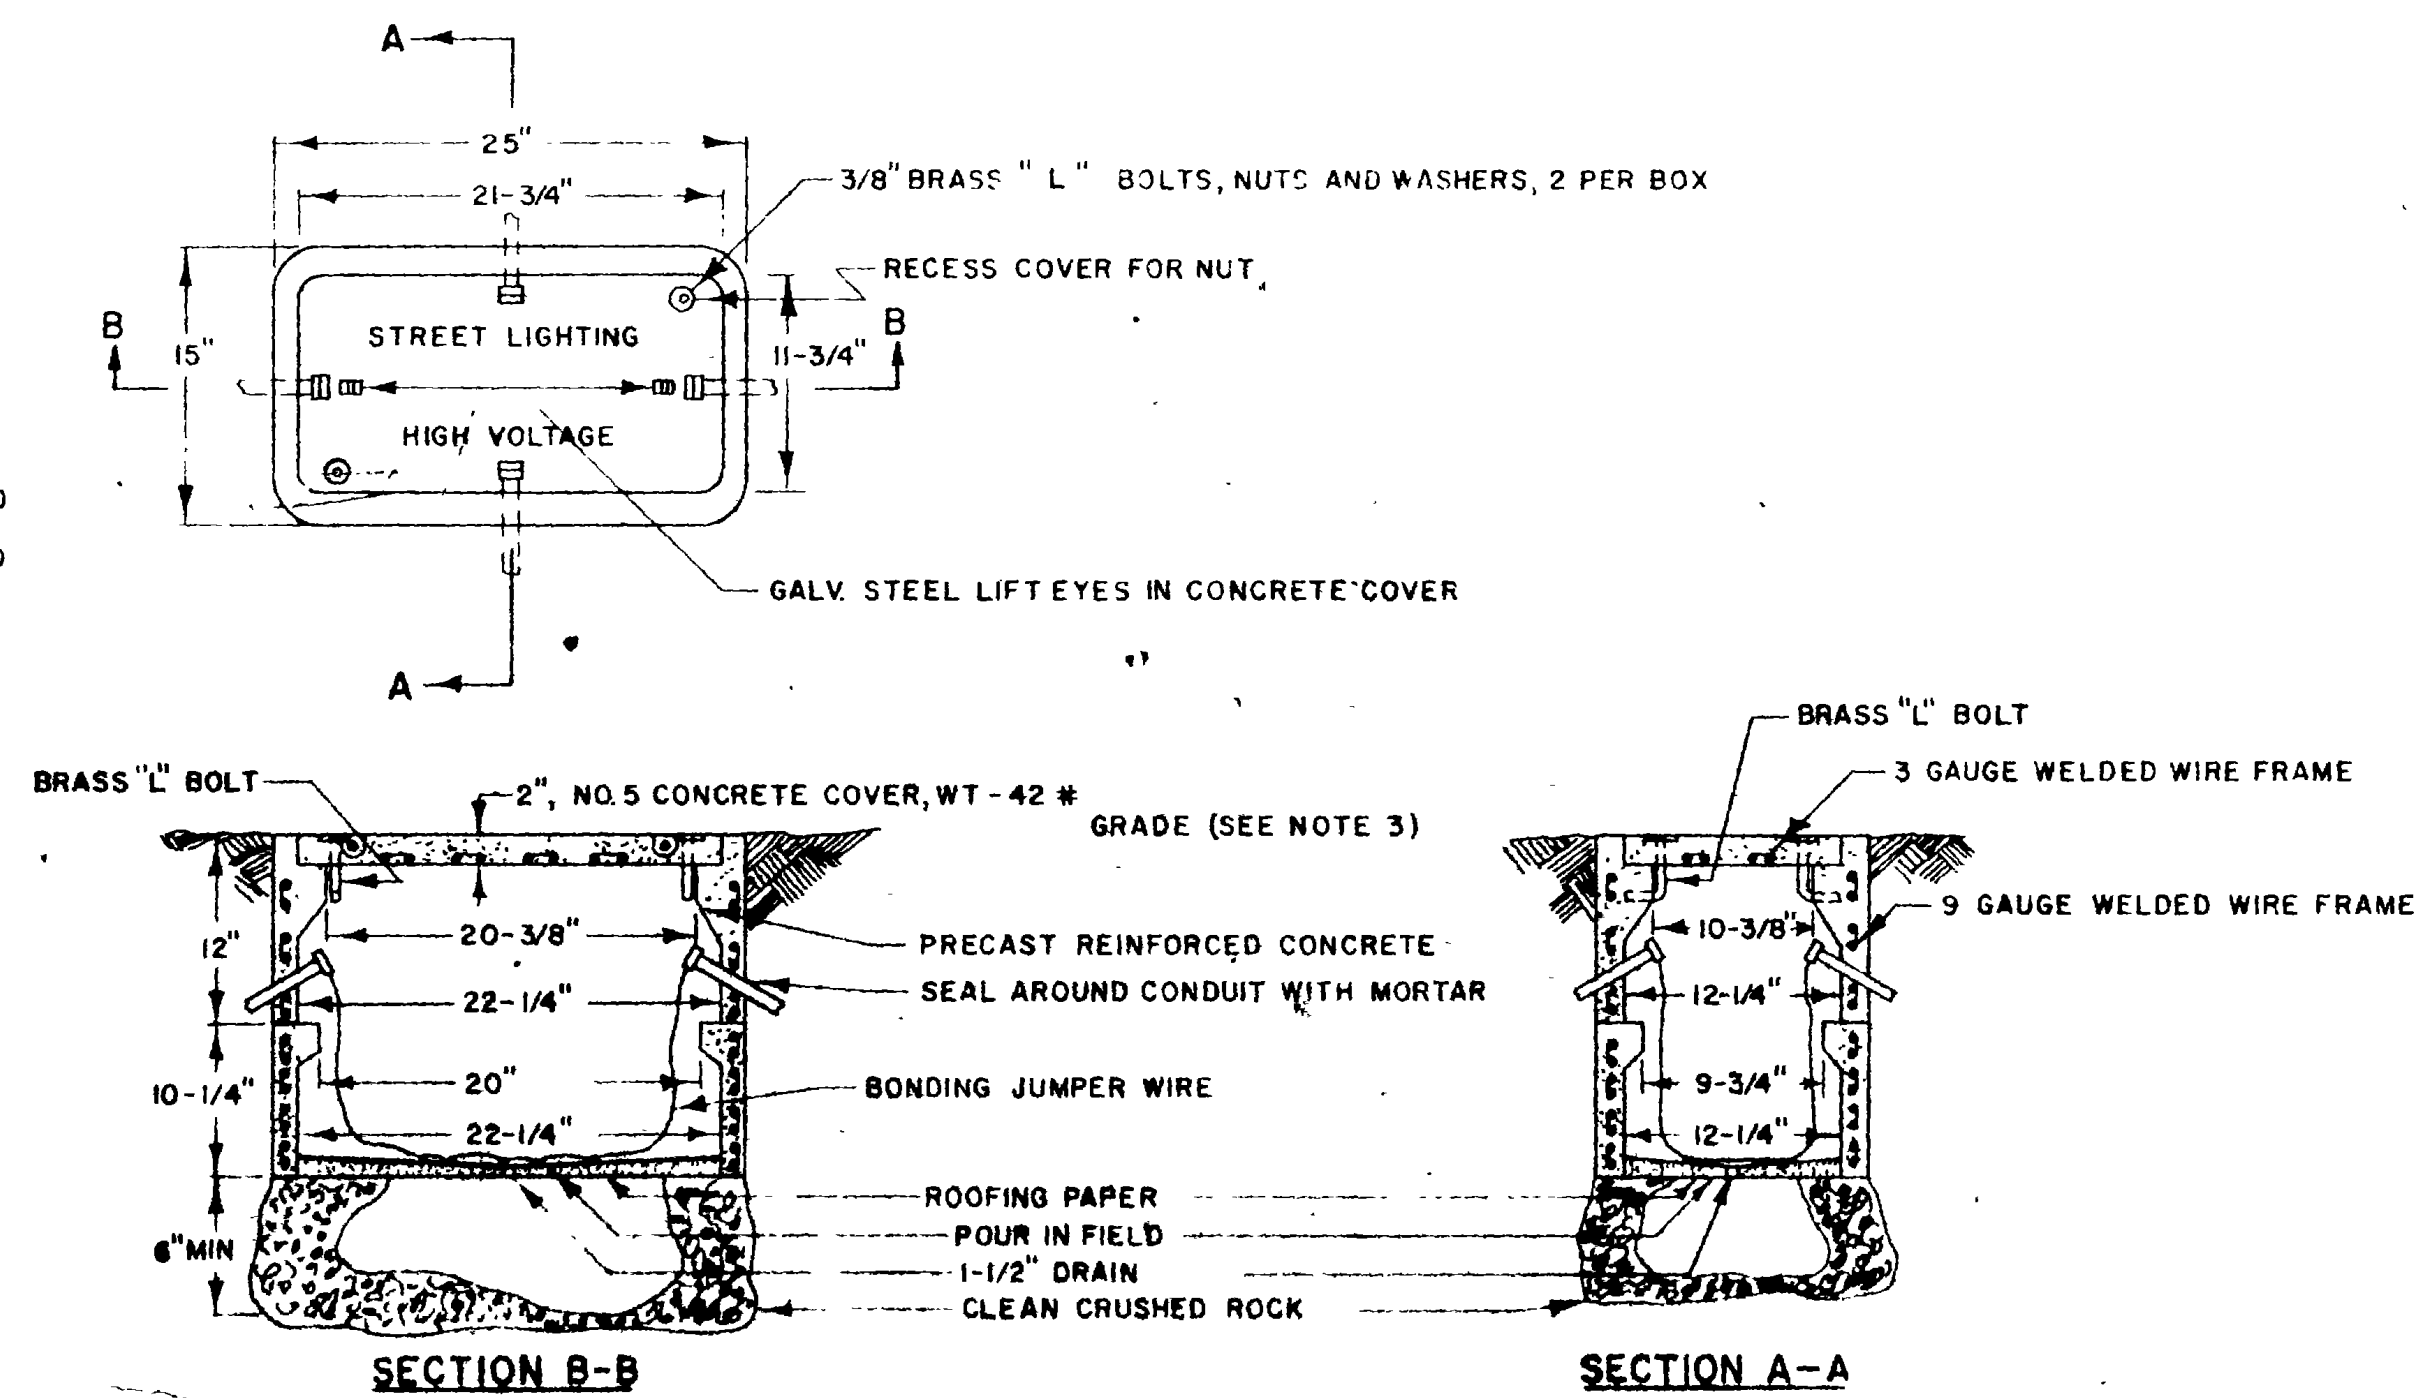


JUNCTION BOX
TYPE III

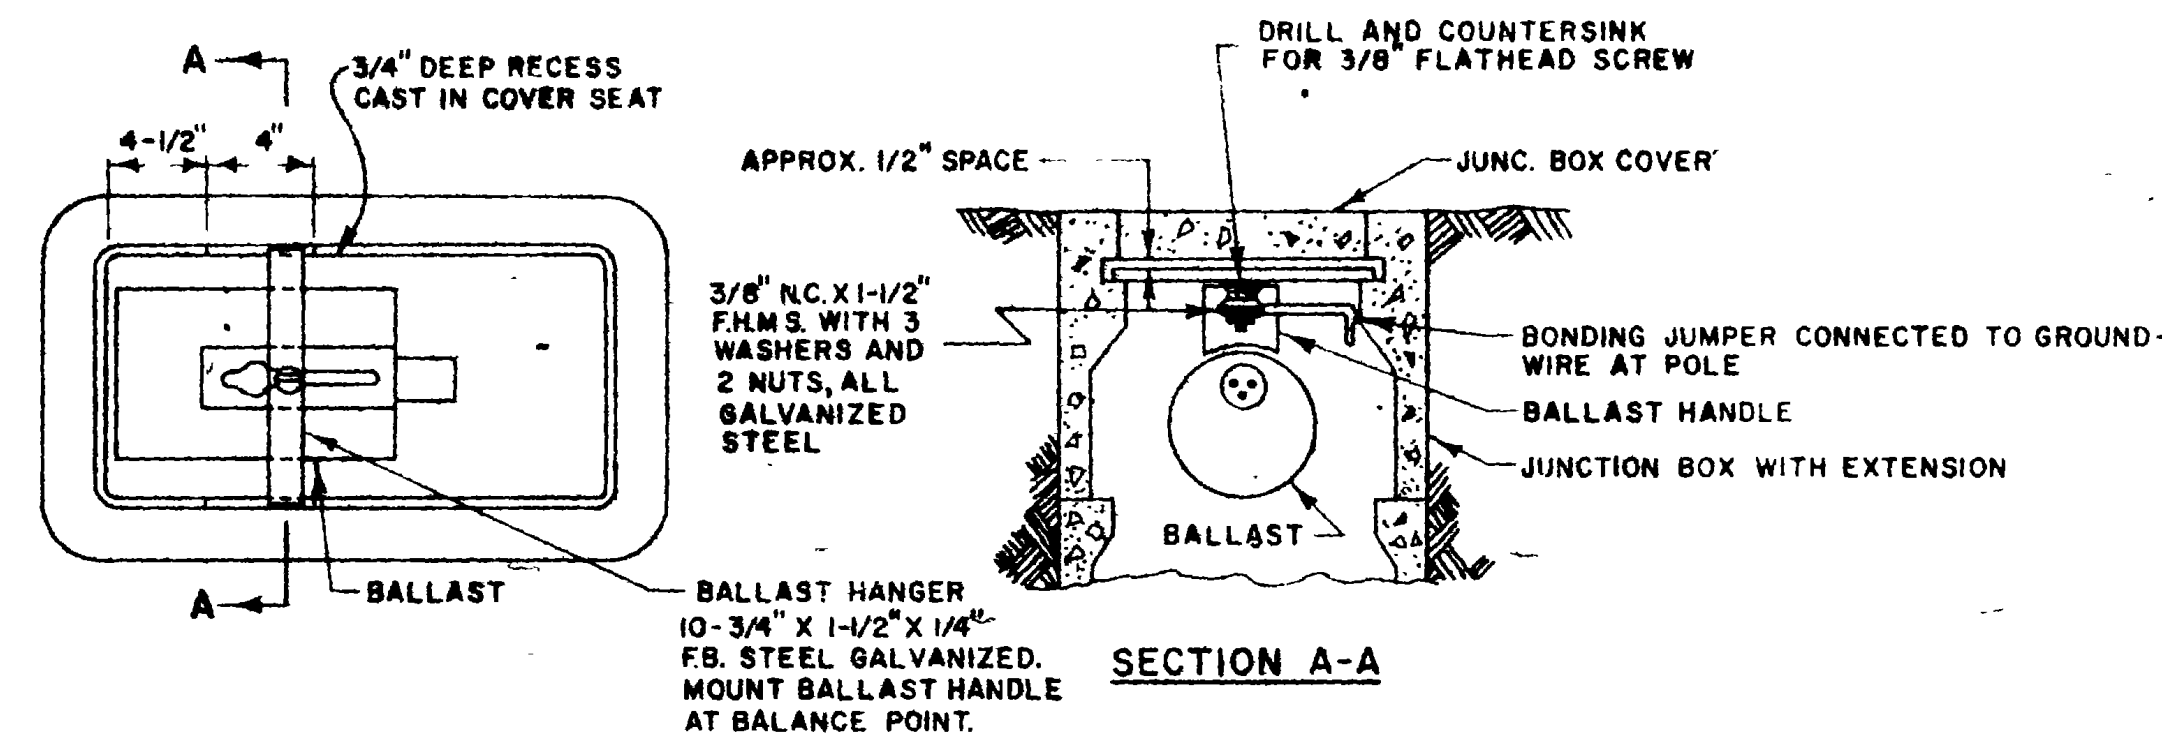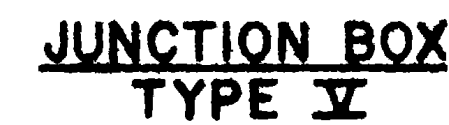

BALLAST INSTALLATION IN ROADWAY JUNCT. BOX

JUNCTION BOX (GENERAL DIMENSIONS SAME AS TYPE V)
TYPE V-B

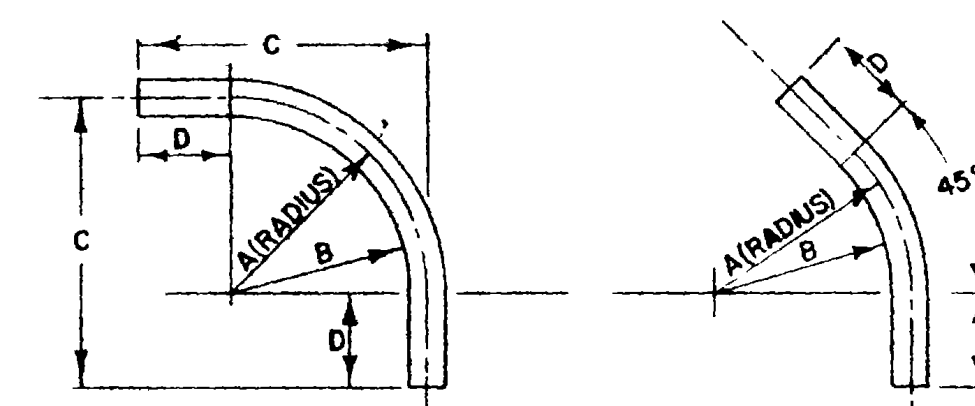

	A	B	C	D
NOM SIZE I.D.	RADIUS	RADIUS	90° OFFSET ELBOW	90° & 45° ELBOW
1/2	4	3-9/16		2-3/4
3/4	4-1/2	4	7-1/2	3
1	5-3/4	5-1/16	8-3/4	3
1-1/4	7-1/4	6-7/16	10-1/4	3
1-1/2	8-1/4	7-5/16	12	3-3/4
2	9-1/2	8-5/16	14-1/2	5
2-1/2	10-1/2	9-1/16	15-7/8	6
3	13	11-1/4	19-3/4	6-3/4
3-1/2	15	13	22	7
4	16	13-3/4	23	7

NOTE

NOTE
MINIMUM RADIUS FOR RIGID CONDUIT TO BE
PLACED UNDERGROUND. A MAXIMUM OF (4) FOUR SUCH
BENDS WILL BE PERMITTED BETWEEN JUNCTION BOXES
WHERE REQUIRED.



1. USE STEEL COVER AND SPECIAL CONCRETE FOOTING, AS SHOWN, WHEN BOX IS TO BE INSTALLED WHERE SUBJECT TO TRAFFIC LOADS. STEEL COVER SHALL HAVE EMBOSSED NON-SKID PATTERN WHEN BOX IS PLACED IN PAVED OR SIDEWALK AREAS.

2. STEEL REINFORCING SHALL BE AS REGULARLY USED IN THE STANDARD PRODUCTS OF THE RESPECTIVE MANUFACTURER.

3. TOP OF JUNCT. BOXES SHALL BE FLUSH WITH SURROUNDING GRADE. TOP OF ADJACENT CURB, EXCEPT WHERE UNPAVED AREAS ADJACENT, SHALL NOT IMMEDIATELY ADJACENT TO AND PROTECTED BY A CONCRETE FOUNDATION, POLE, OR OTHER PROTECTIVE CONSTRUCTION, THE BOX SHALL BE BURIED 12 INCHES BELOW GRADE, AND SHALL BE MARKED BY A JUNCT. BOX MARKER PLACED ADJACENT TO THE JUNCT. BOX. WHERE PRACTICABLE, JUNCT. BOXES SHOWN IN THE VICINITY OF CURBS, SHALL BE PLACED ADJACENT TO THE BACK OF CURB, AND JUNCT. BOXES SHOWN ADJACENT TO STANDARDS, SHALL BE PLACED ALONG THE SIDE OF FOUNDATION.

4. BONDING JUMPER REQUIRED WITH RIGID STEEL CONDUIT.

JUNCTION BOX MARKER

UTAH STATE ROAD COMMISSION
TRAFFIC & RESEARCH DEPARTMENT
TRAFFIC ENGINEERING BRANCH

JUNCT. BOX DETAIL

(OFF STRUCTURE)

REC'D R.S.T. SCALE NONE
JMB 1 APR 63 SUBD MAY 5 1963
R.S.T.

DOC NO T E. 1128

1. - REVISED JUNE 15, 1964
2. - REVISED DEC. 4, 1964 D E M
3. - REVISED FEB 8, 1965 V W